




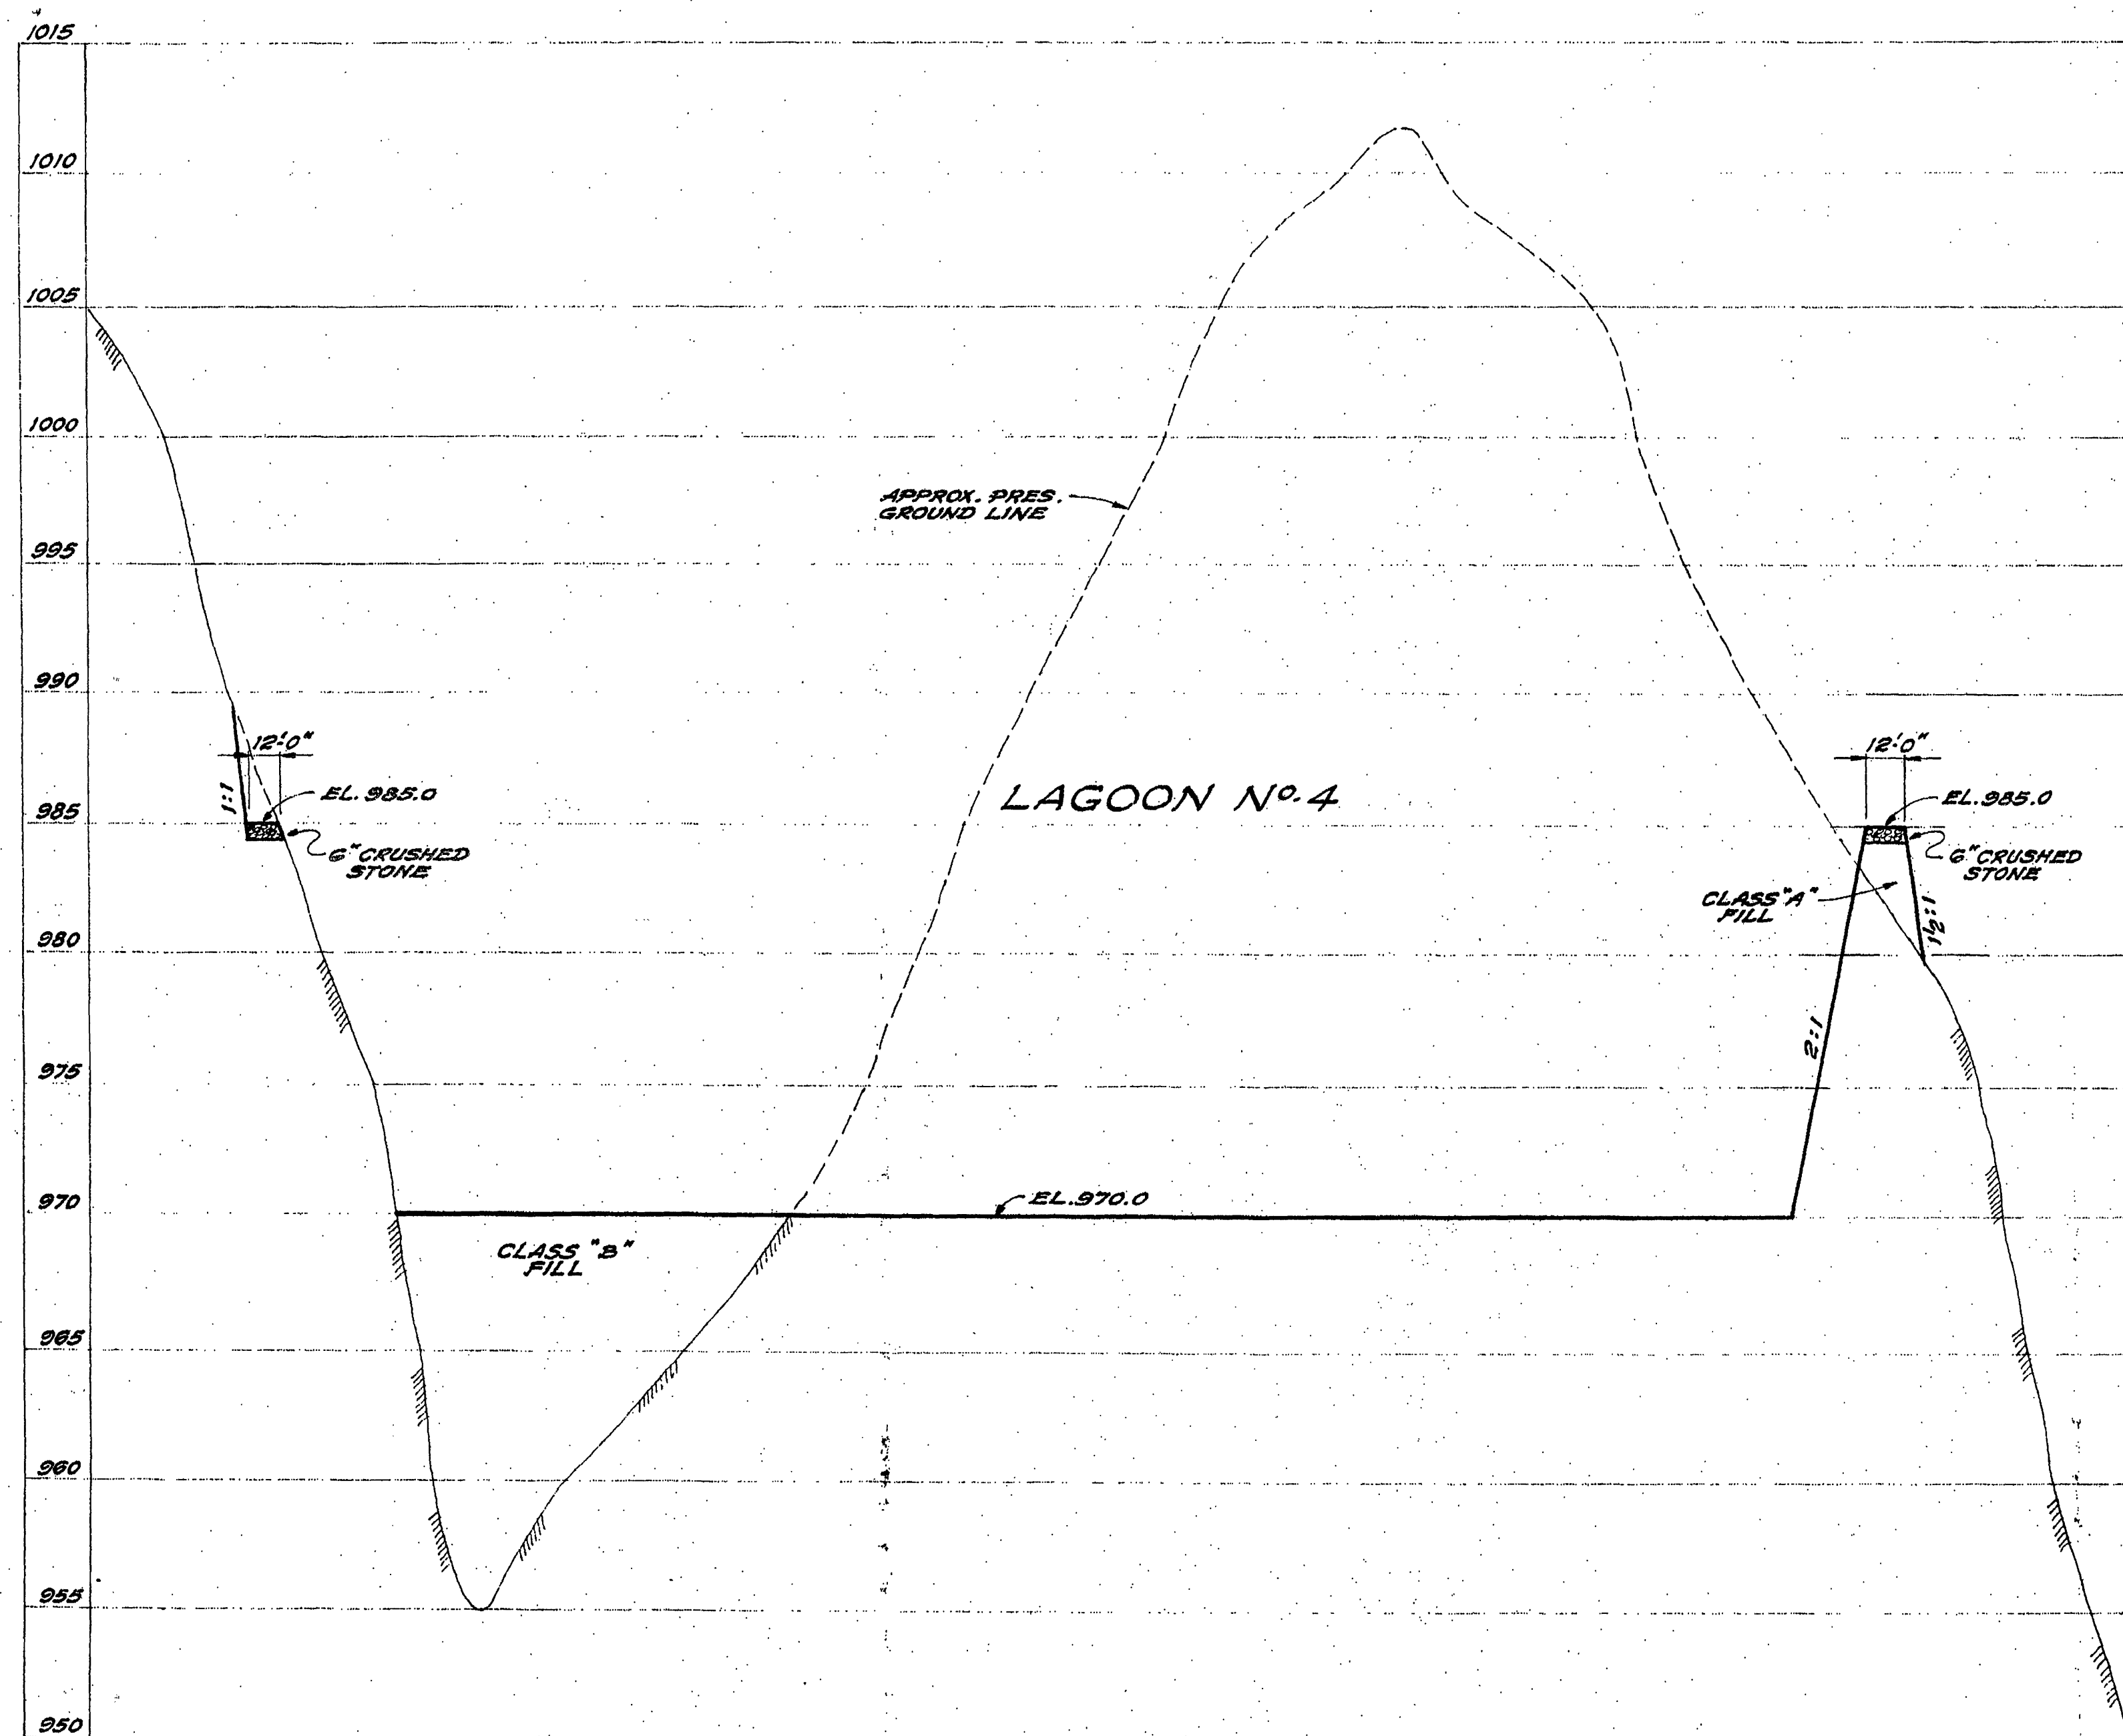



SECTION E-E
 SCALES: HORIZ. 1" = 50'
 VERT. 1" = 5'

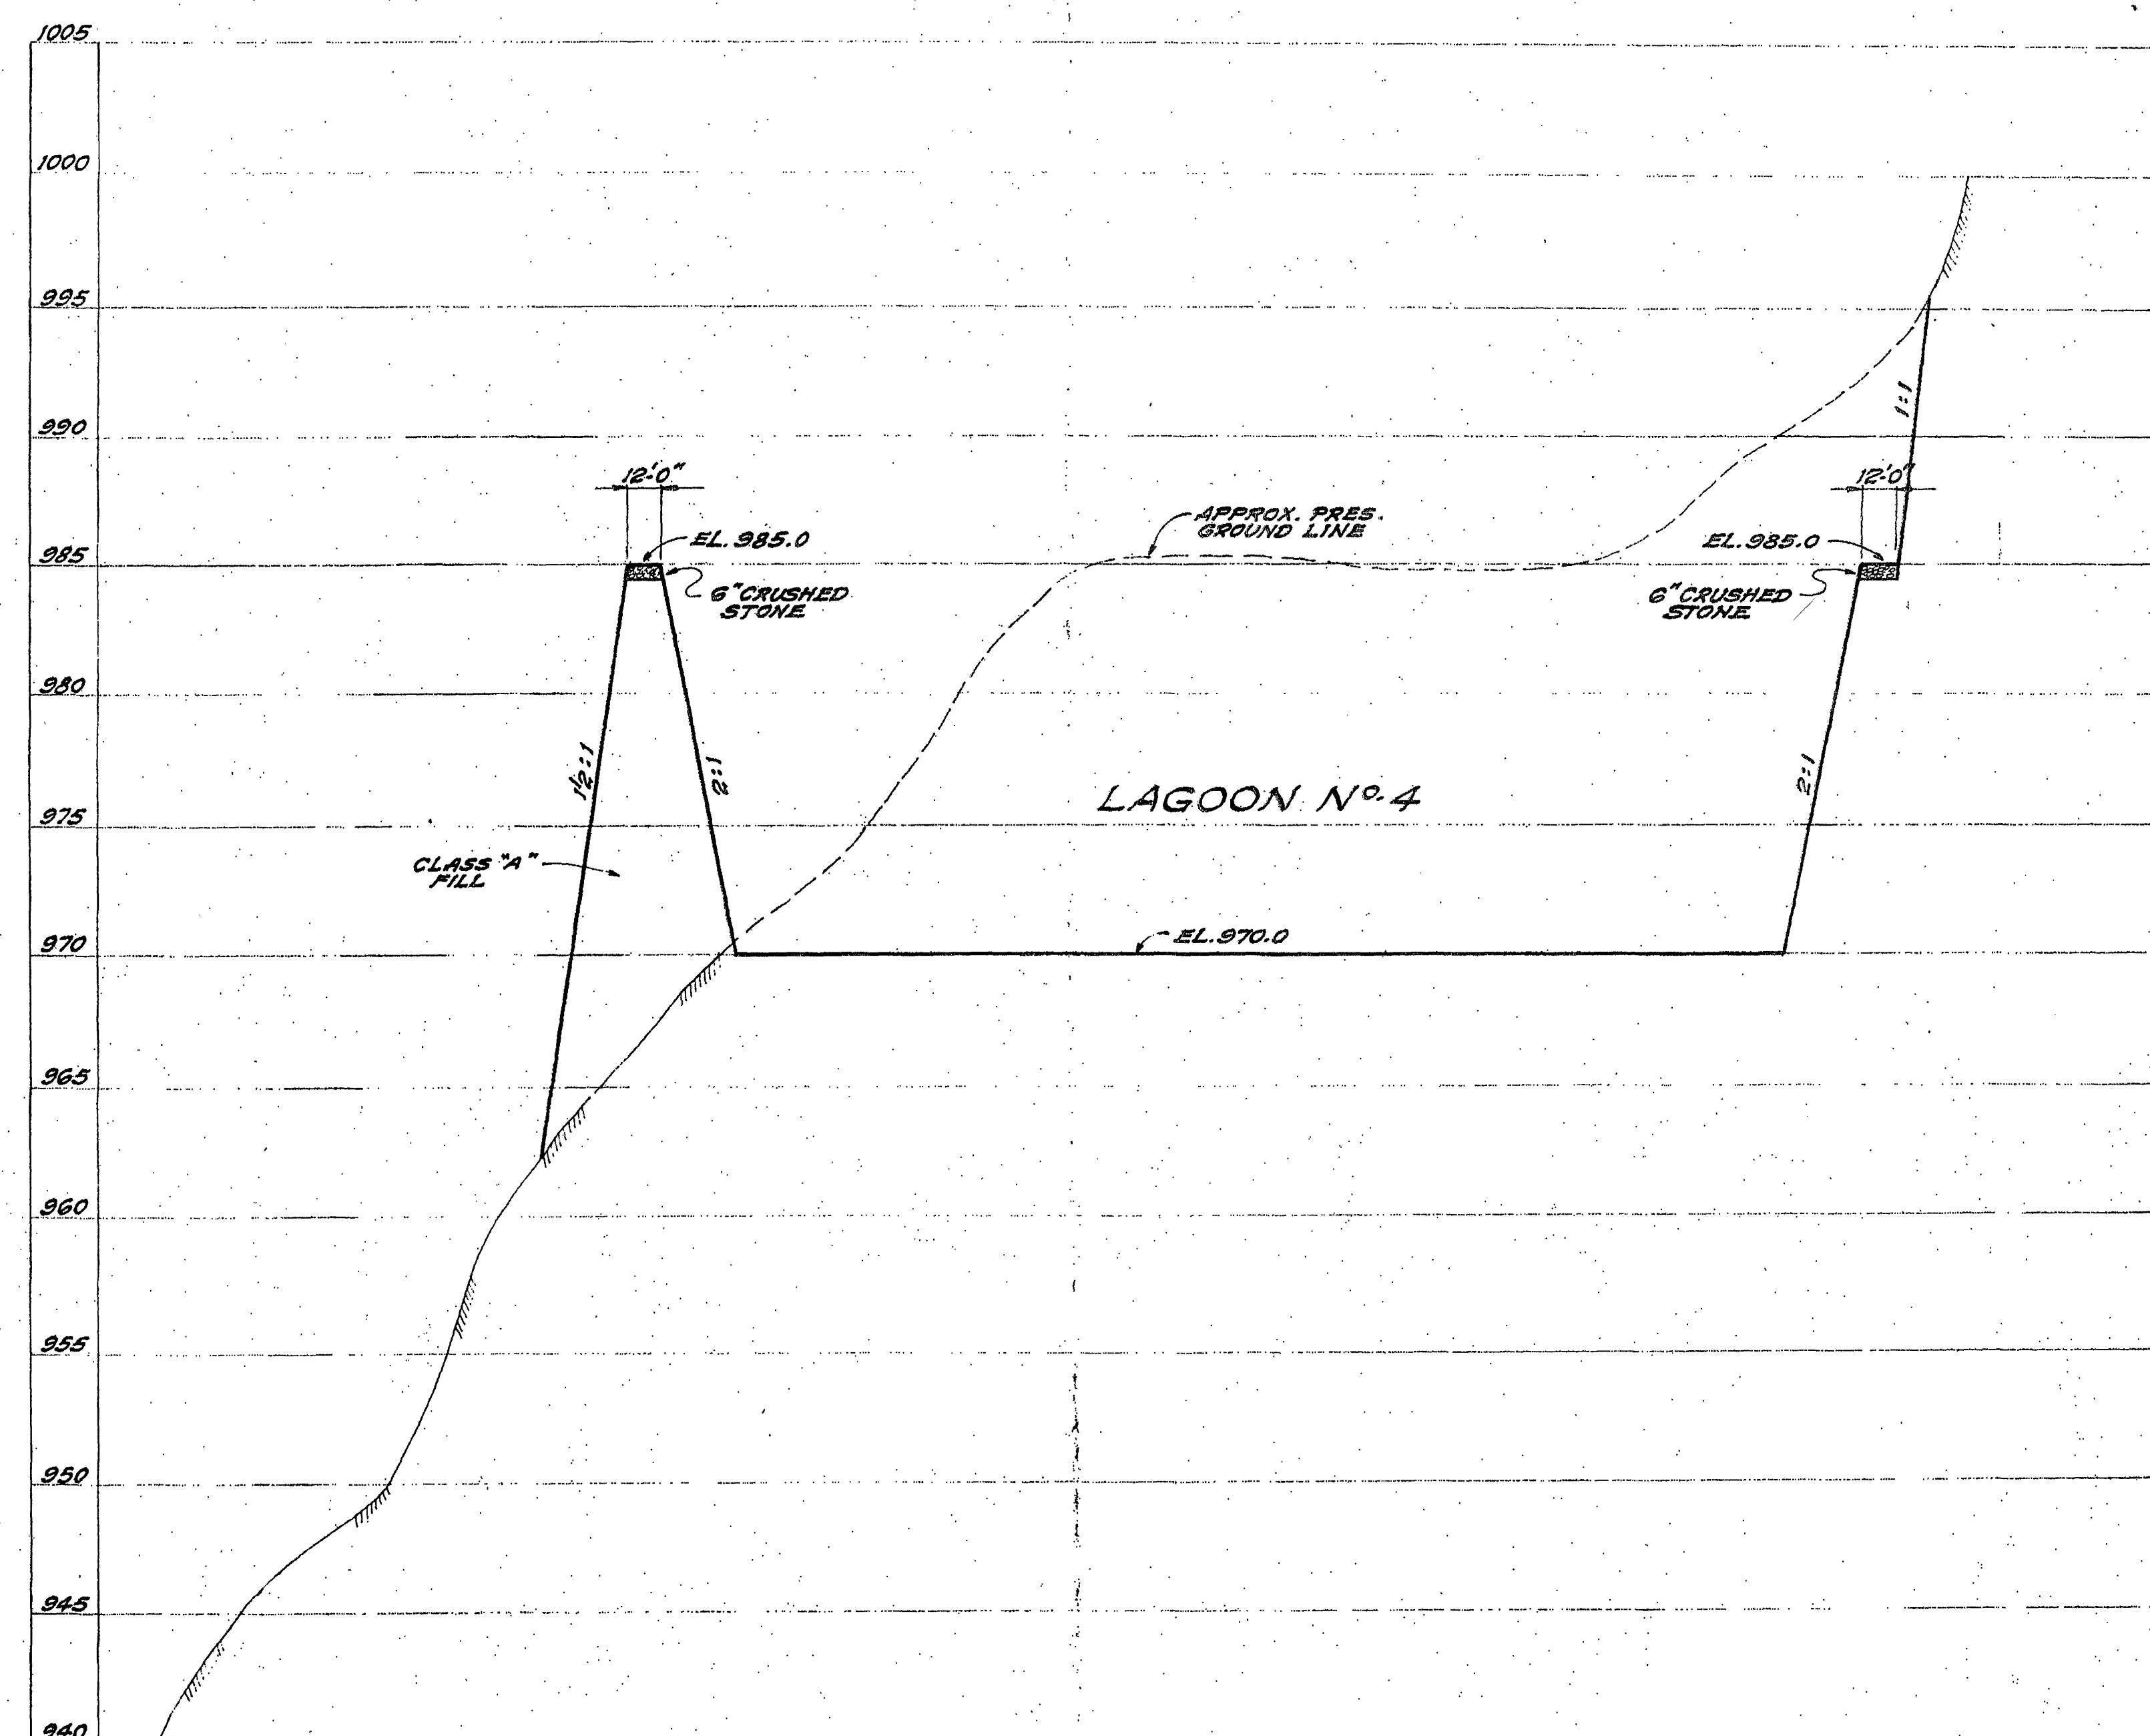

SECTION F-F
 SCALES: HORIZ. 1" = 50'
 VERT. 1" = 5'

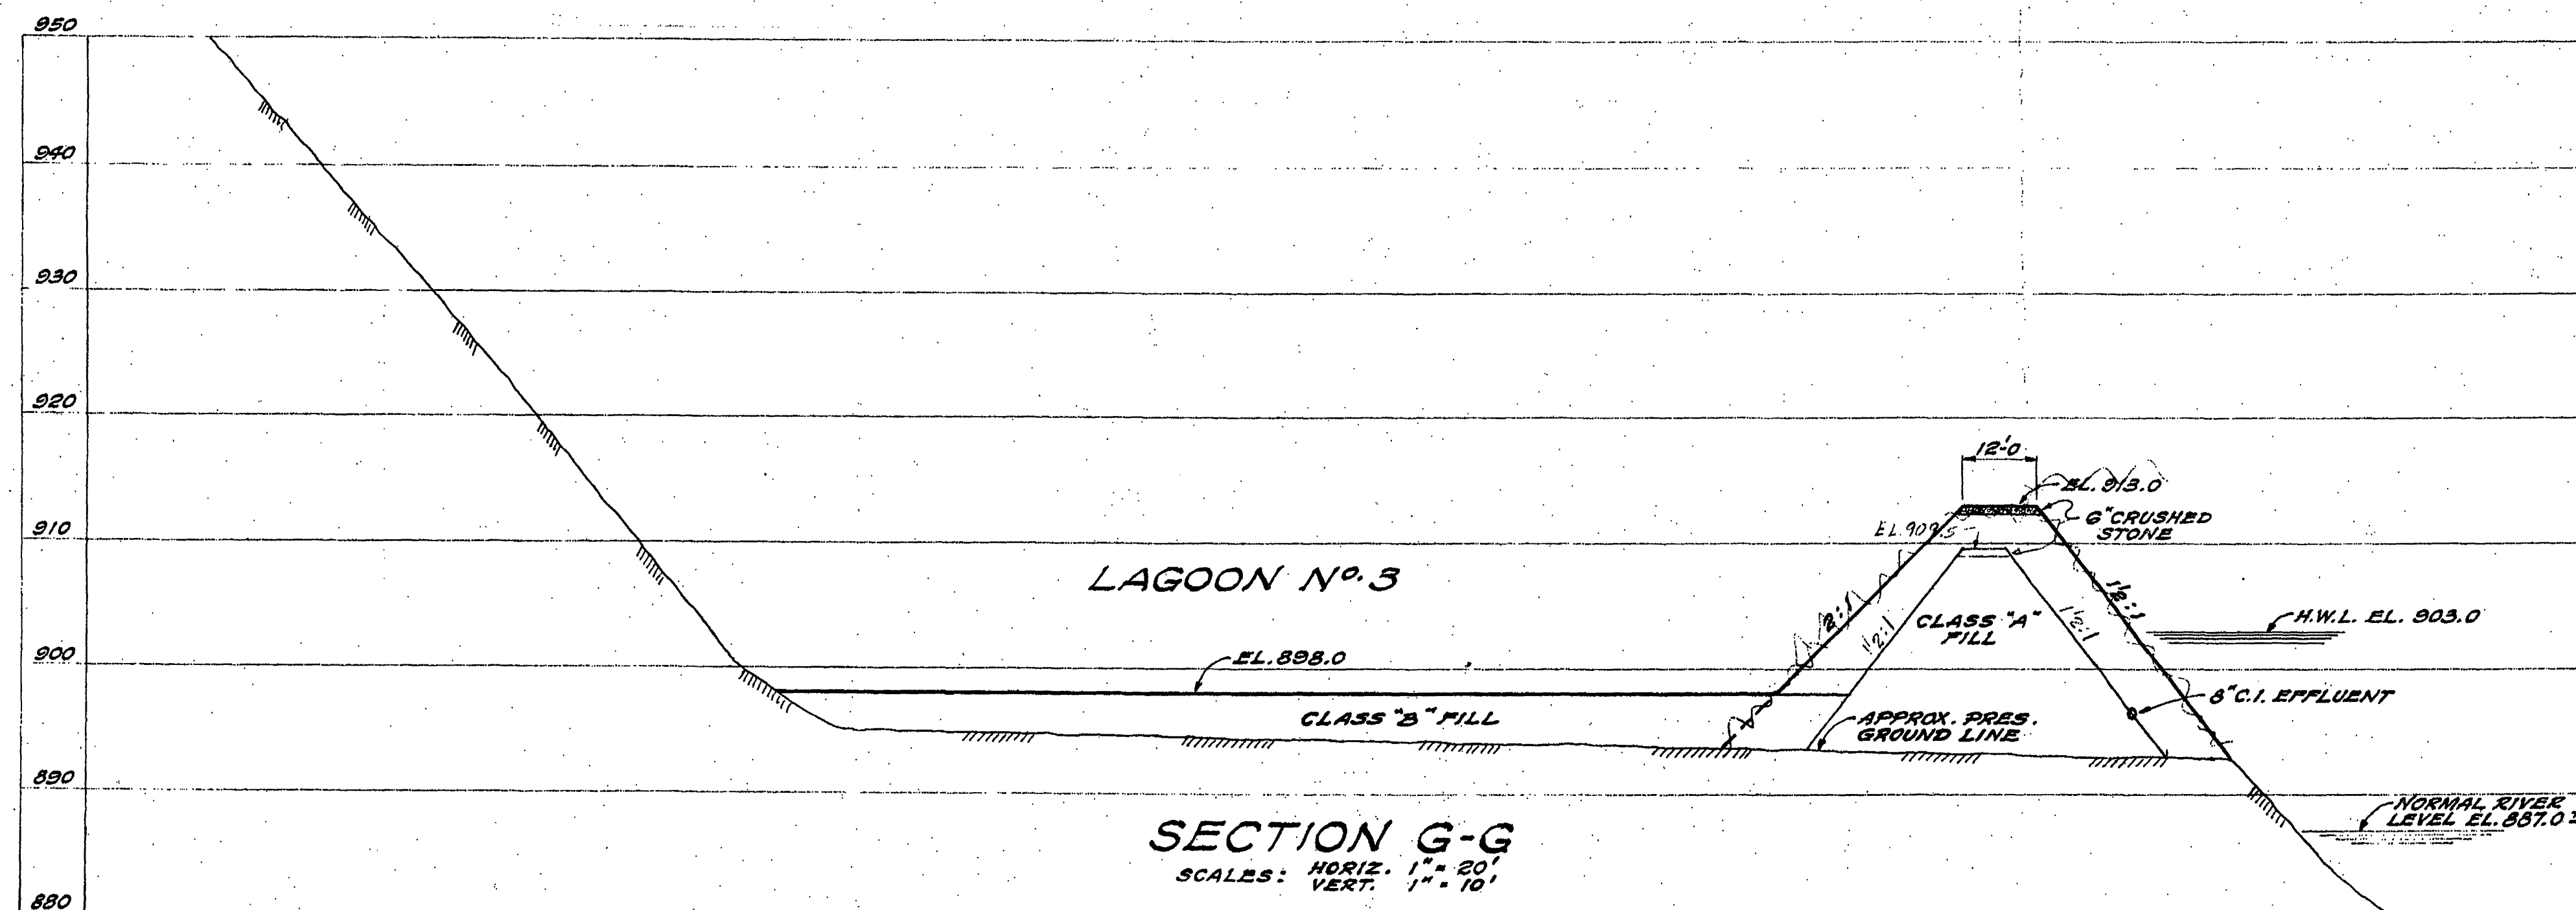

SECTION G-G
 SCALES: HORIZ. 1" = 20'
 VERT. 1" = 10'

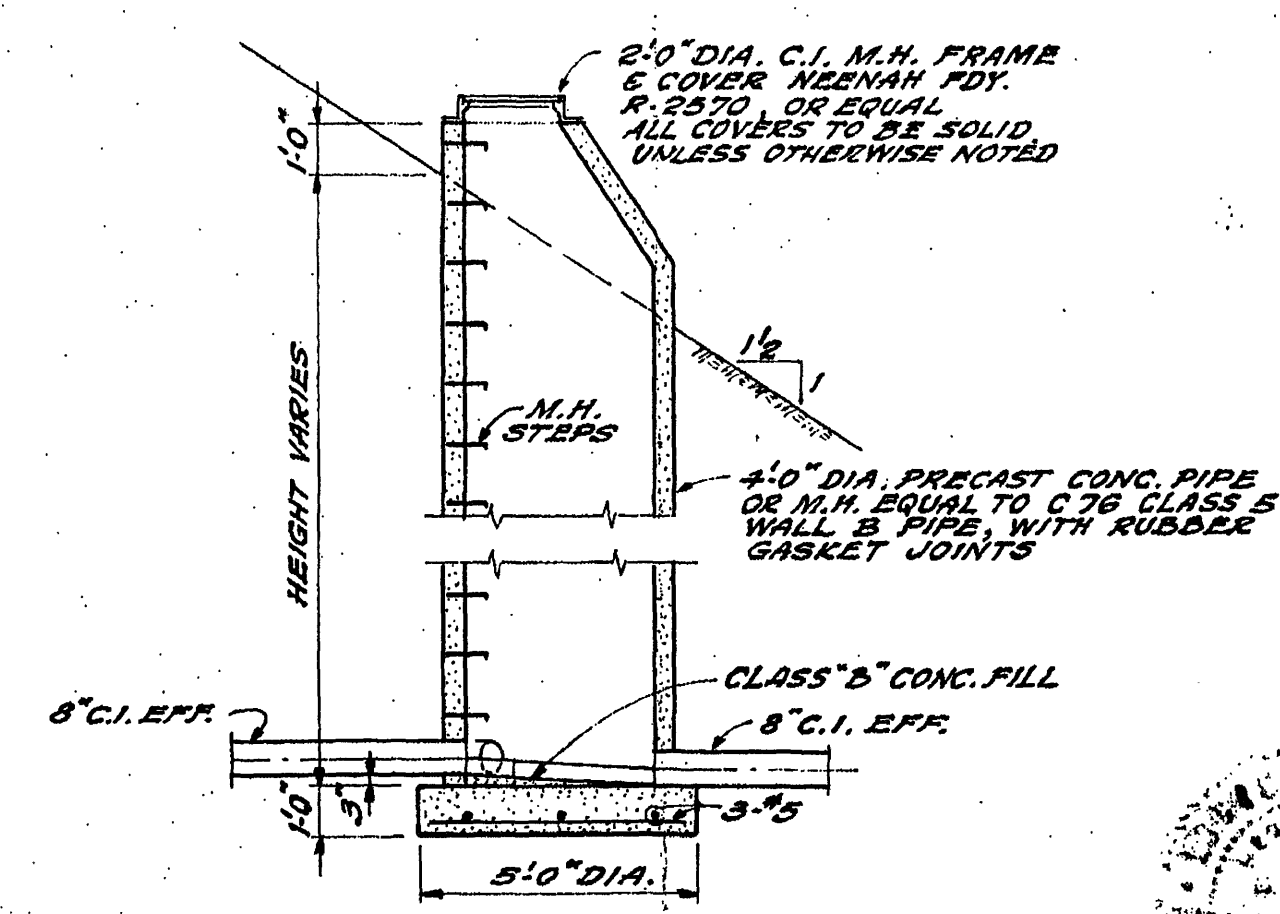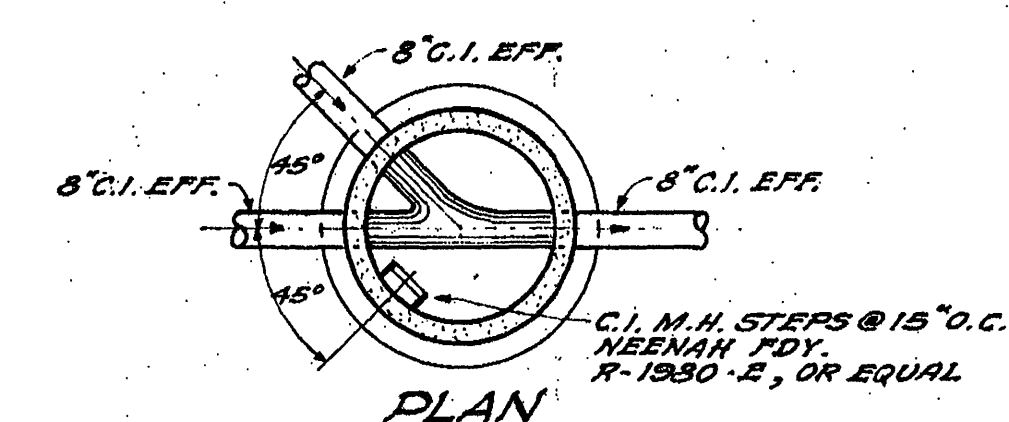

SECTION
 TYPICAL M.H. DETAIL
 SCALE: 1/4" = 1'-0"

AS BUILT

3

ADDITIONS TO SEWAGE TREATMENT PLANT
 ROANOKE, VIRGINIA

SLUDGE LAGOONS

ALVORD BURDICK & HOWSON
 ENGINEERS CHICAGO

1972