

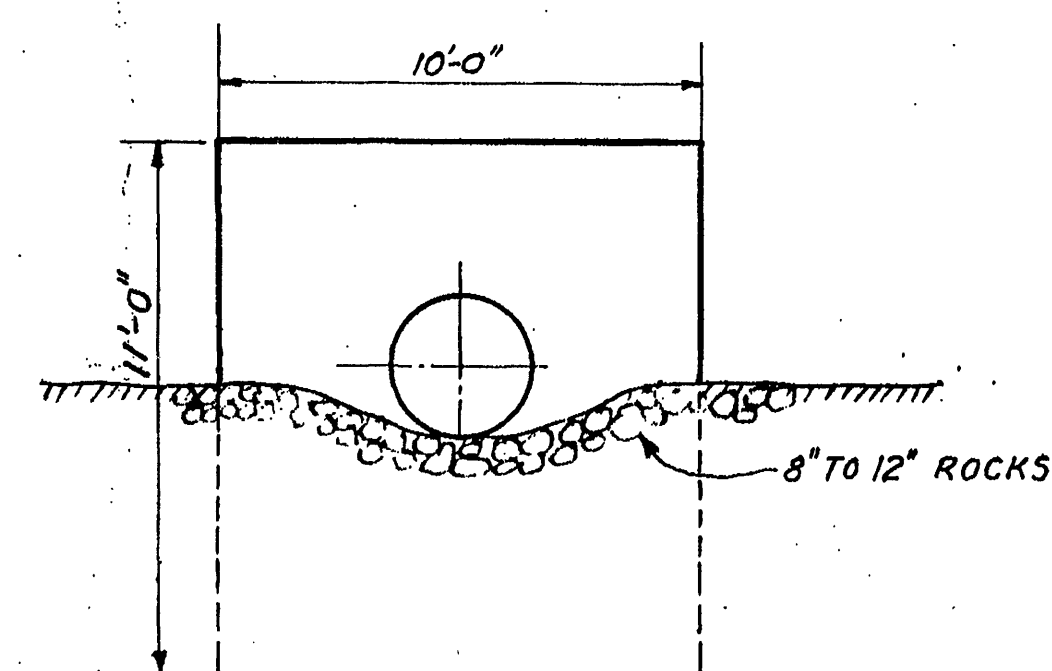


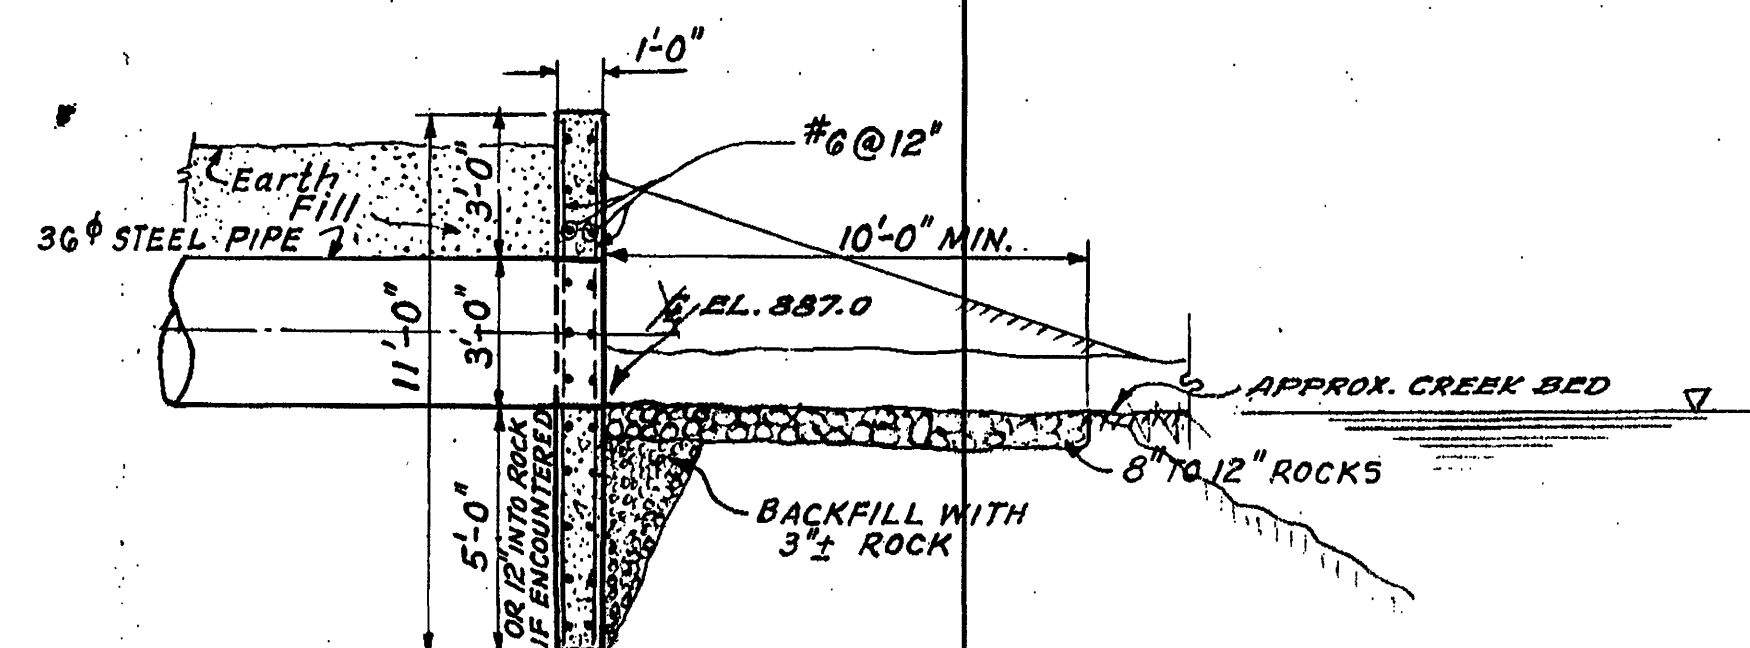

DETAIL OF CONCRETE HEAD WALL
SCALE: 1/4" = 1'-0"

AS BUILT

5

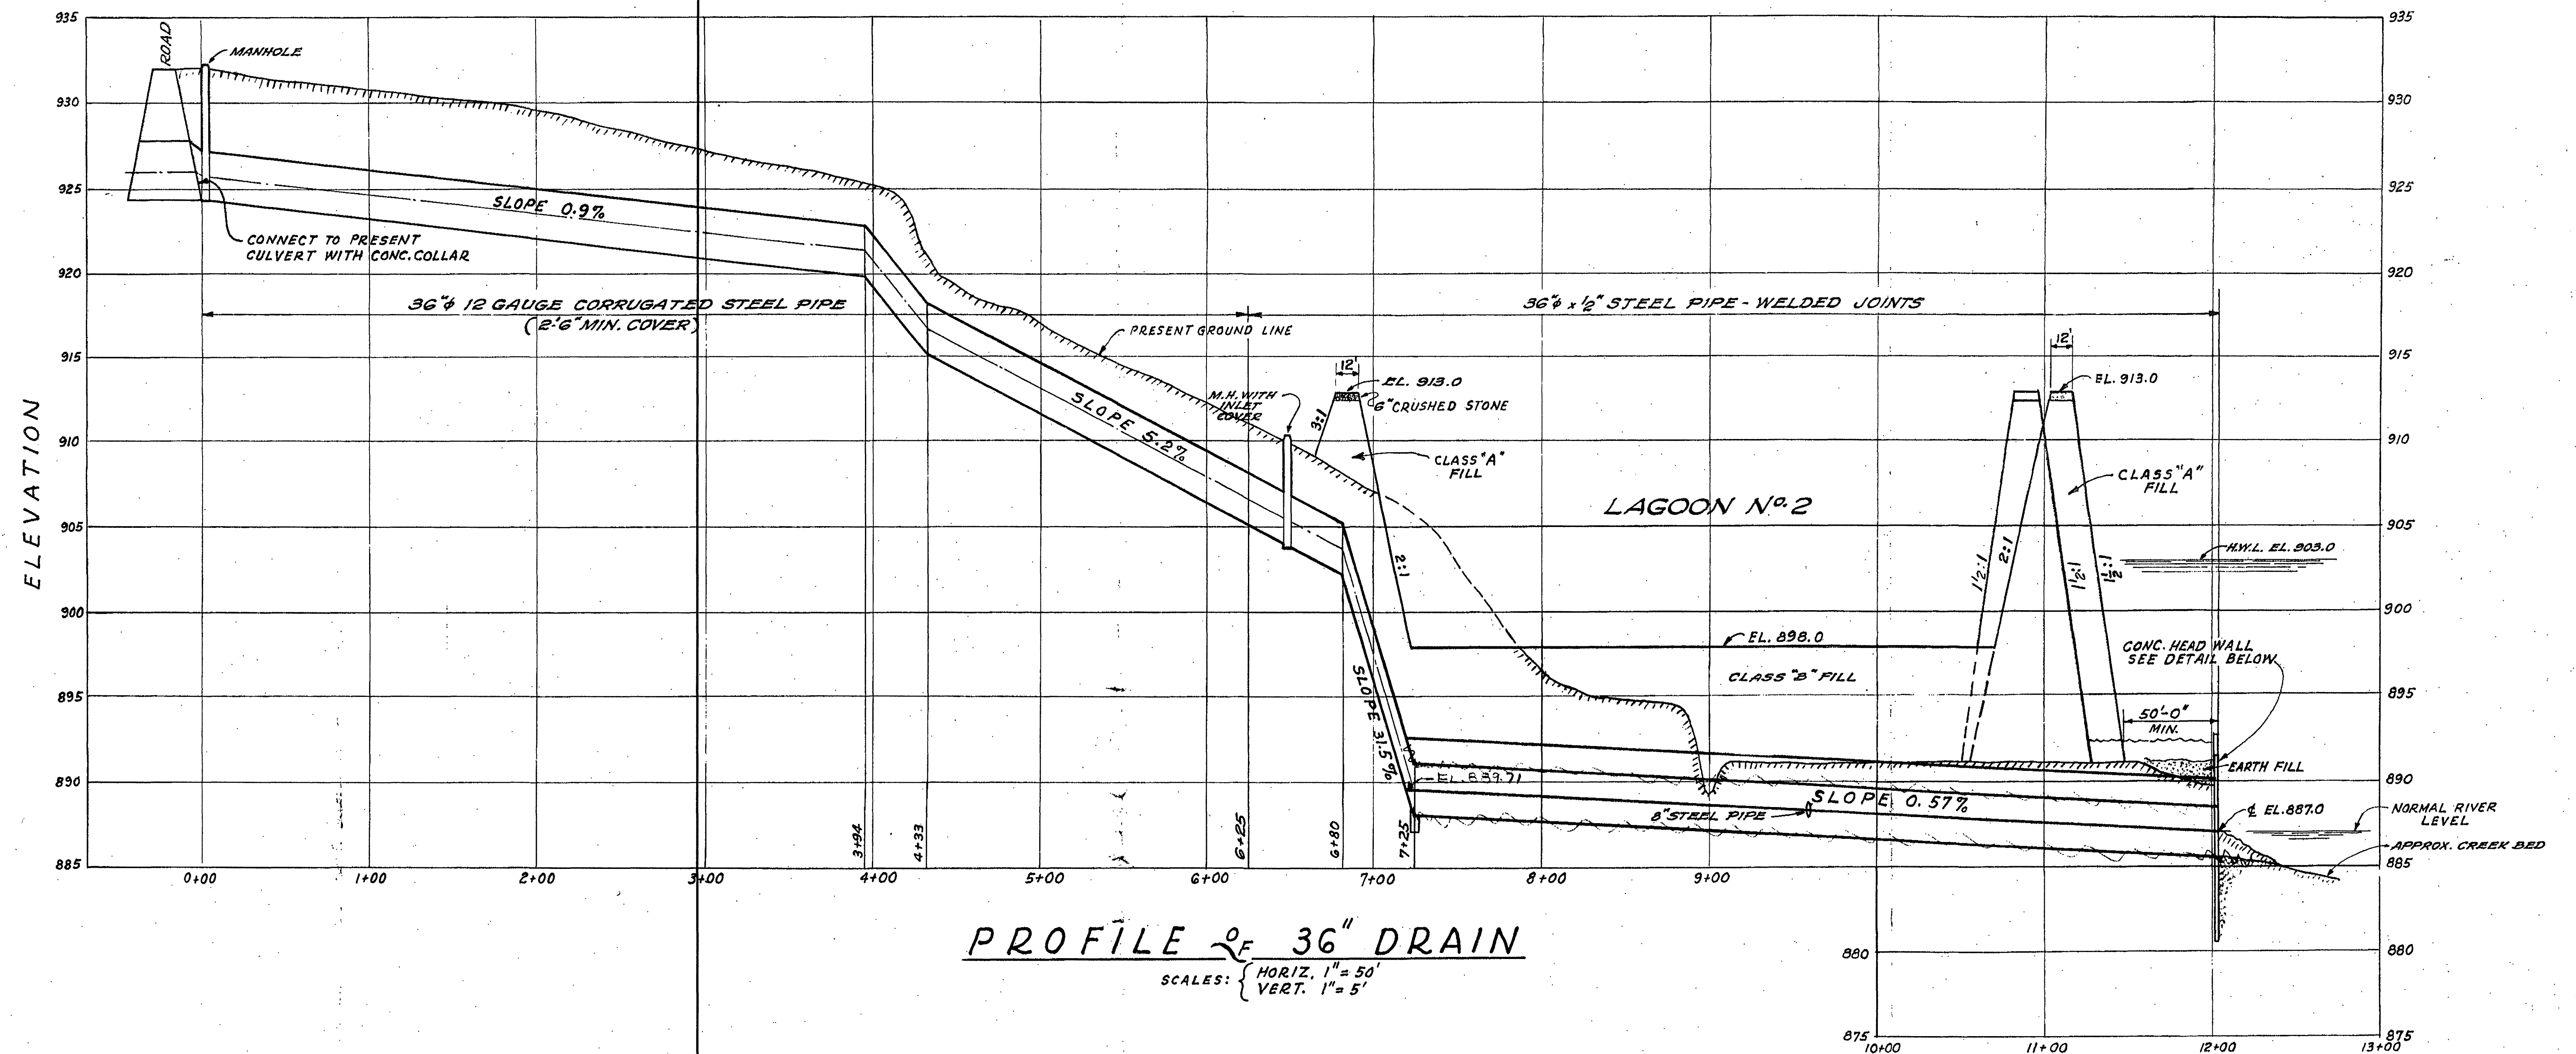

ADDITIONS TO SEWAGE TREATMENT PLANT
ROANOKE, VIRGINIA

SLUDGE LAGOONS

ALVORD, BURDICK & HOWSON
ENGINEERS CHICAGO
1972