



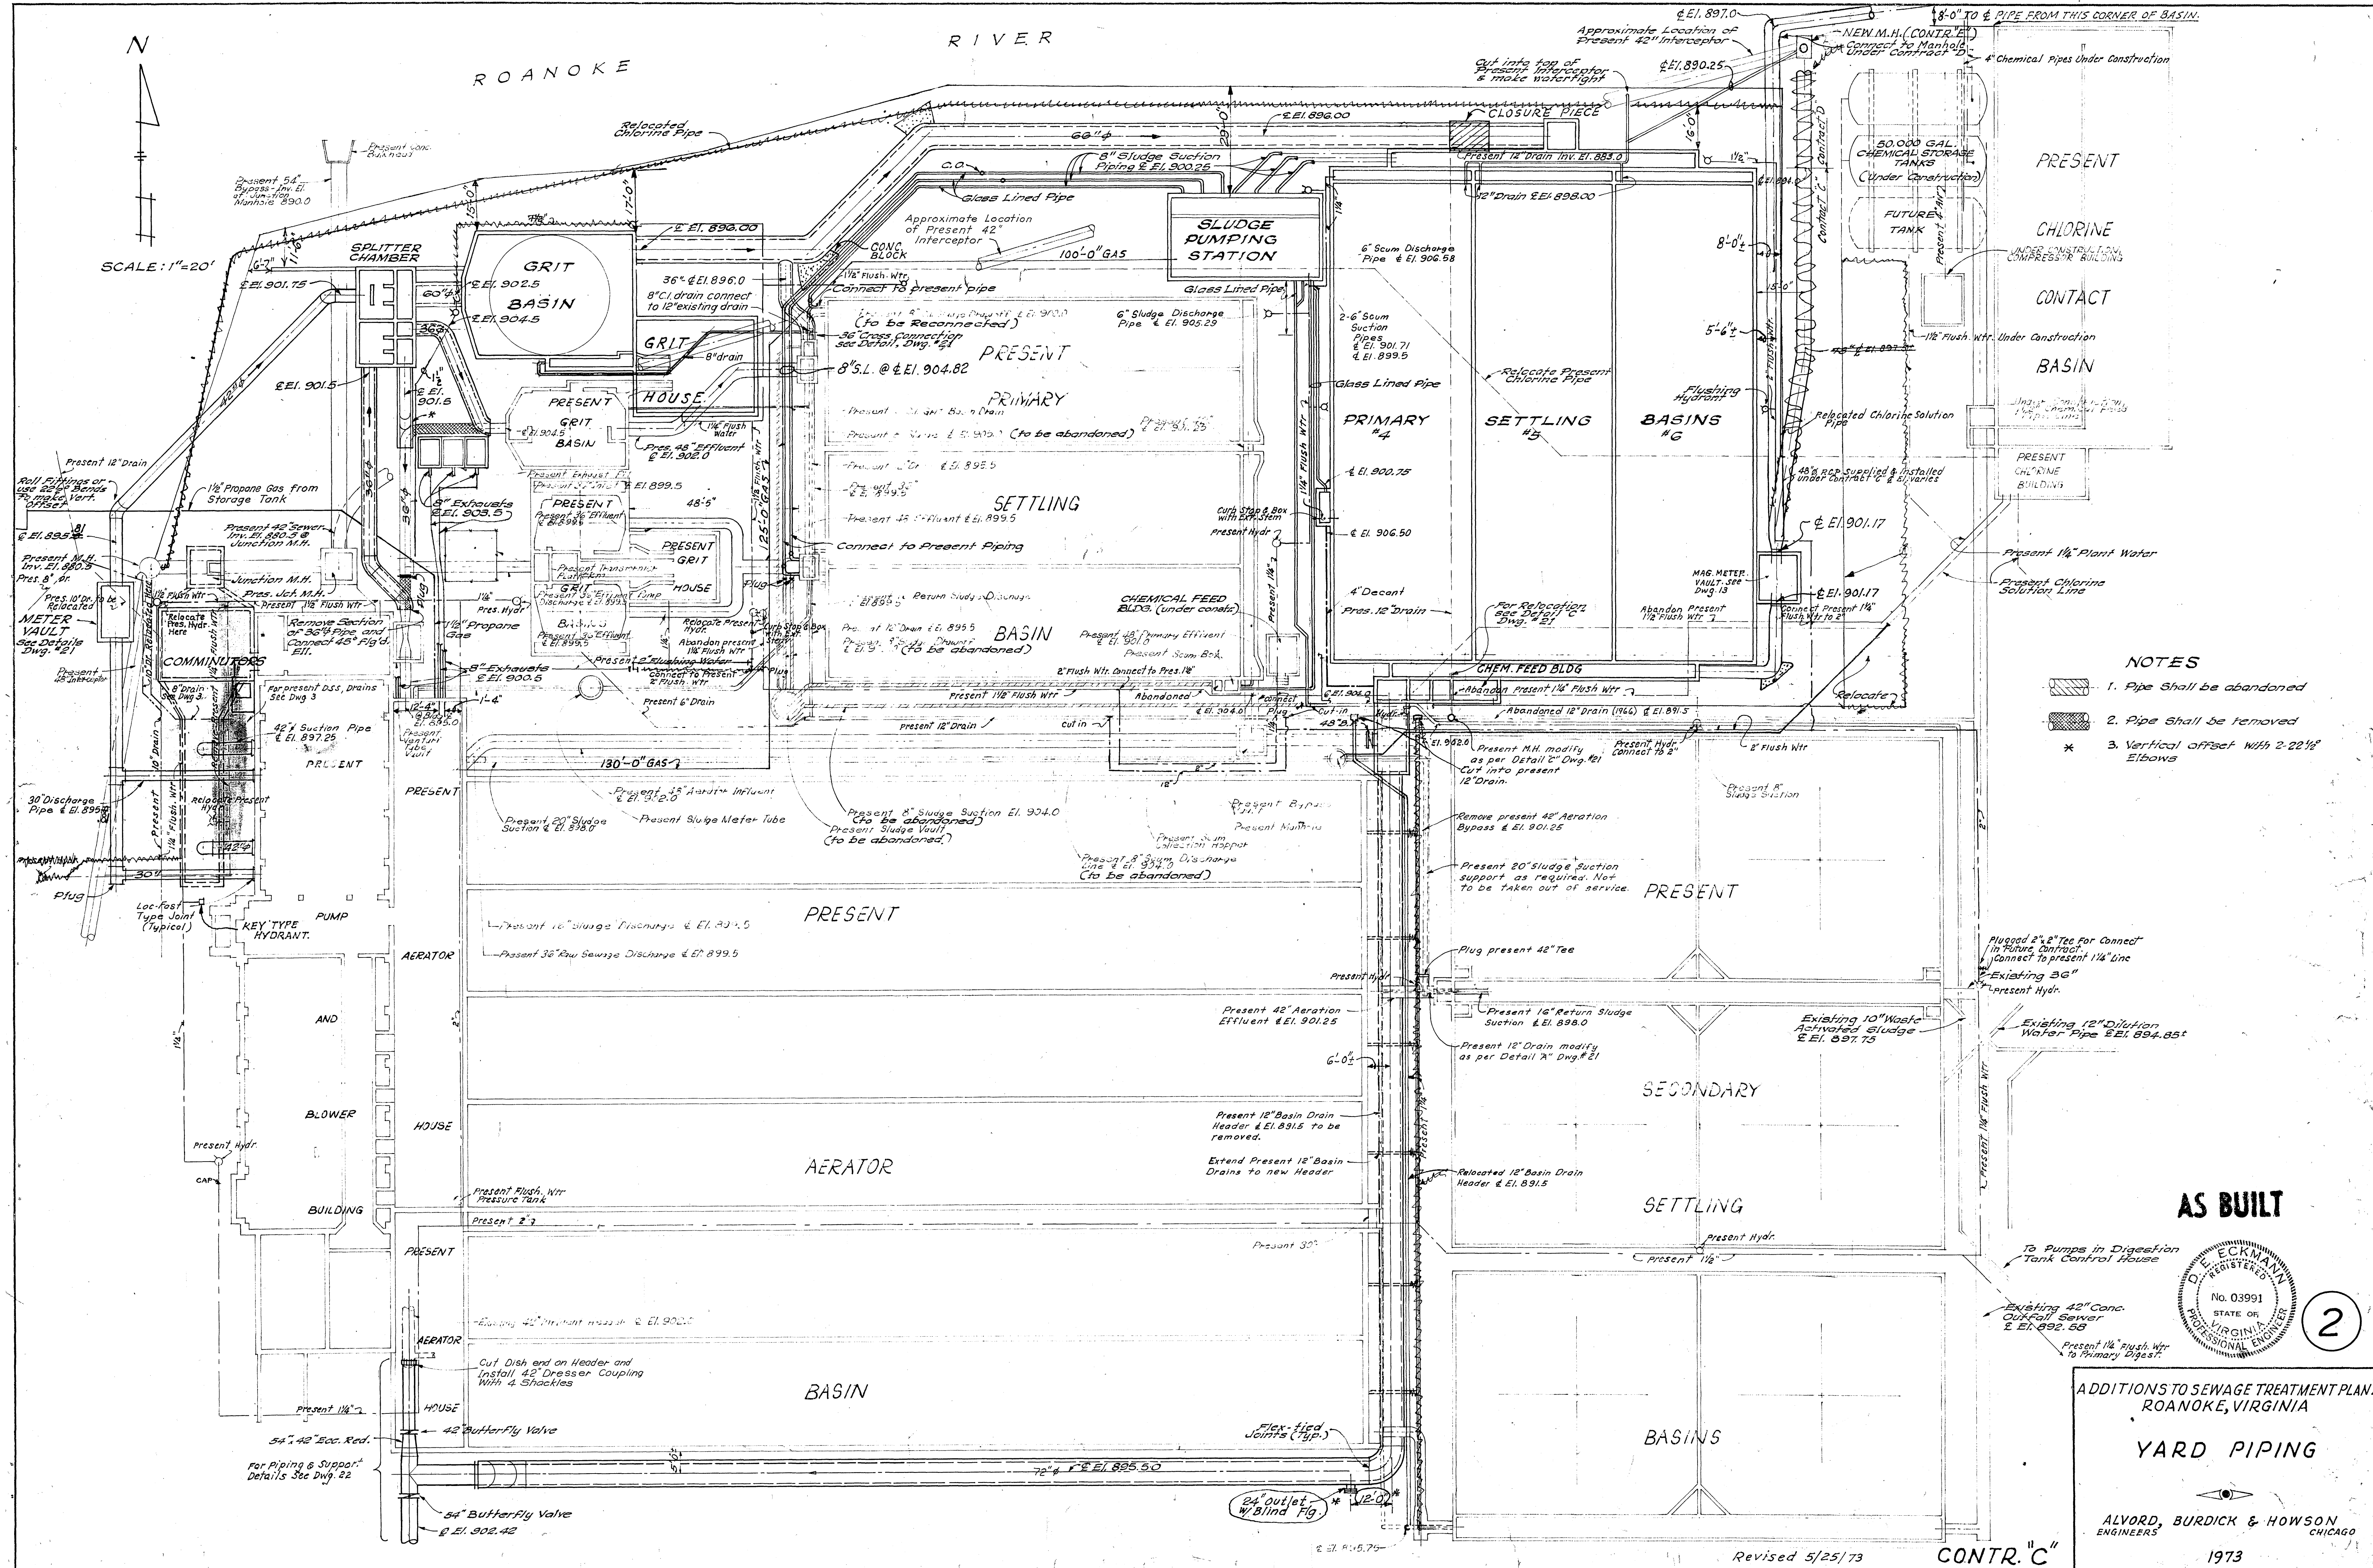

- NOTES**
- 1. Pipe shall be abandoned
 - 2. Pipe shall be removed
 - 3. Vertical offset with 2-22 1/2" Elbows

AS BUILT

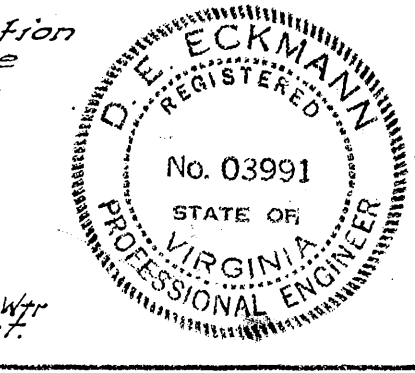

ADDITIONS TO SEWAGE TREATMENT PLANT
ROANOKE, VIRGINIA

YARD PIPING

ALVORD, BURDICK & HOWSON
ENGINEERS CHICAGO

Revised 5/25/73

CONTR. "C"

1973