




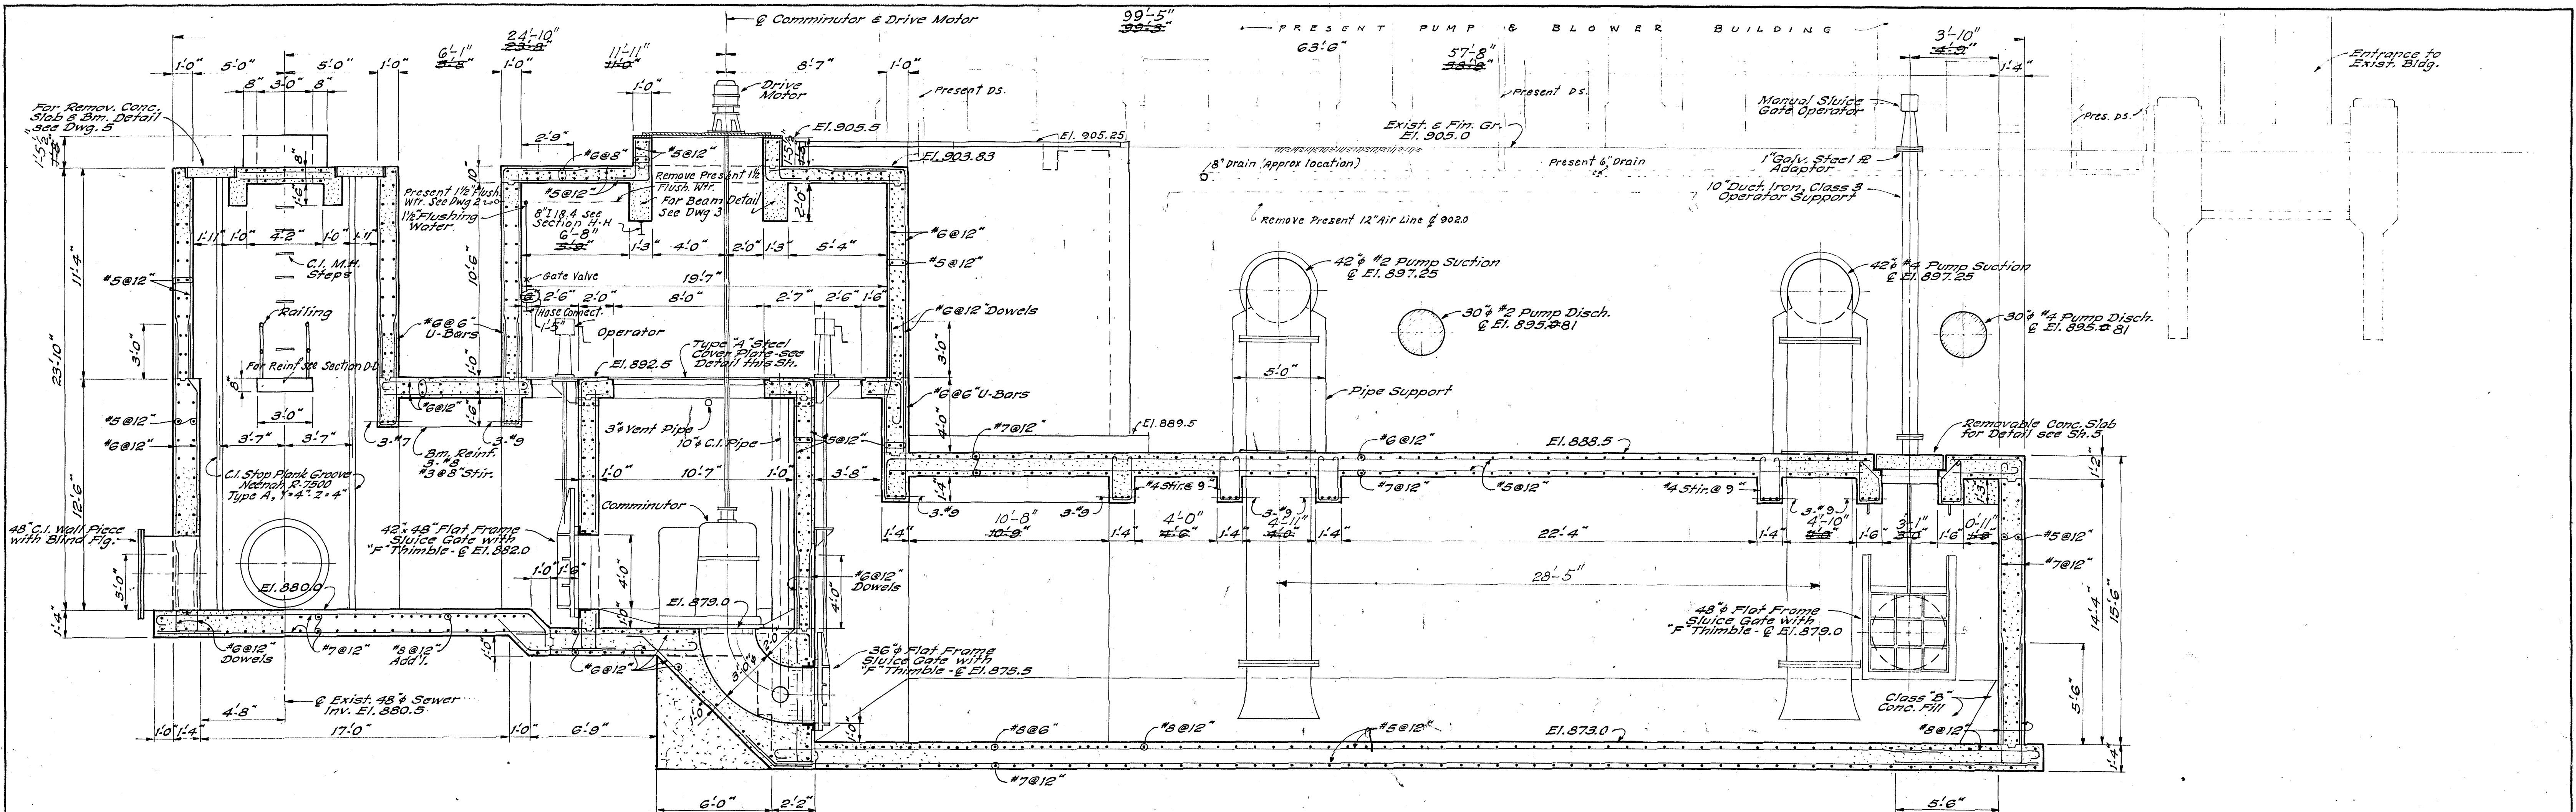



SECTION A-A
Scale: 1/4" = 1'-0"

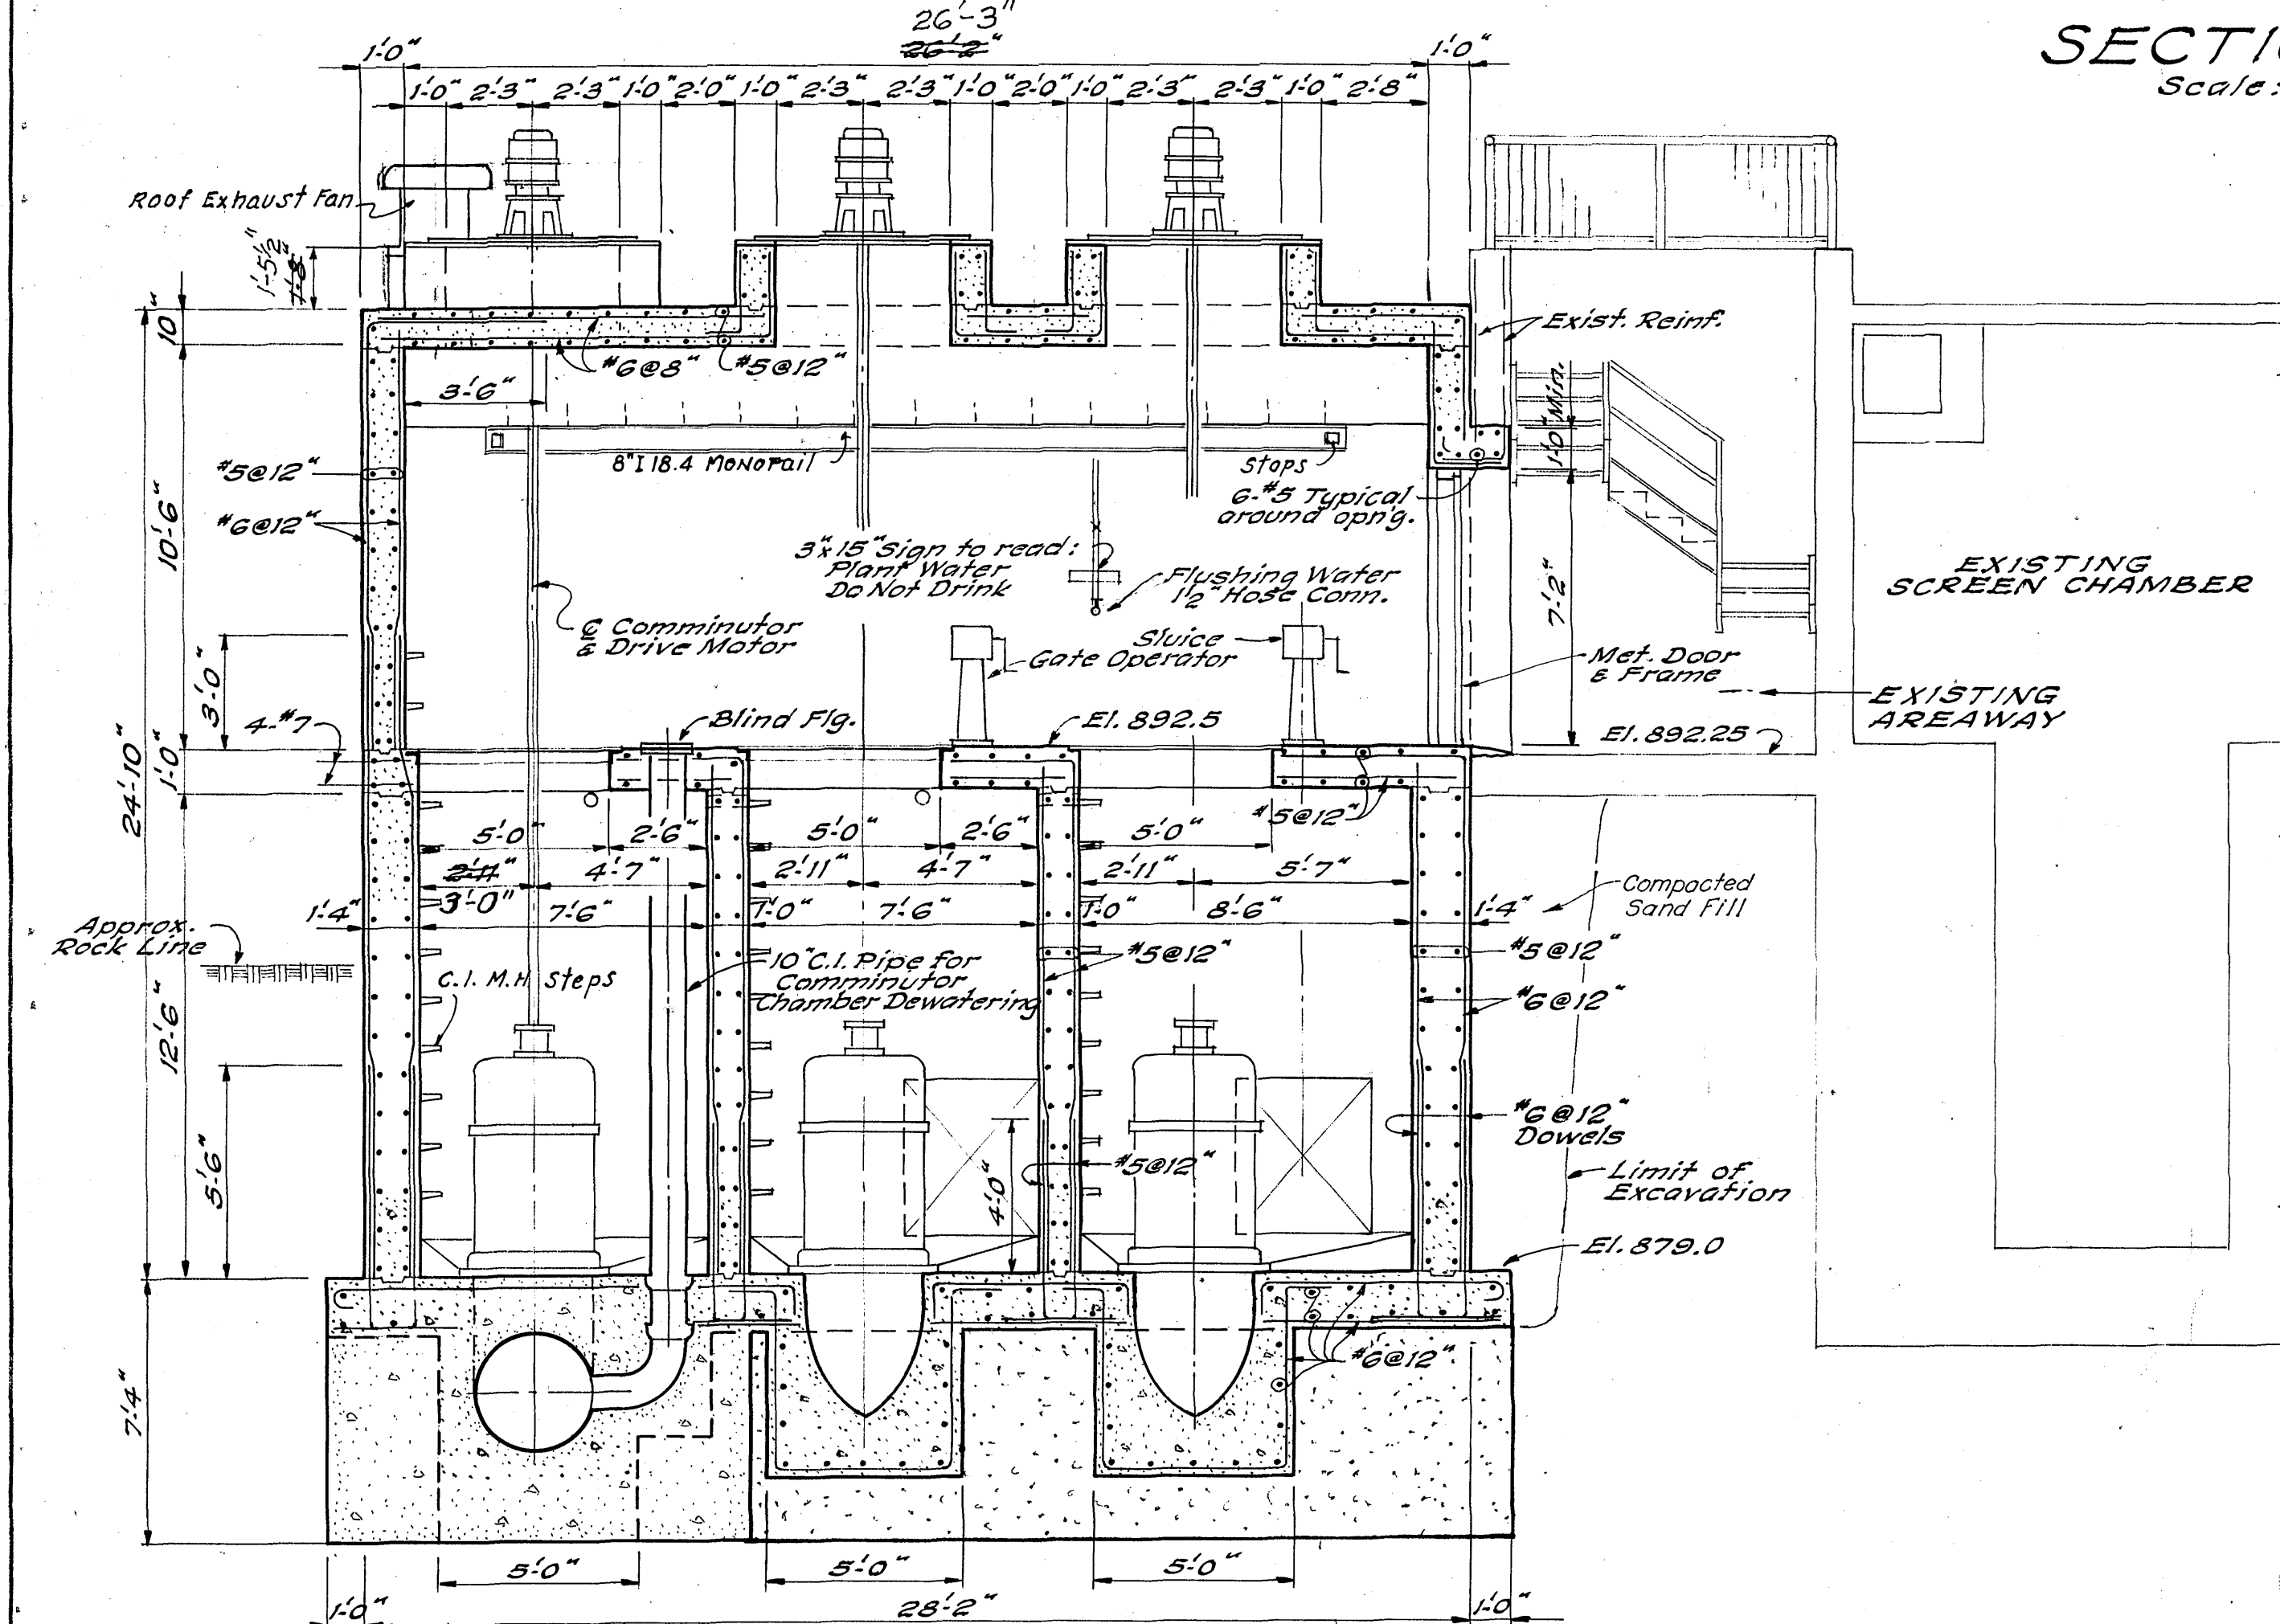


SECTION B-B
Scale: 1/4" = 1'-0"

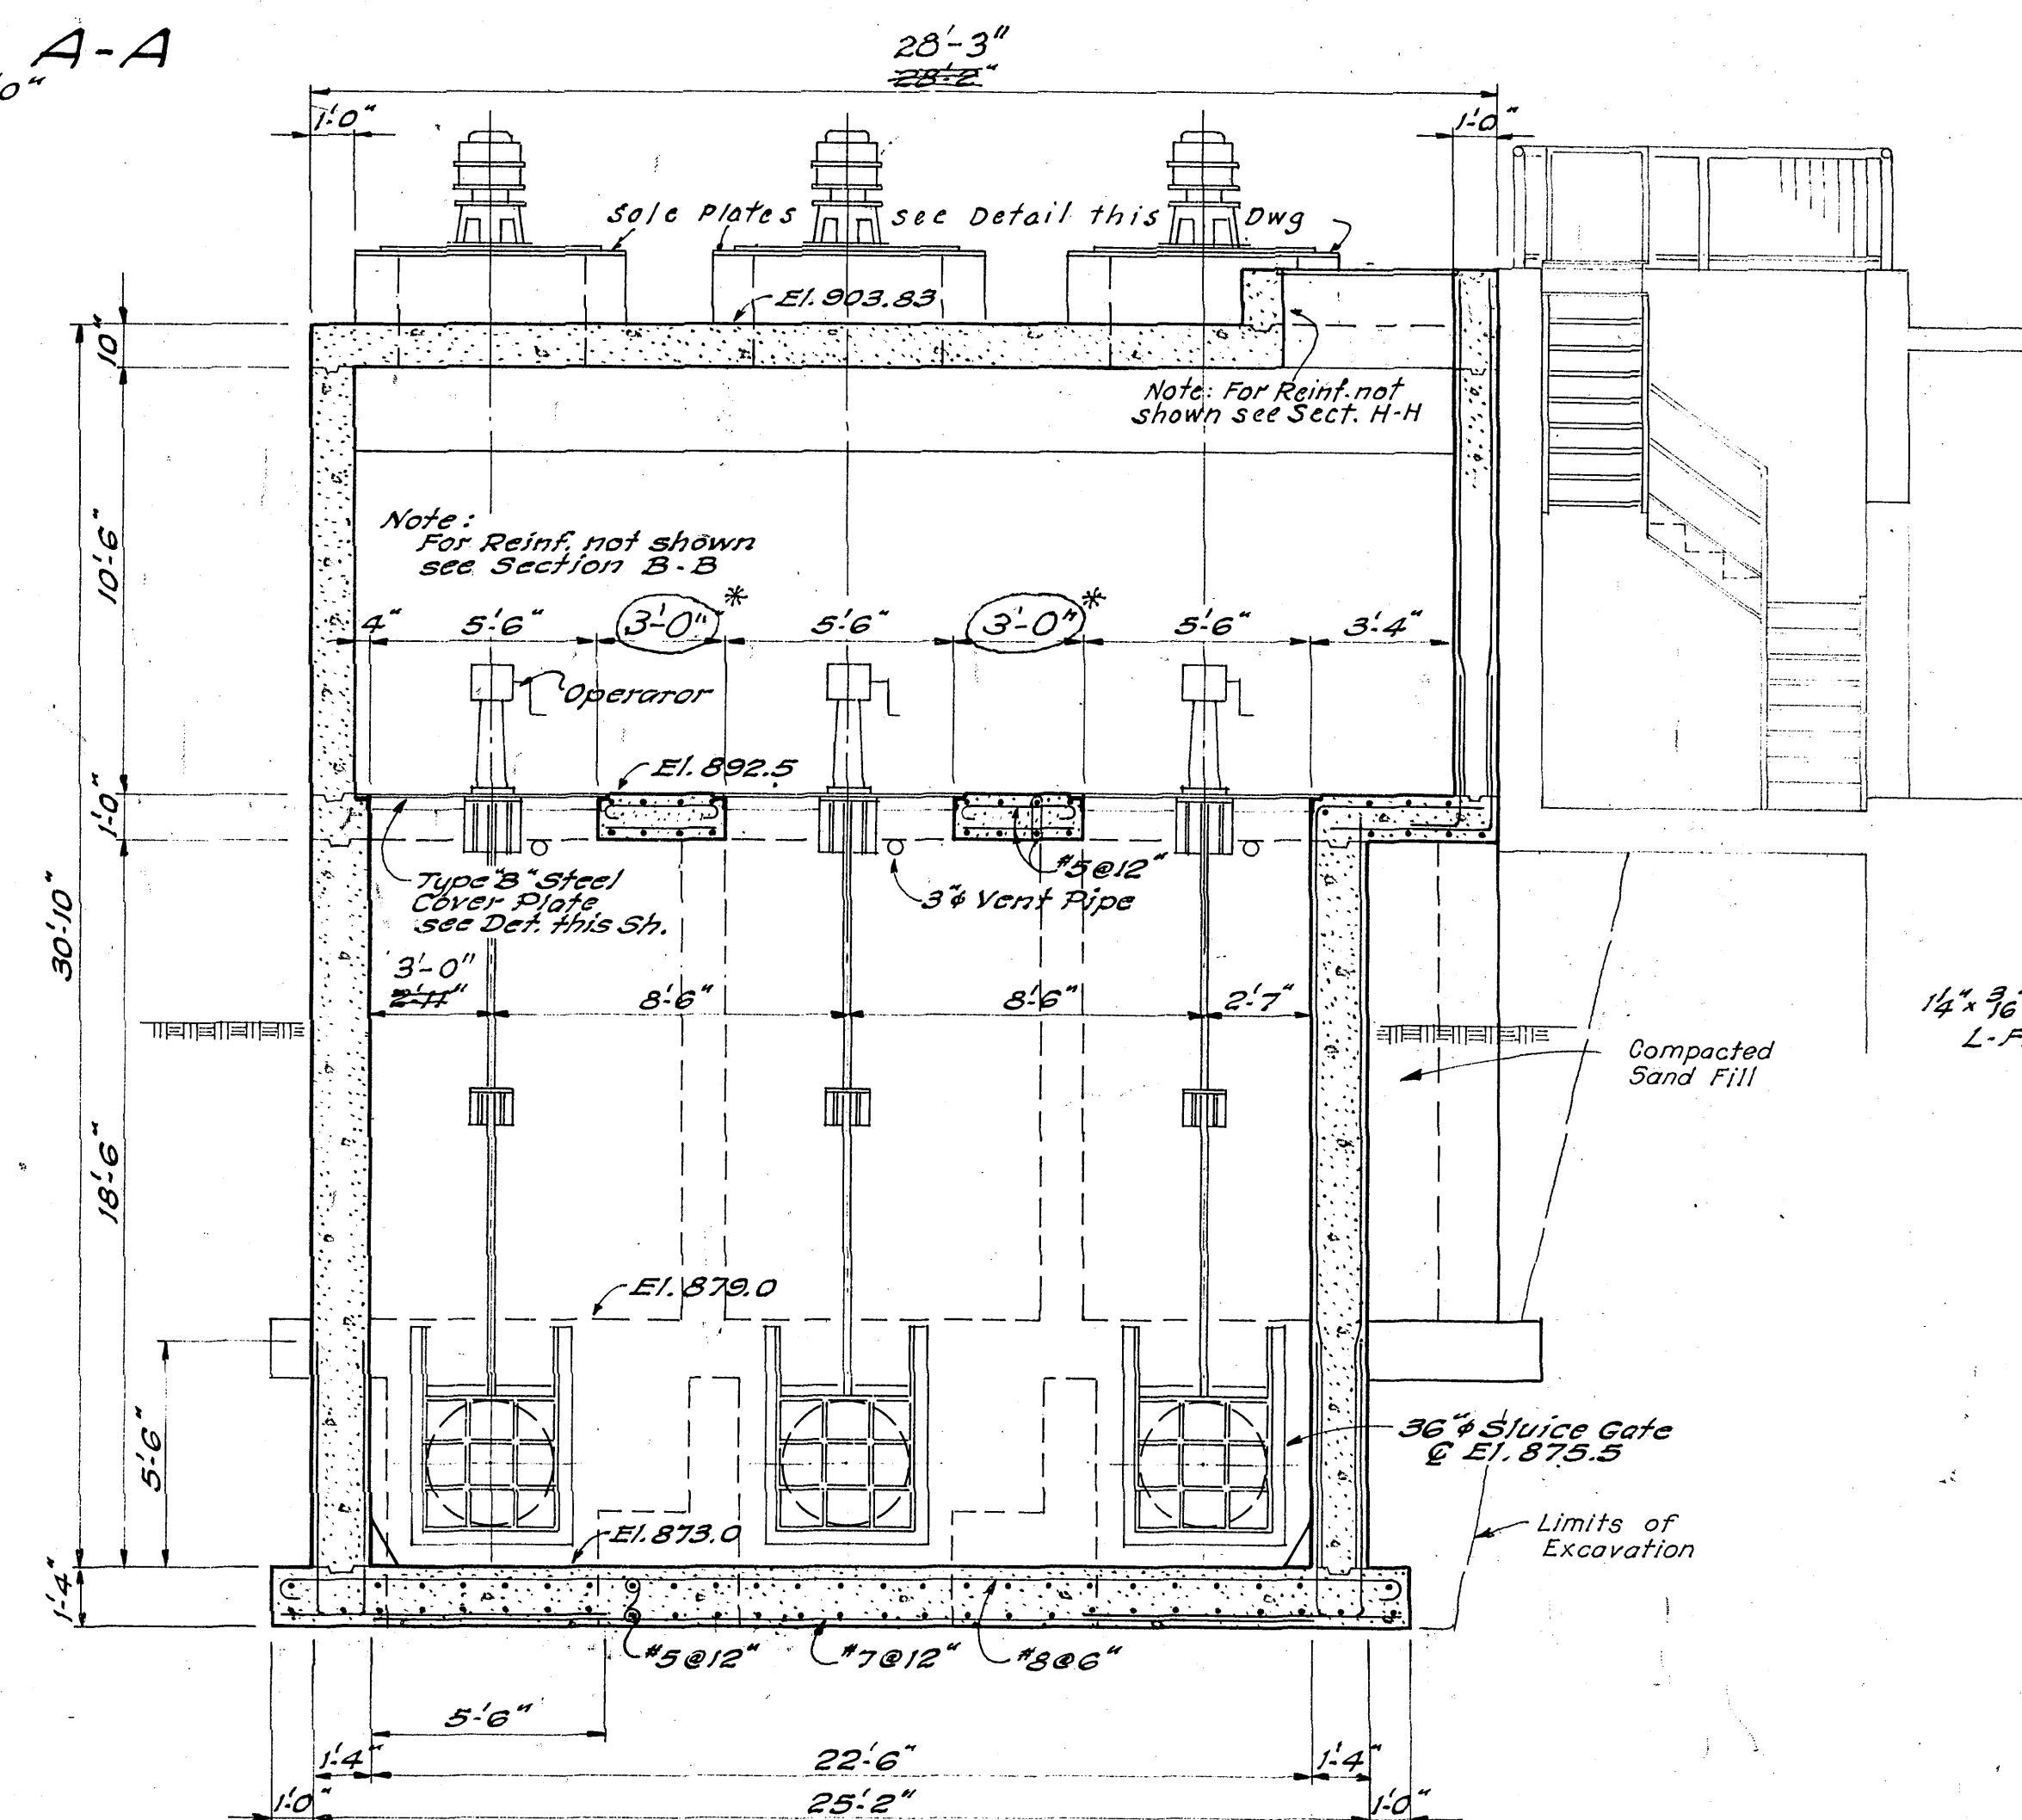

SECTION C-C
Scale: 1/4" = 1'-0"

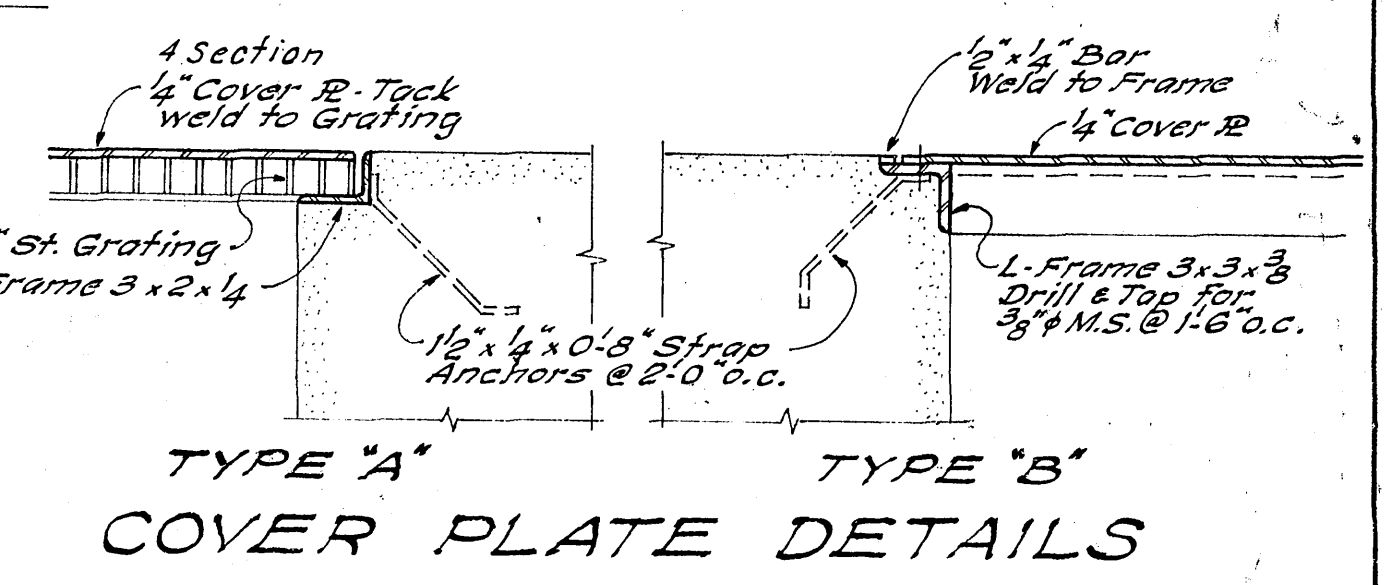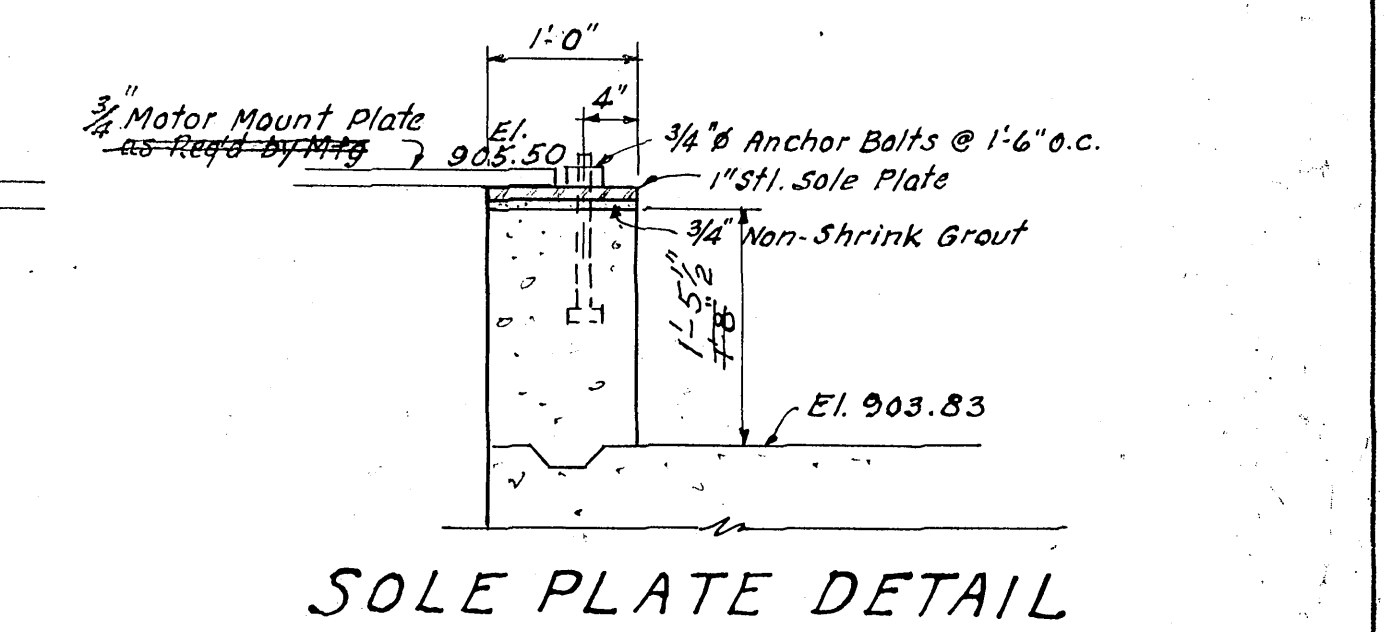

TYPE 'B' COVER PLATE DETAILS

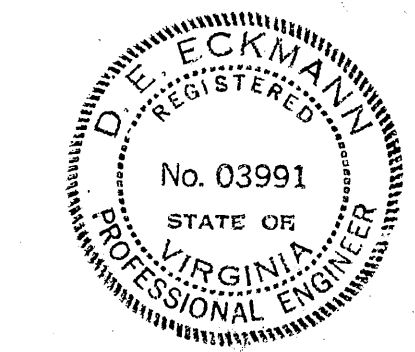

AS BUILT 4

CONTR. "C"

ADDITIONS TO SEWAGE TREATMENT PLANT
ROANOKE, VIRGINIA

**COMMUNUTORS AND
SUCTION WELL SECTIONS**

ALVORD, BURDICK & HOWSON
ENGINEERS CHICAGO

1973

* Revised 5/25/73