

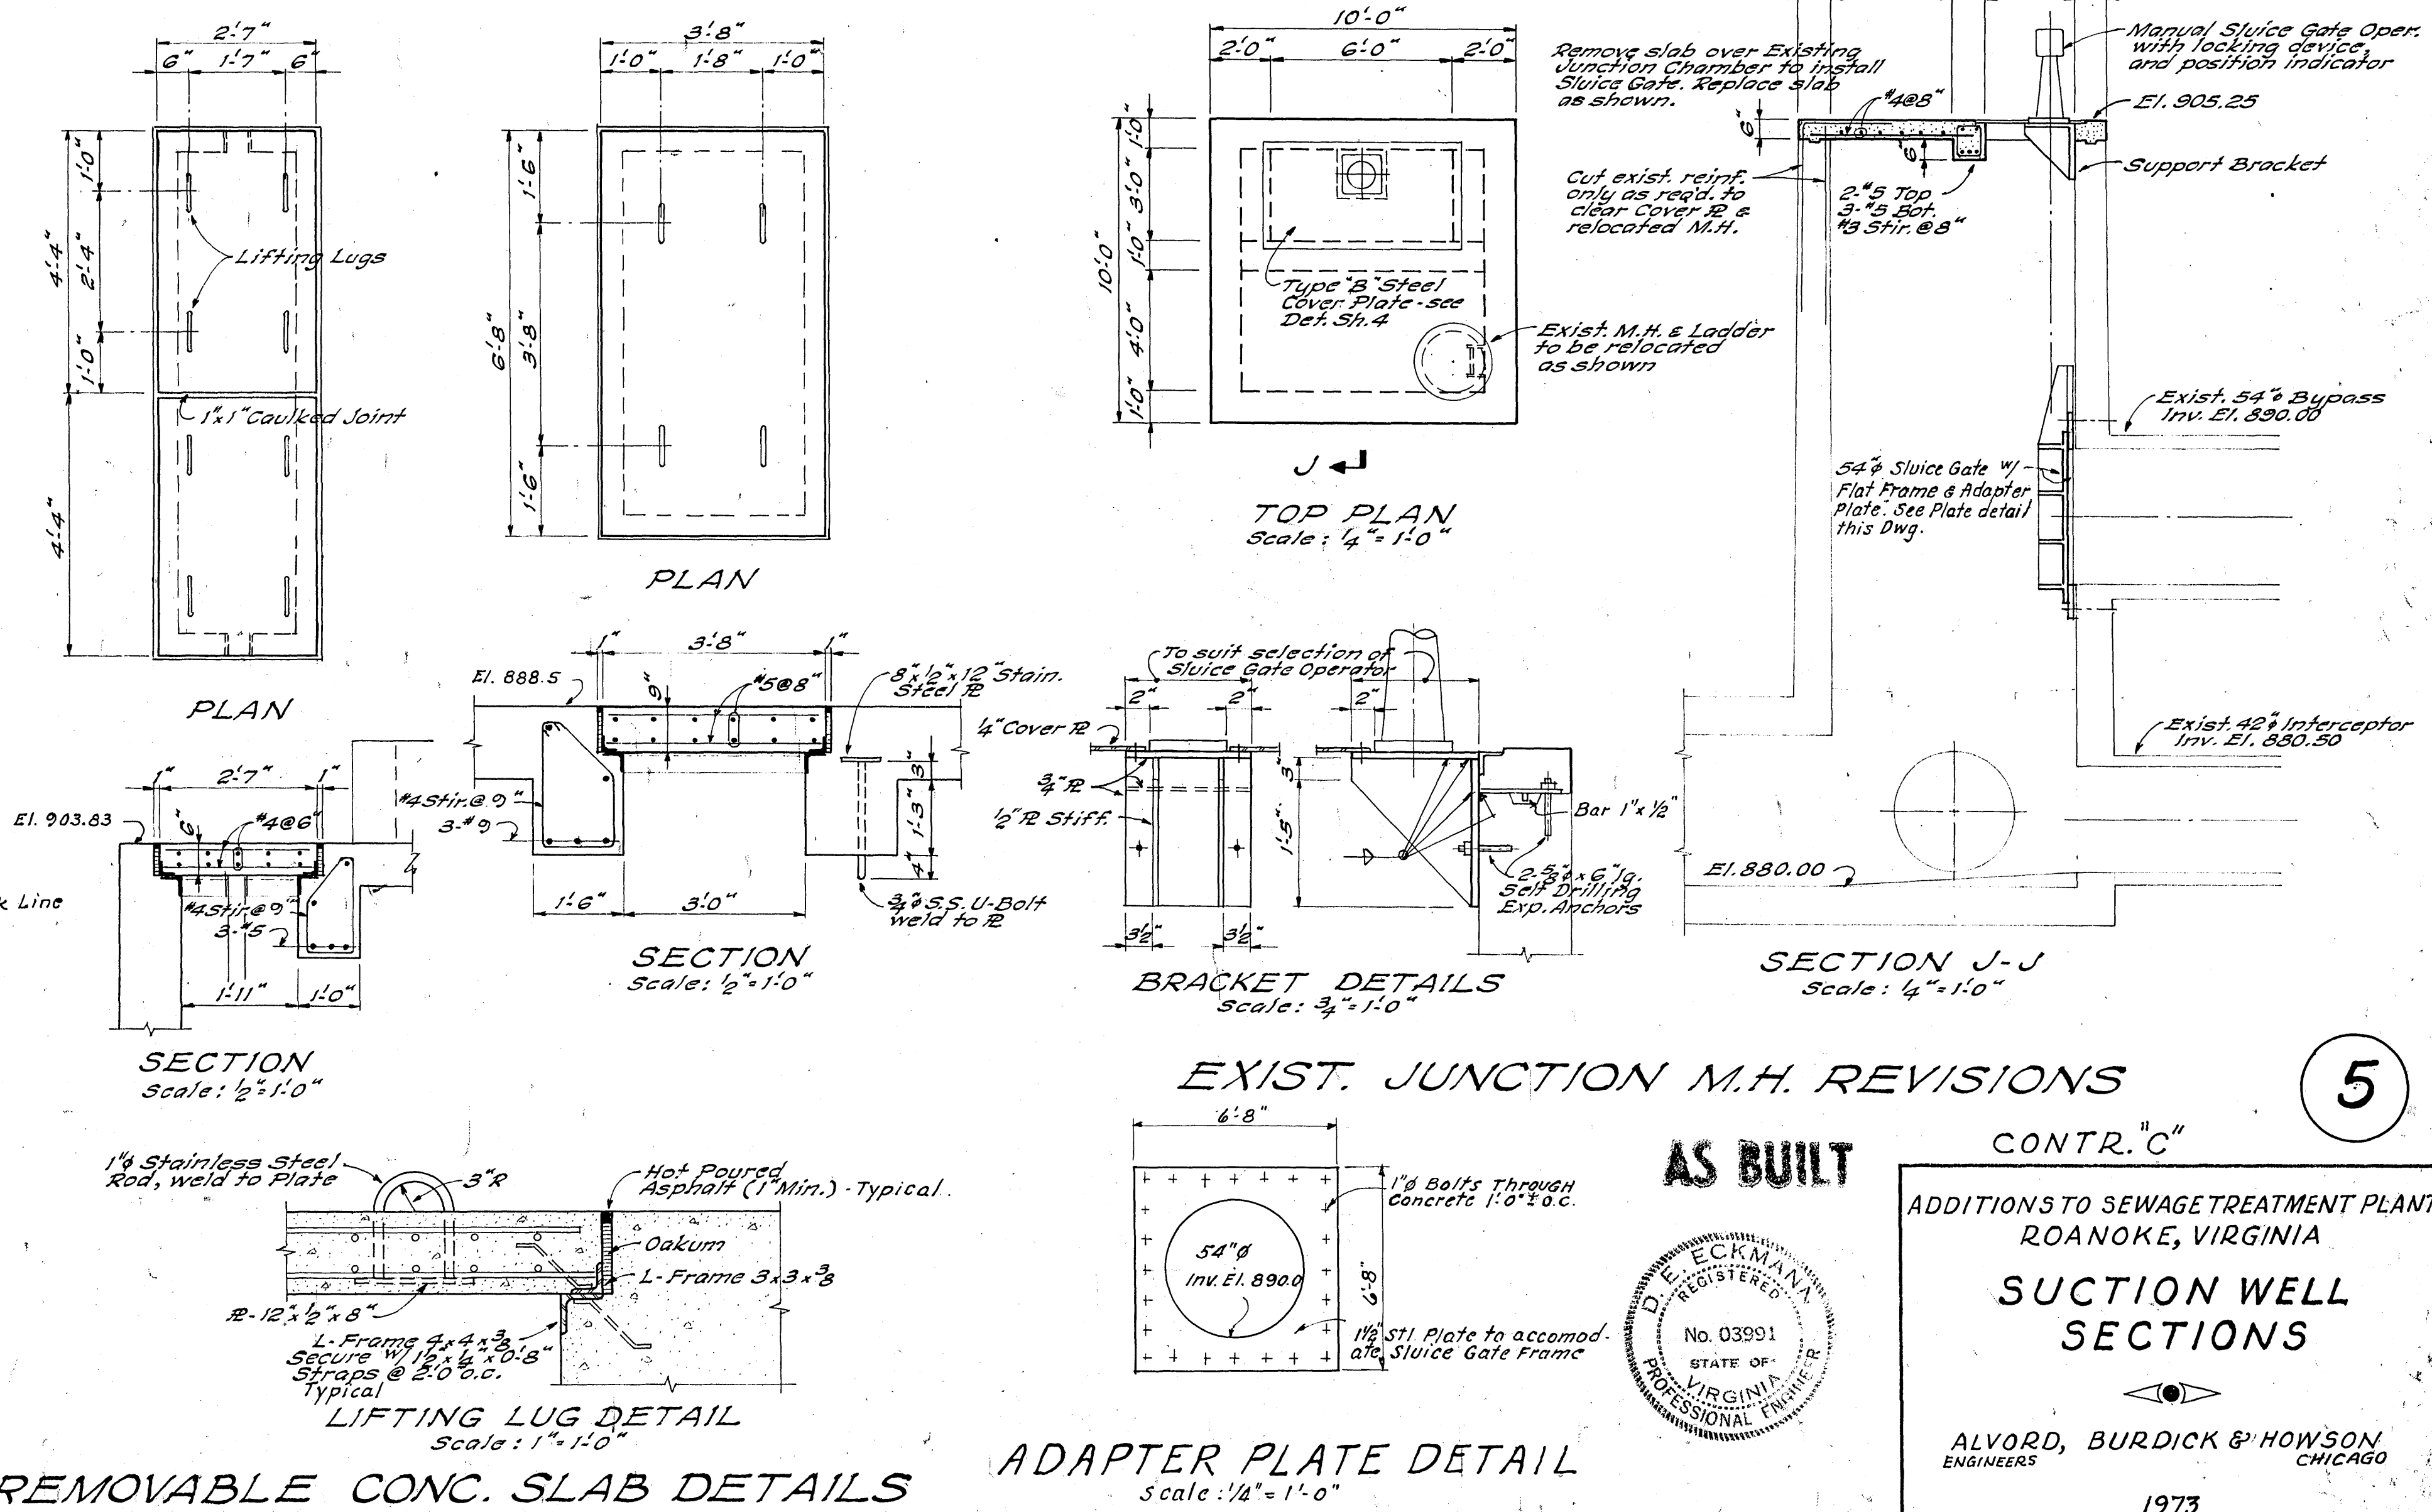
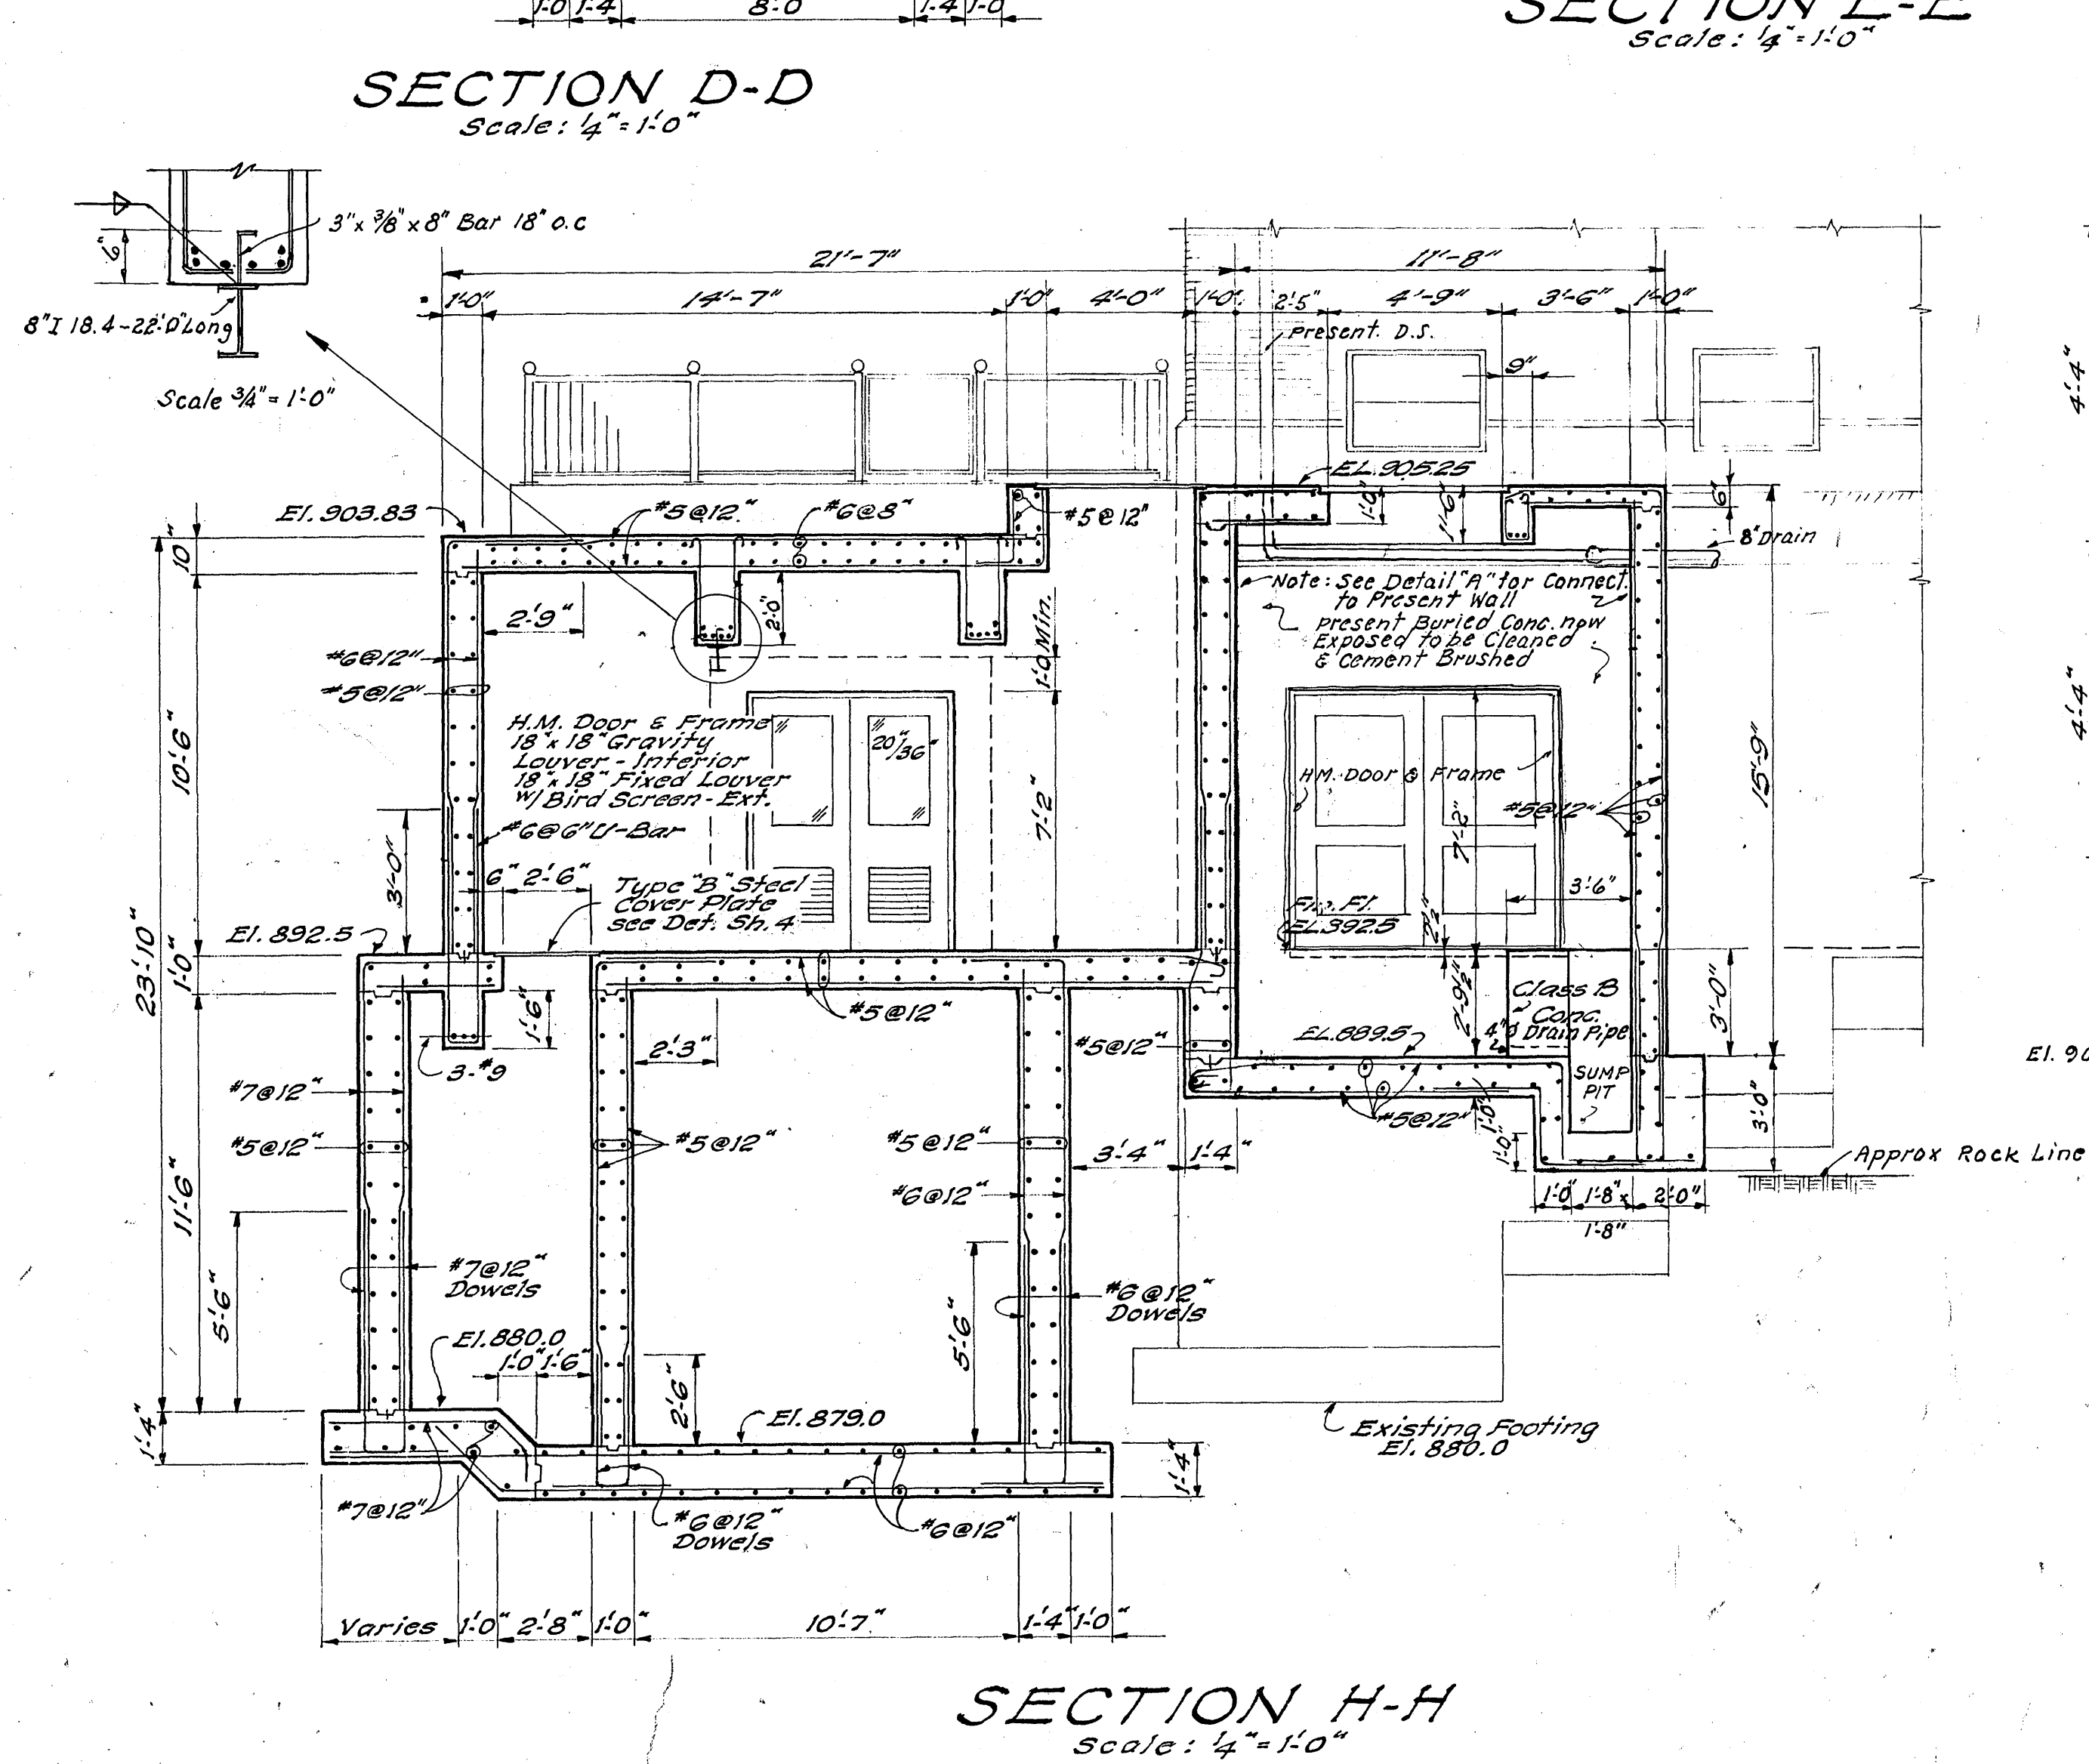


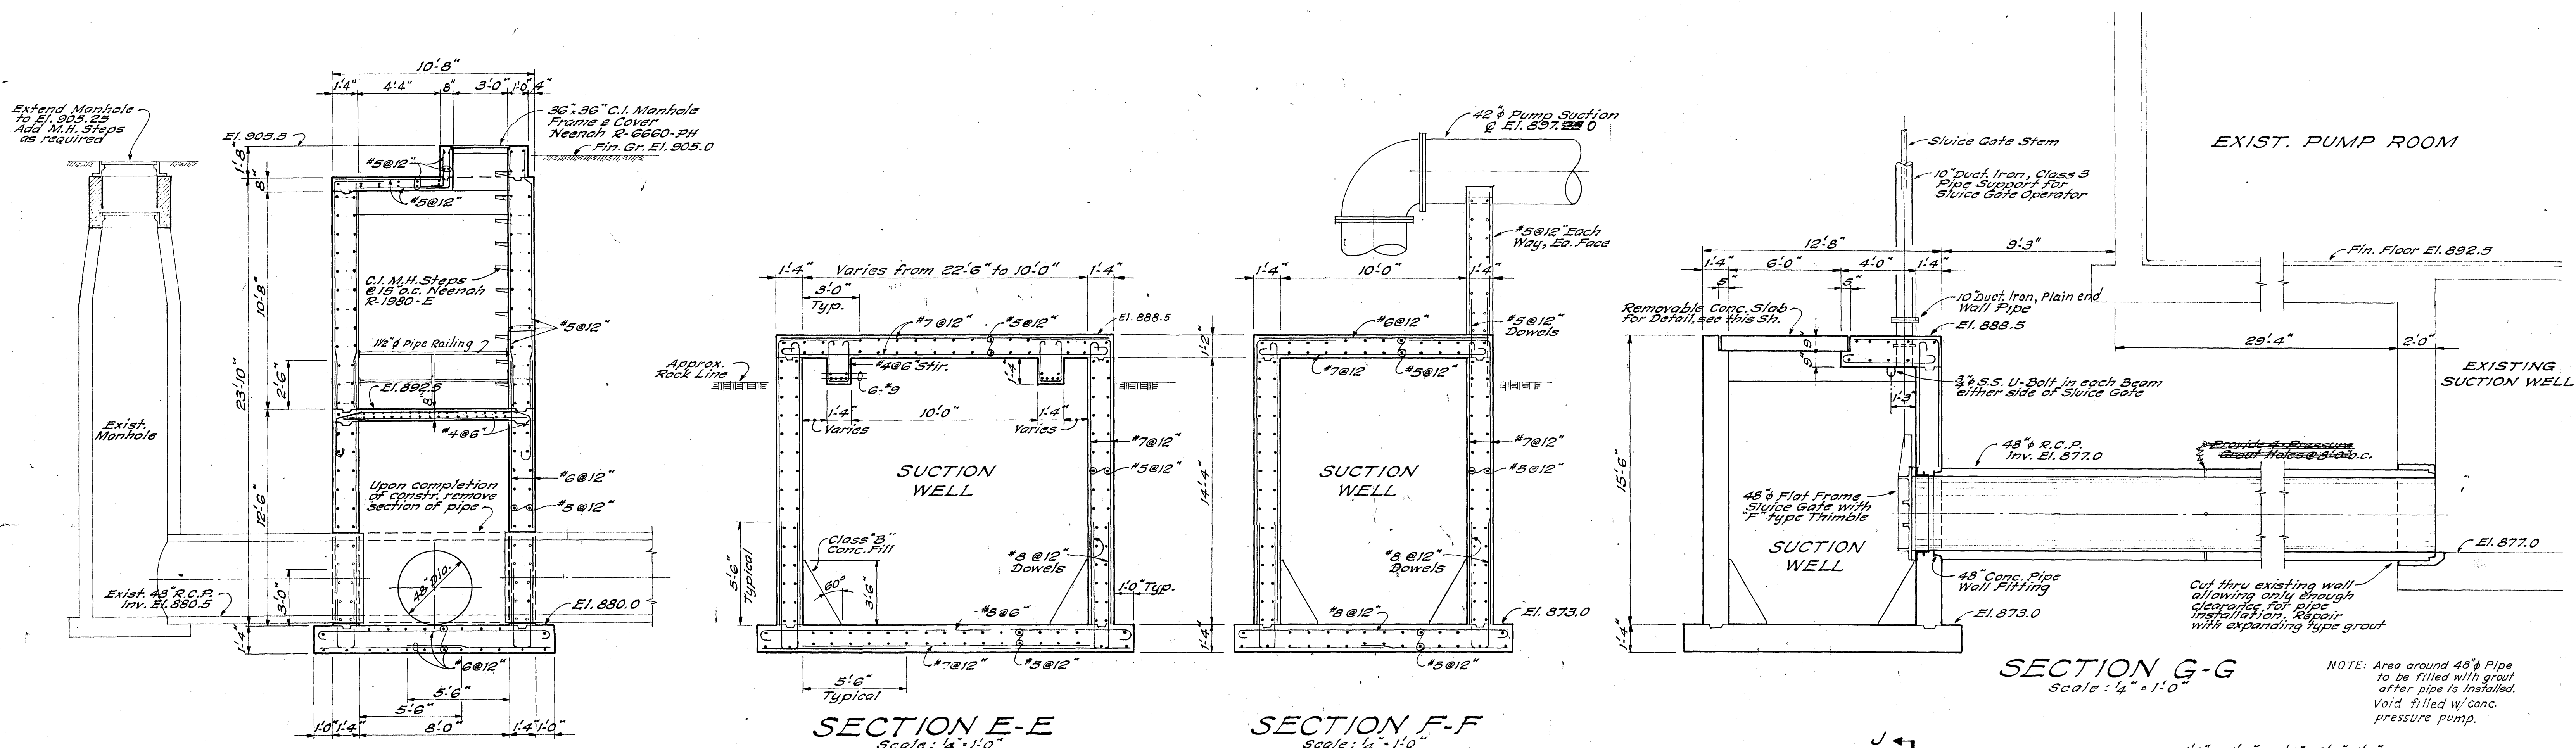

AS BUILT

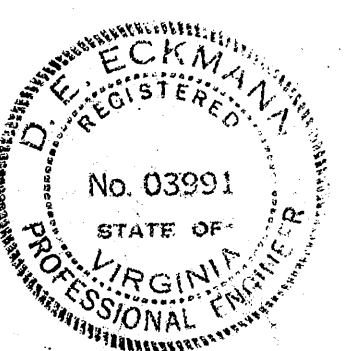

CONTR. "C"

ADDITIONS TO SEWAGE TREATMENT PLANT
ROANOKE, VIRGINIA

SUCTION WELL SECTIONS

ALVORD, BURDICK & HOWSON
ENGINEERS CHICAGO

1973