



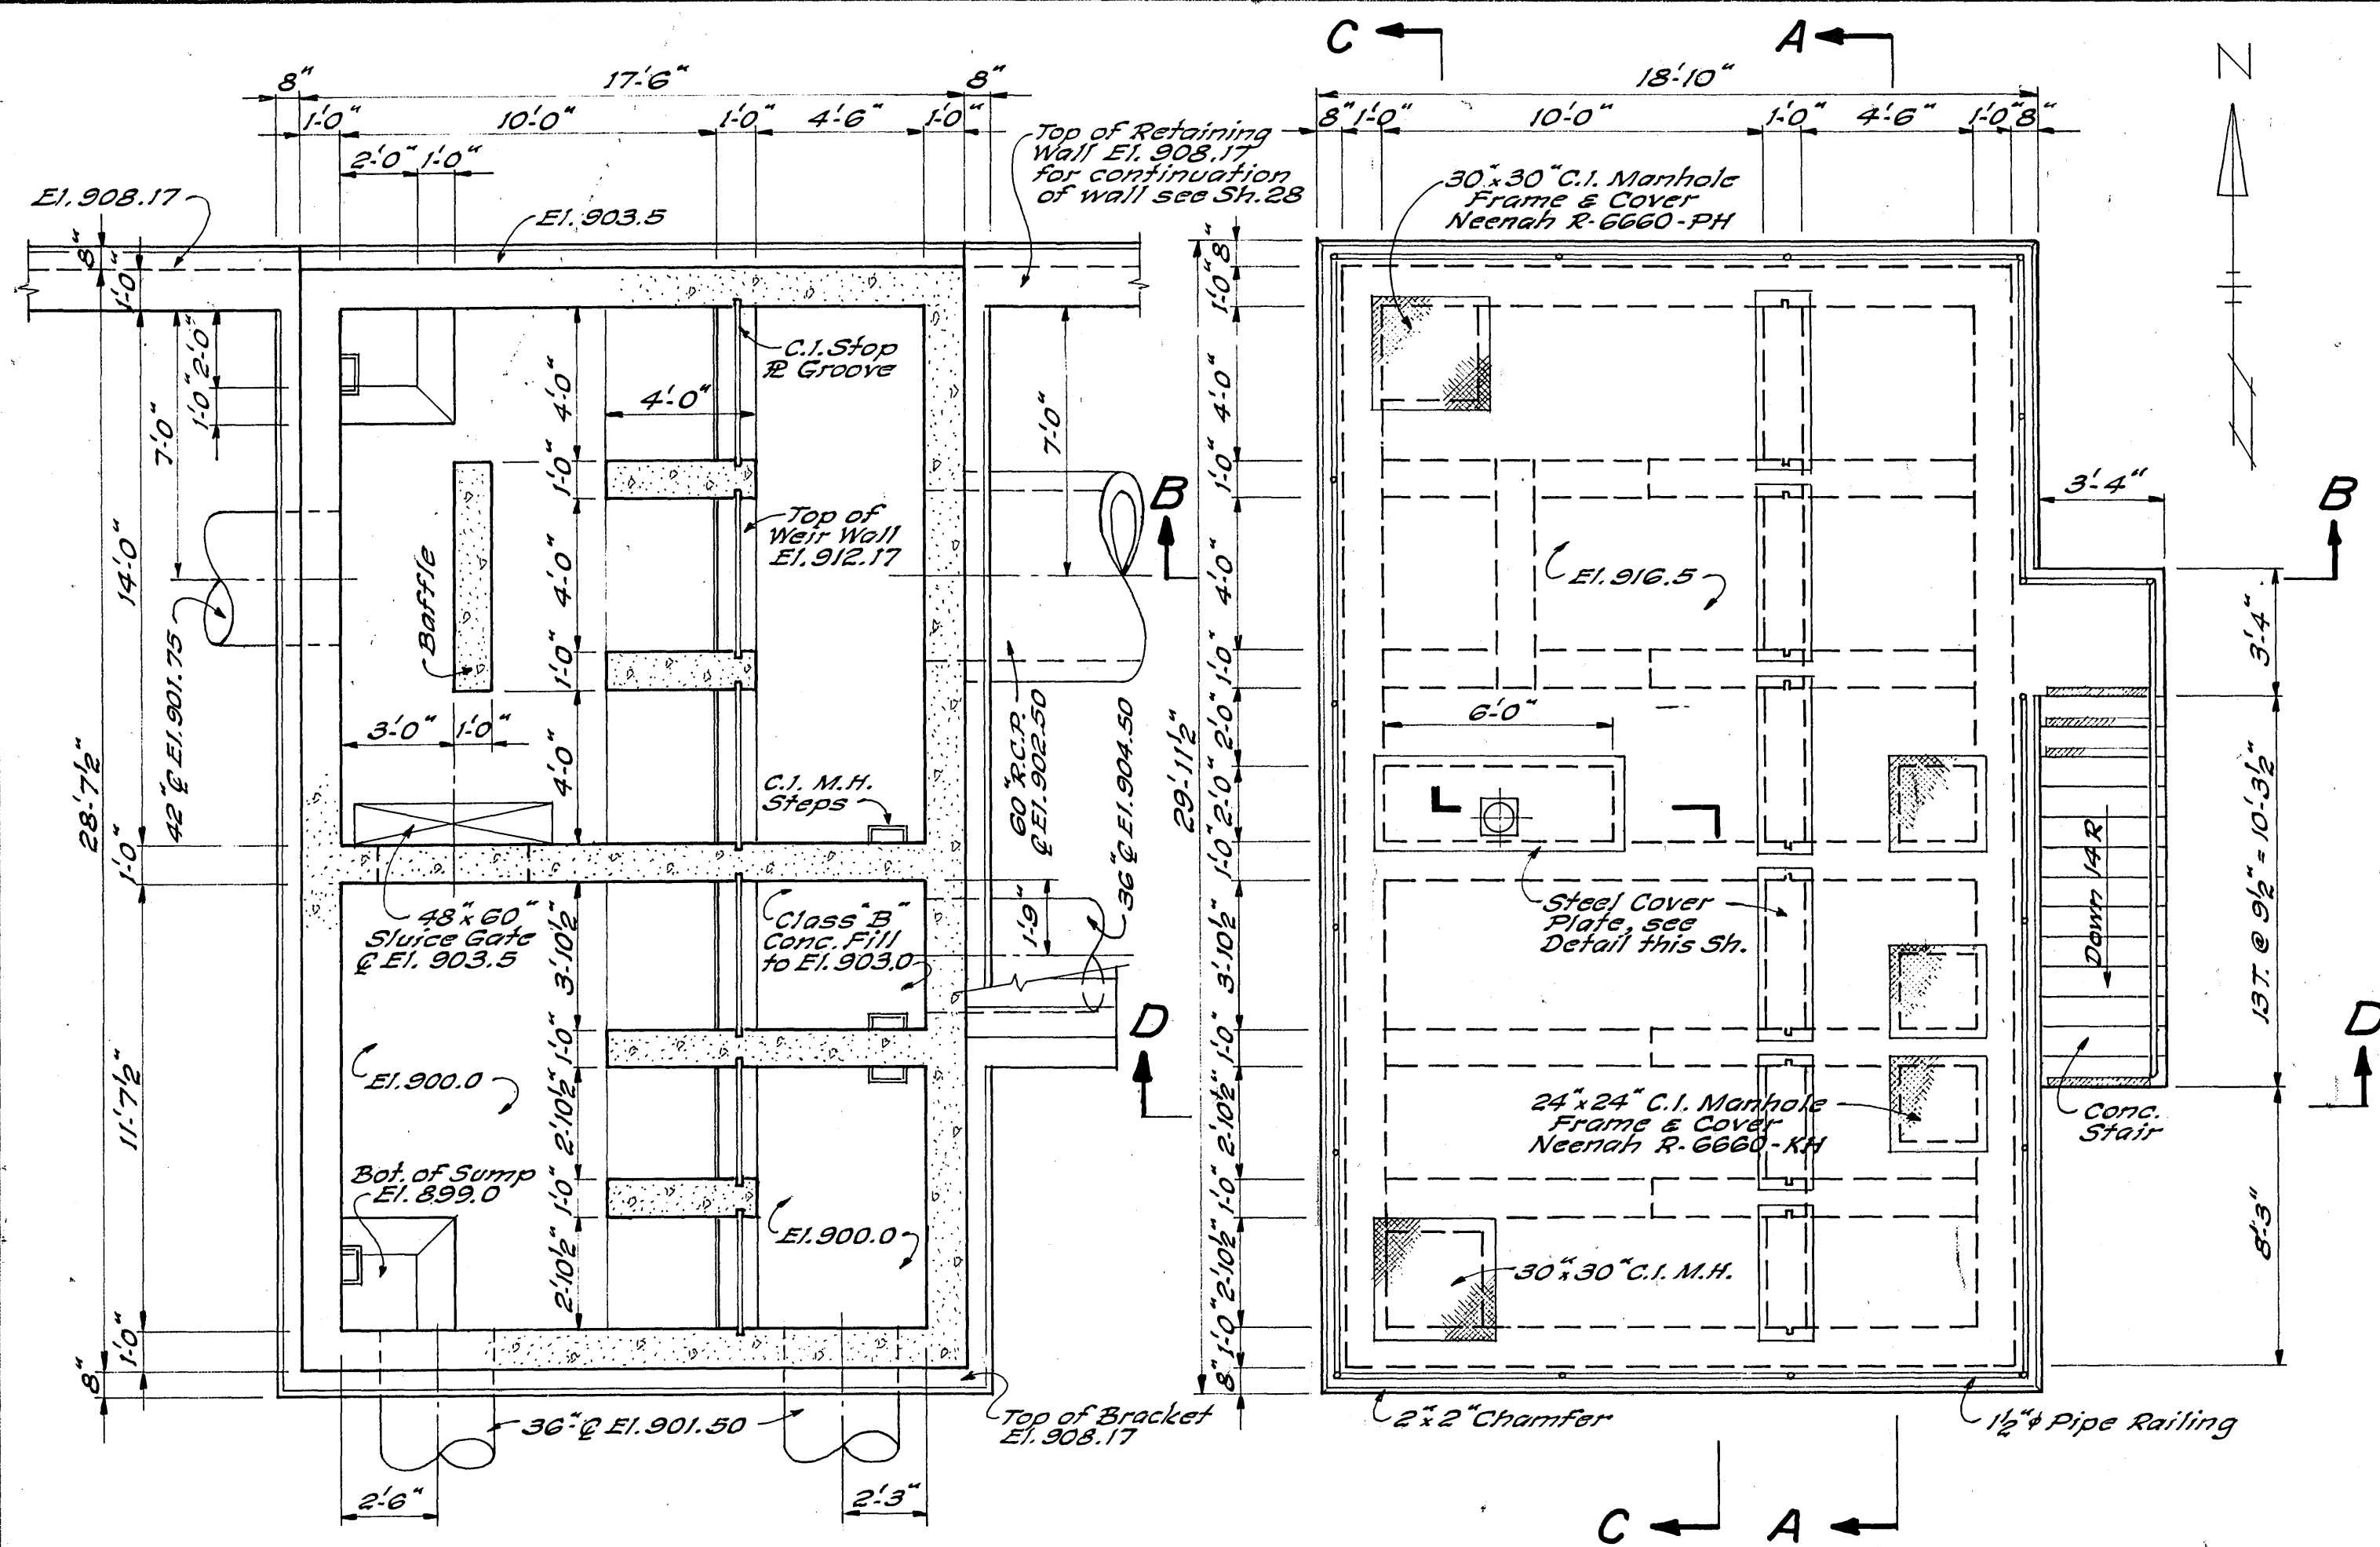


SECTIONAL PLAN
Scale: 1/4" = 1'-0"

TOP OF CONC. PLAN
Scale: 1/4" = 1'-0"

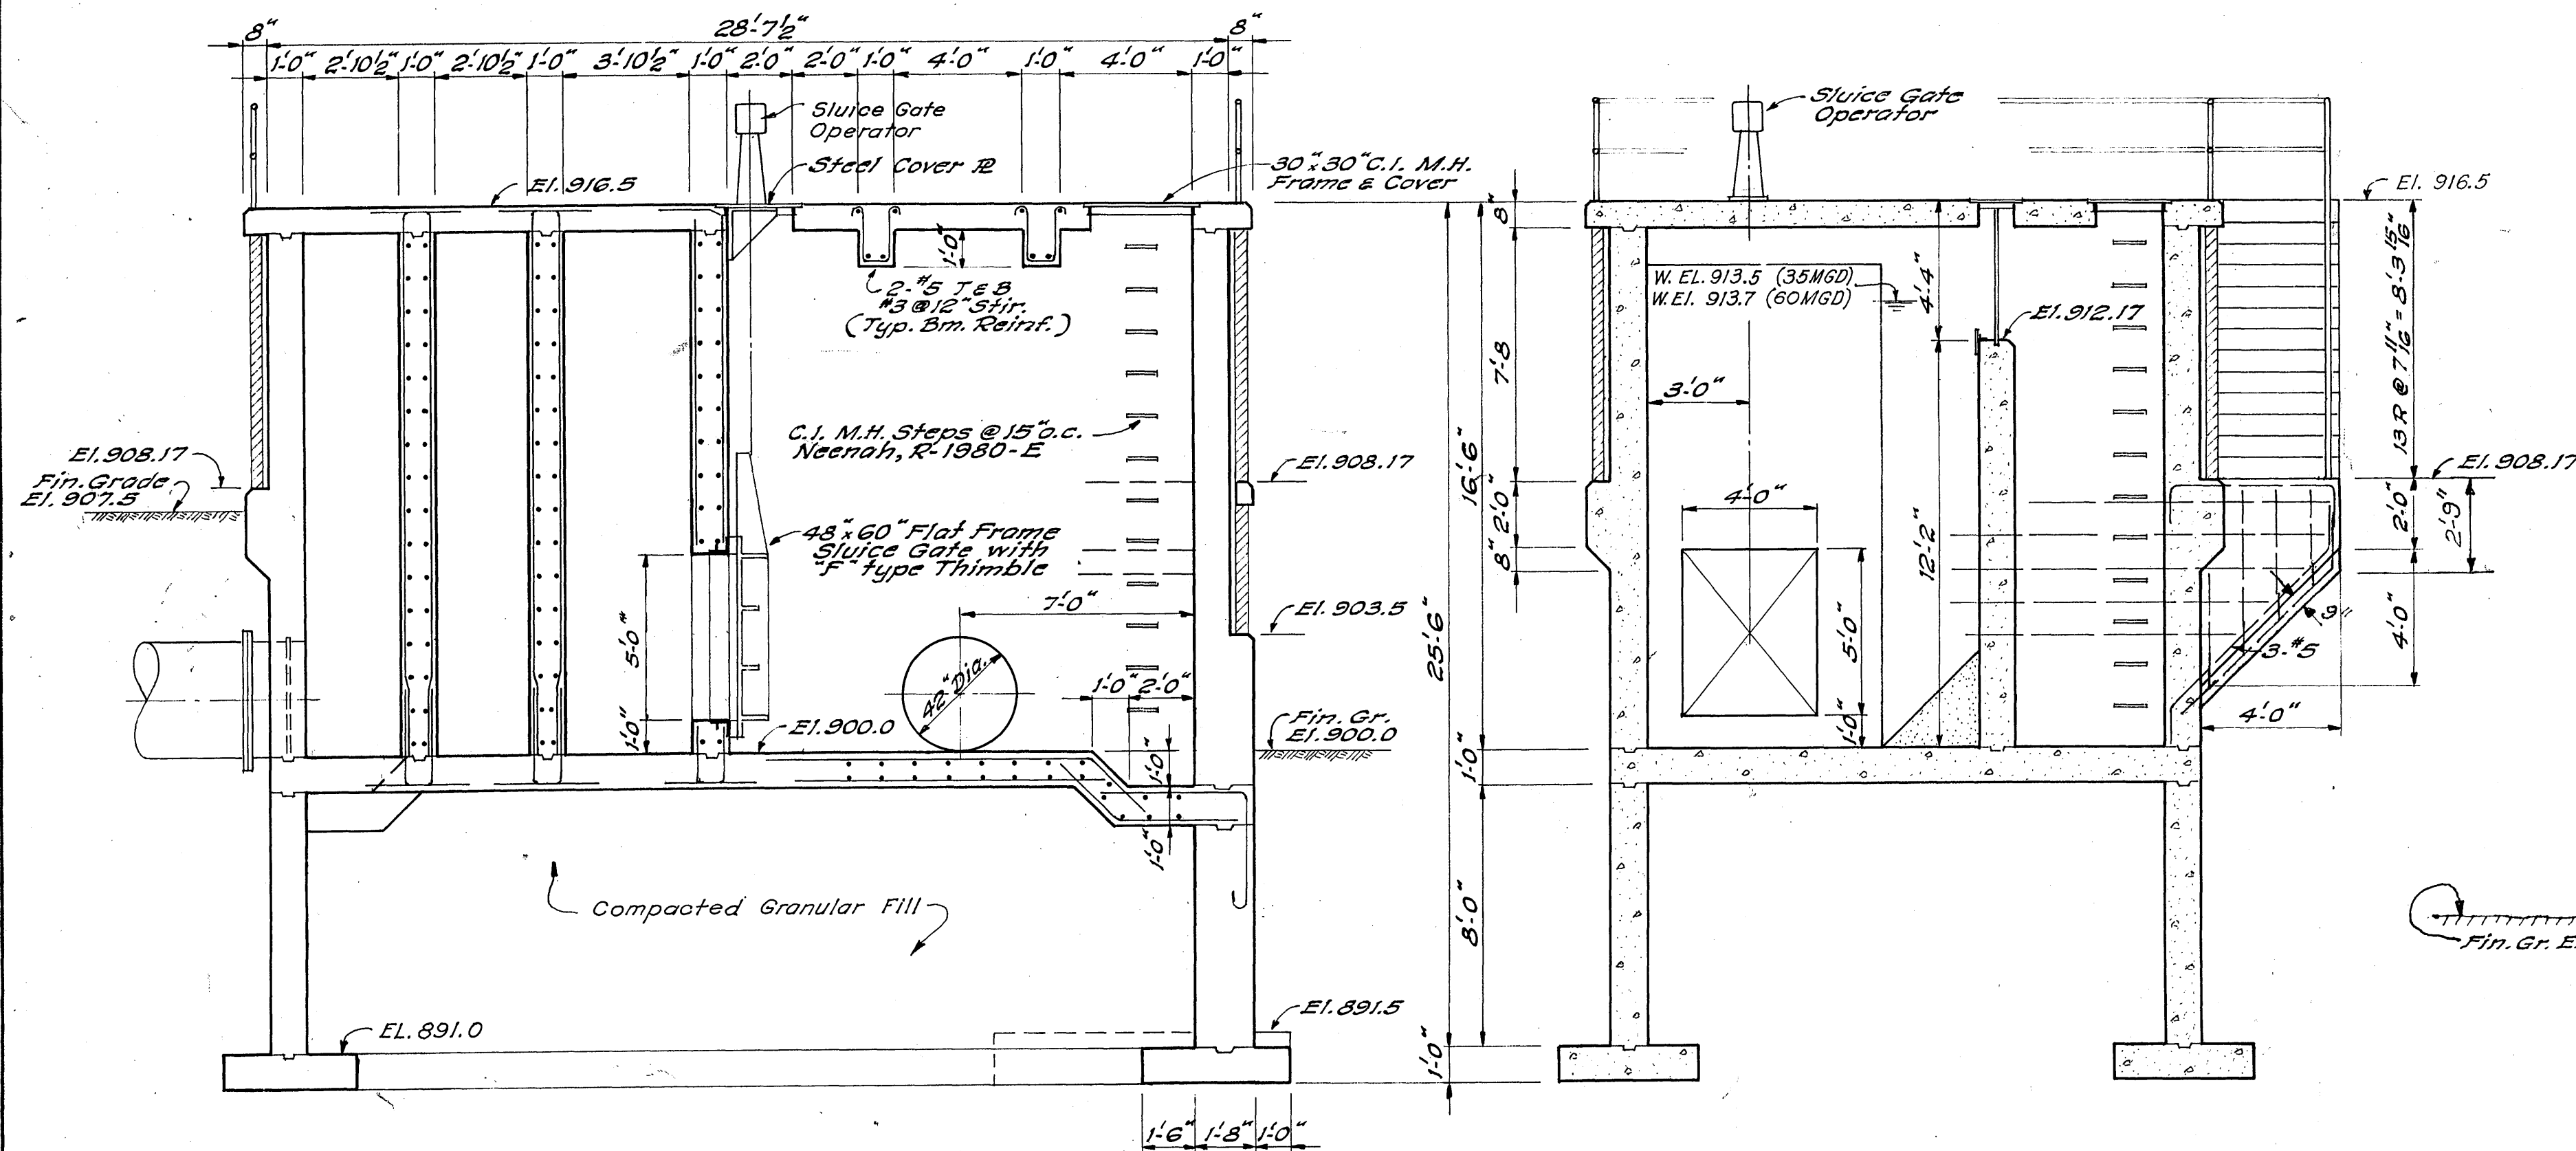


SECTION C-C
Scale: 1/4" = 1'-0"

SECTION D-D
Scale: 1/4" = 1'-0"

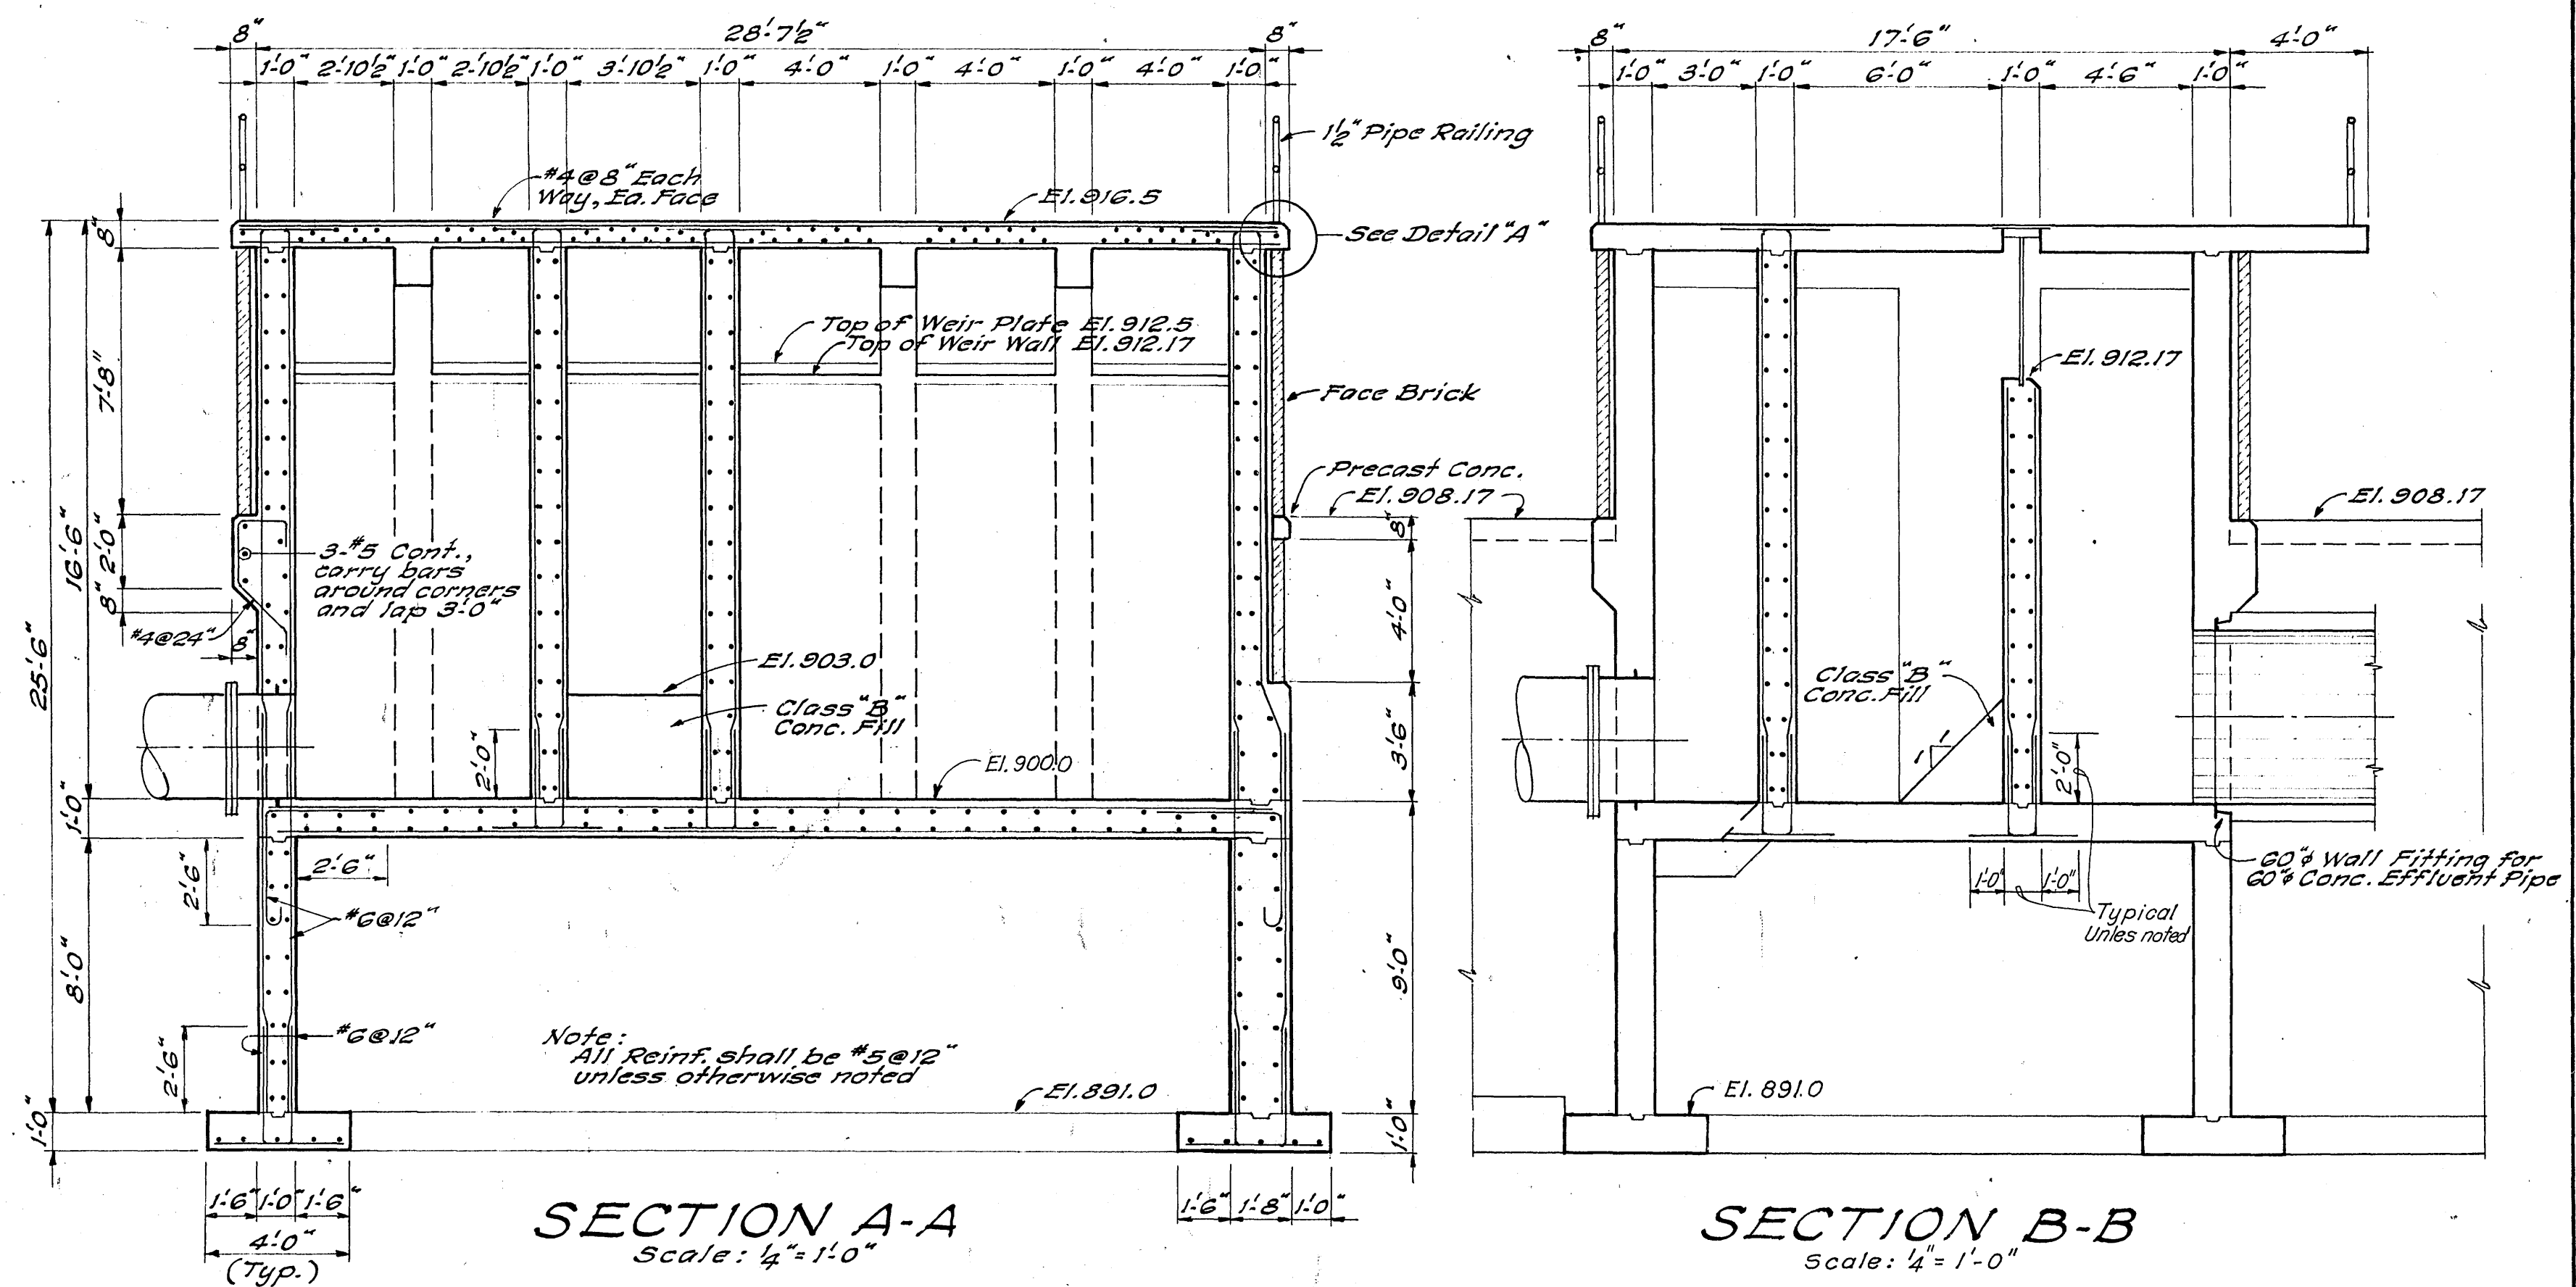


SECTION A-A
Scale: 1/4" = 1'-0"


SECTION B-B
Scale: 1/4" = 1'-0"

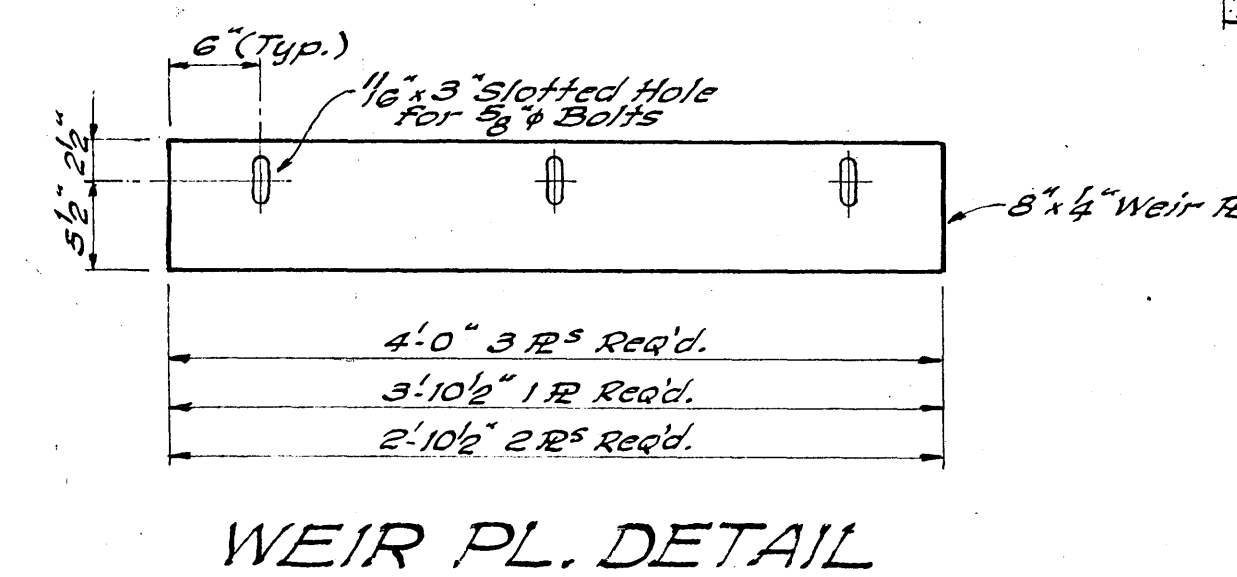


WEIR PL. DETAIL

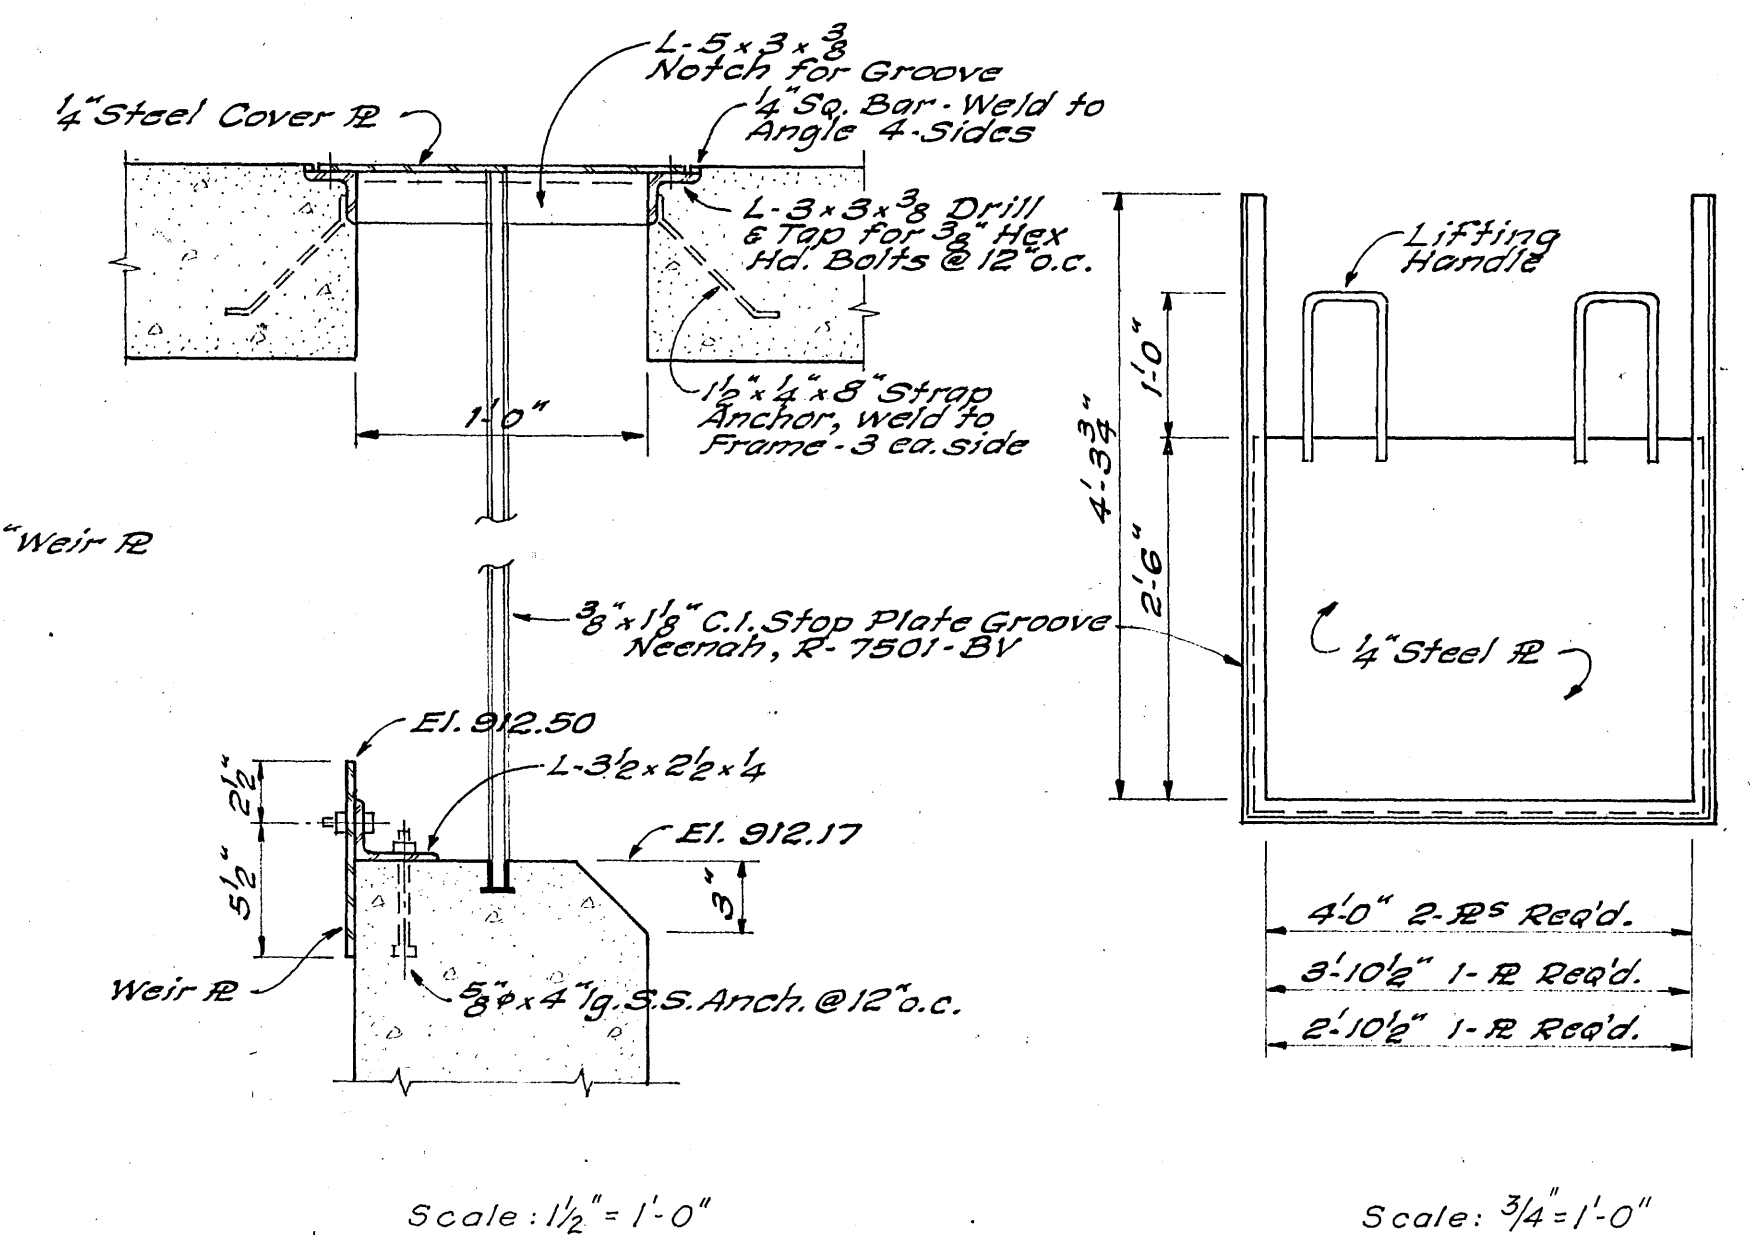

SLIDE GATE DETAIL

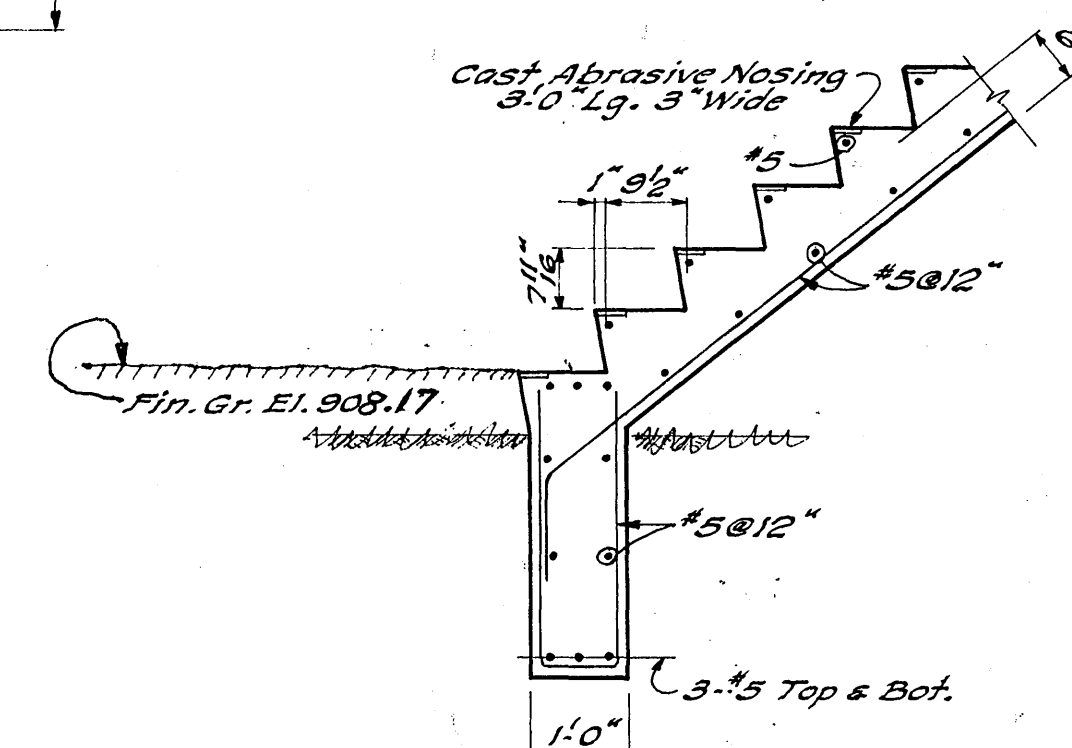

CONC. STAIR DETAIL

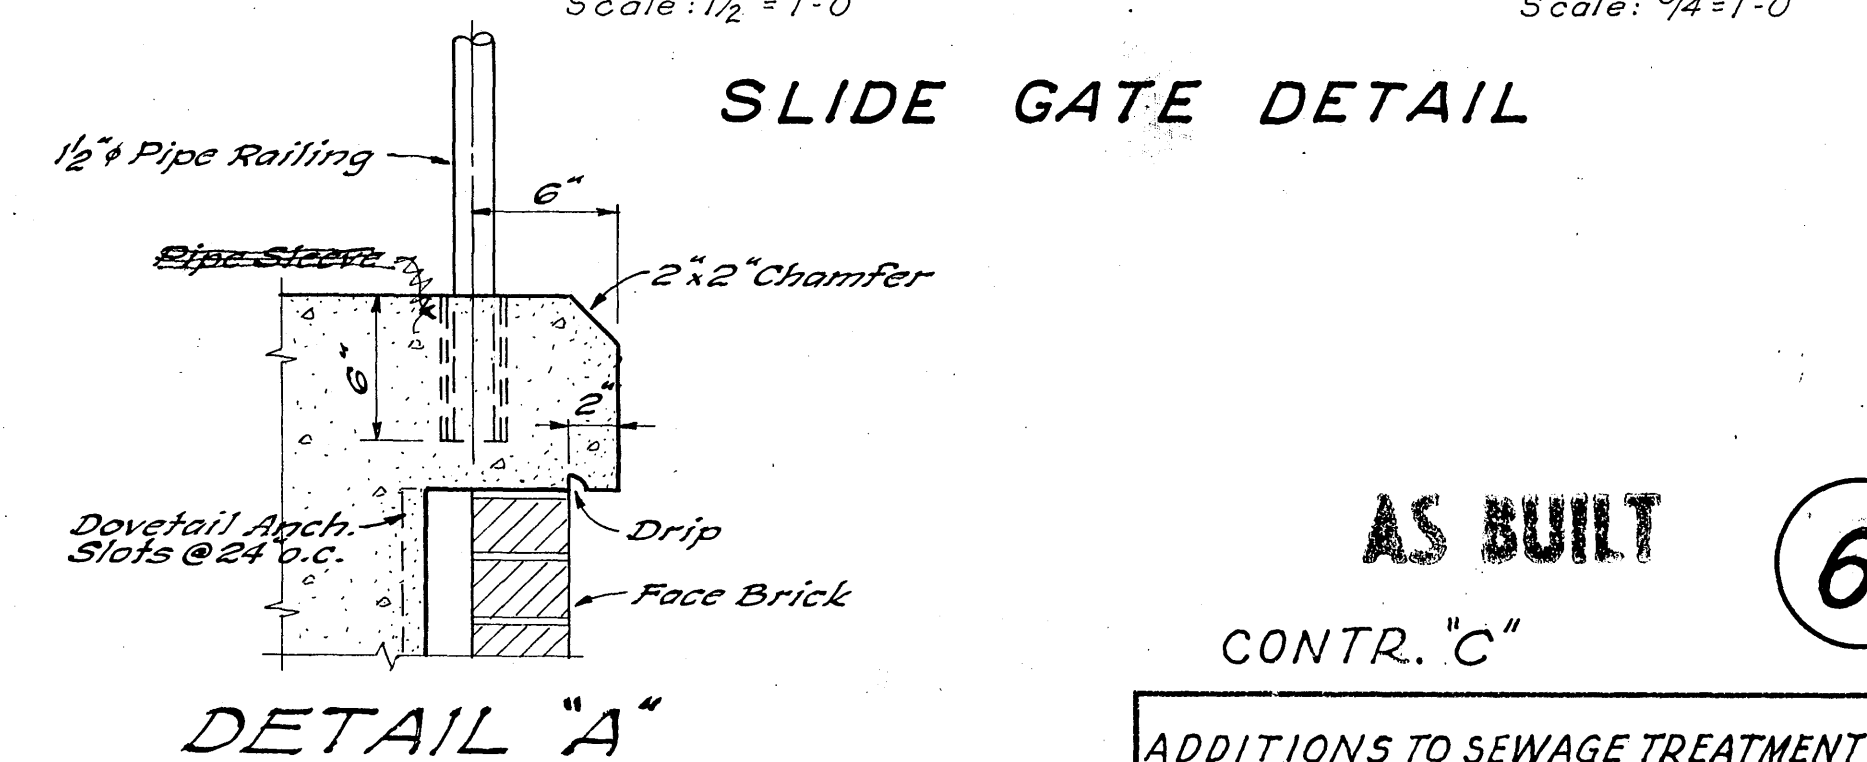

DETAIL "A"

AS BUILT

CONTR. "C"

ADDITIONS TO SEWAGE TREATMENT PLANT
ROANOKE, VIRGINIA

SPLITTER CHAMBER

ALVORD, BURDICK & HOWSON
ENGINEERS CHICAGO

1973

