




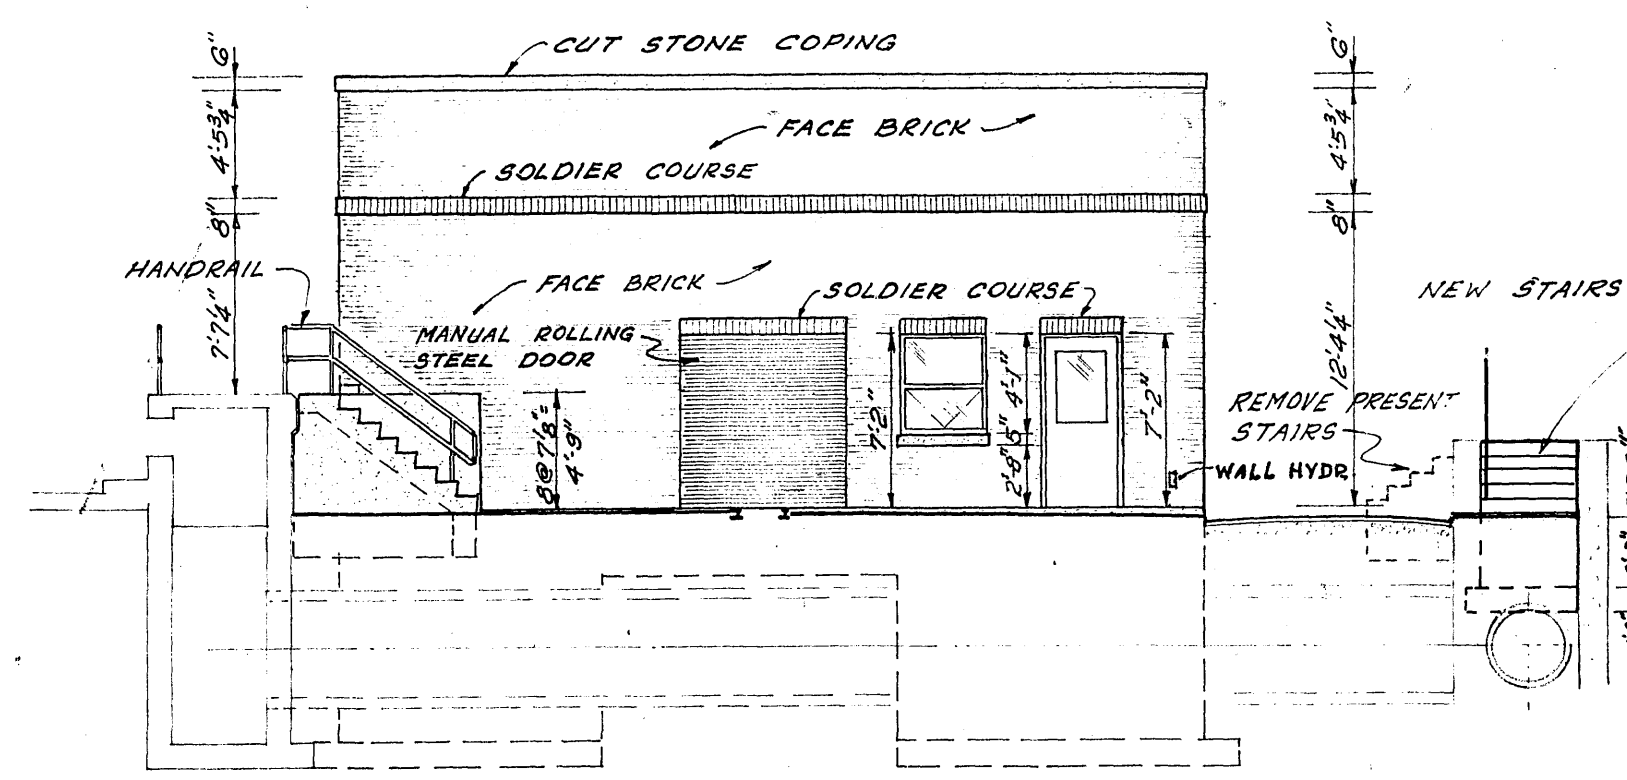


SOUTH ELEVATION
SCALE: 1/8"=1'-0"

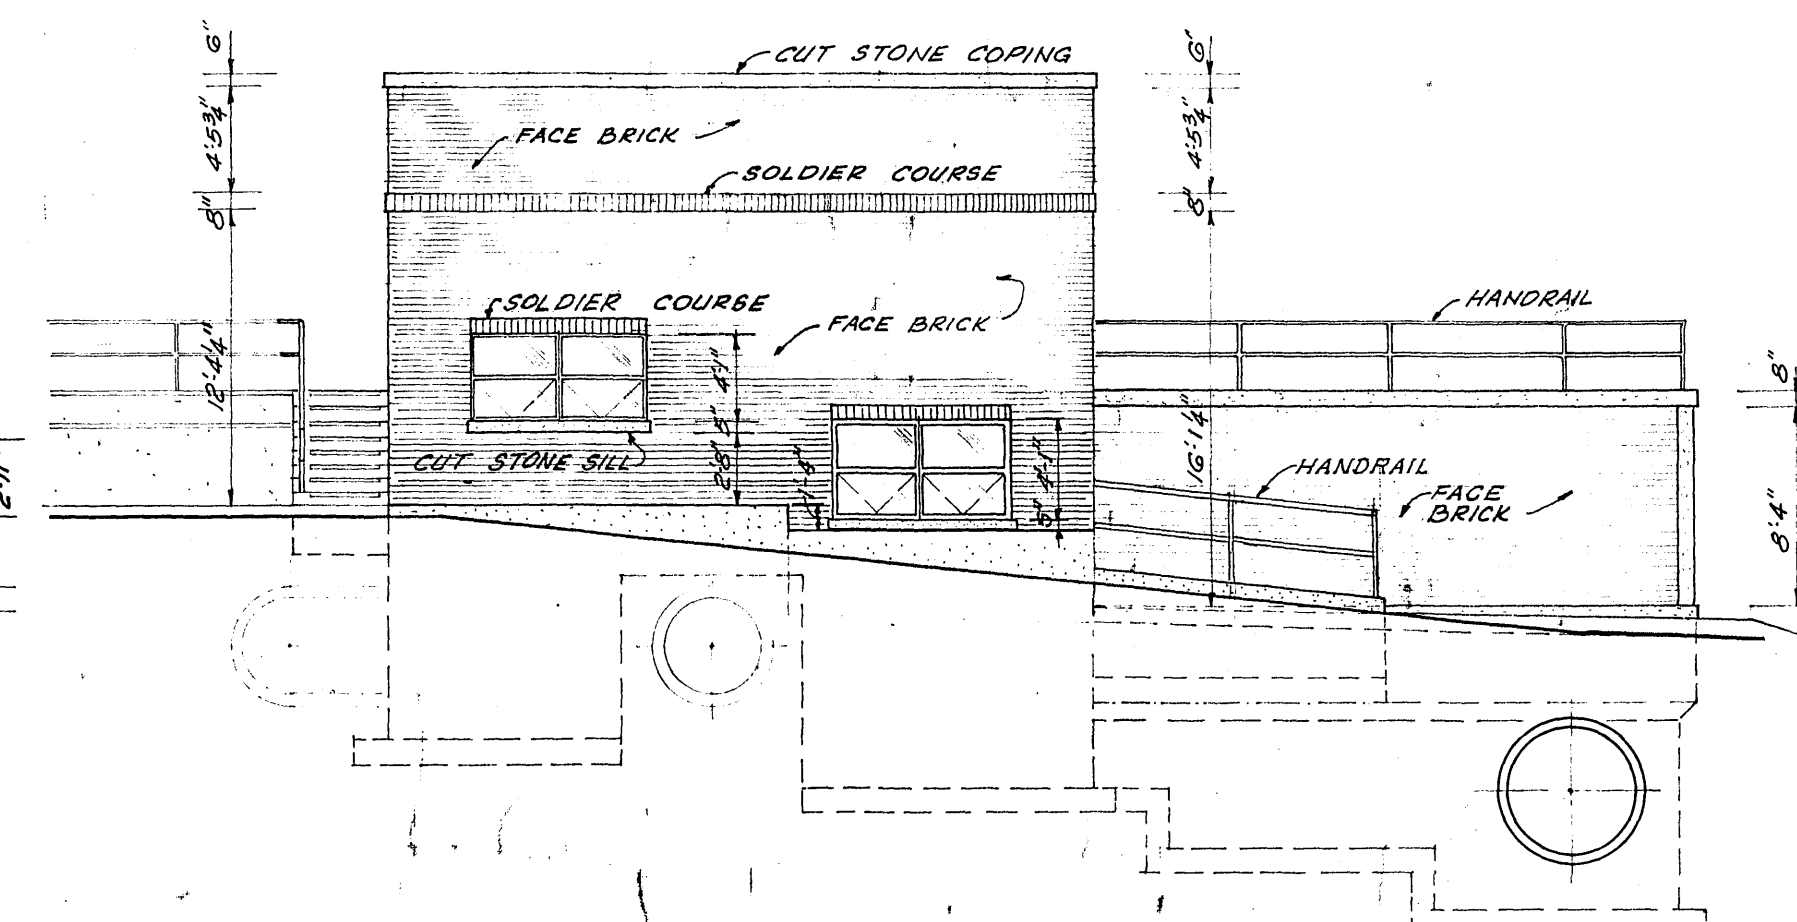


EAST ELEVATION
SCALE: 1/8"=1'-0"

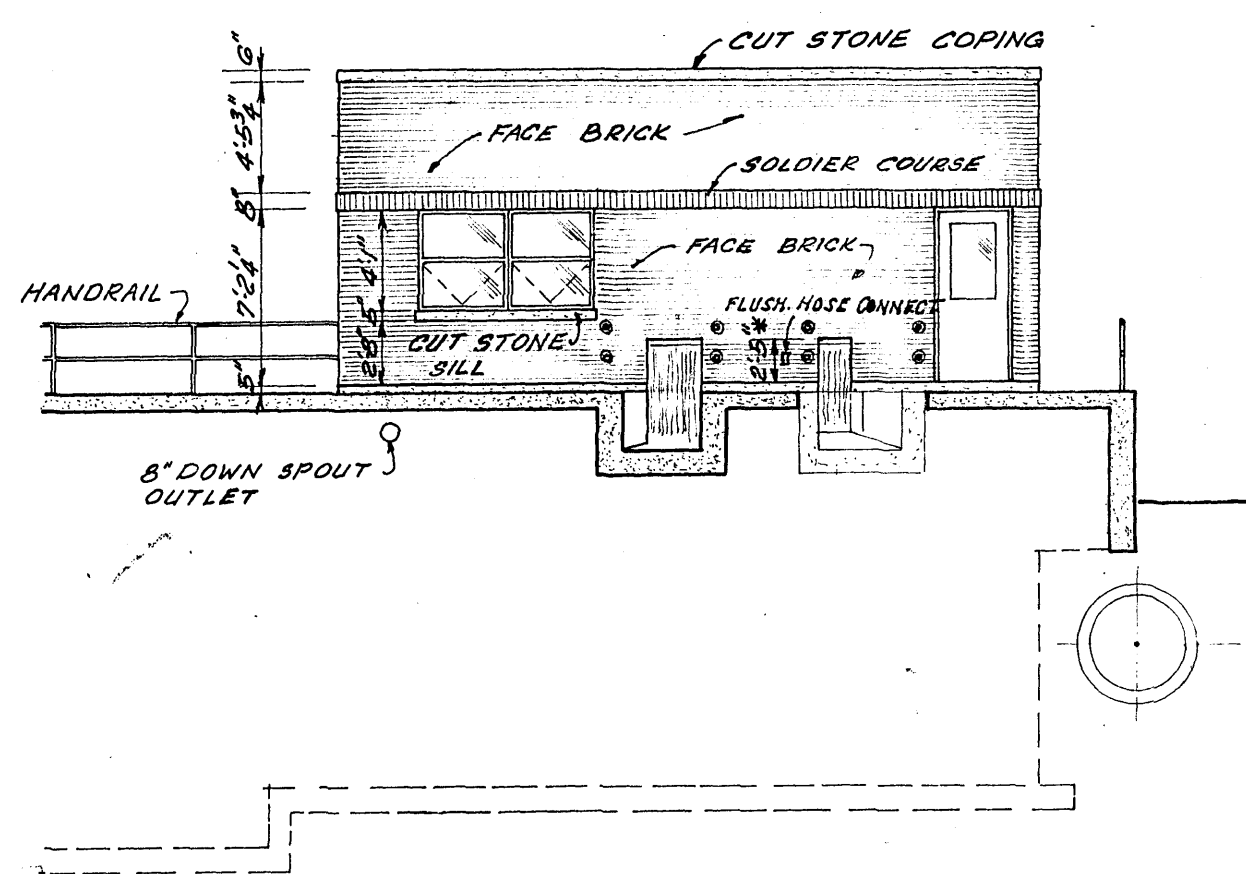

WEST ELEVATION
SCALE: 1/8"=1'-0"

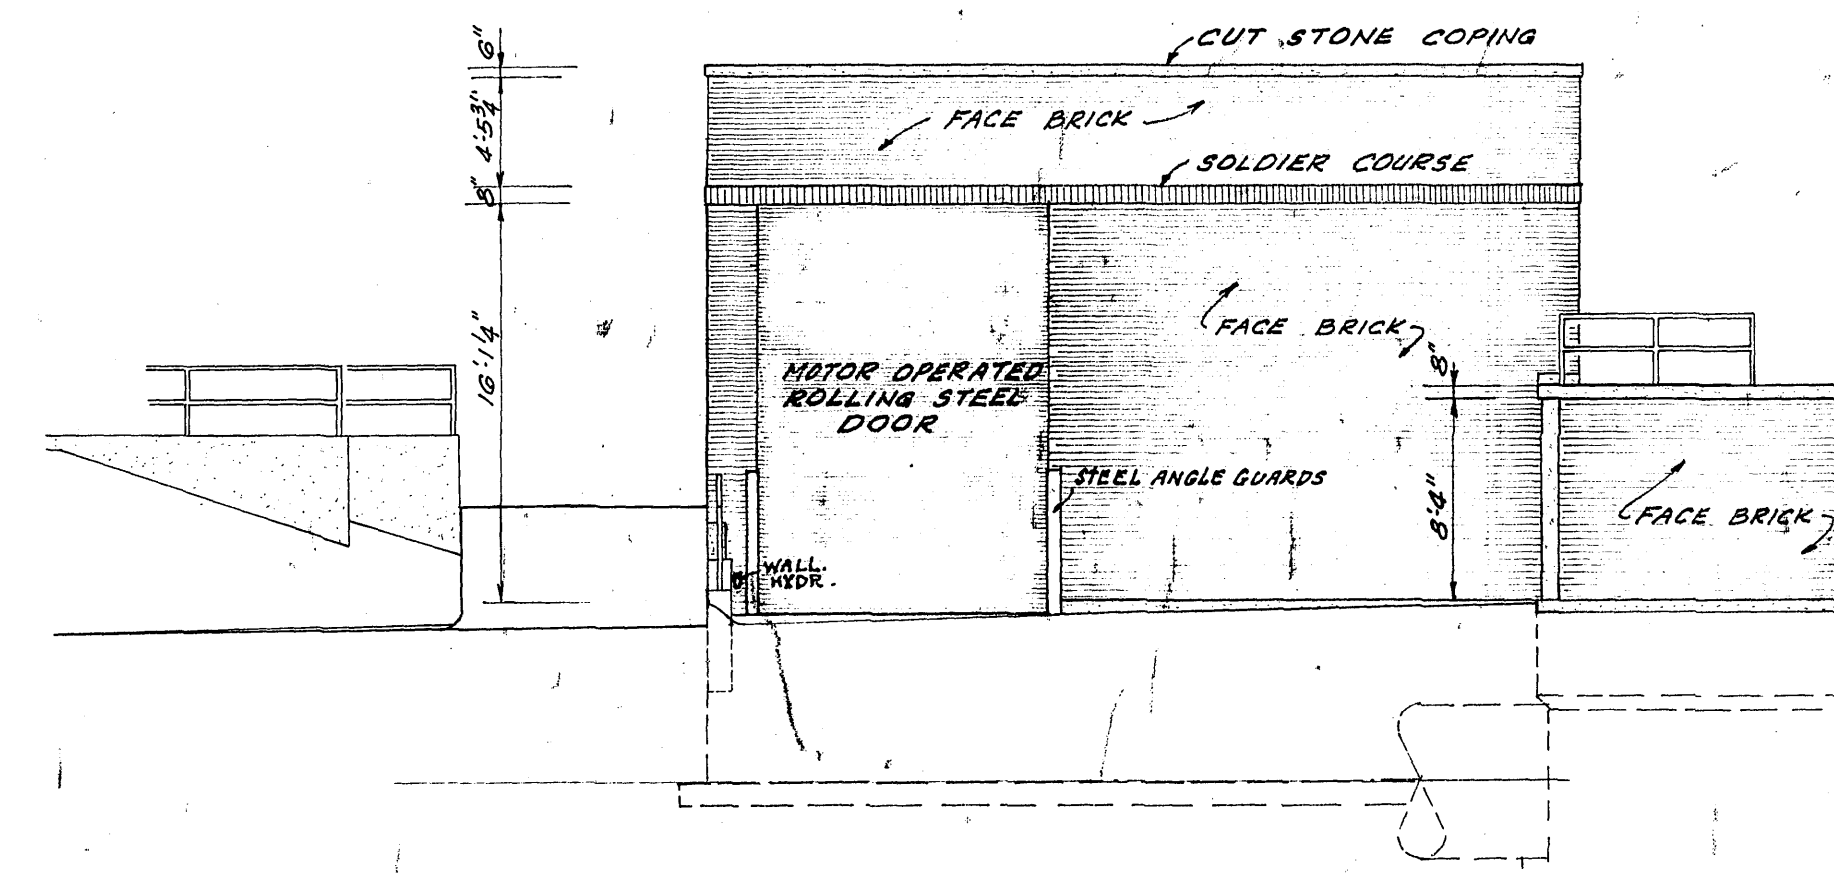

NORTH ELEVATION
SCALE: 1/8"=1'-0"

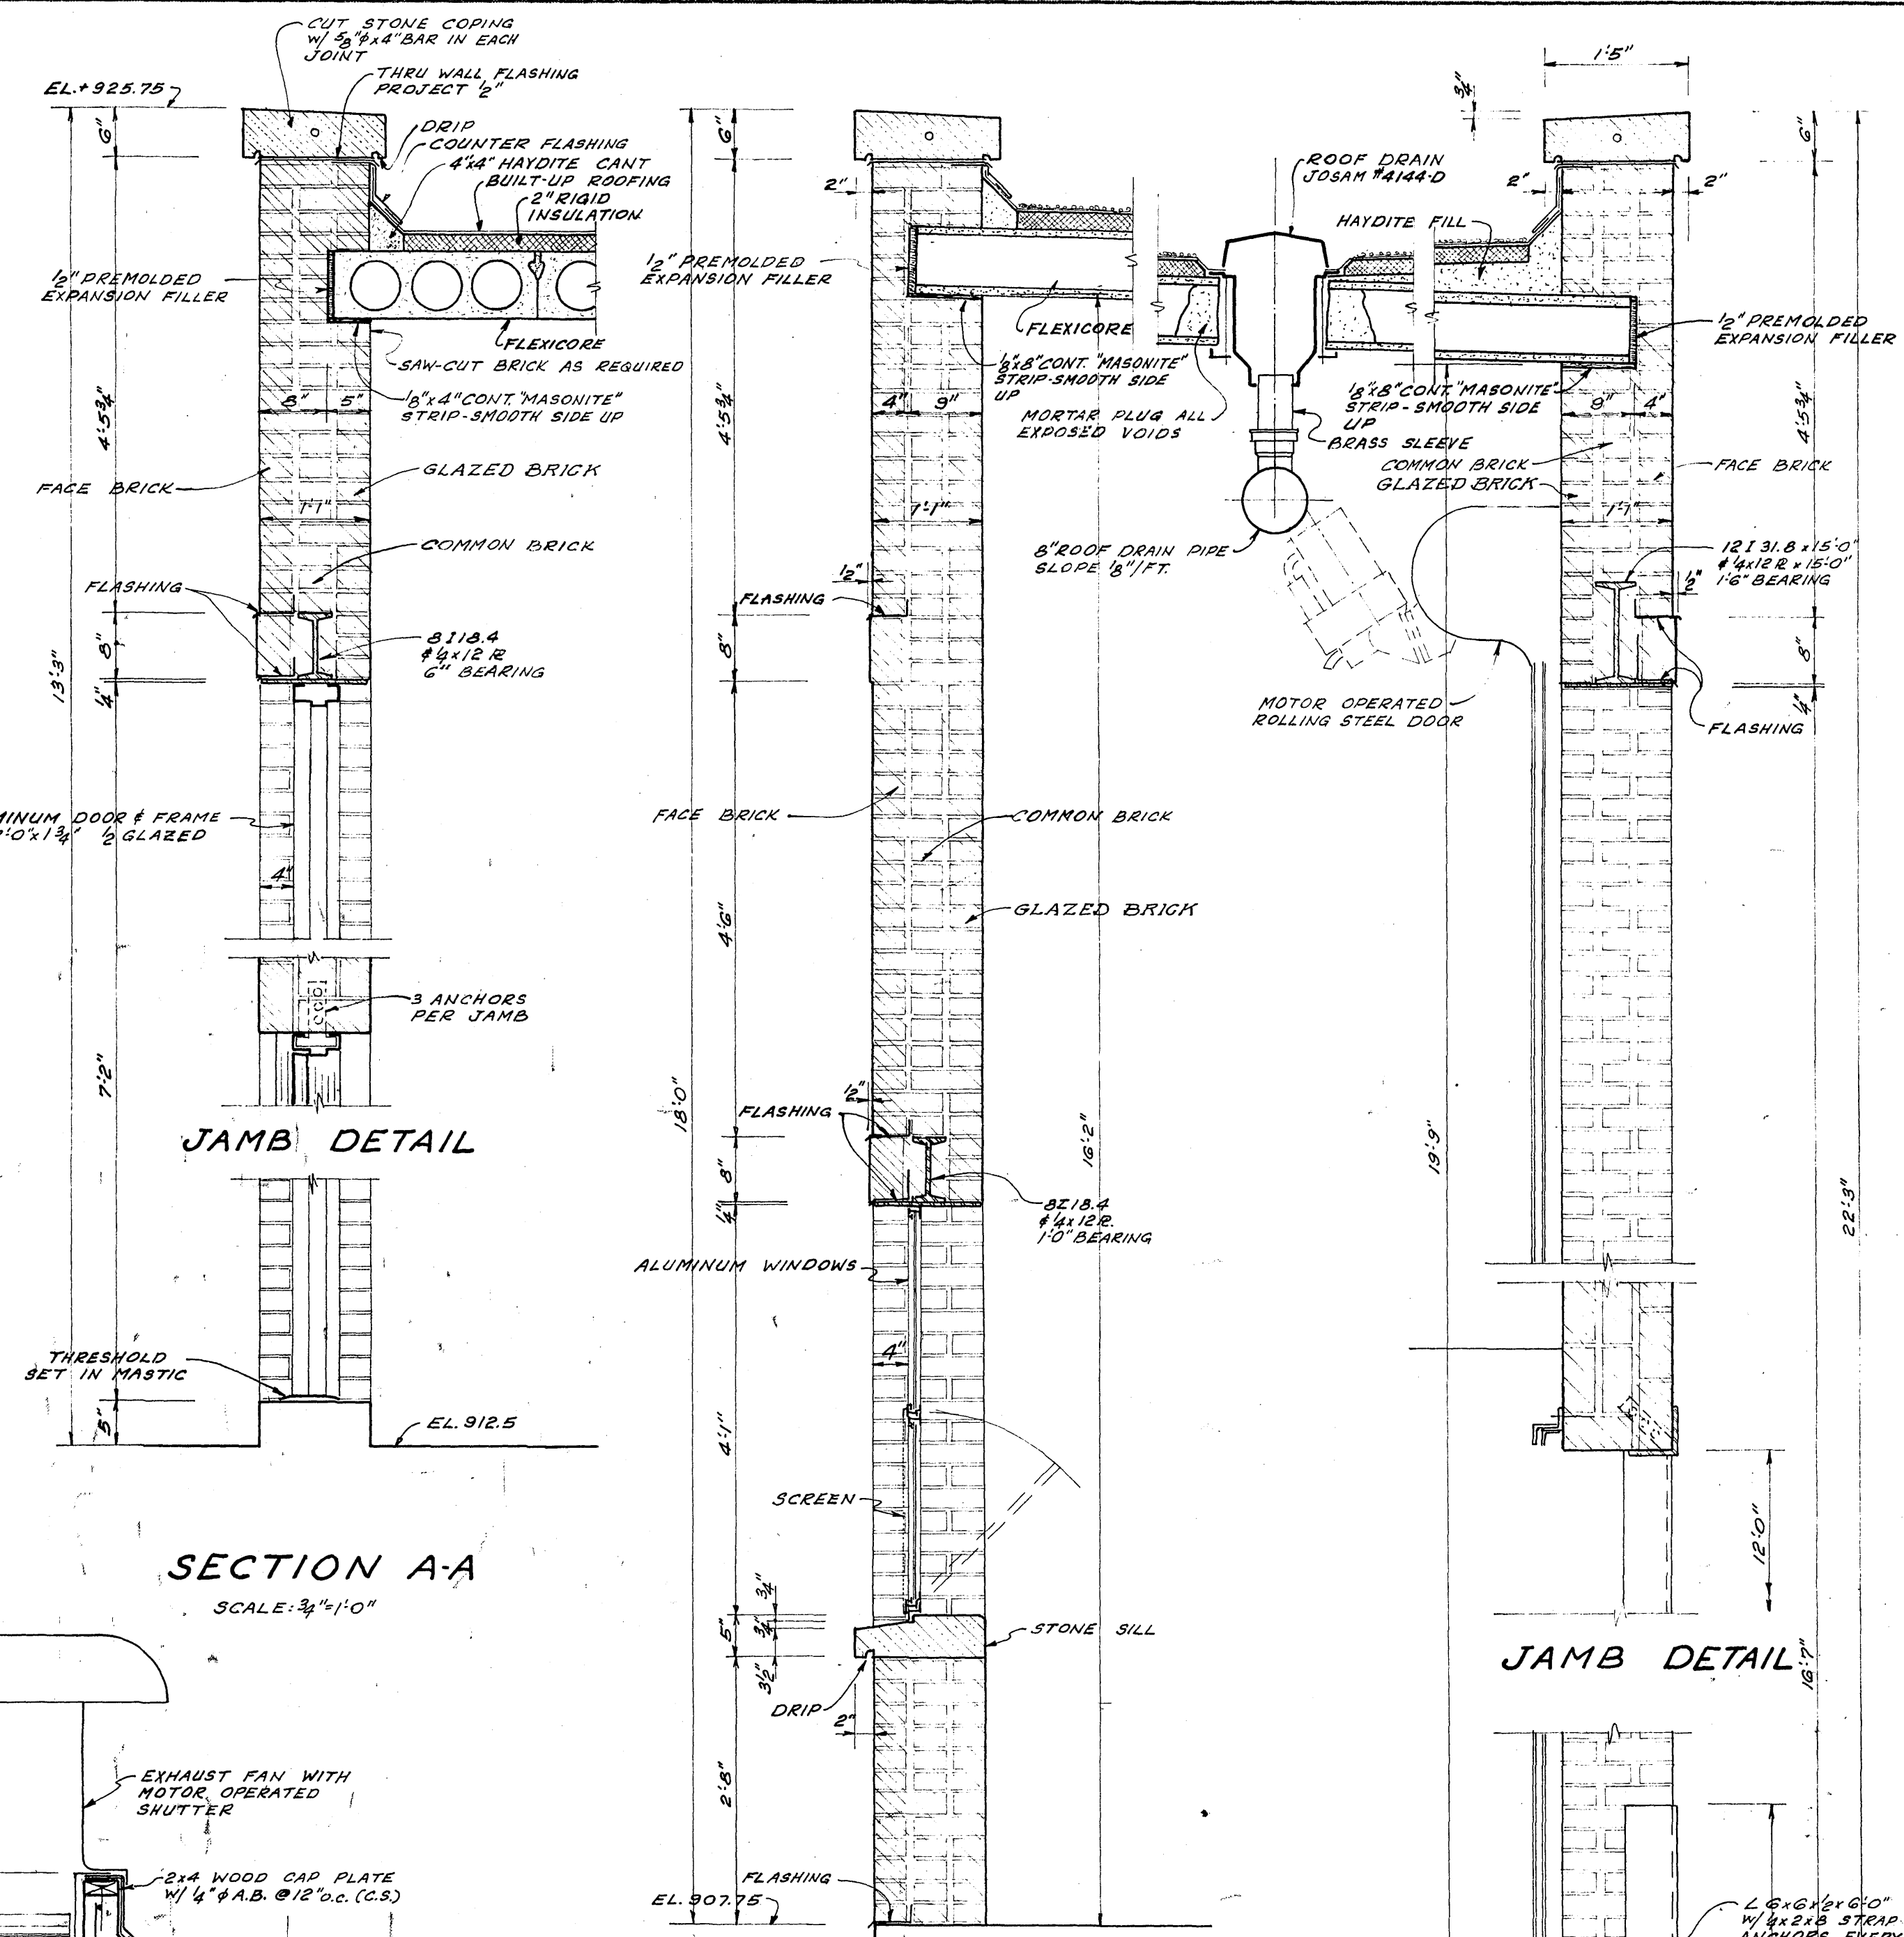


SECTION A-A
SCALE: 3/4"=1'-0"


SECTION B-B
SCALE: 3/4"=1'-0"

SECTION C-C
SCALE: 3/4"=1'-0"


CONTR. "C"

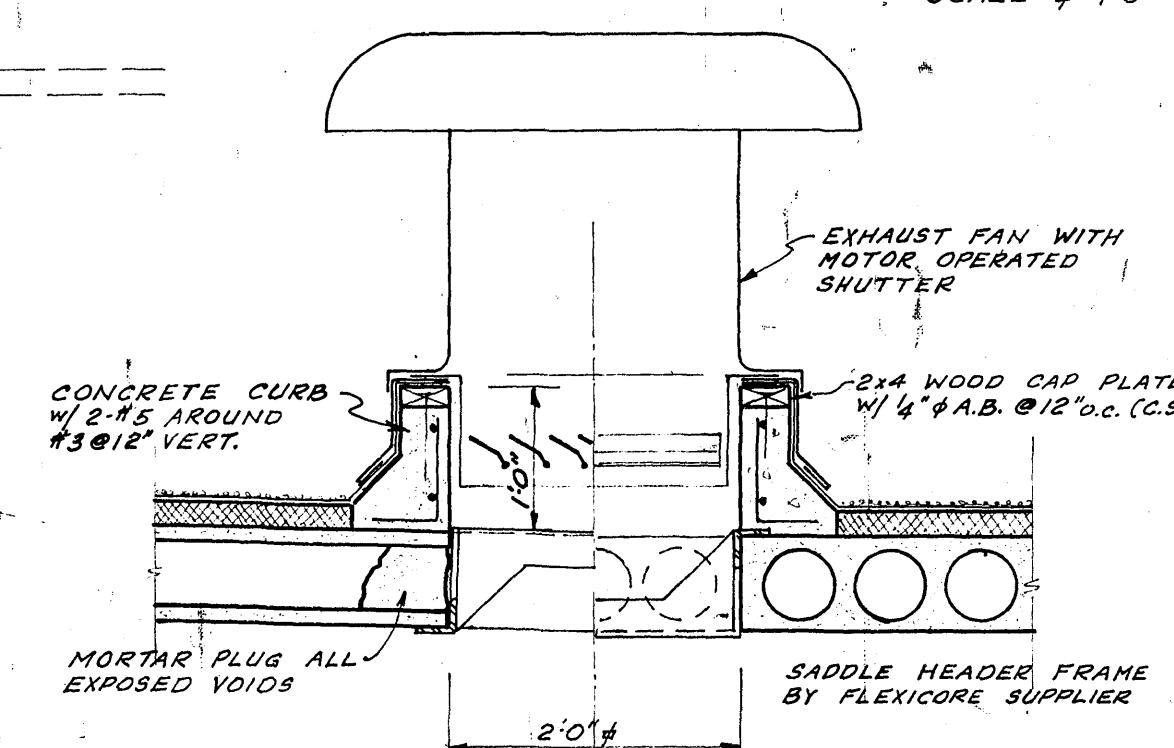


EXHAUST FAN DETAIL
SCALE: 3/4"=1'-0"

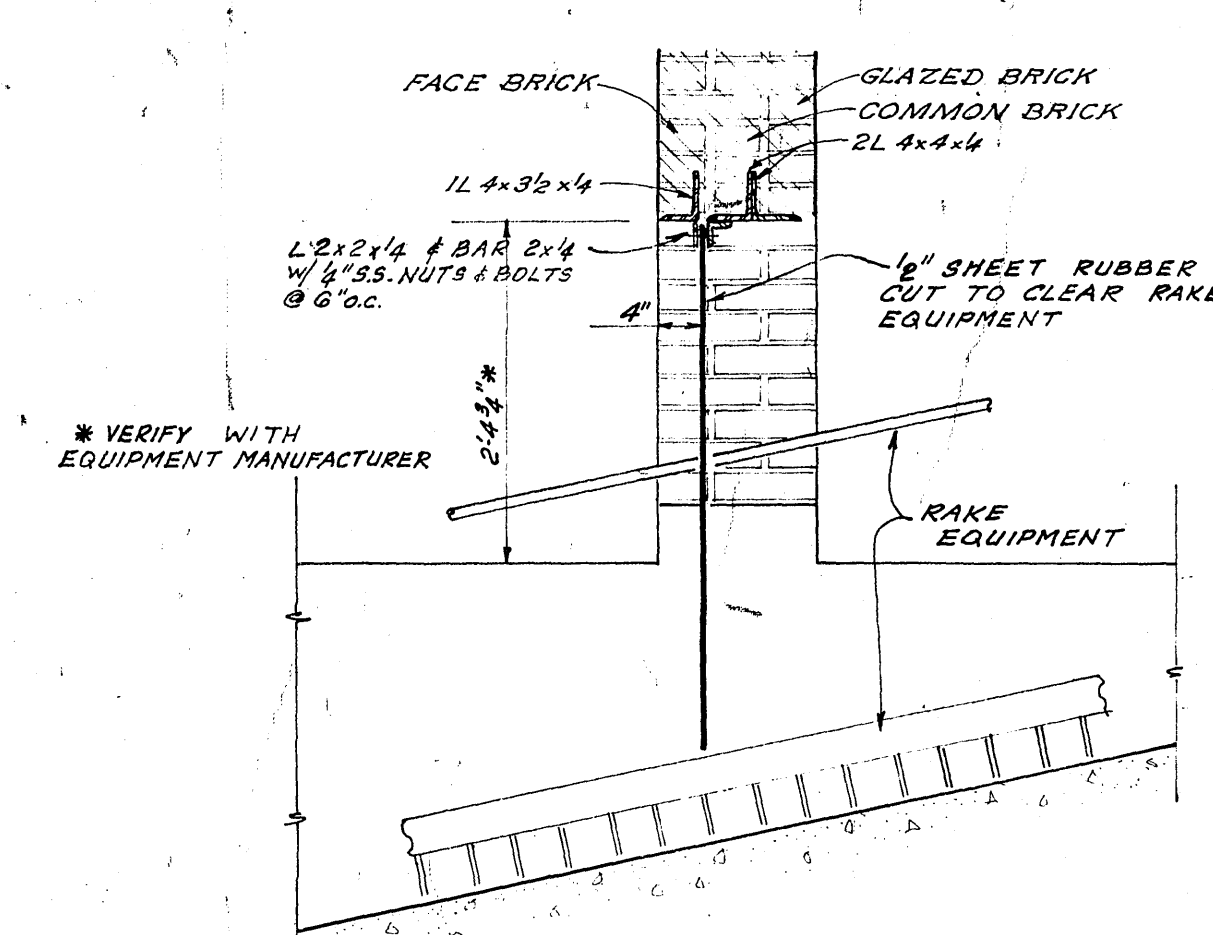


GRIT TROUGH CLOSURE DETAIL
SCALE: 3/4"=1'-0"

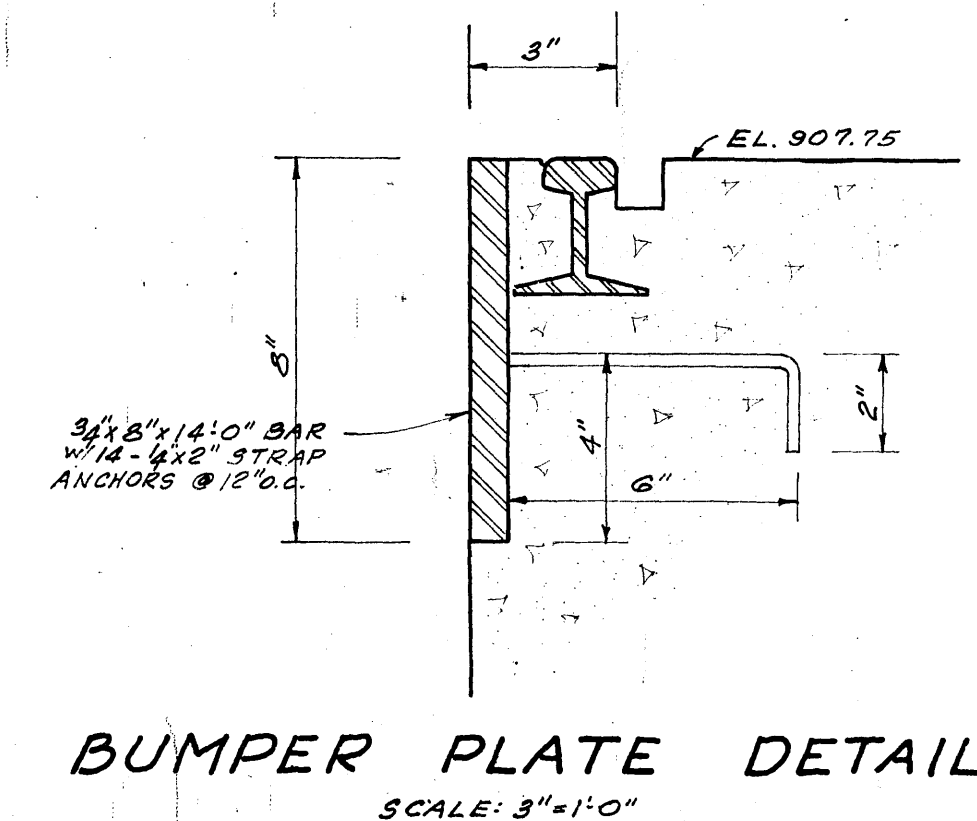


BUMPER PLATE DETAIL
SCALE: 3/4"=1'-0"

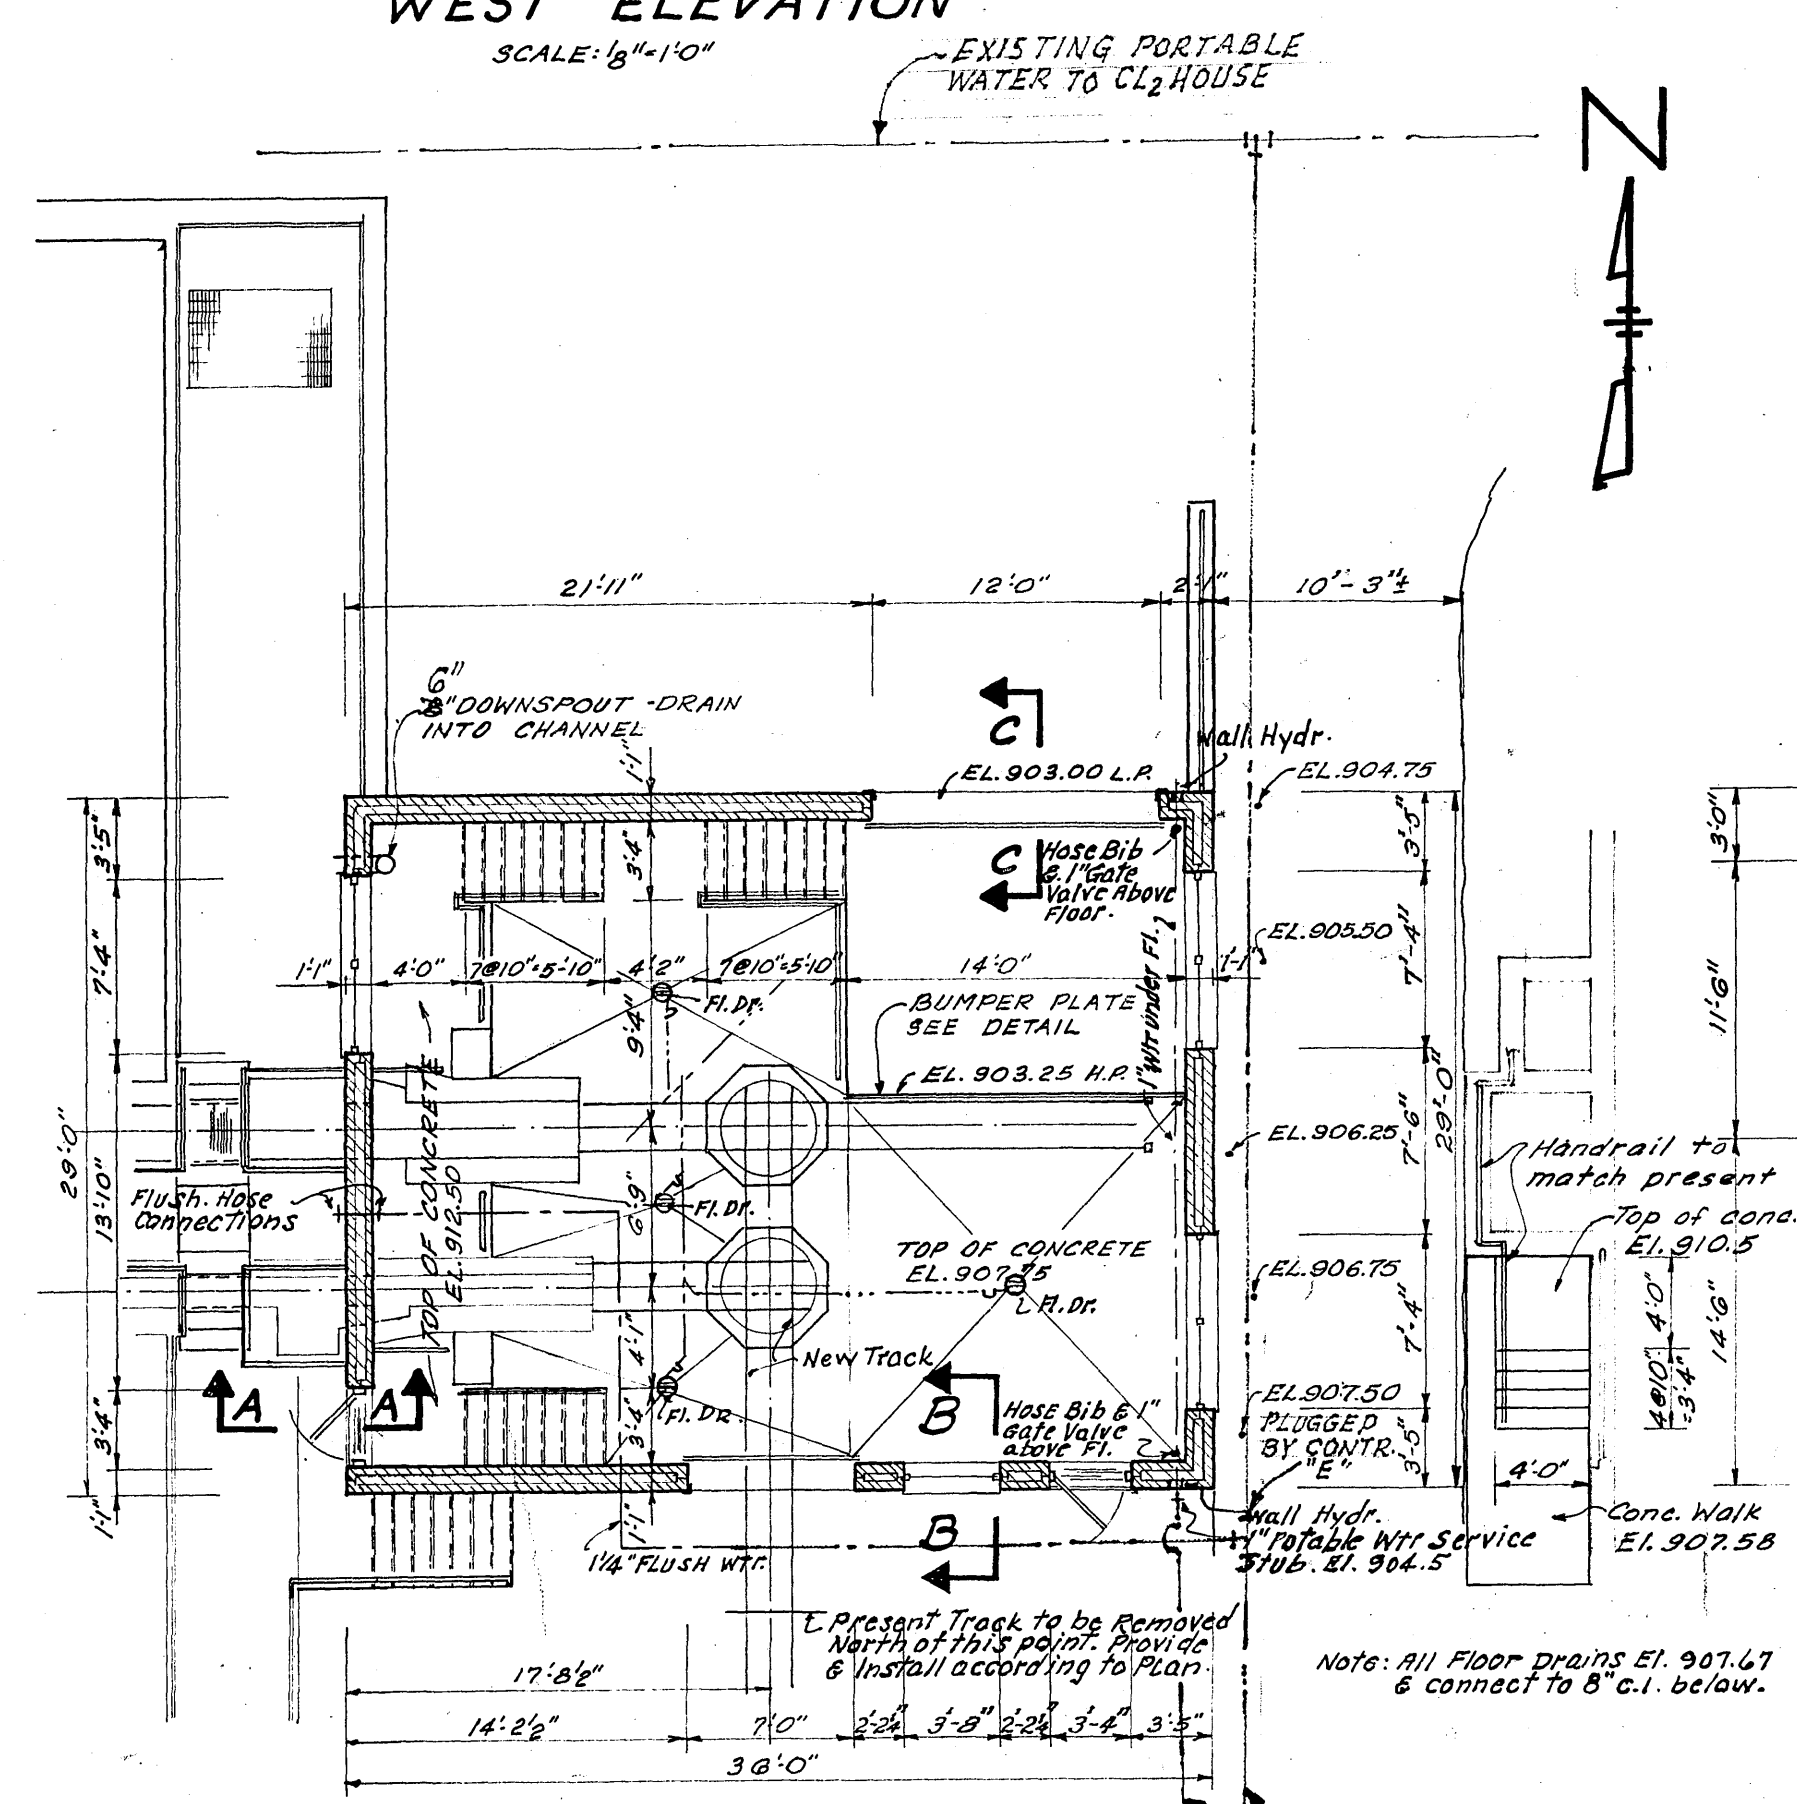

FLOOR PLAN
SCALE: 1/8"=1'-0"

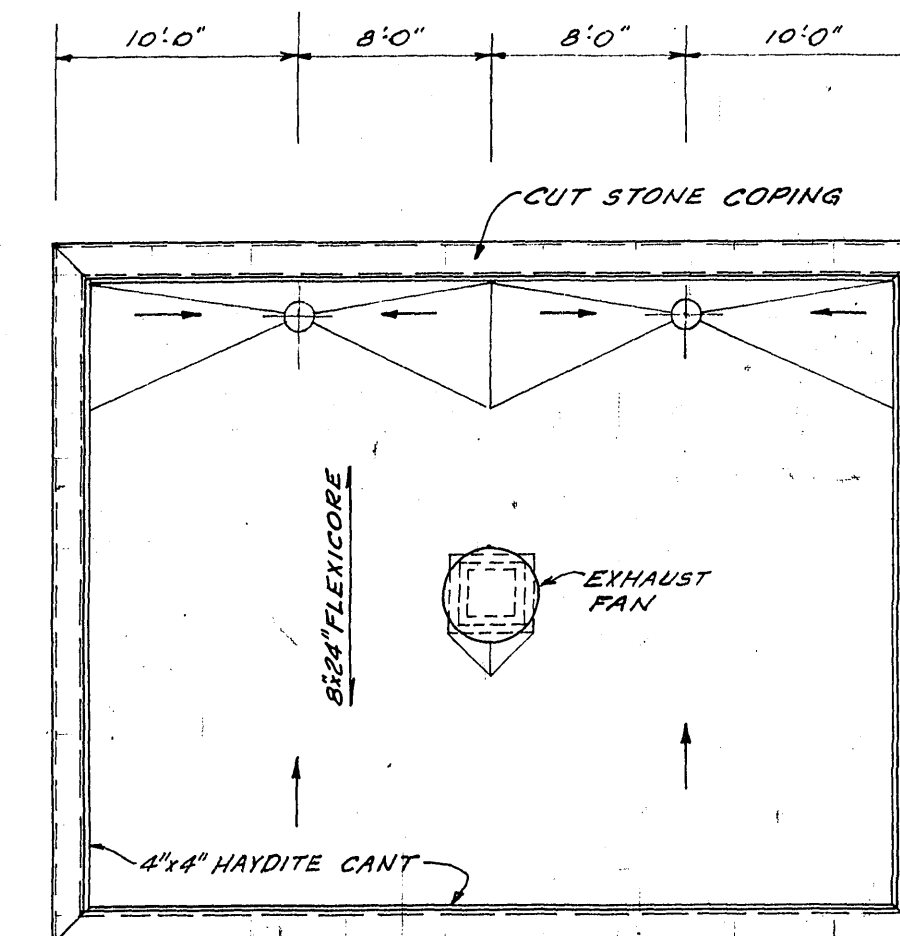

ROOF PLAN
SCALE: 1/8"=1'-0"

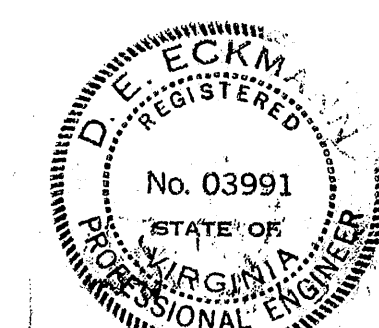

AS BUILT
ADDITIONS TO SEWAGE TREATMENT PLANT
ROANOKE, VIRGINIA
GRIT BASIN BUILDING
ARCHITECTURAL

ALVORD, BURDICK & HOWSON
ENGINEERS CHICAGO

1973