



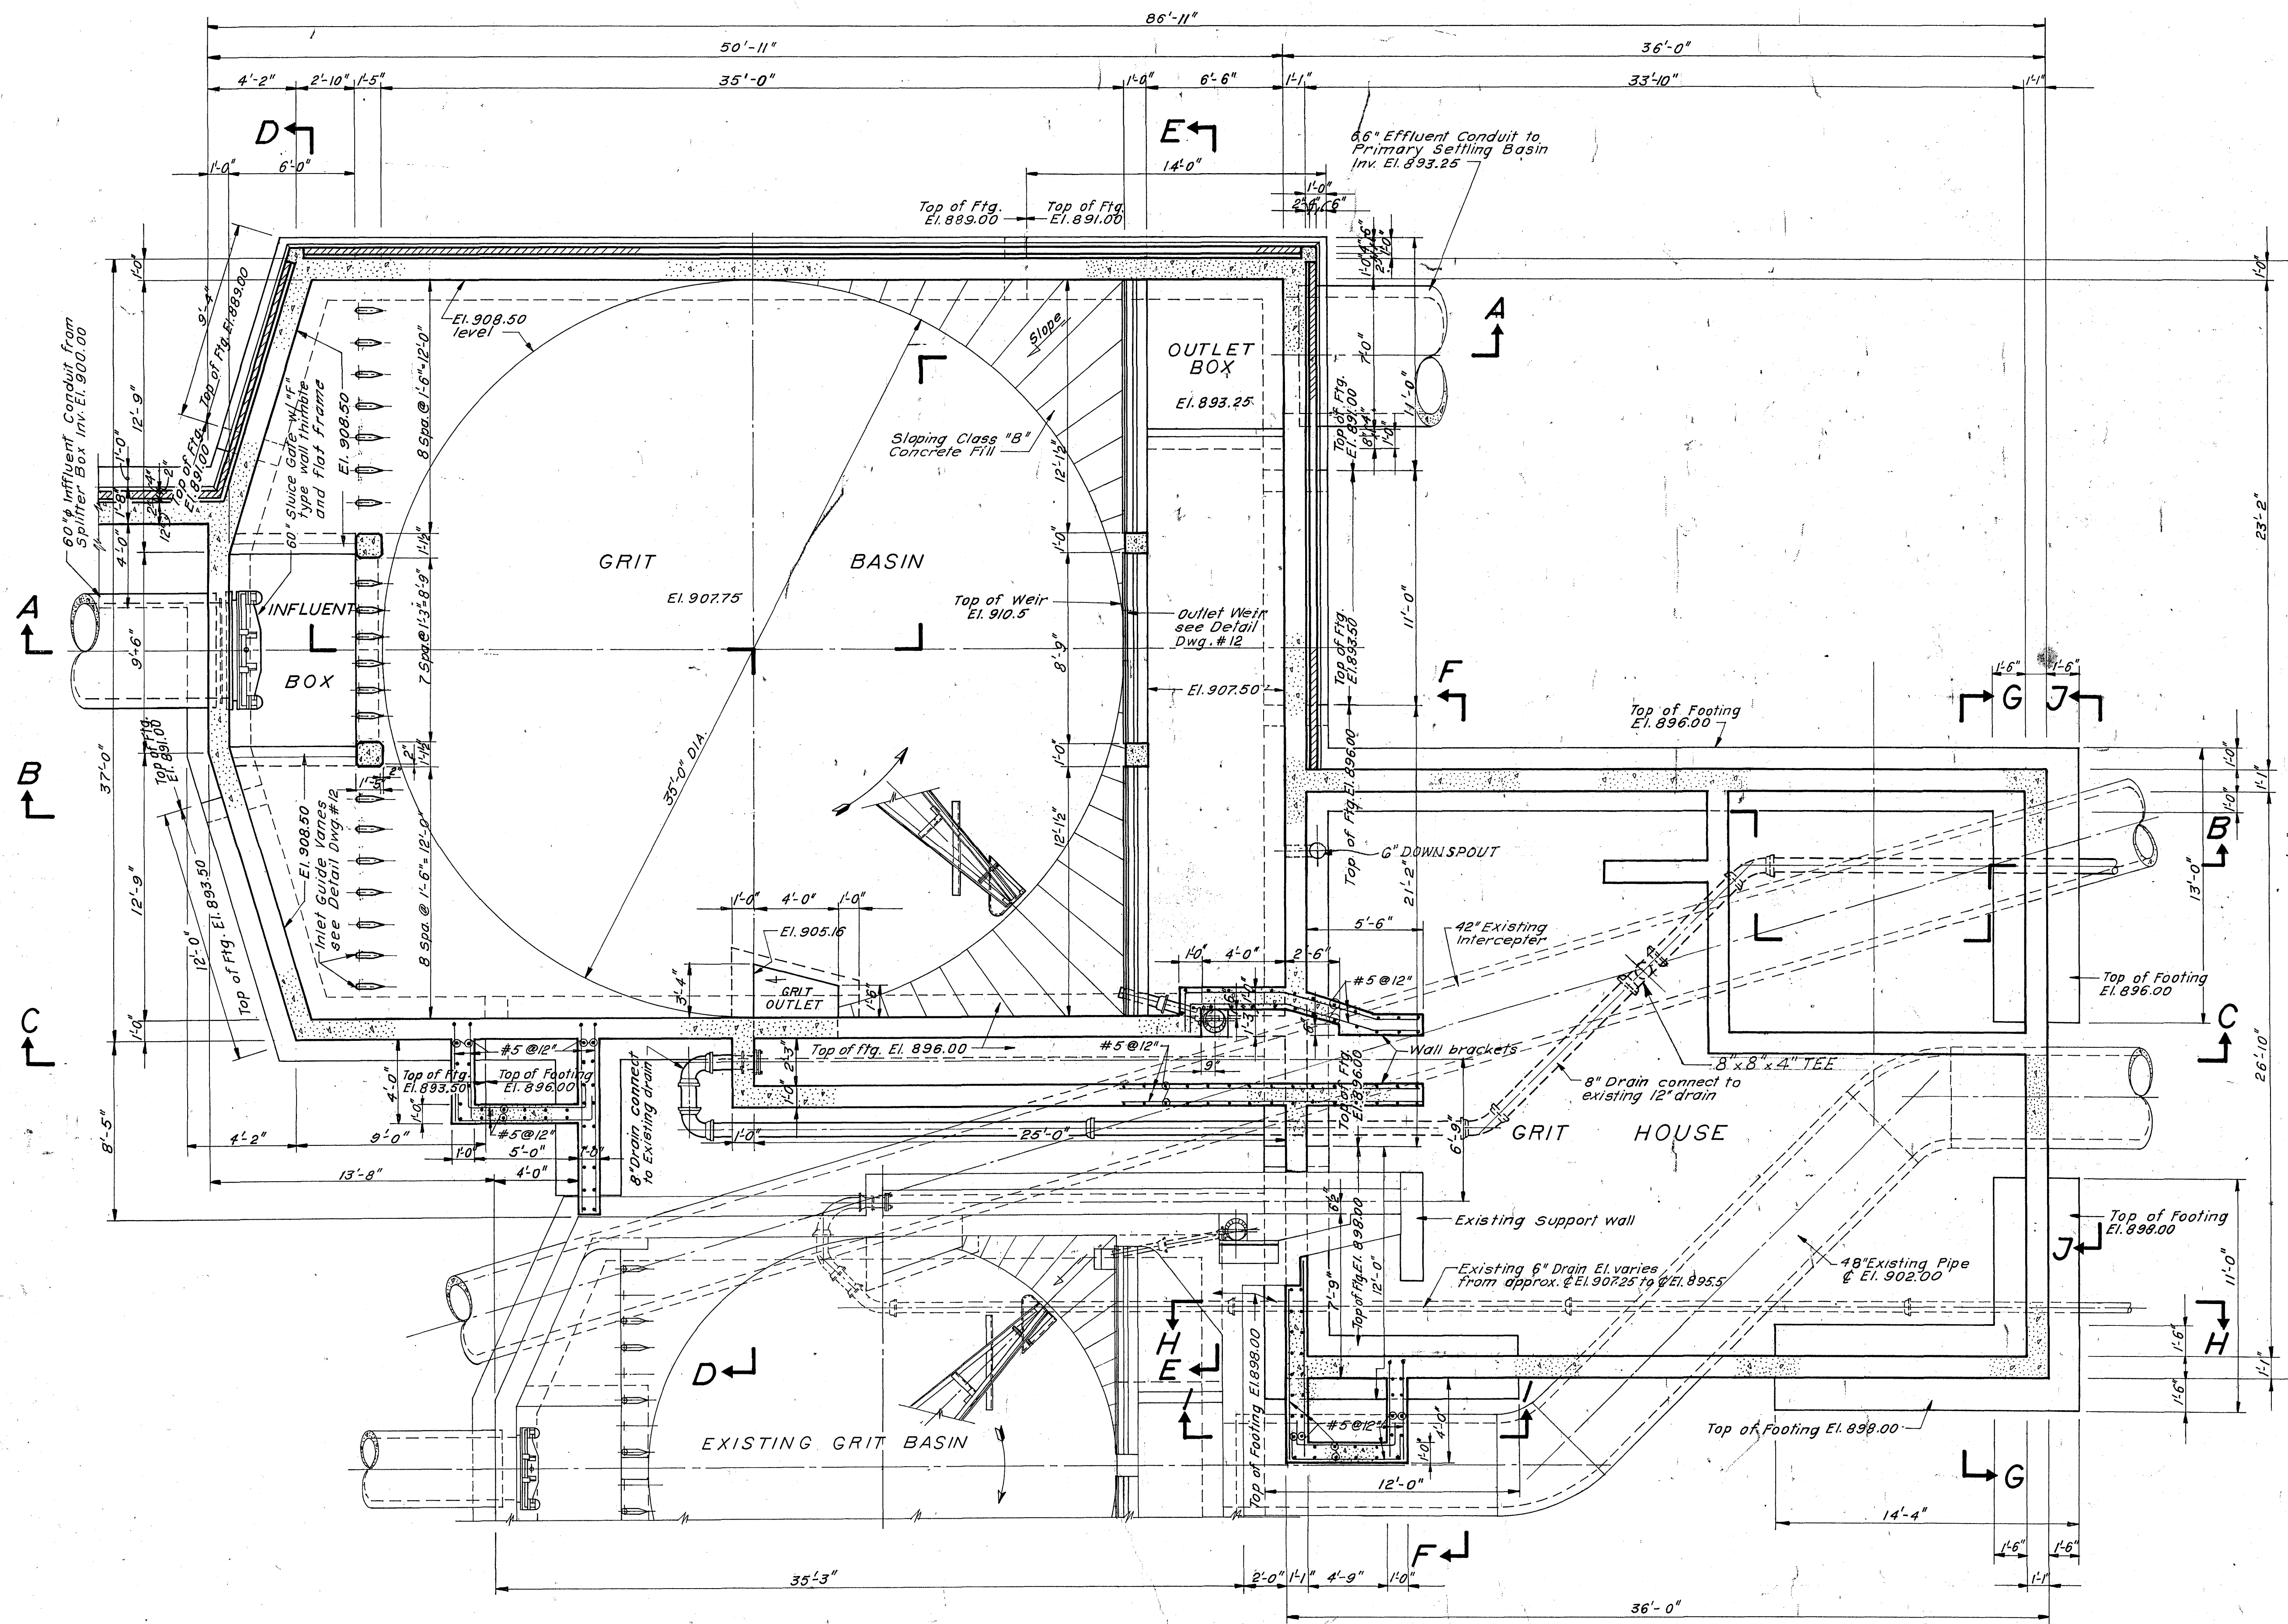

SECTIONAL PLAN
SCALE: 1/4"=1'-0"

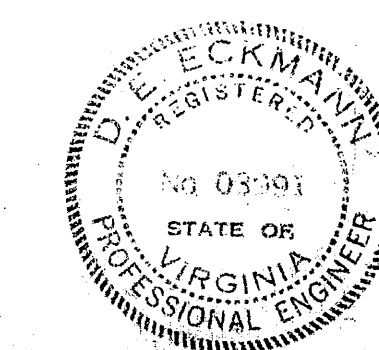

AS BUILT
CONTR. "C"

8

ADDITIONS TO SEWAGE TREATMENT PLANT
ROANOKE, VIRGINIA
GRIT BASIN & BUILDING
FOOTING PLAN

ALVORD, BURDICK & HOWSON
ENGINEERS CHICAGO

1973