

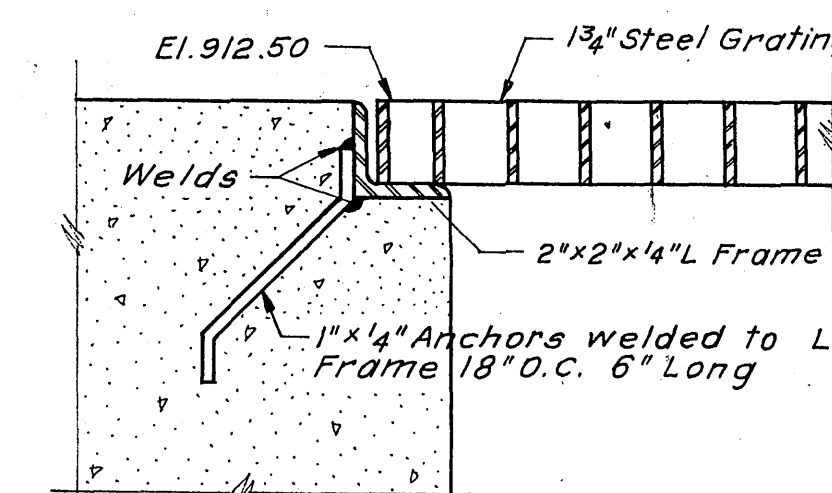


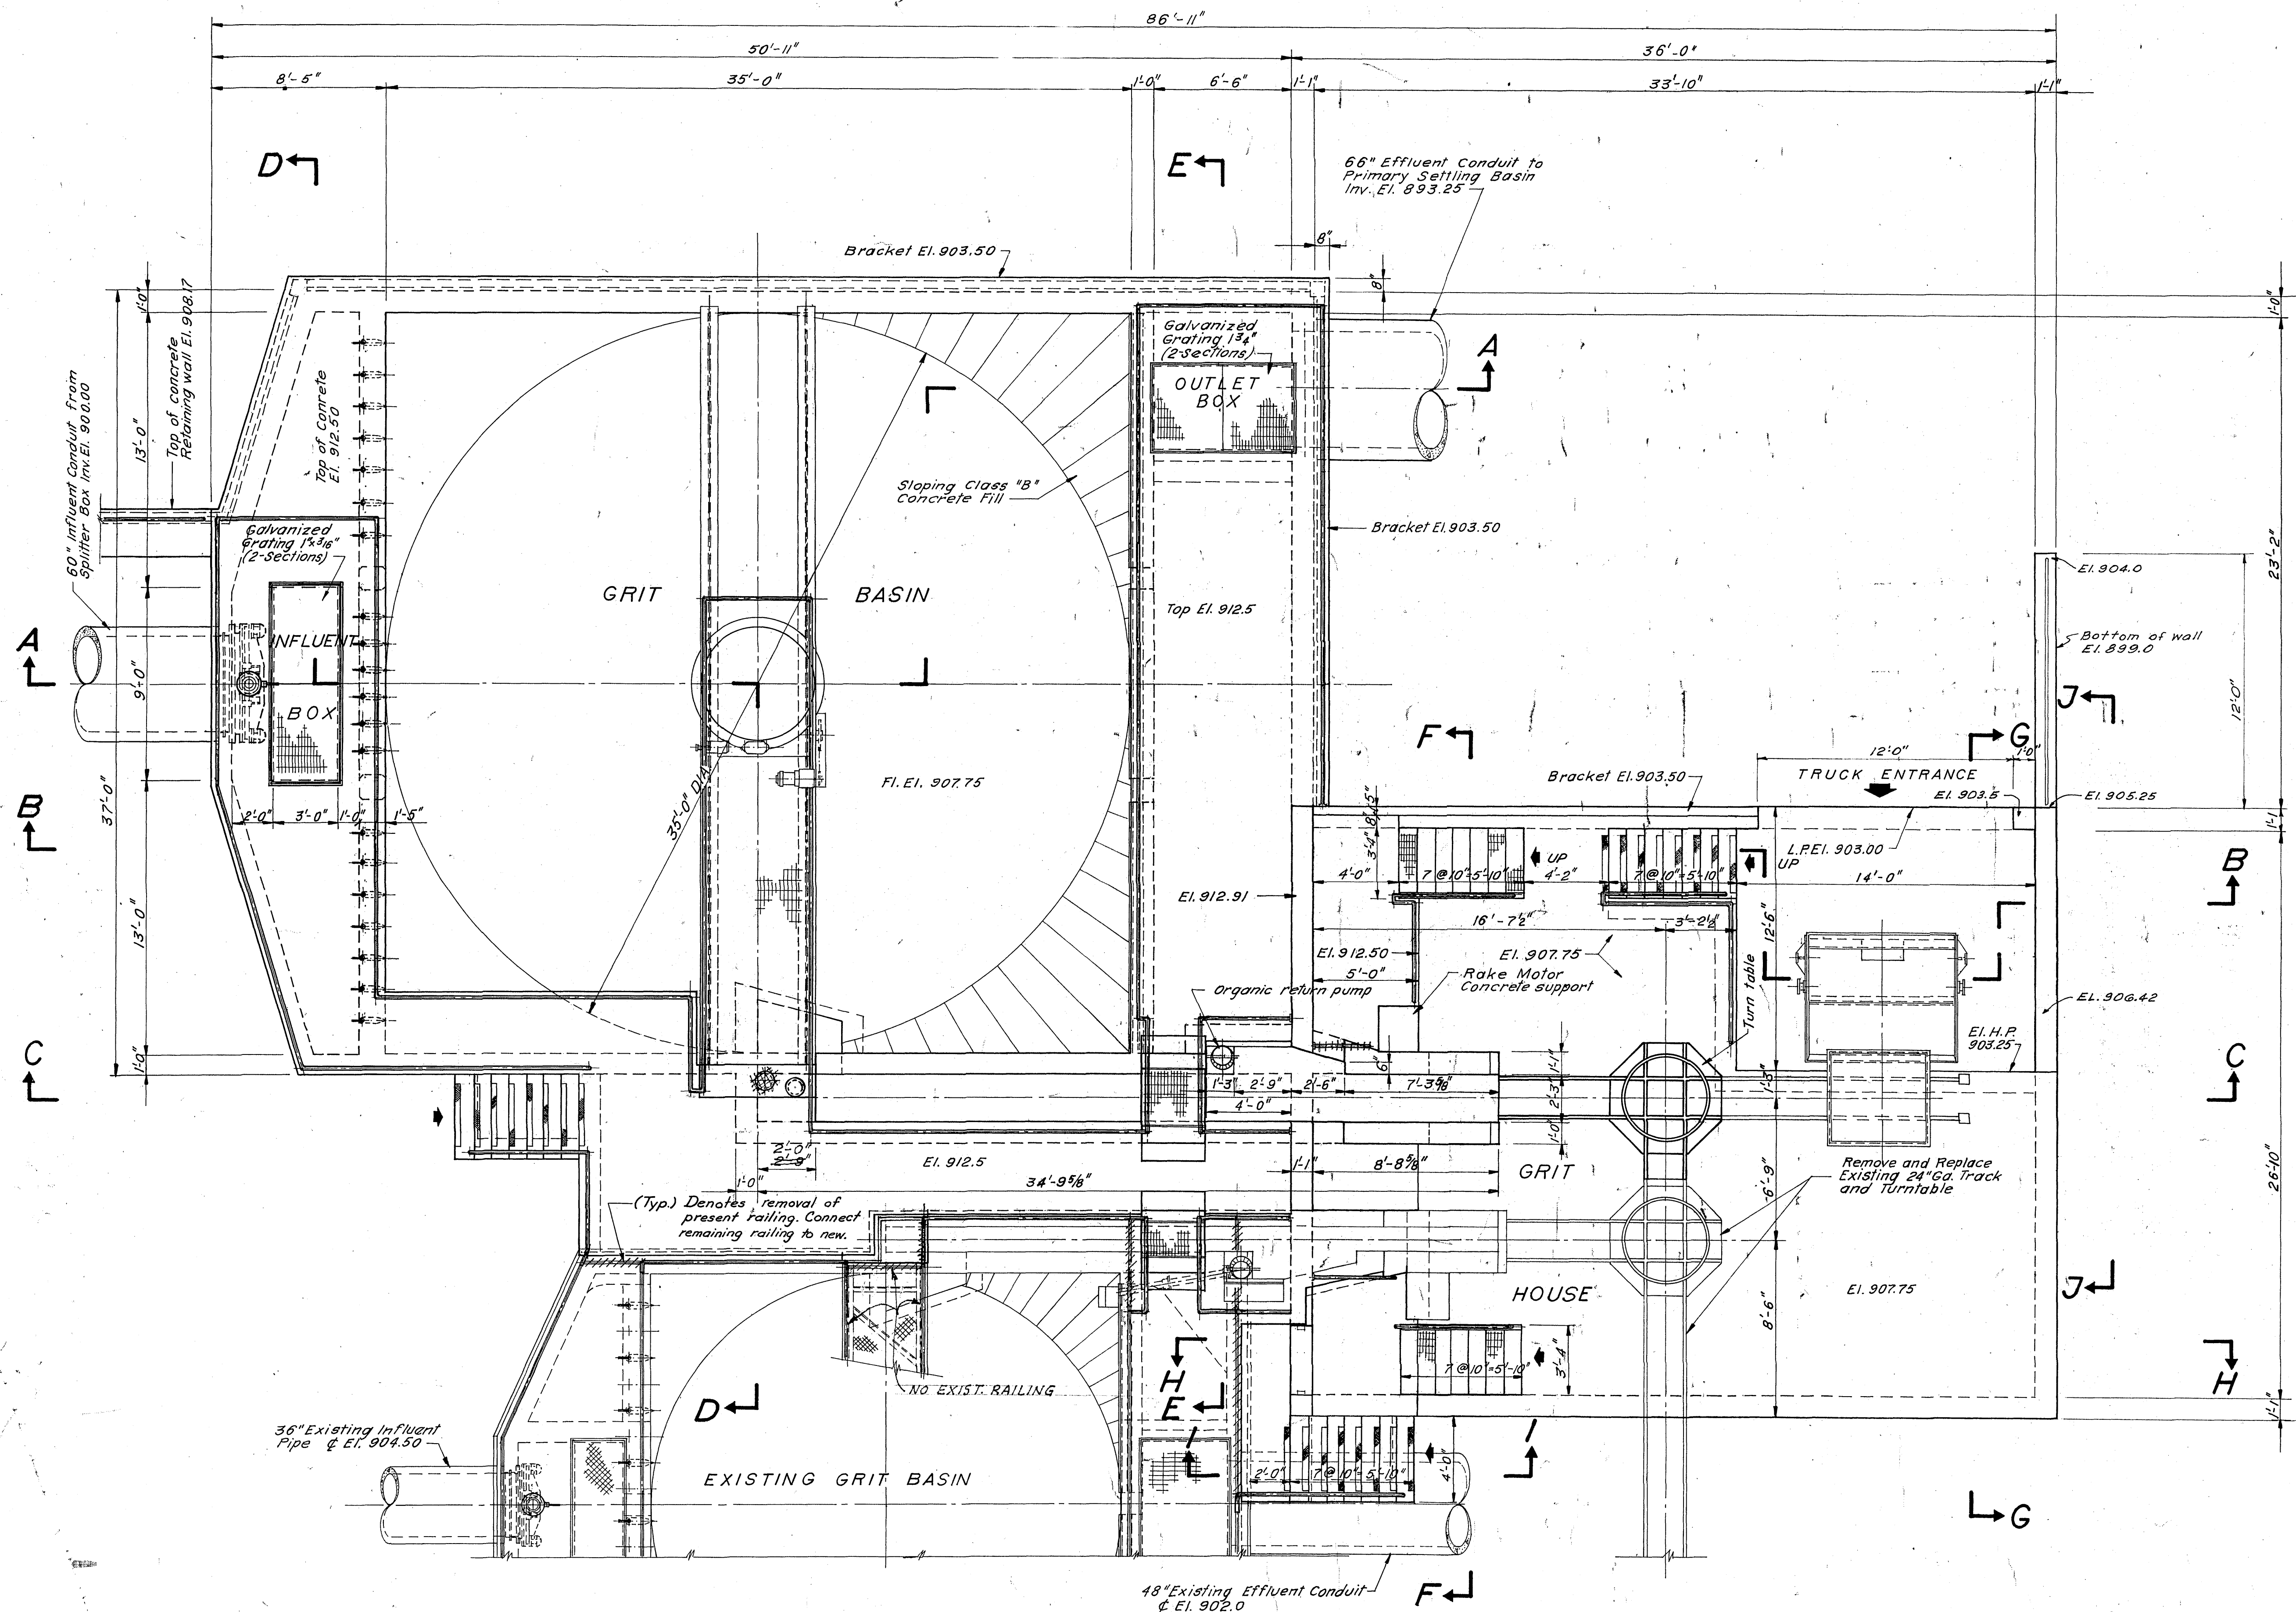

TYPICAL GRATING AND SUPPORT
SCALE: 3" = 1'-0"

PLAN AT EL. 916.00
SCALE: 1/4" = 1'-0"

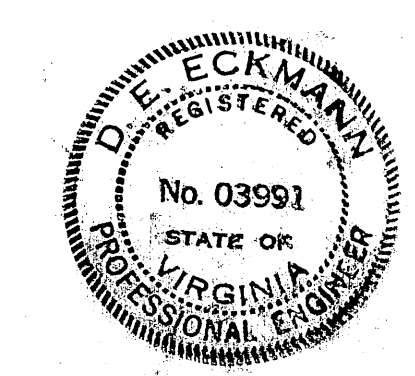

AS BUILT 9

CONTR. "C"

ADDITIONS TO SEWAGE TREATMENT PLANT
ROANOKE, VIRGINIA

GRIT BASIN & BUILDING
CONCRETE PLAN

ALVORD, BURDICK & HOWSON
ENGINEERS CHICAGO

1973