


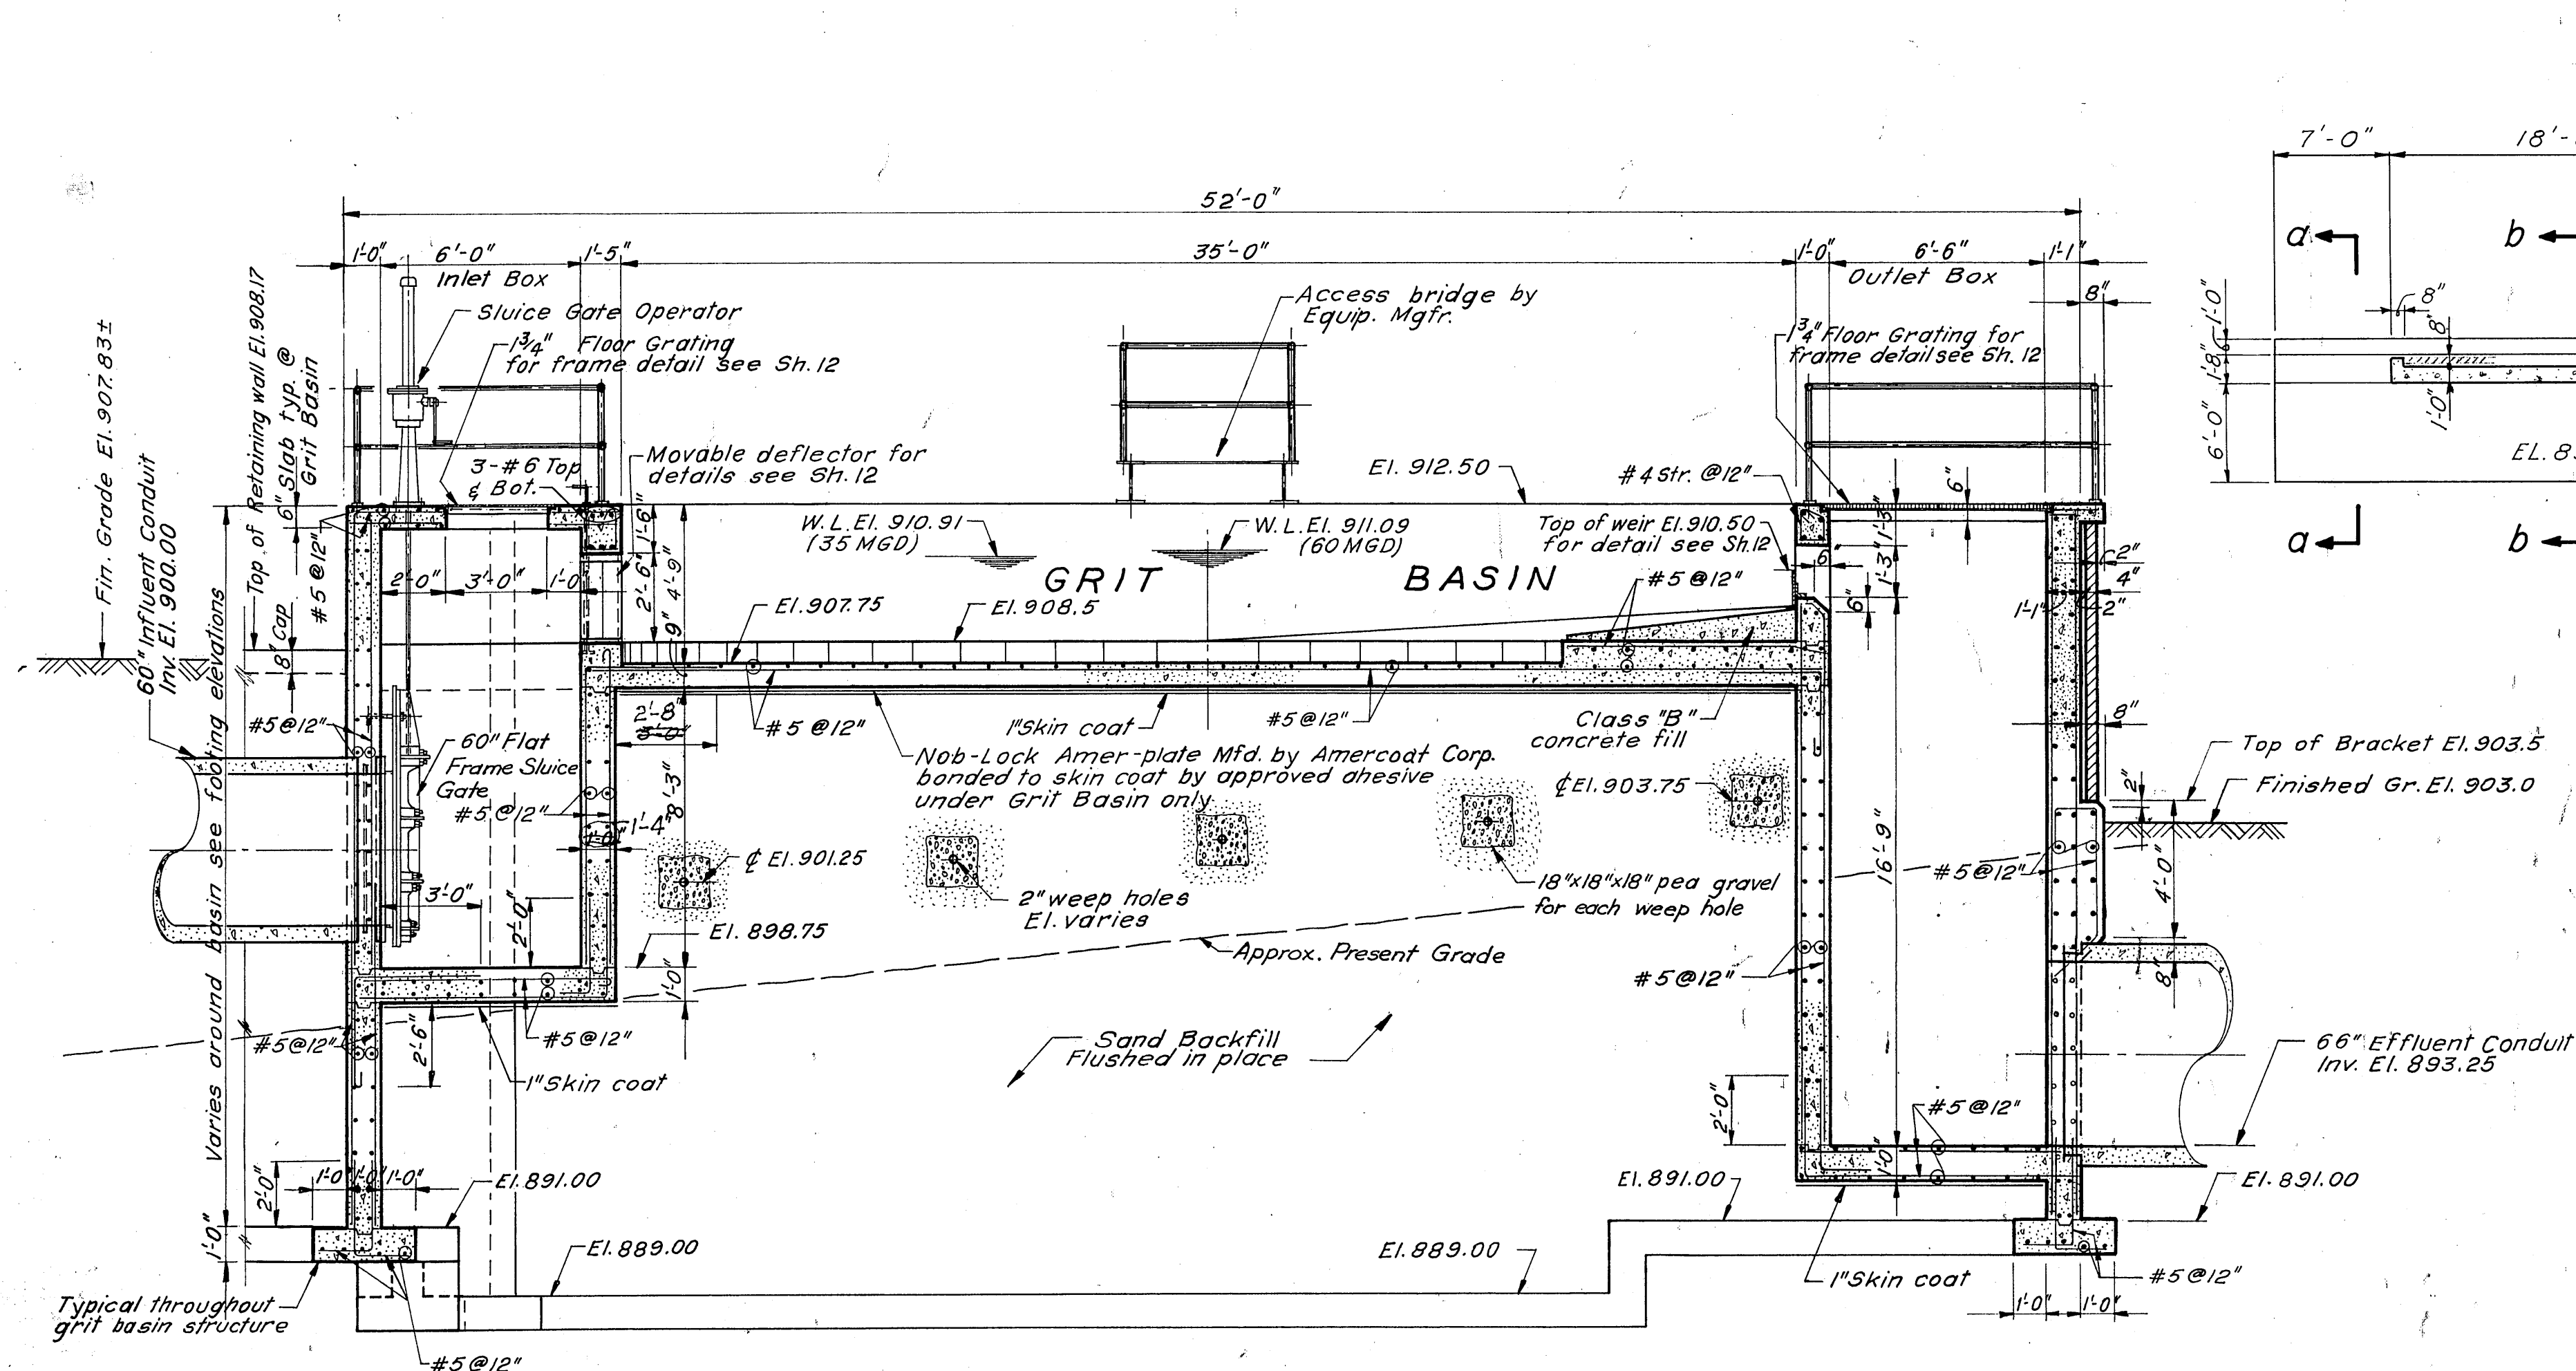


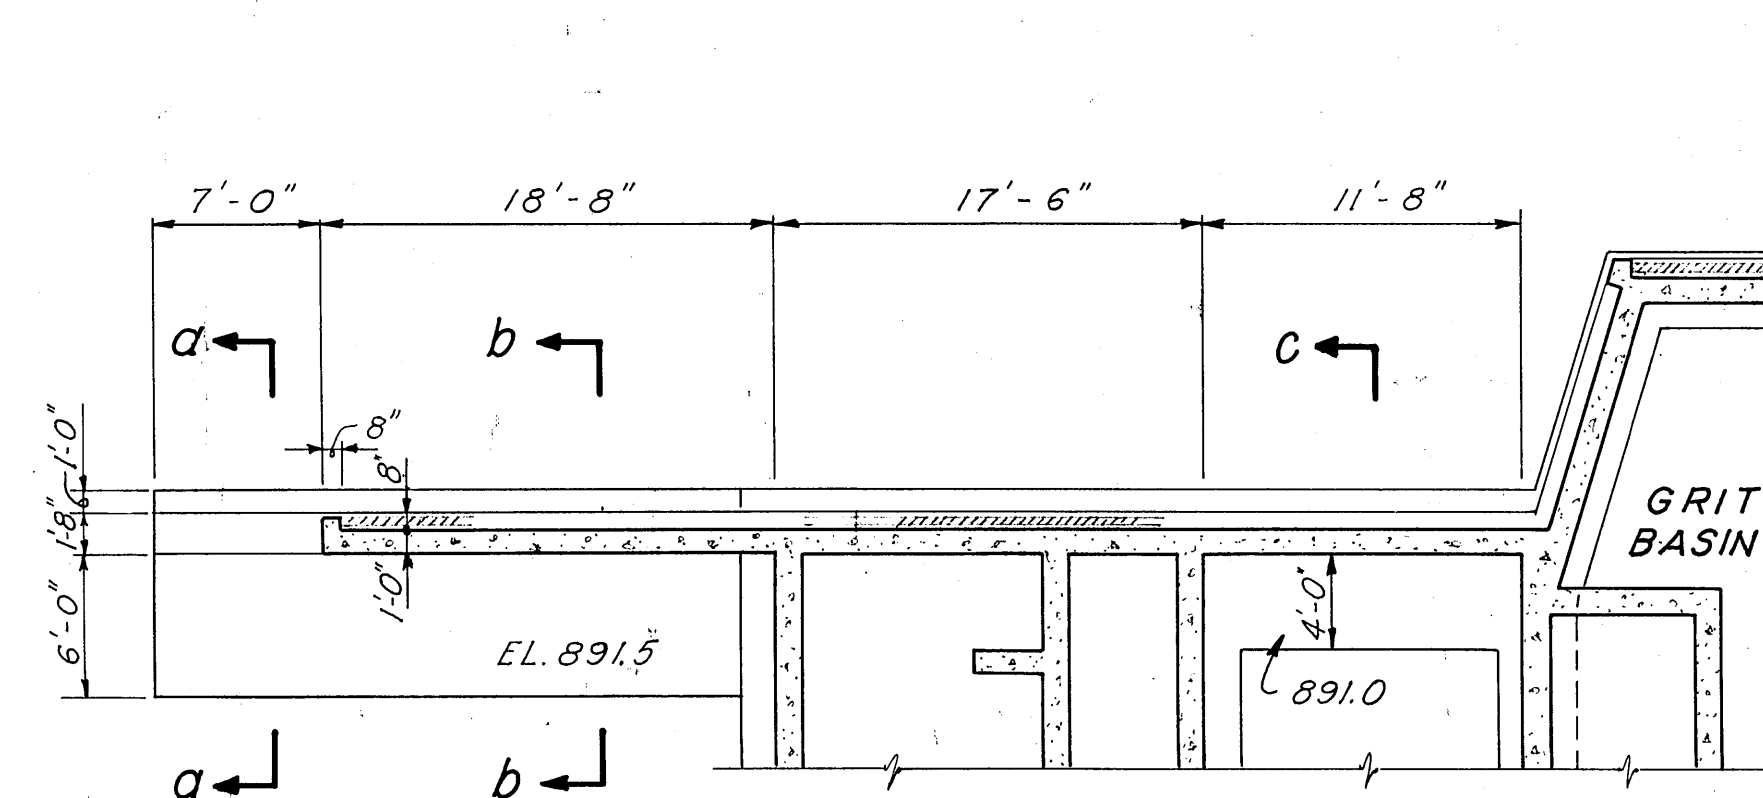


SECTION A-A
SCALE: 1/4"=1'-0"

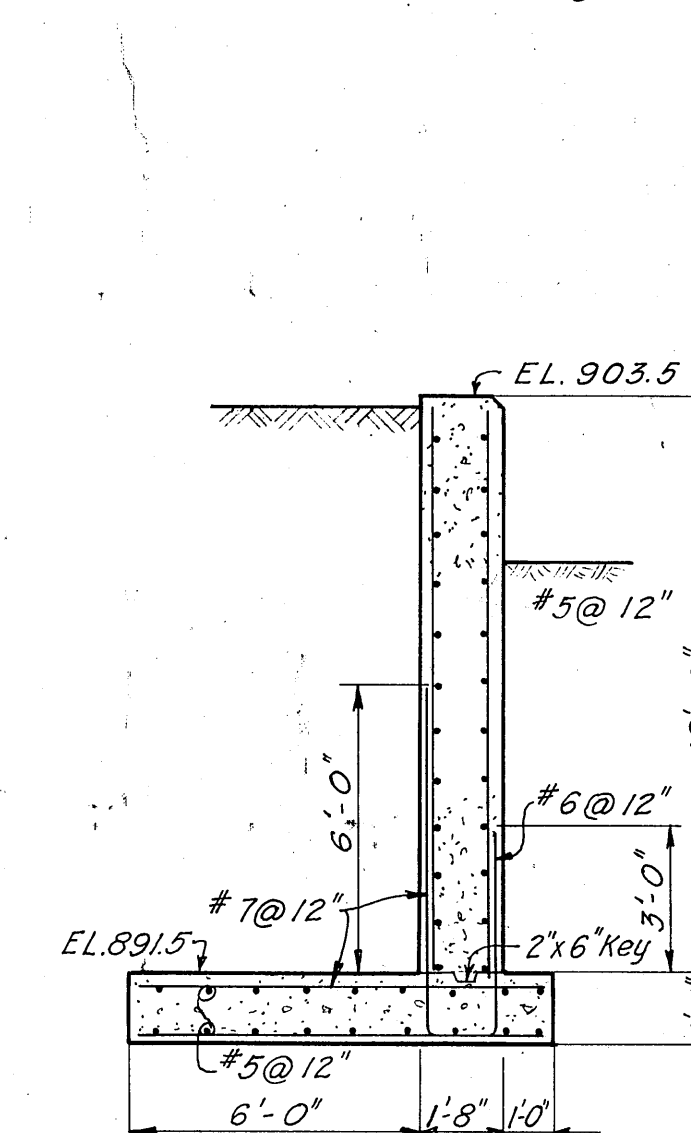


SECTIONAL PLAN C
RETAINING WALL AT GRIT BASIN AND SPLITTER CHAMBER
SCALE: 1/8"=1'-0"

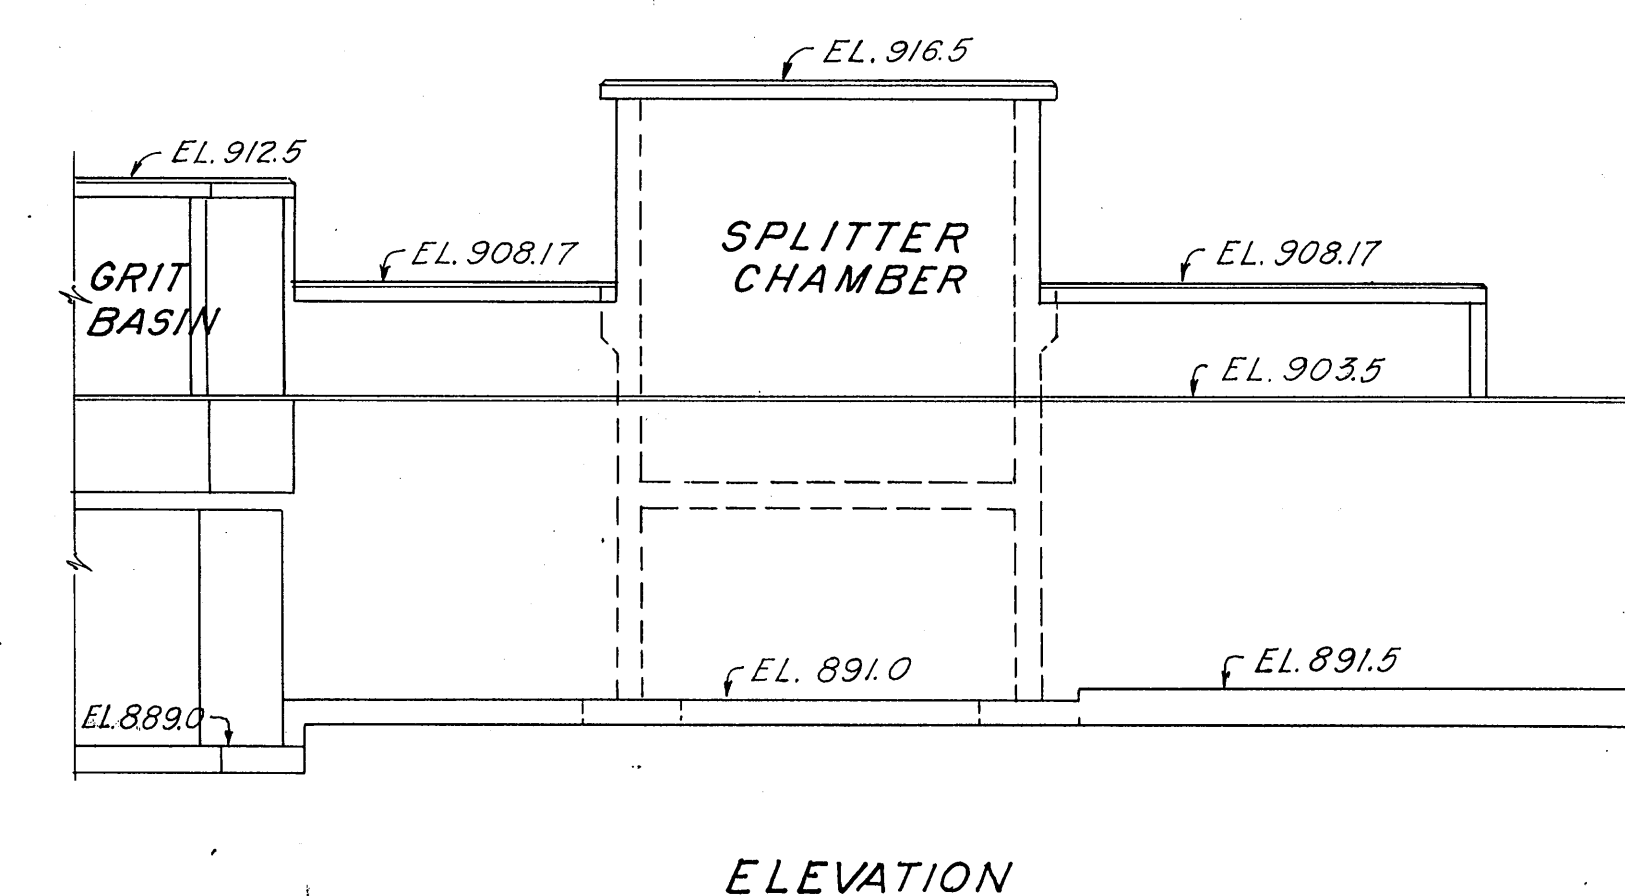


SECTION a-a
SCALE: 1/4"=1'-0"

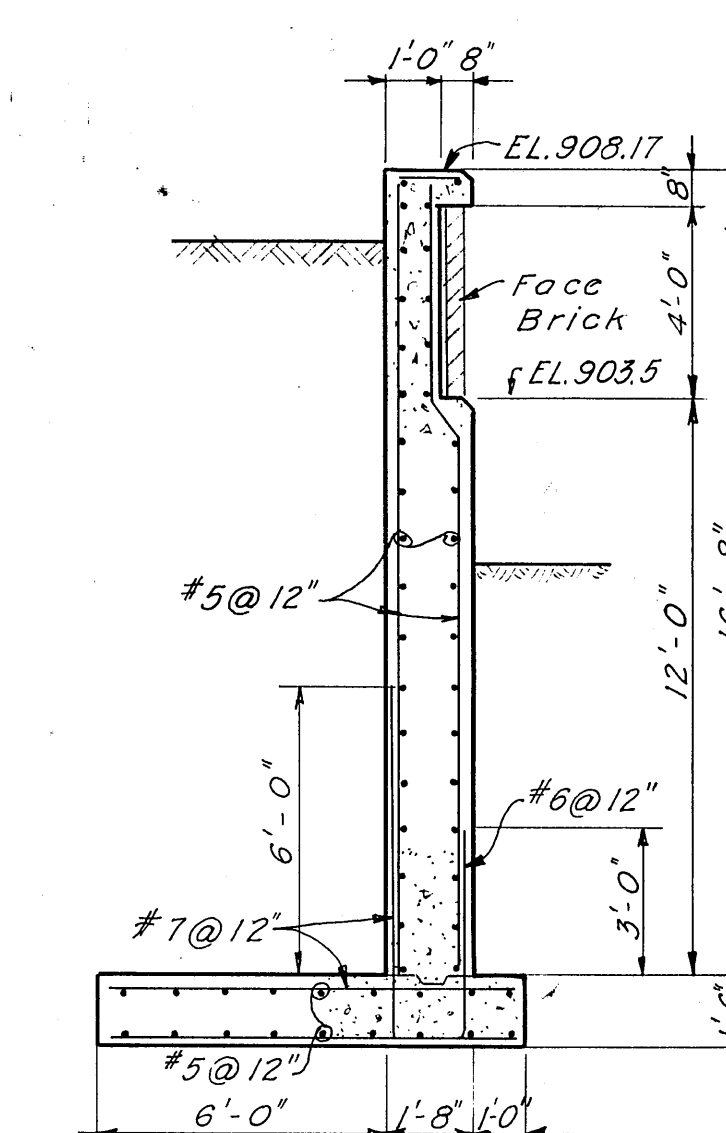

SECTION b-b
SCALE: 1/4"=1'-0"

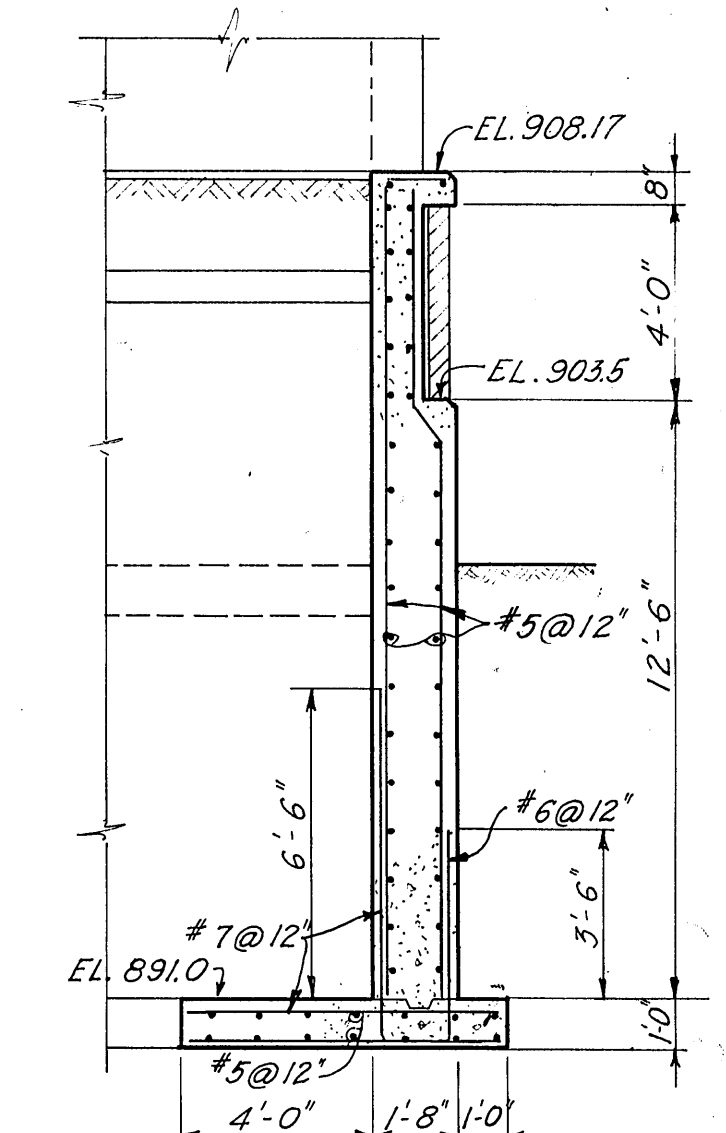

SECTION c-c
SCALE: 1/4"=1'-0"

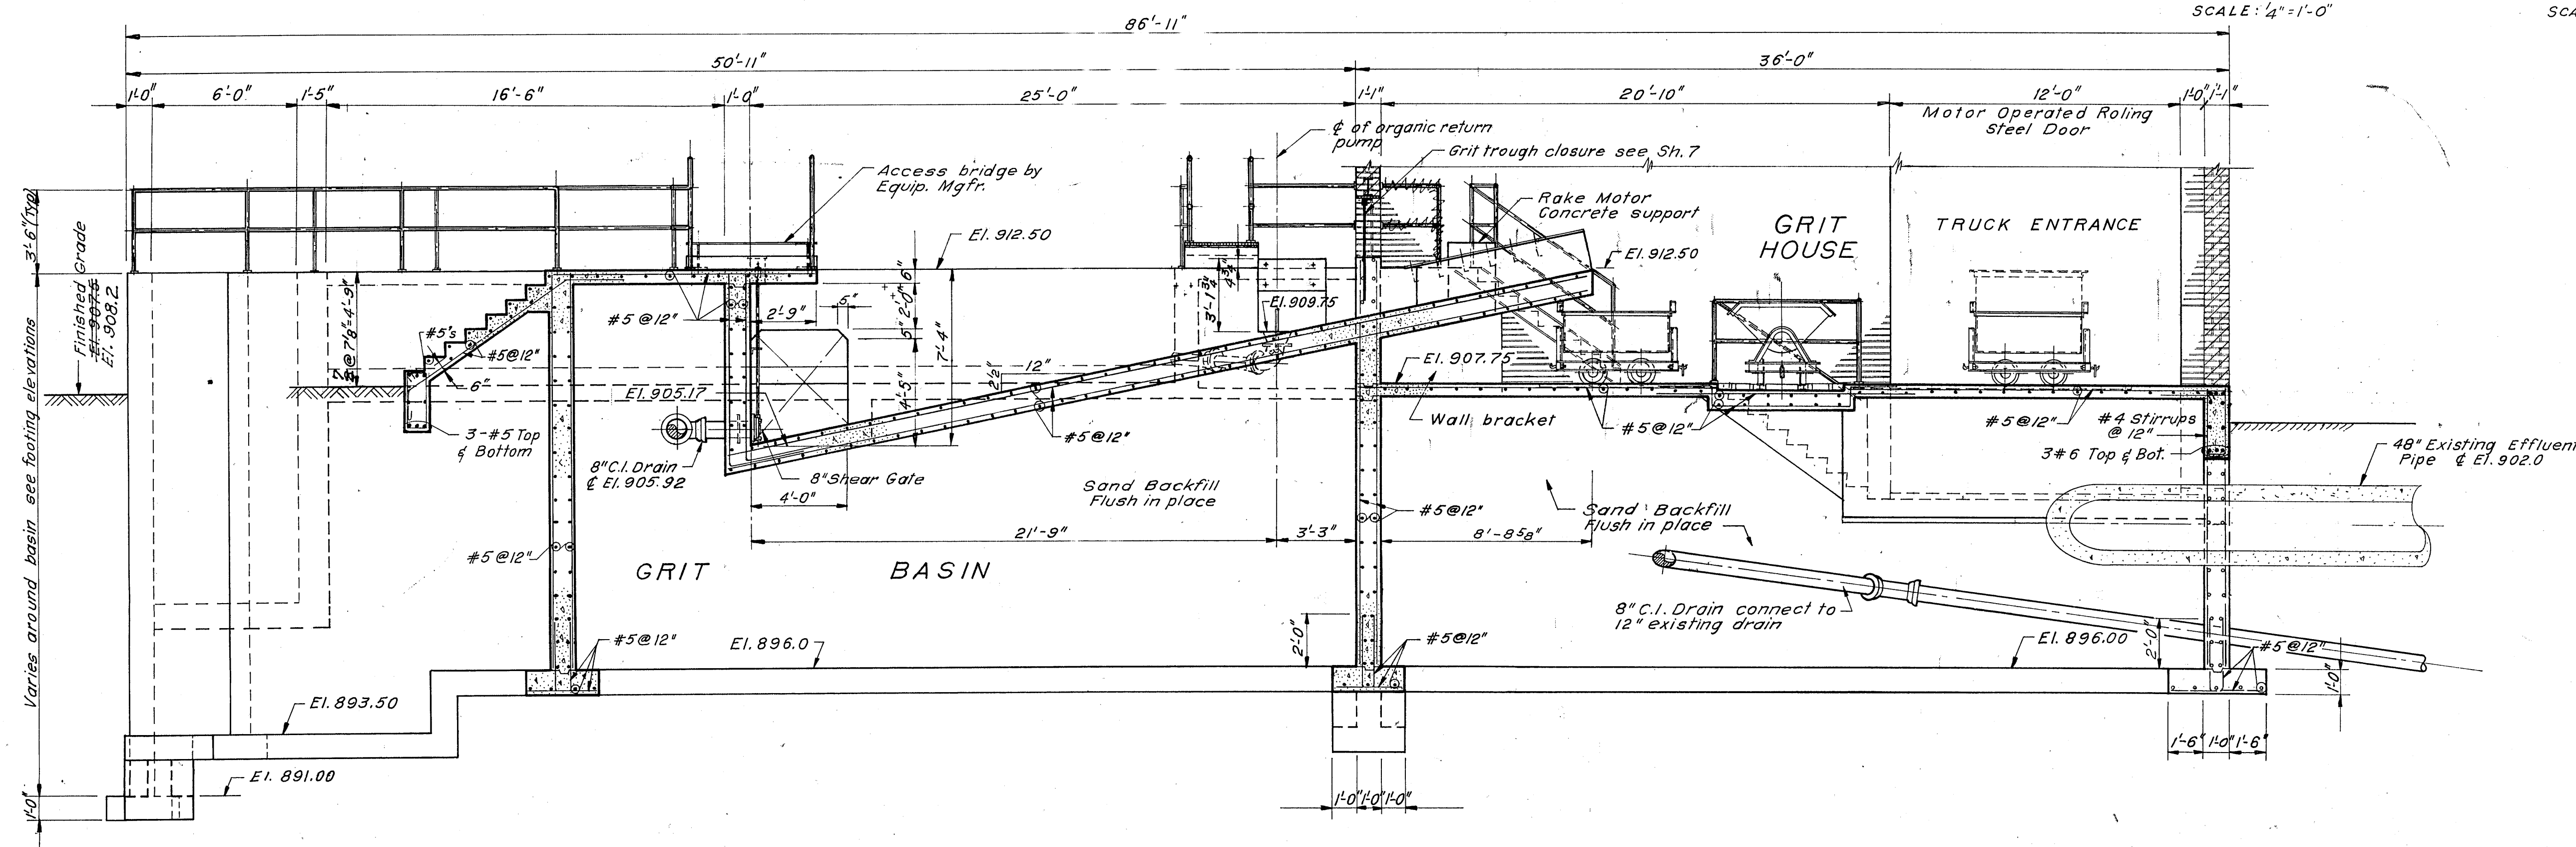

SECTION C-C
SCALE: 1/4"=1'-0"

AS BUILT

CONTR. "C"

ADDITIONS TO SEWAGE TREATMENT PLANT
ROANOKE, VIRGINIA

GRIT BASIN & BUILDING
SECTIONS

ALVORD, BURDICK & HOWSON
ENGINEERS

1973

