
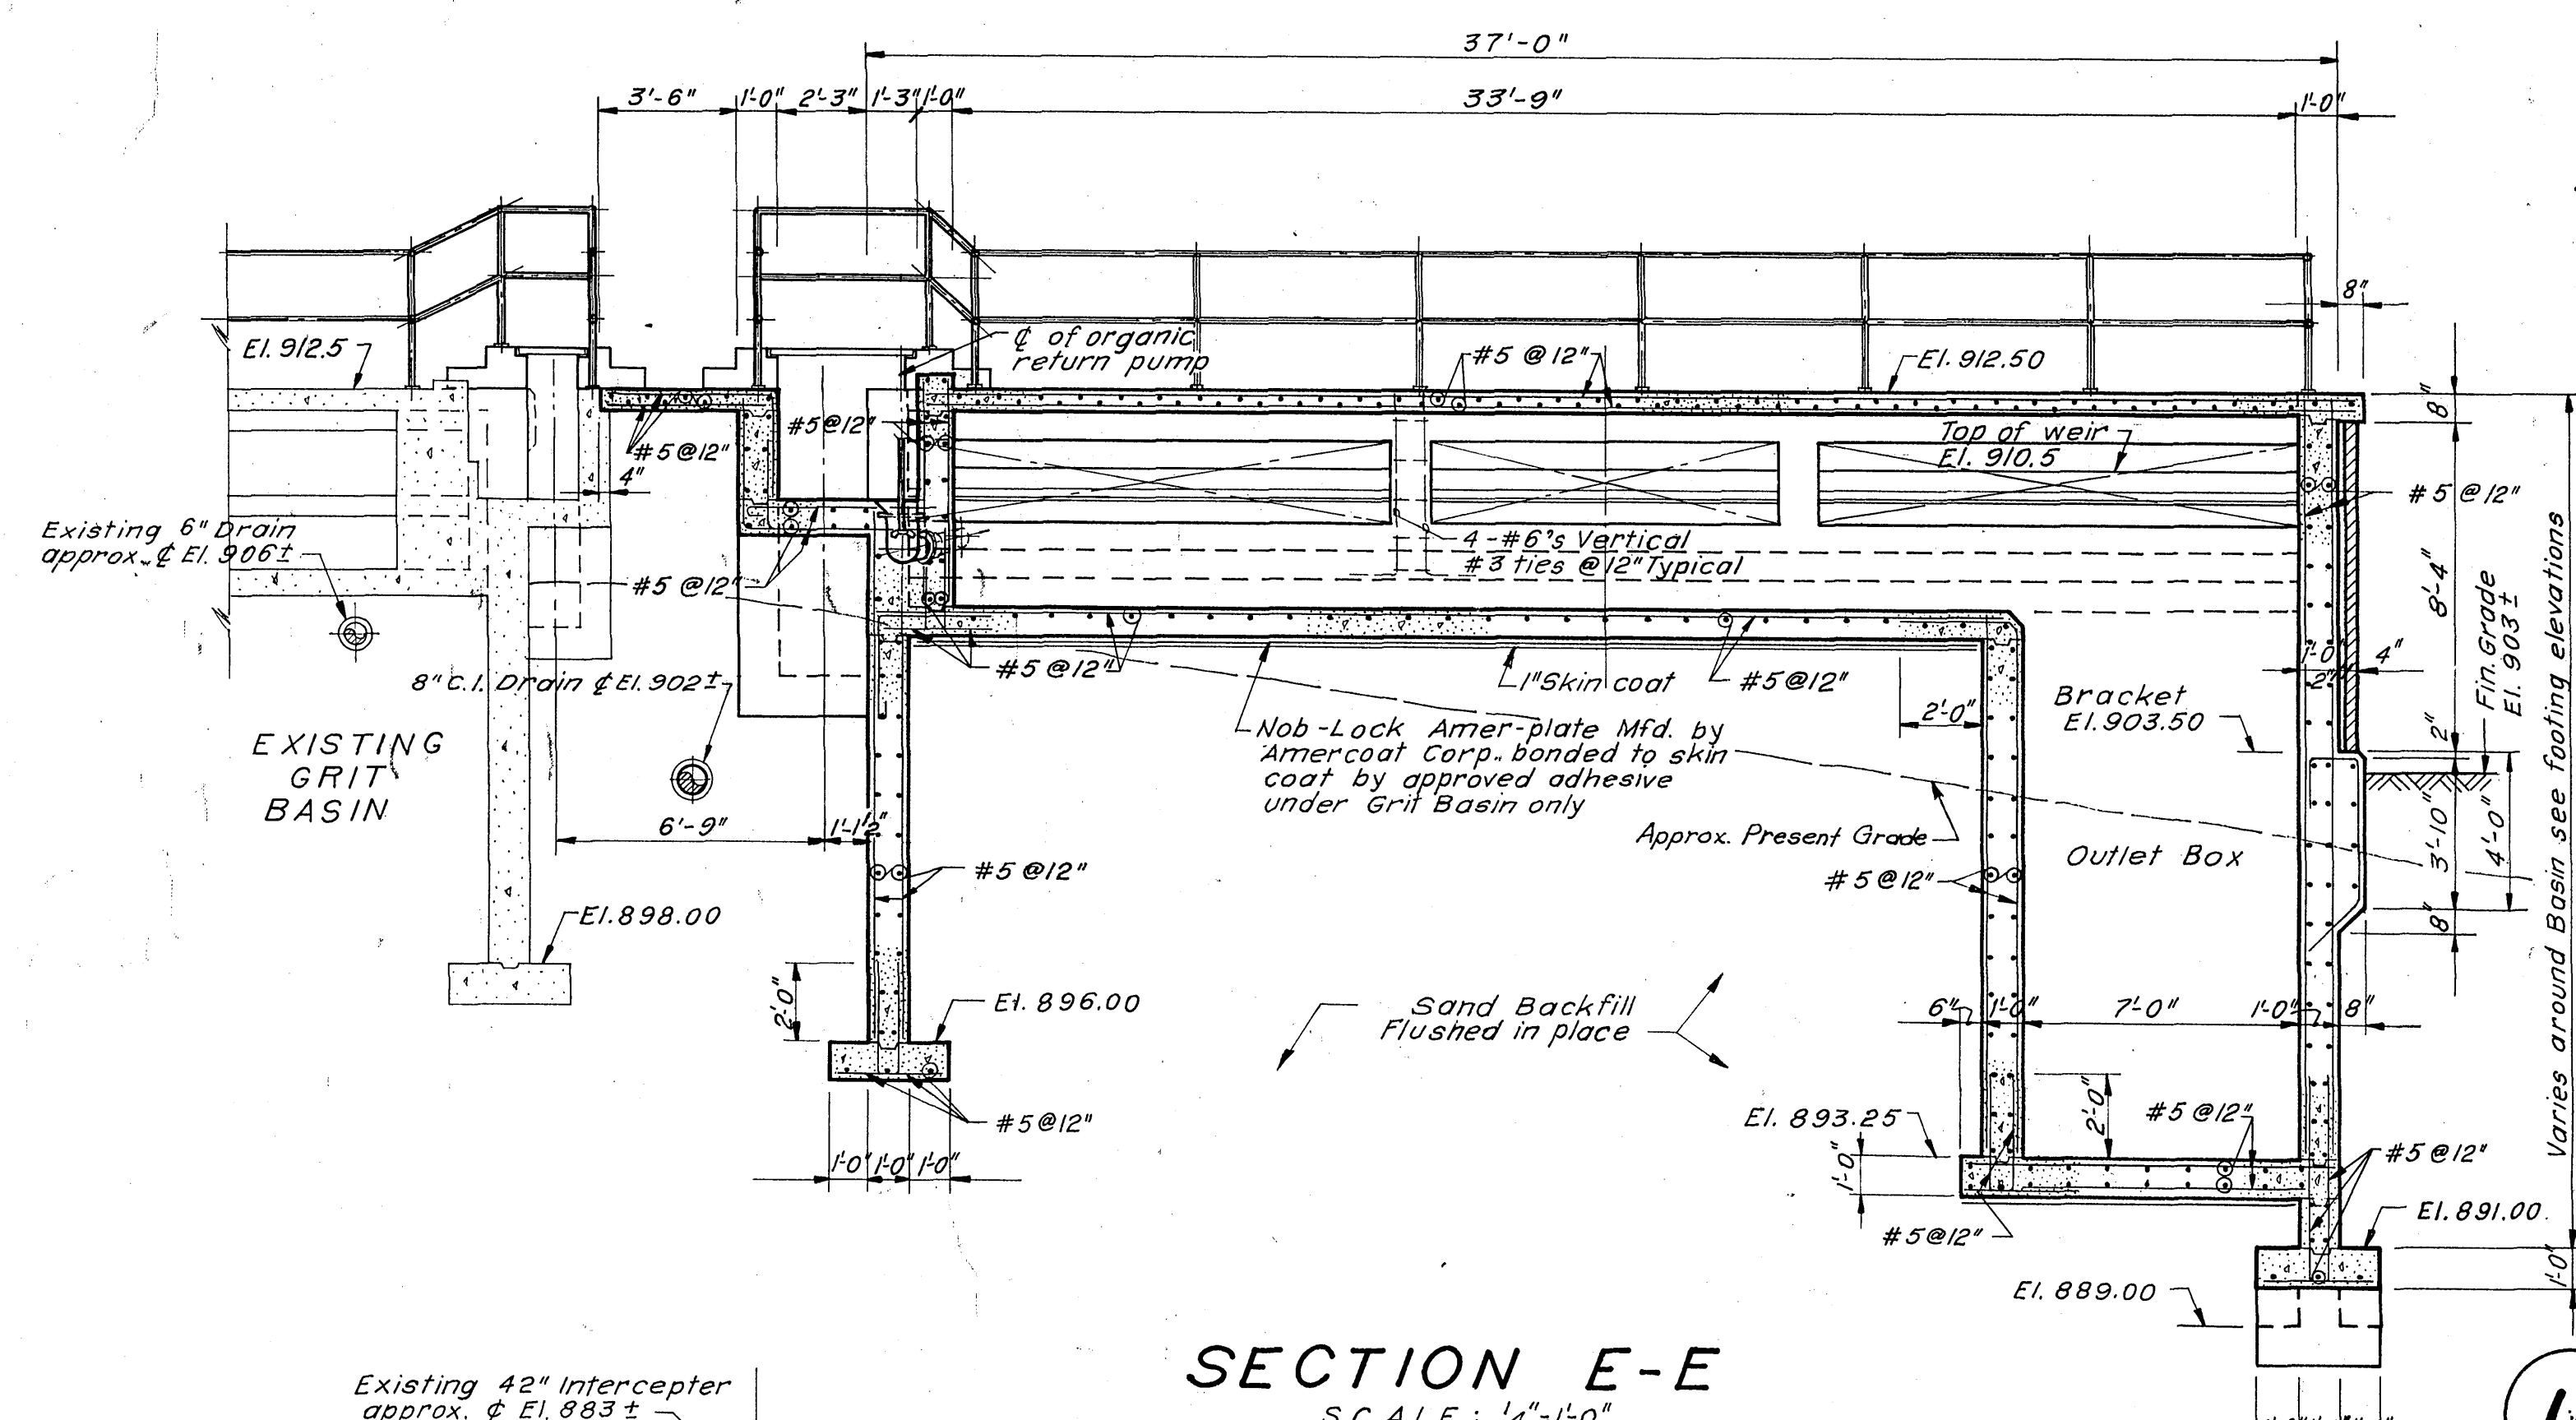
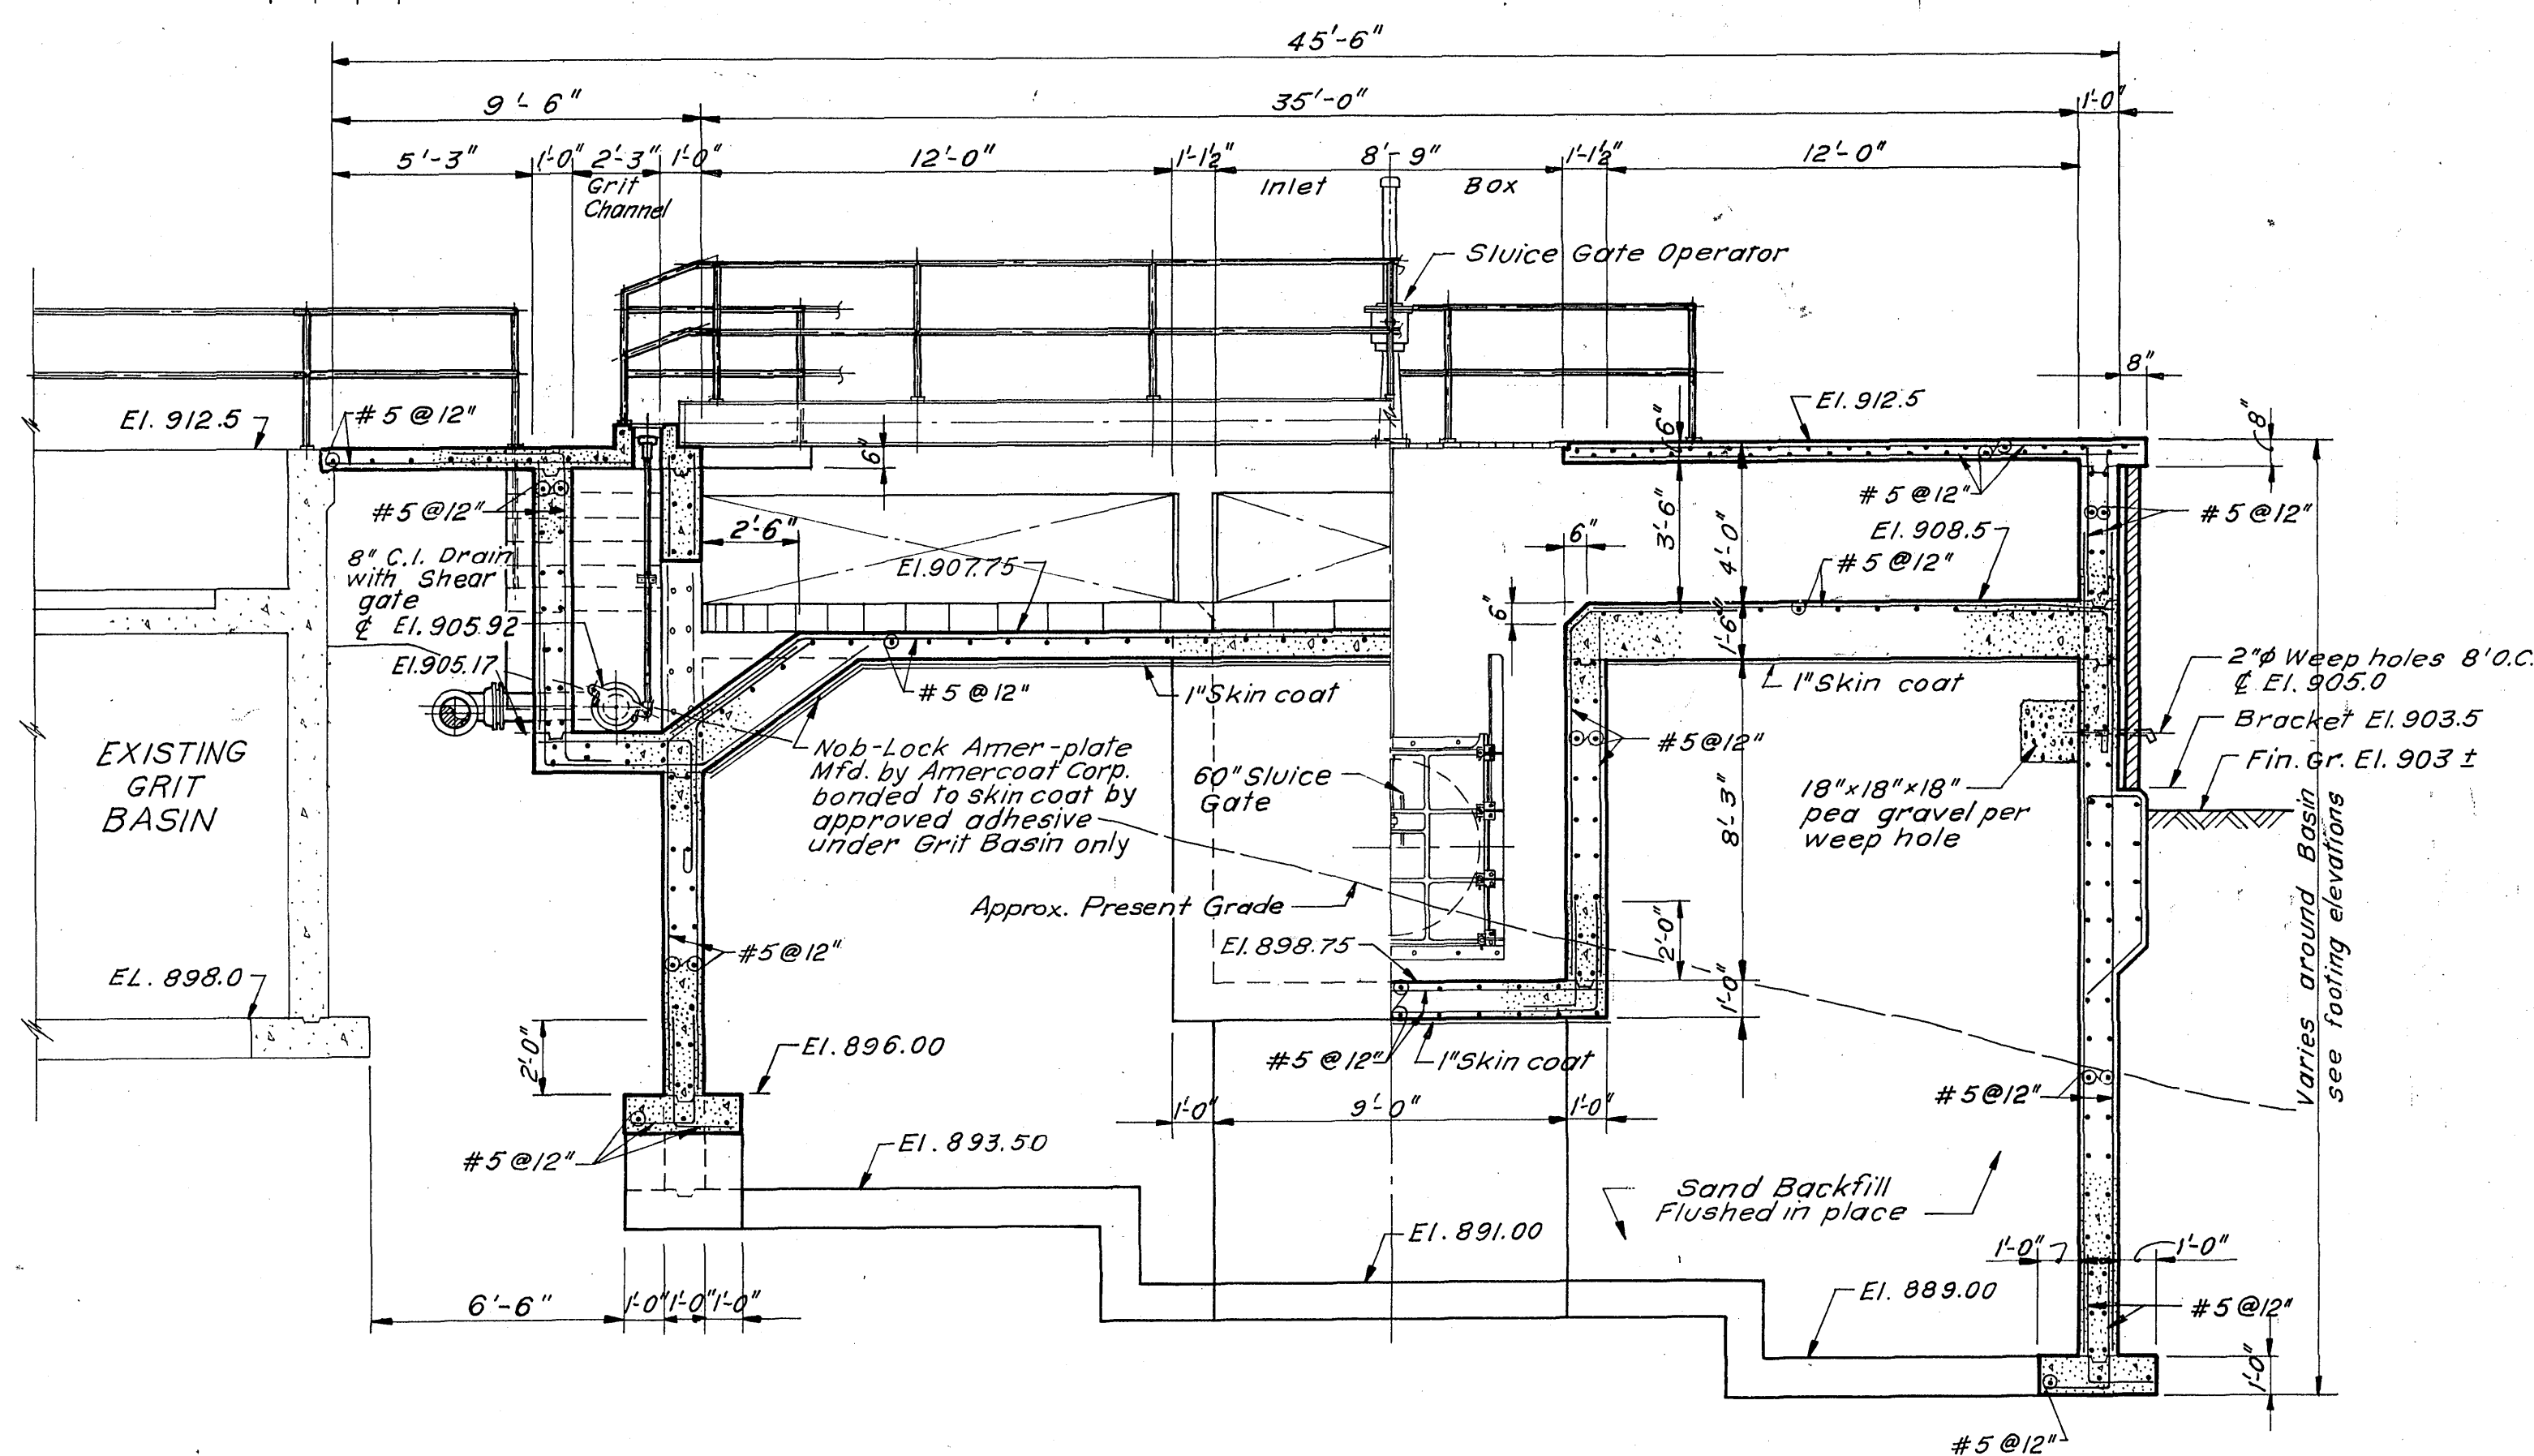


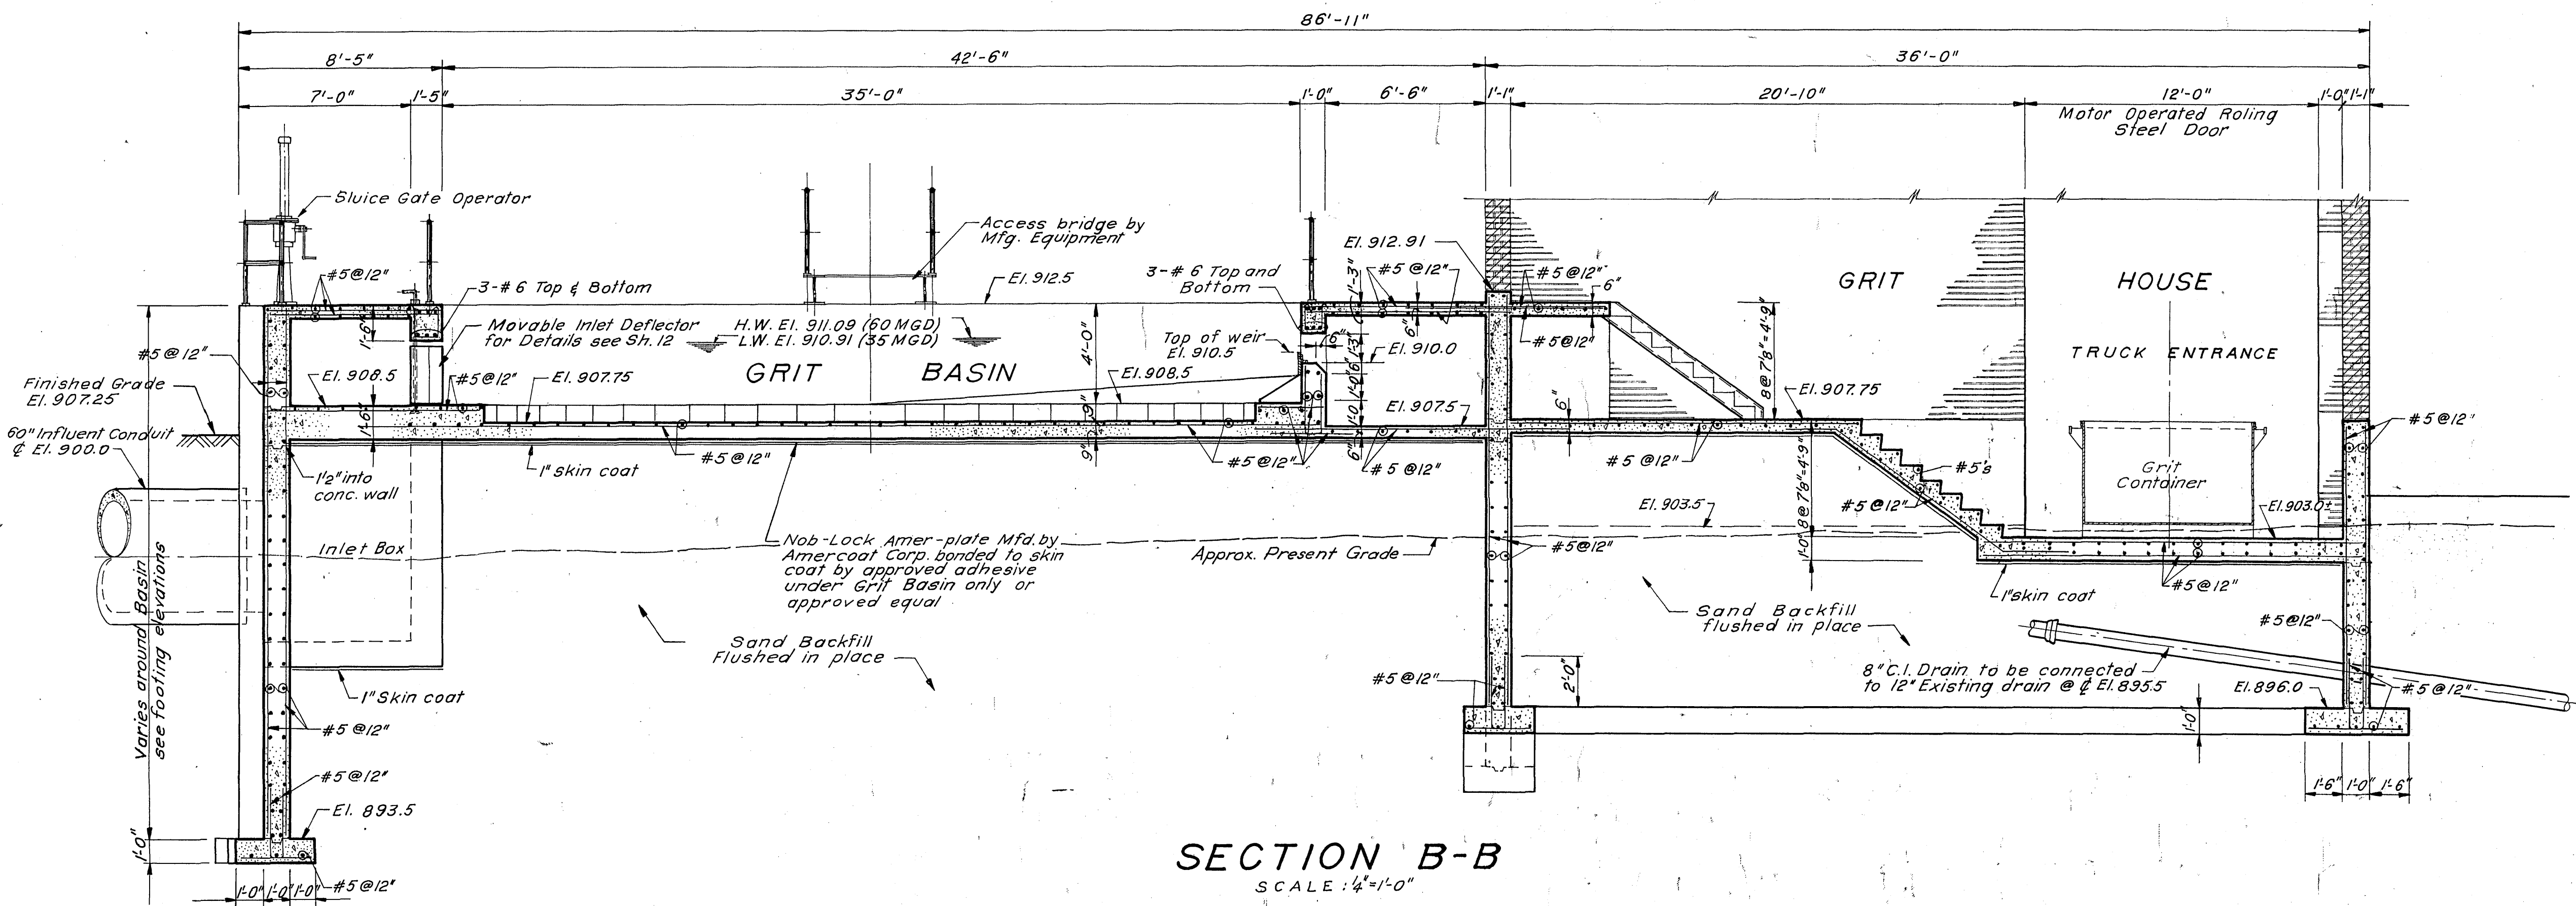

AS BUILT

CONTR. "C"

ADDITIONS TO SEWAGE TREATMENT PLANT
ROANOKE, VIRGINIA

GRIT BASIN & BUILDING
SECTIONS

ALVORD, BURDICK & HOWSON
ENGINEERS CHICAGO

1973

