




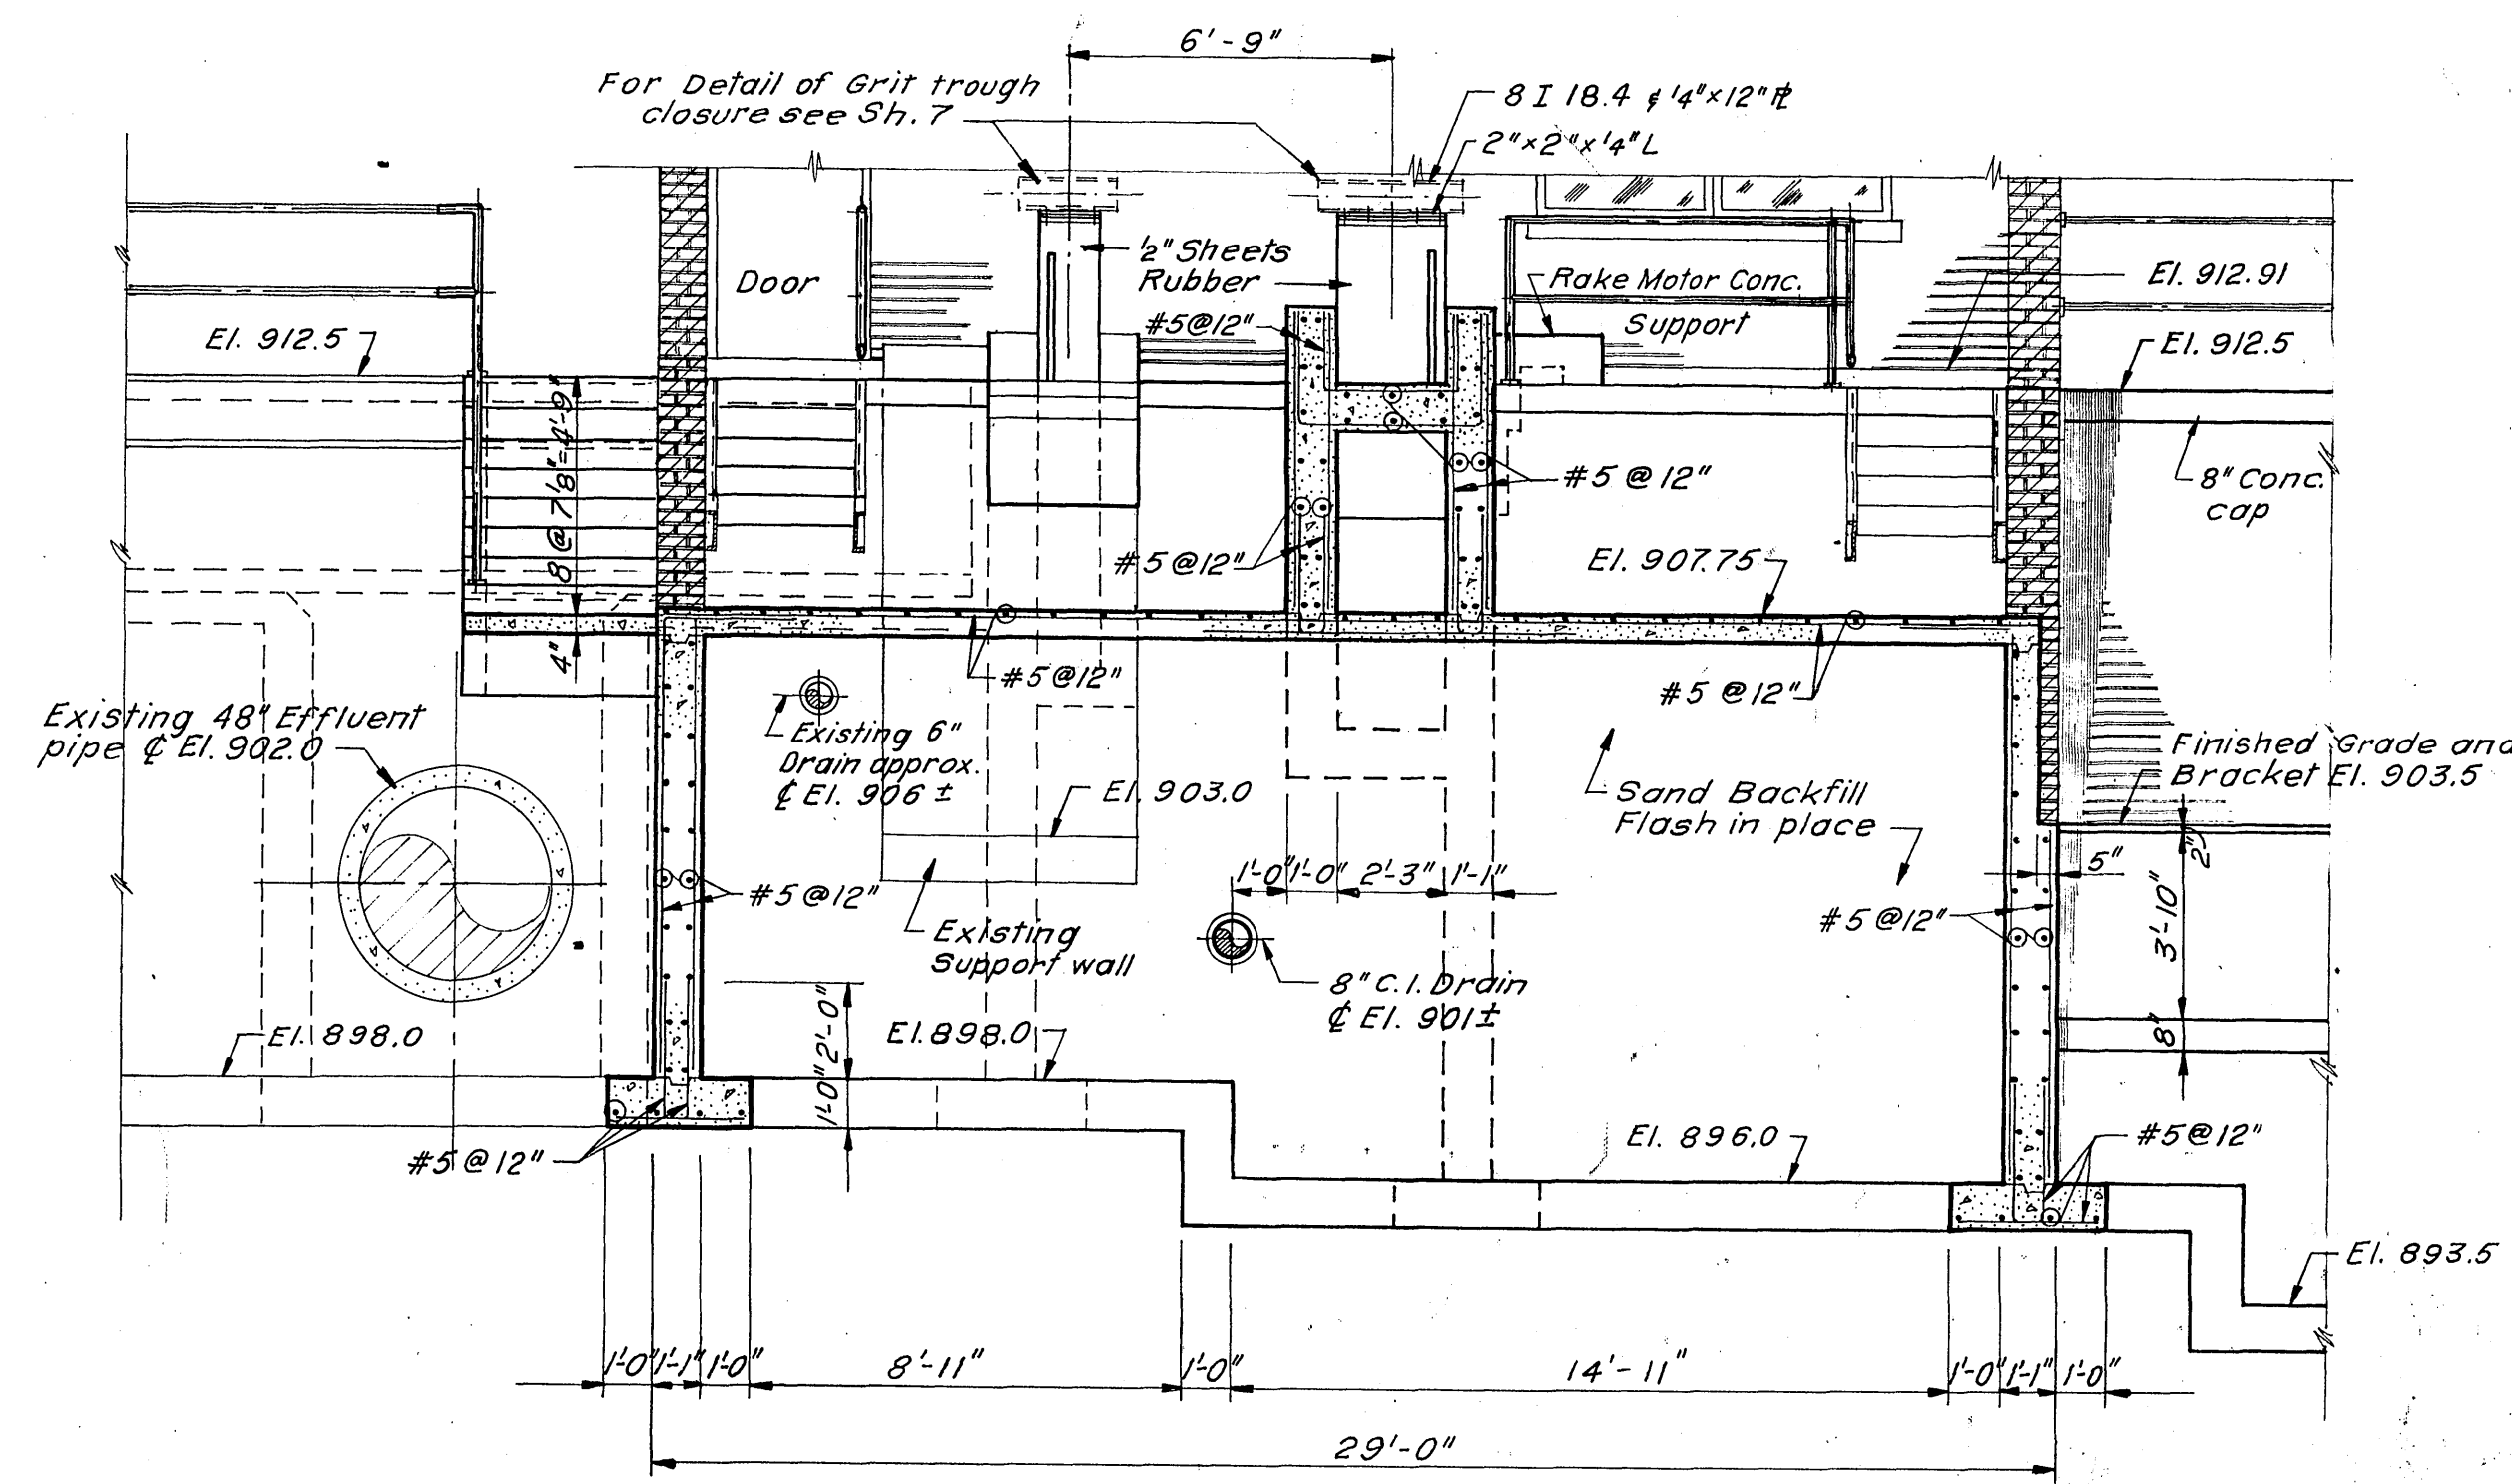


SECTION F-F
SCALE: 1/4"=1'-0"

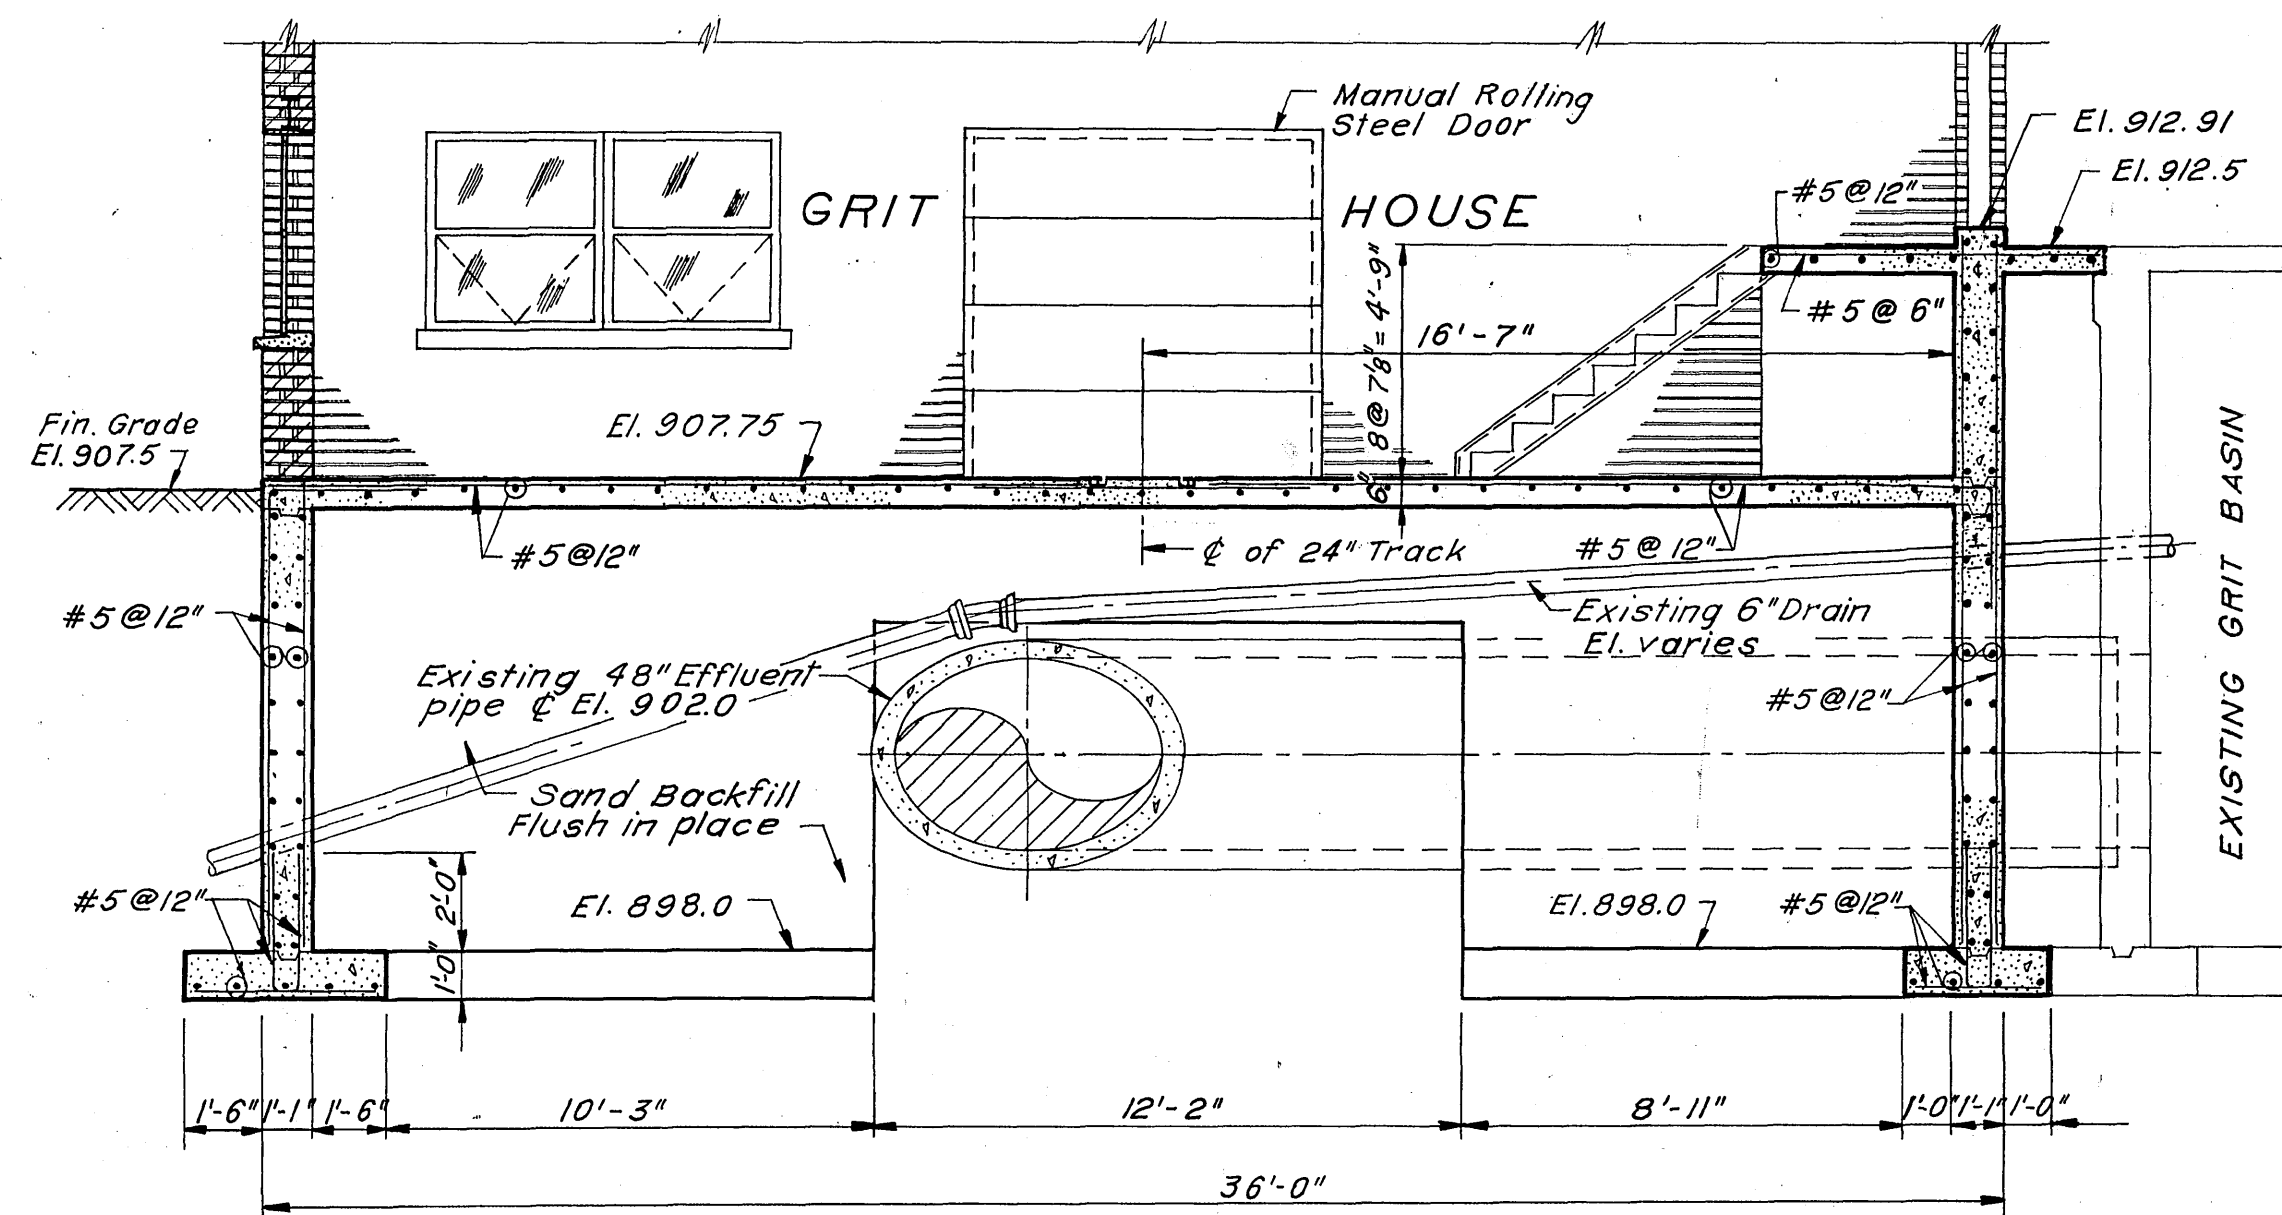


SECTION H-H
SCALE: 1/4"=1'-0"

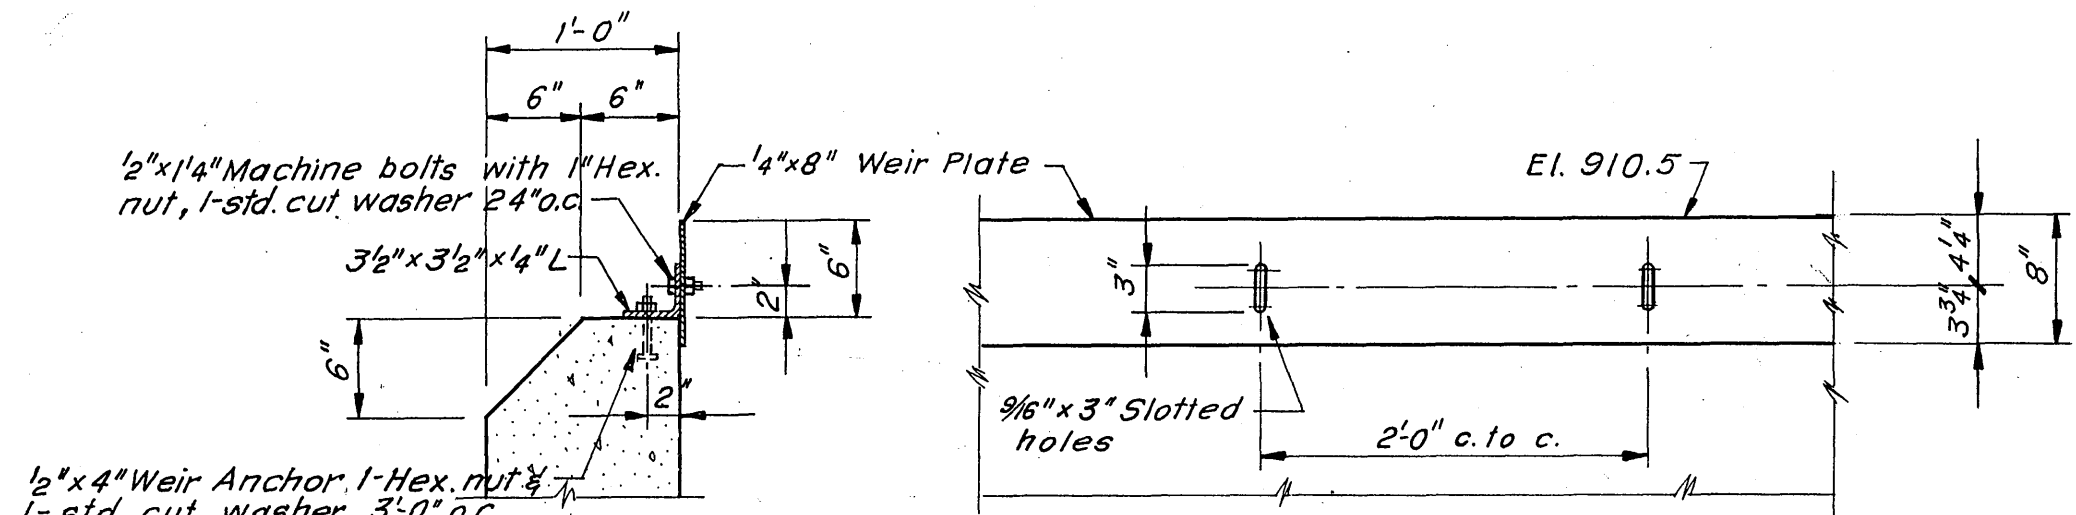


DETAIL OF WEIR PLATE
SCALE: 1"=1'-0"

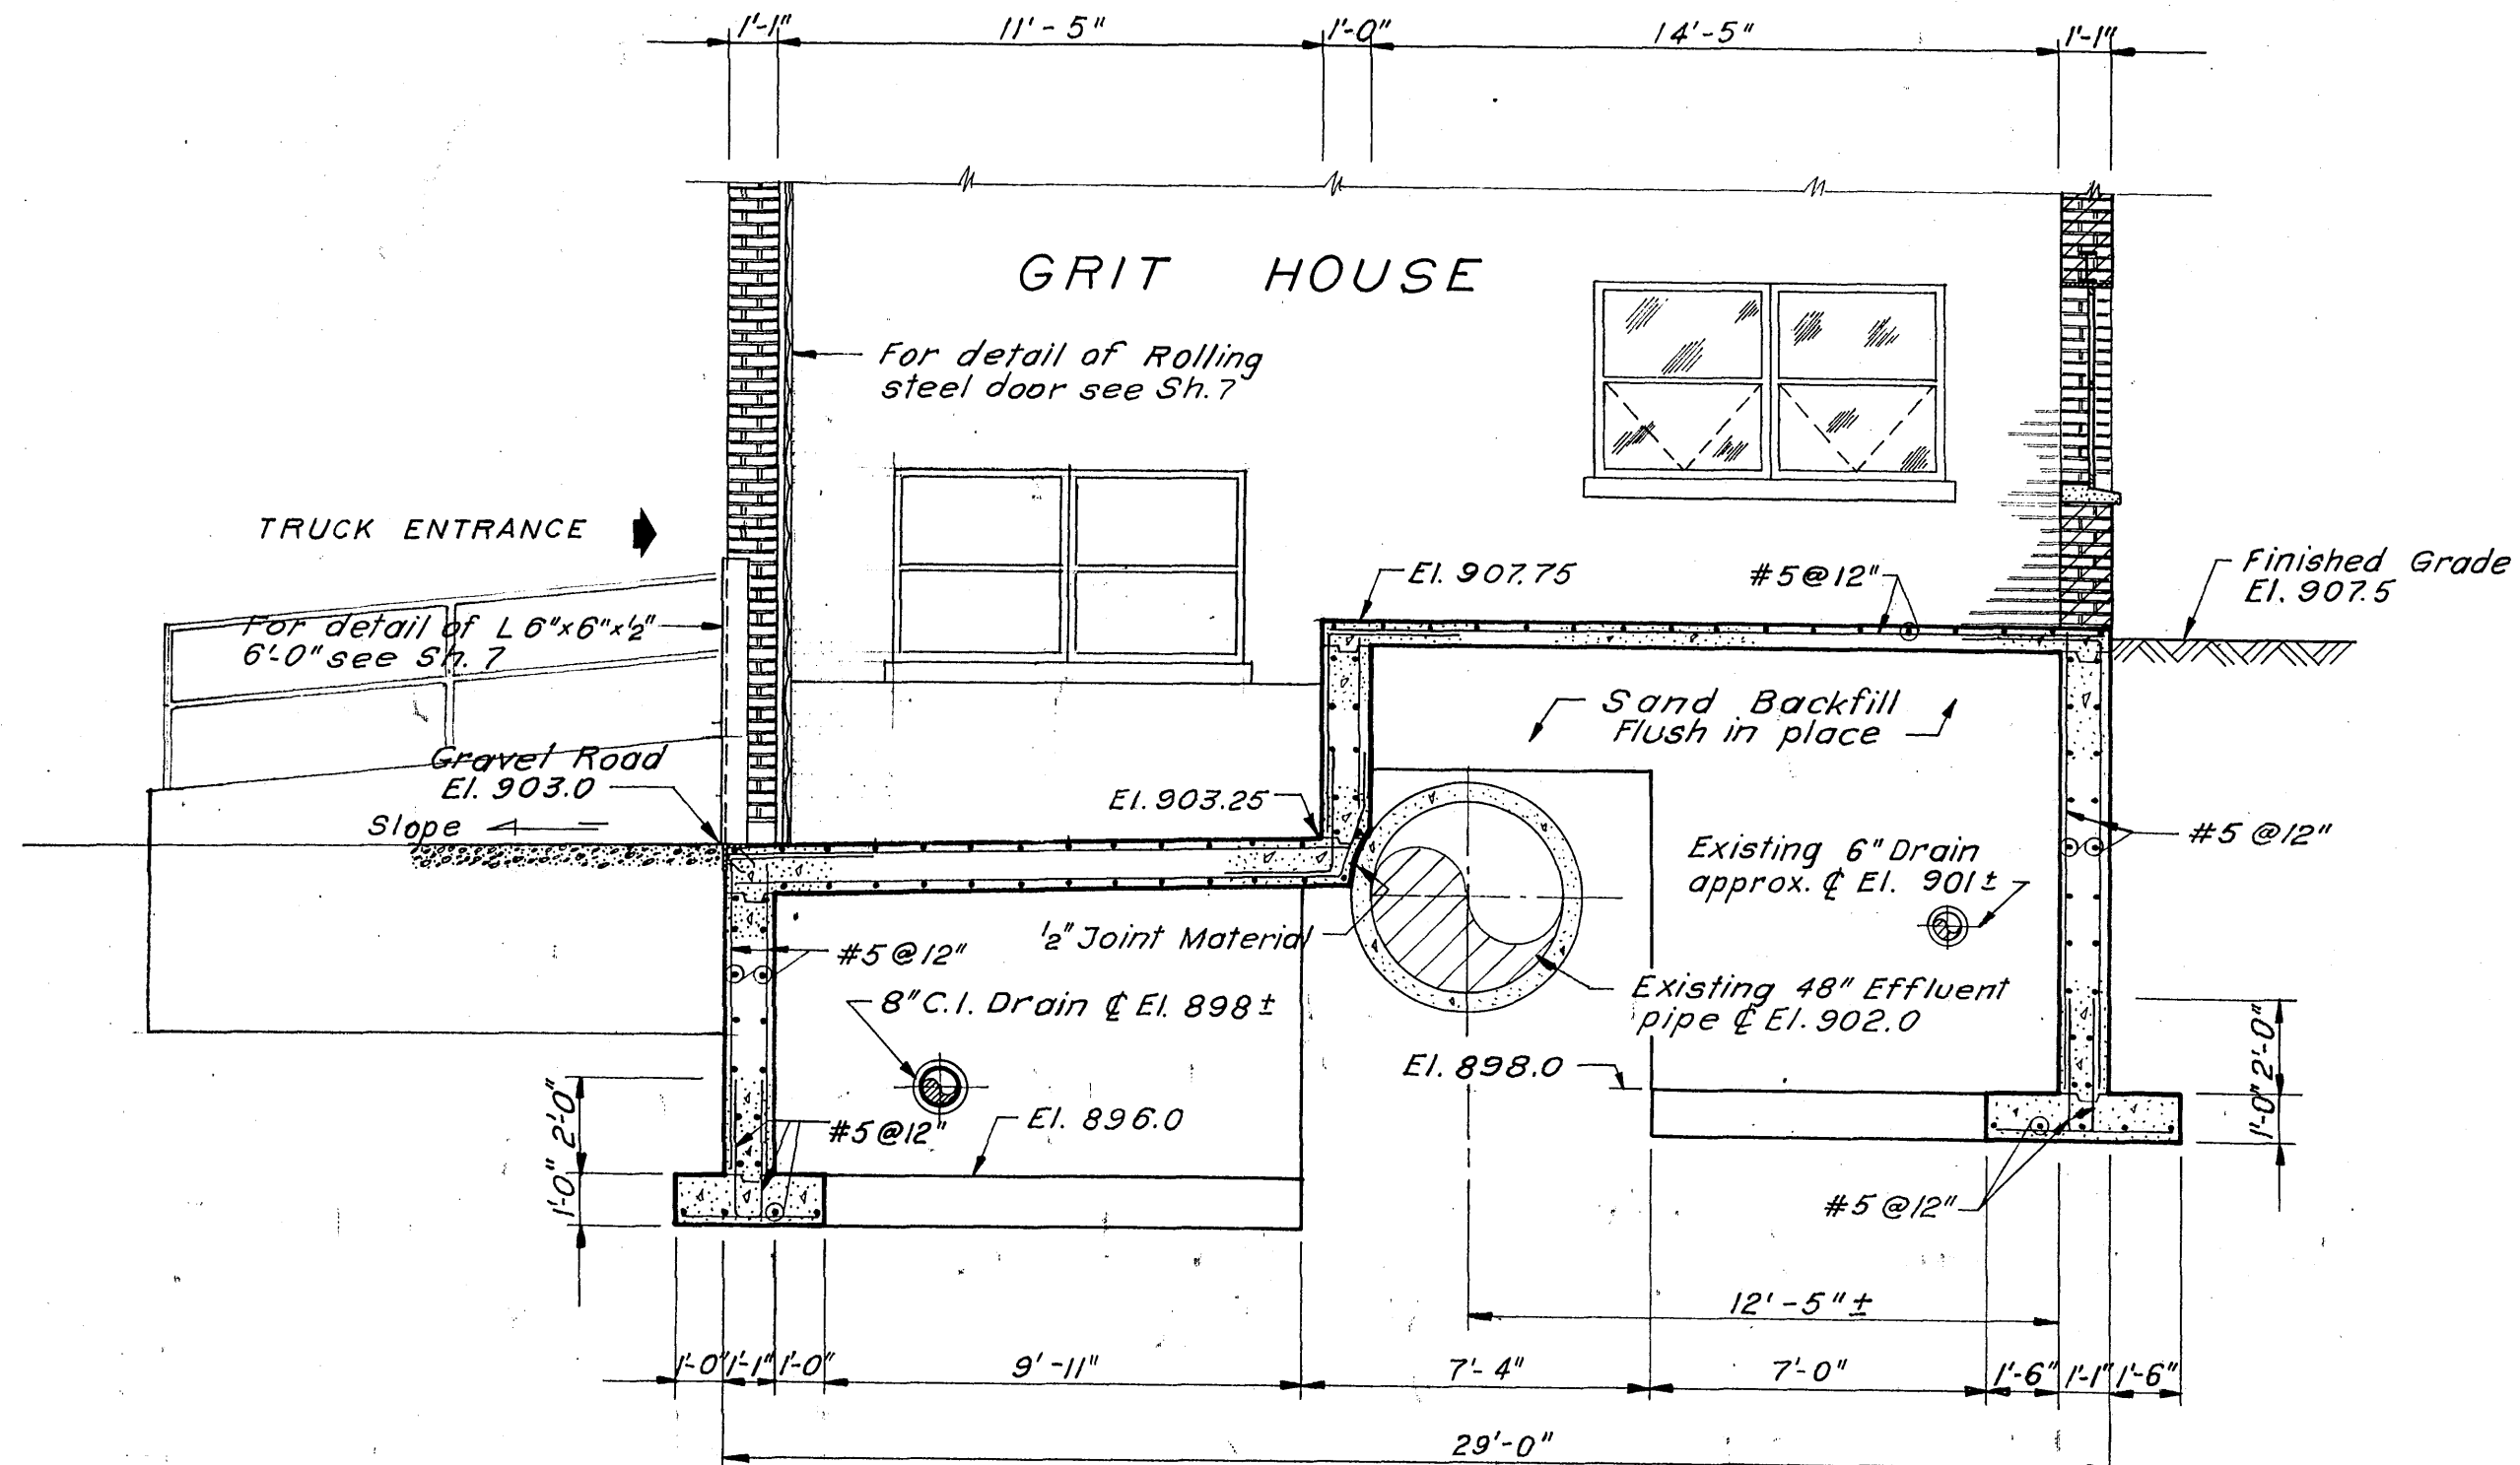


SECTION G-G
SCALE: 1/4"=1'-0"

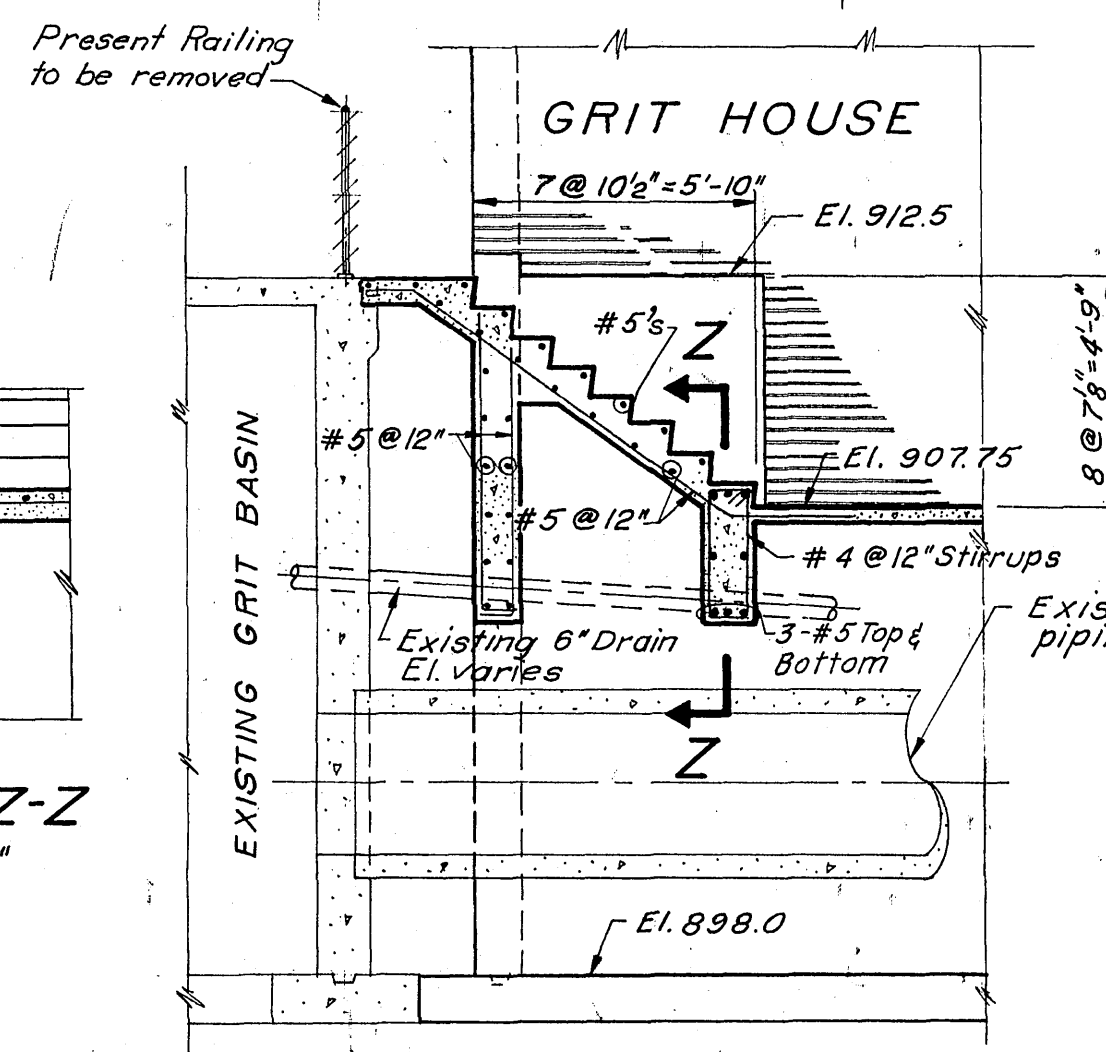


SECTION I-I
SCALE: 1/4"=1'-0"

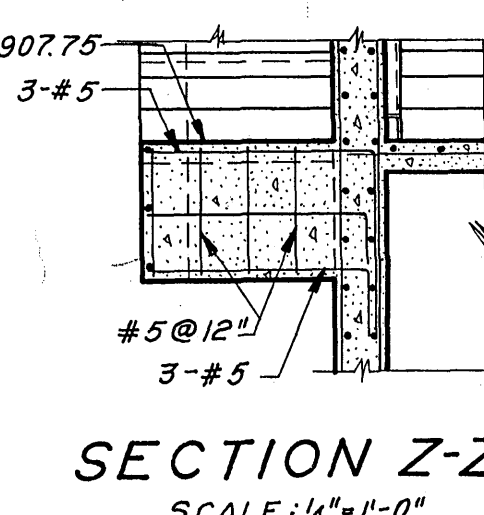


SECTION Z-Z
SCALE: 1/4"=1'-0"

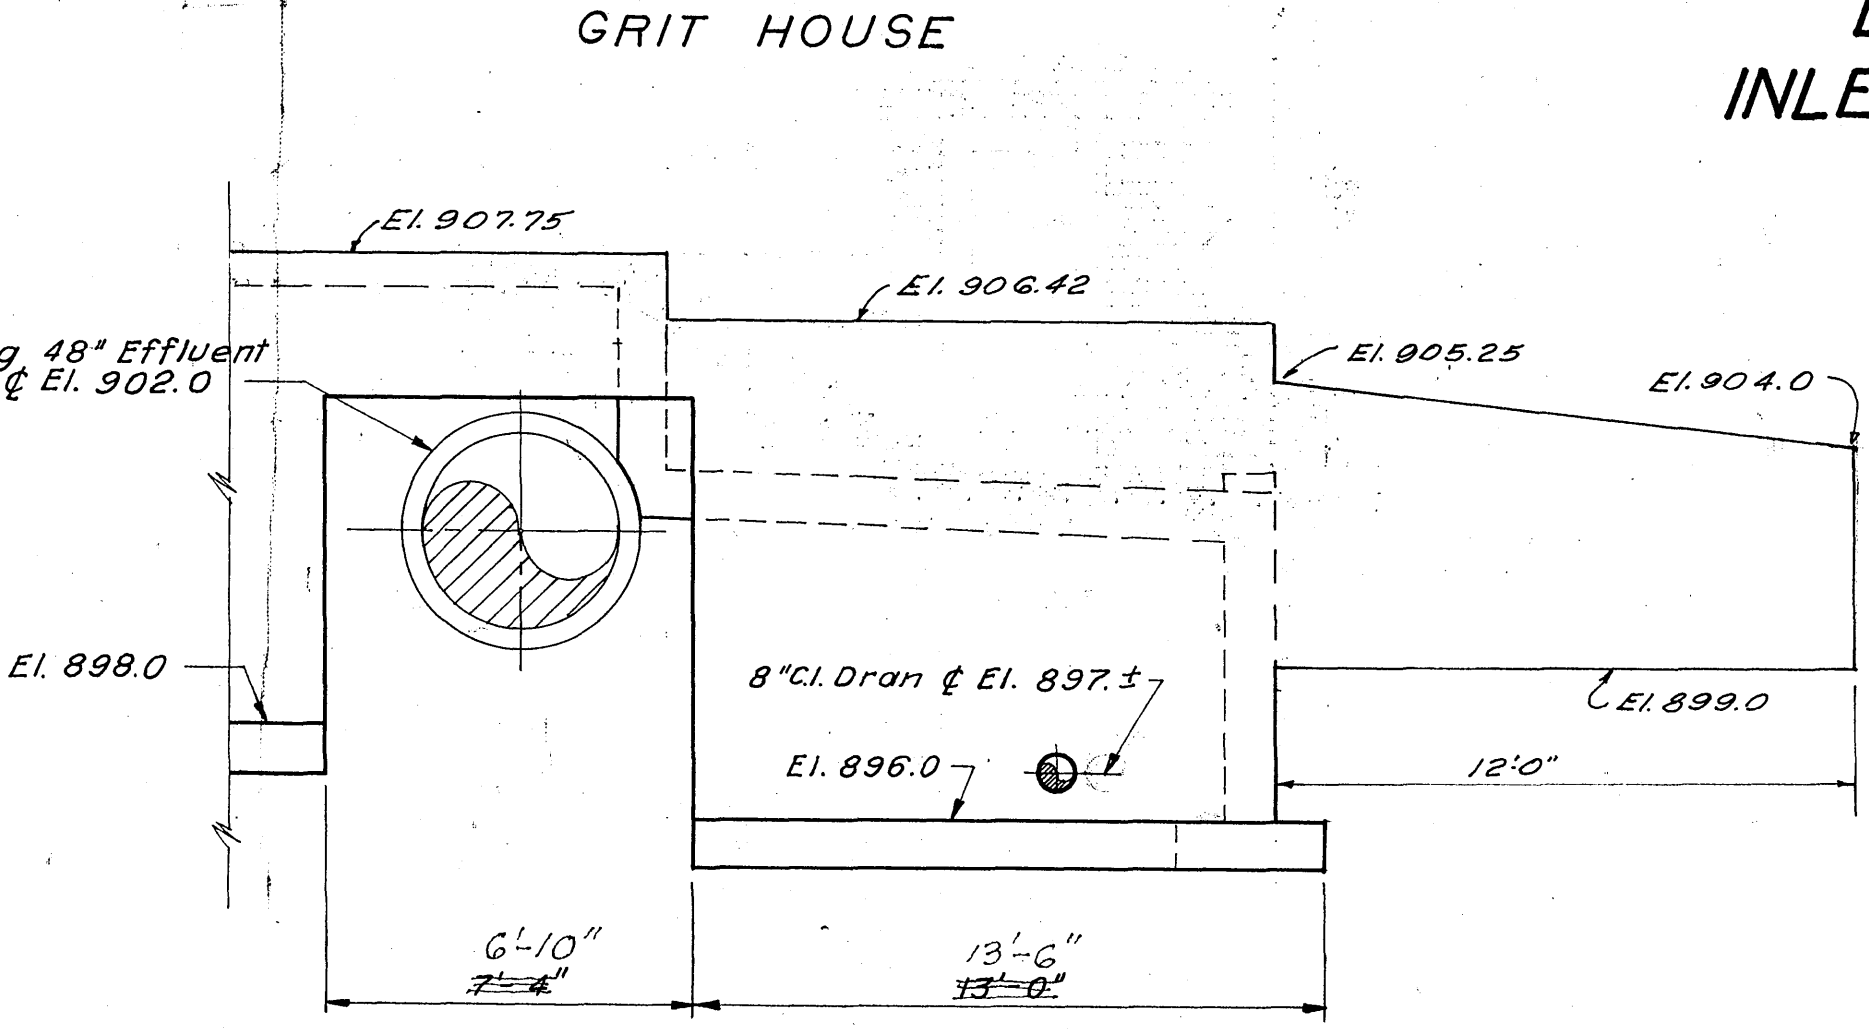

SECTION J-J
SCALE: 1/4"=1'-0"

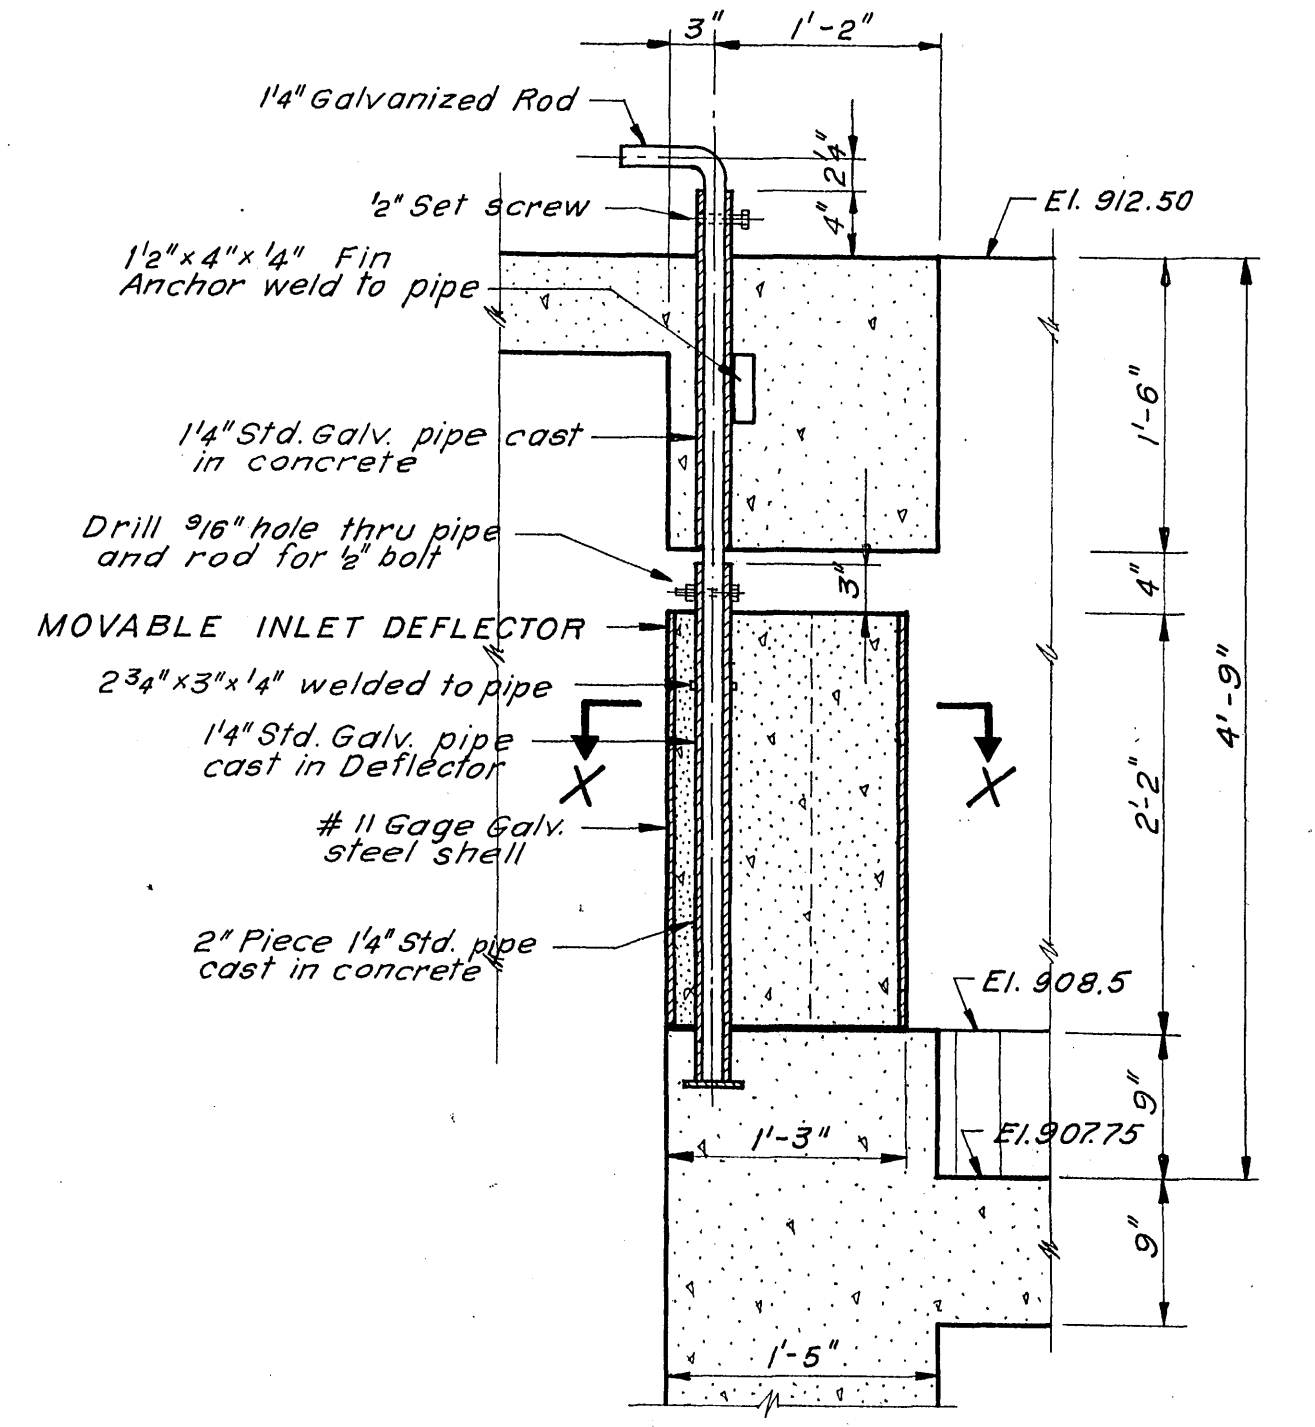

SECTION Y-Y

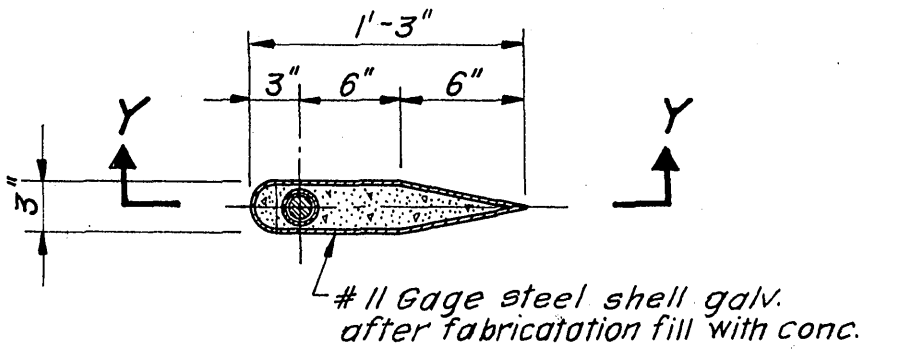

SECTION X-X

DETAILS OF INLET DEFLECTORS
SCALE: 1"=1'-0"
(20 Required)


AS BUILT

CONTR. "C"

ADDITIONS TO SEWAGE TREATMENT PLANT
ROANOKE, VIRGINIA
GRIT BASIN & BUILDING
SECTIONS

ALVORD, BURDICK & HOWSON
ENGINEERS CHICAGO

1973

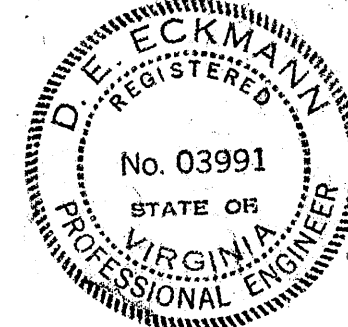

12