


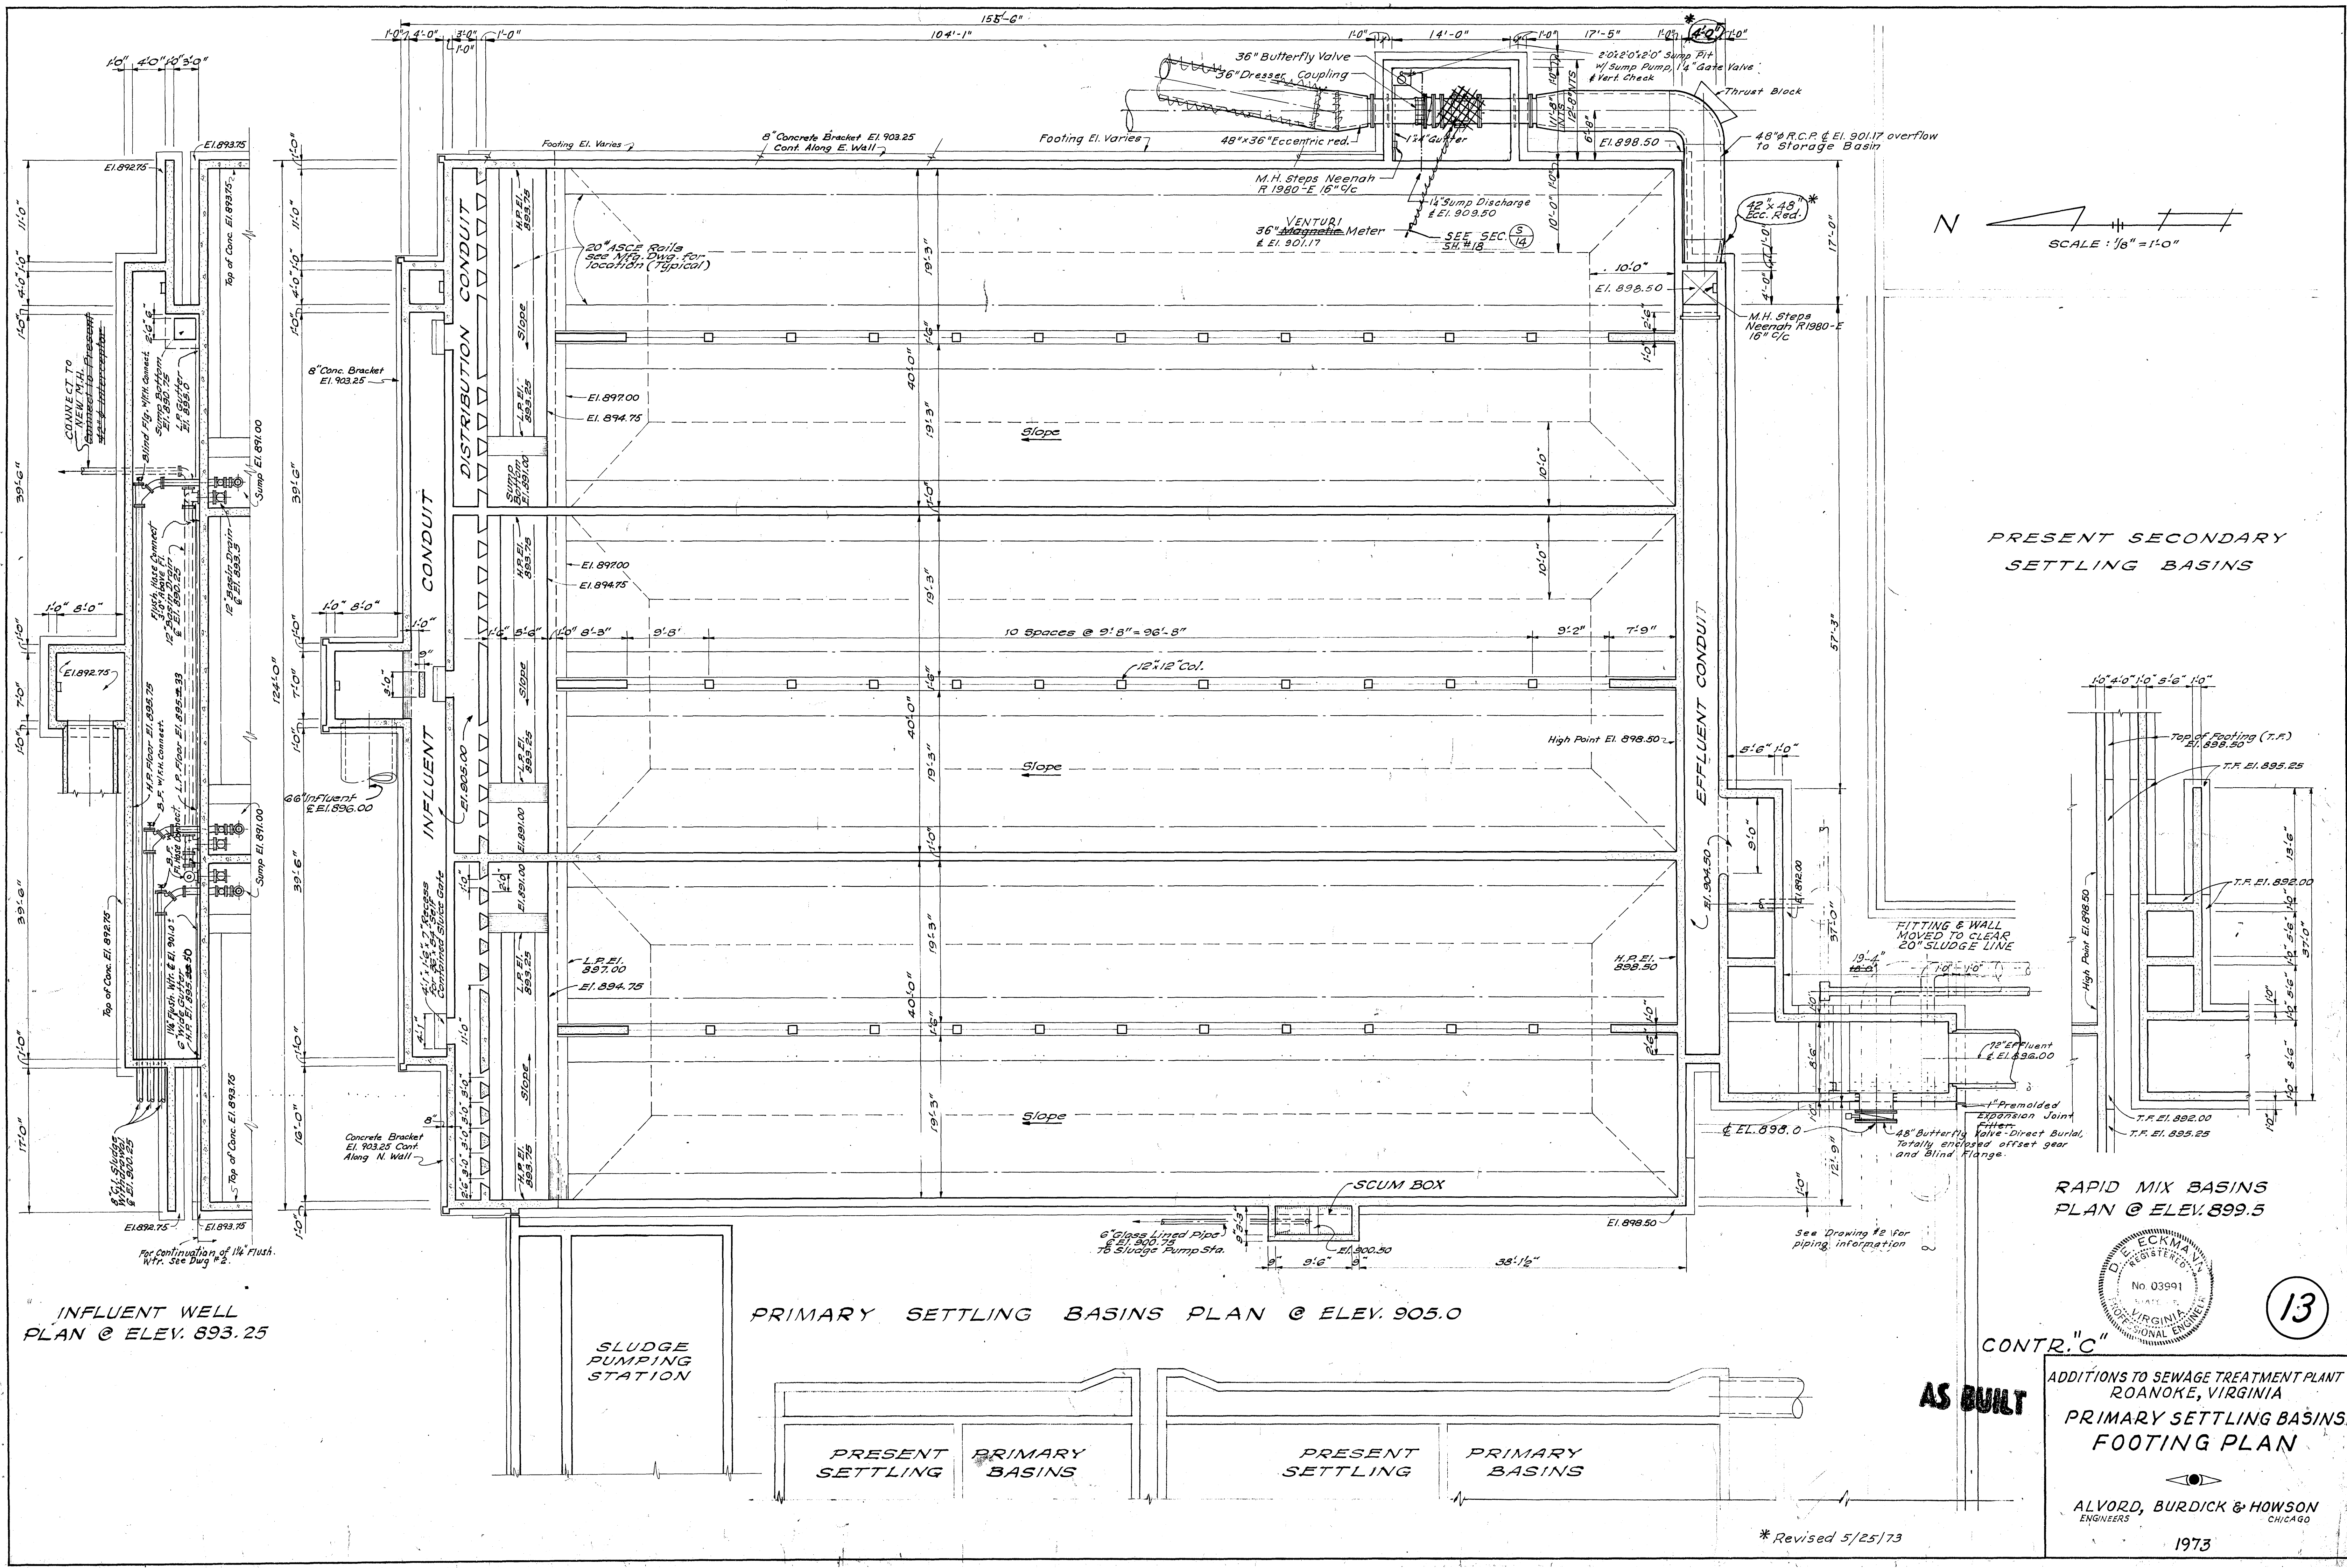

INFLUENT WELL
PLAN @ ELEV. 893.25

PRIMARY SETTLING BASINS PLAN @ ELEV. 905.0

PRESENT SECONDARY
SETTLING BASINS

RAPID MIX BASINS
PLAN @ ELEV. 899.5

CONTR. "C"

AS BUILT

PRESENT
SETTLING
BASINS

PRESENT
SETTLING
BASINS

PRIMARY
BASINS

ADDITIONS TO SEWAGE TREATMENT PLANT
ROANOKE, VIRGINIA
PRIMARY SETTLING BASINS
FOOTING PLAN

ALVORD, BURDICK & HOWSON
ENGINEERS CHICAGO

* Revised 5/25/73

1973