



SECTION A-1
Scale: 4" = 1'-0"

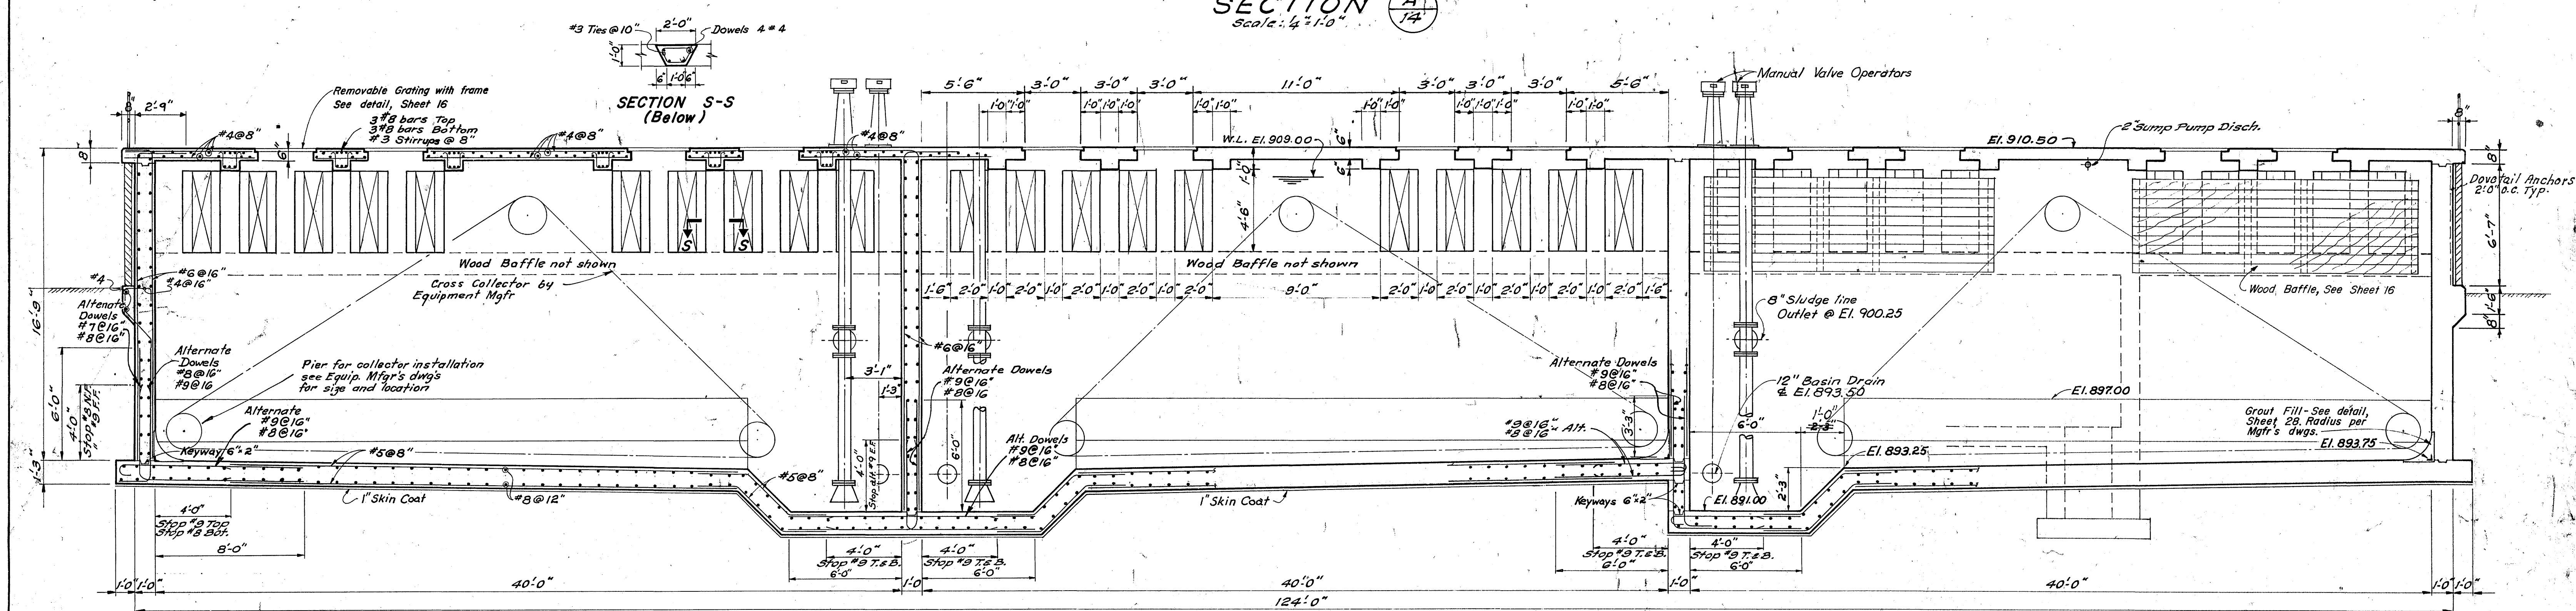


SECTION S-S (Below)
Scale: 4" = 1'-0"

ALL REINFORCING STEEL IS #5 @ 12" UNLESS NOTED

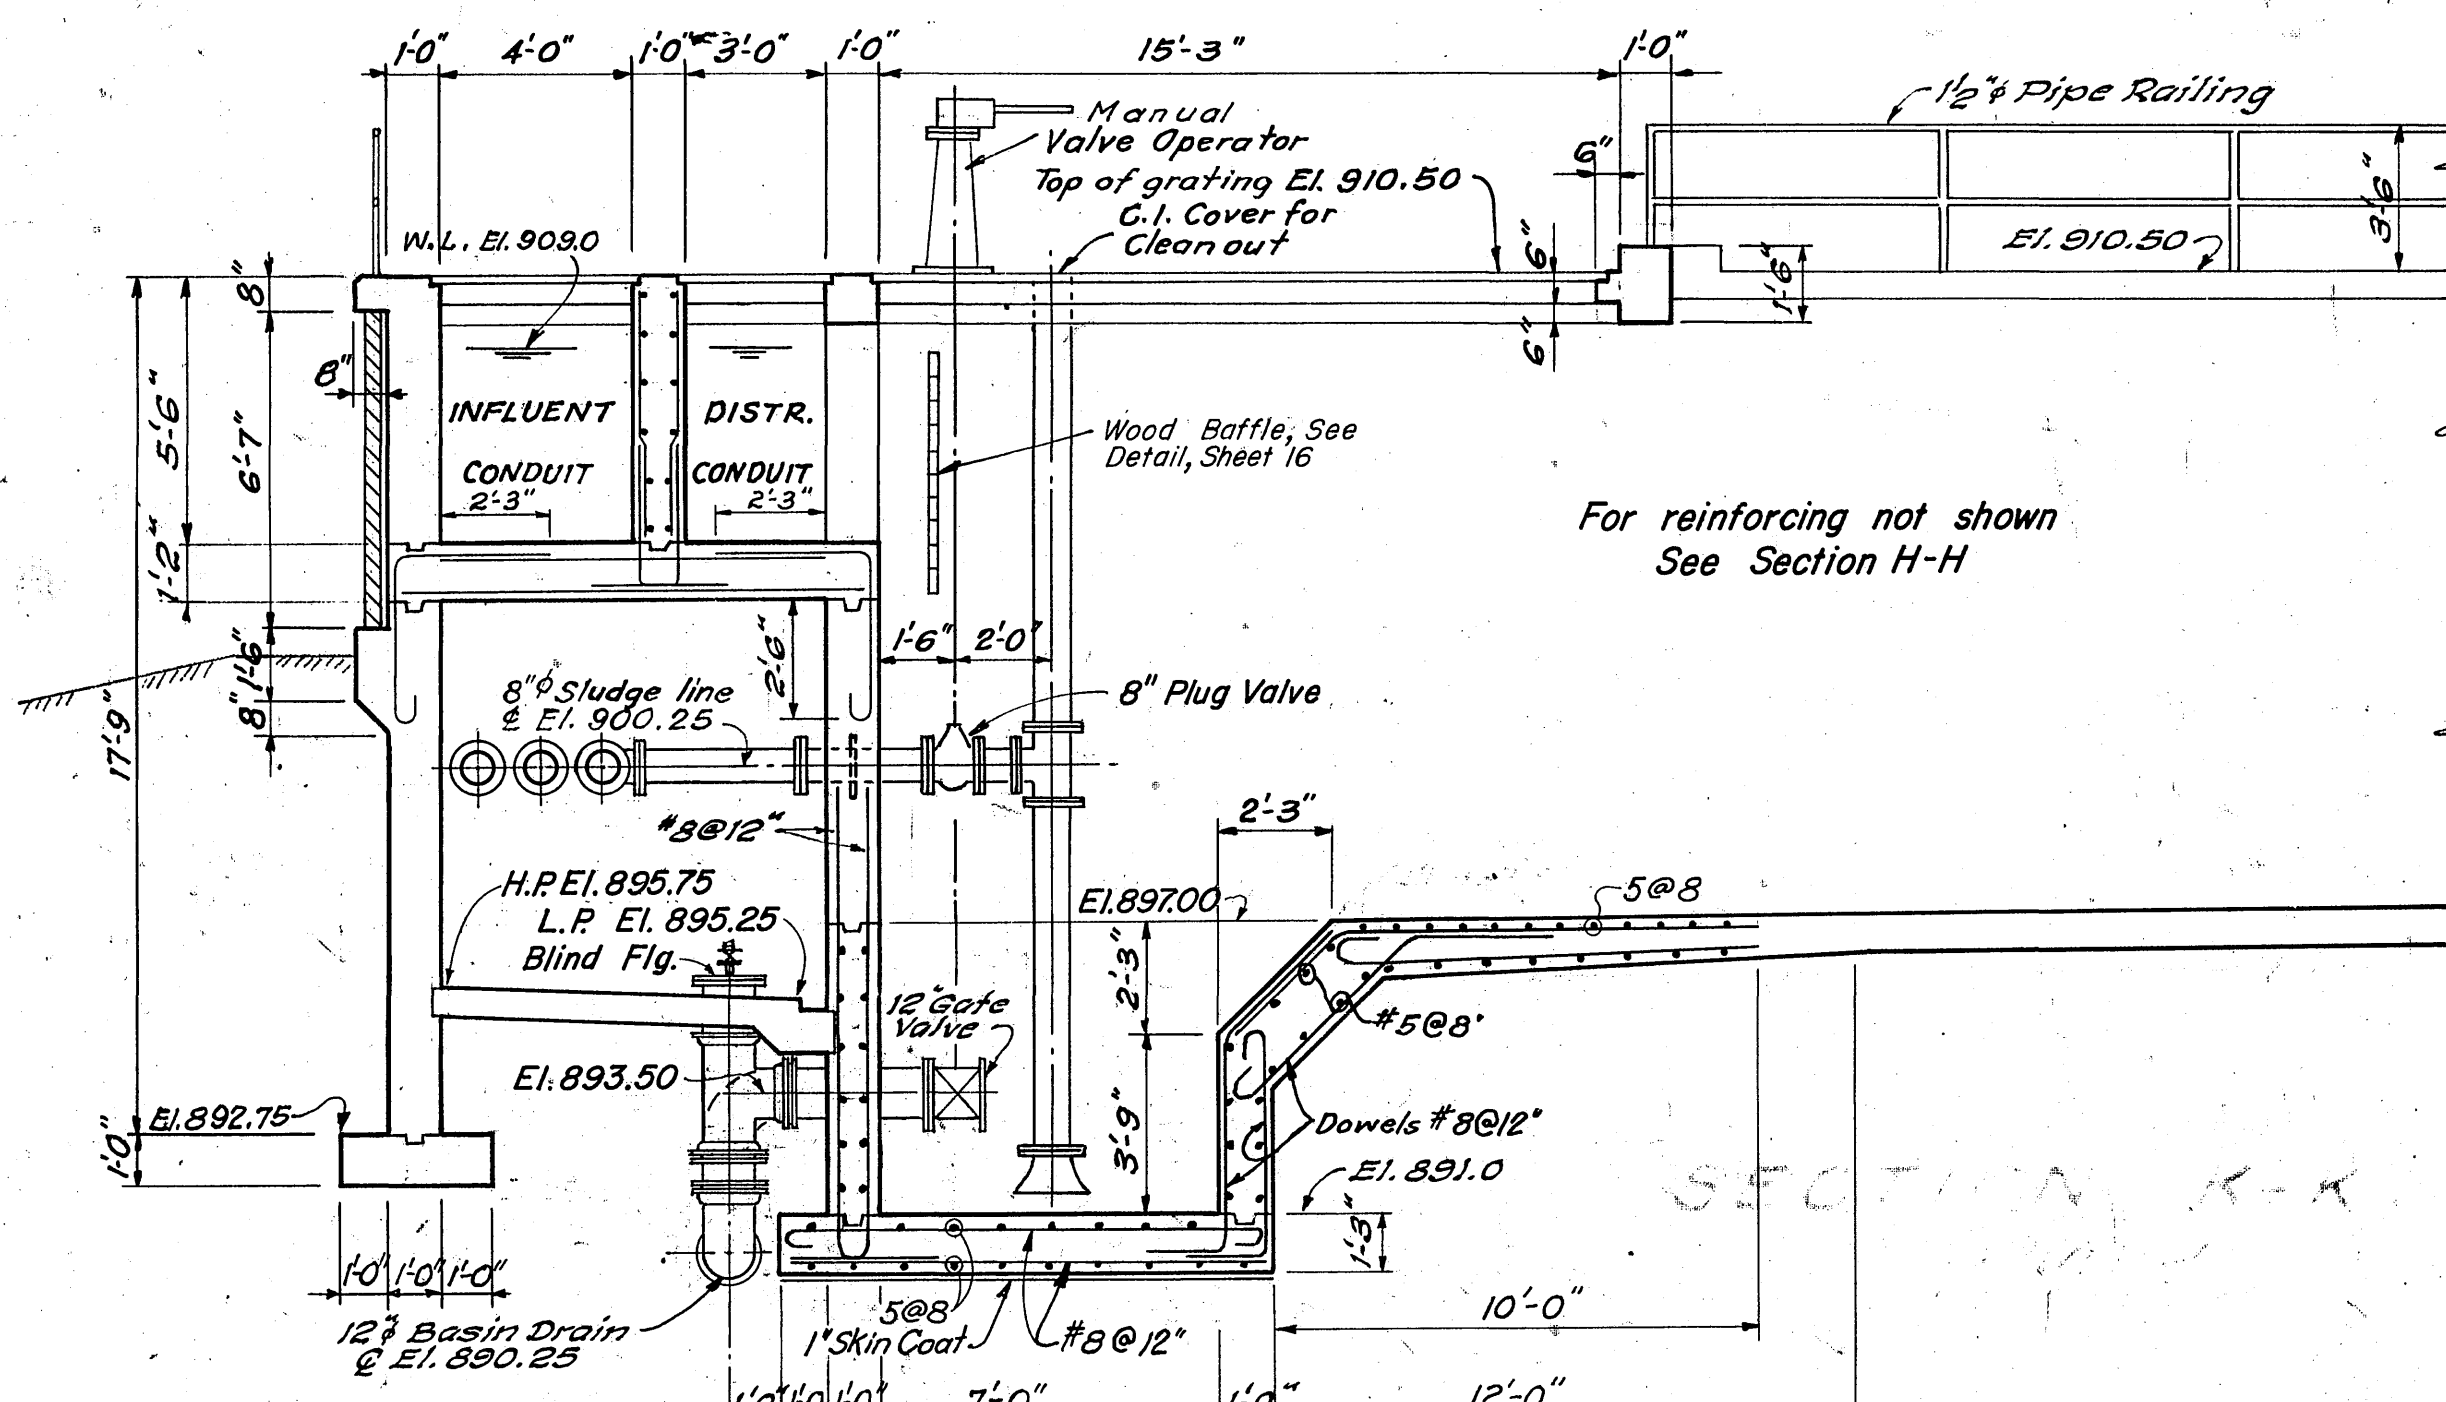

SECTION C-14
Scale: 4" = 1'-0"

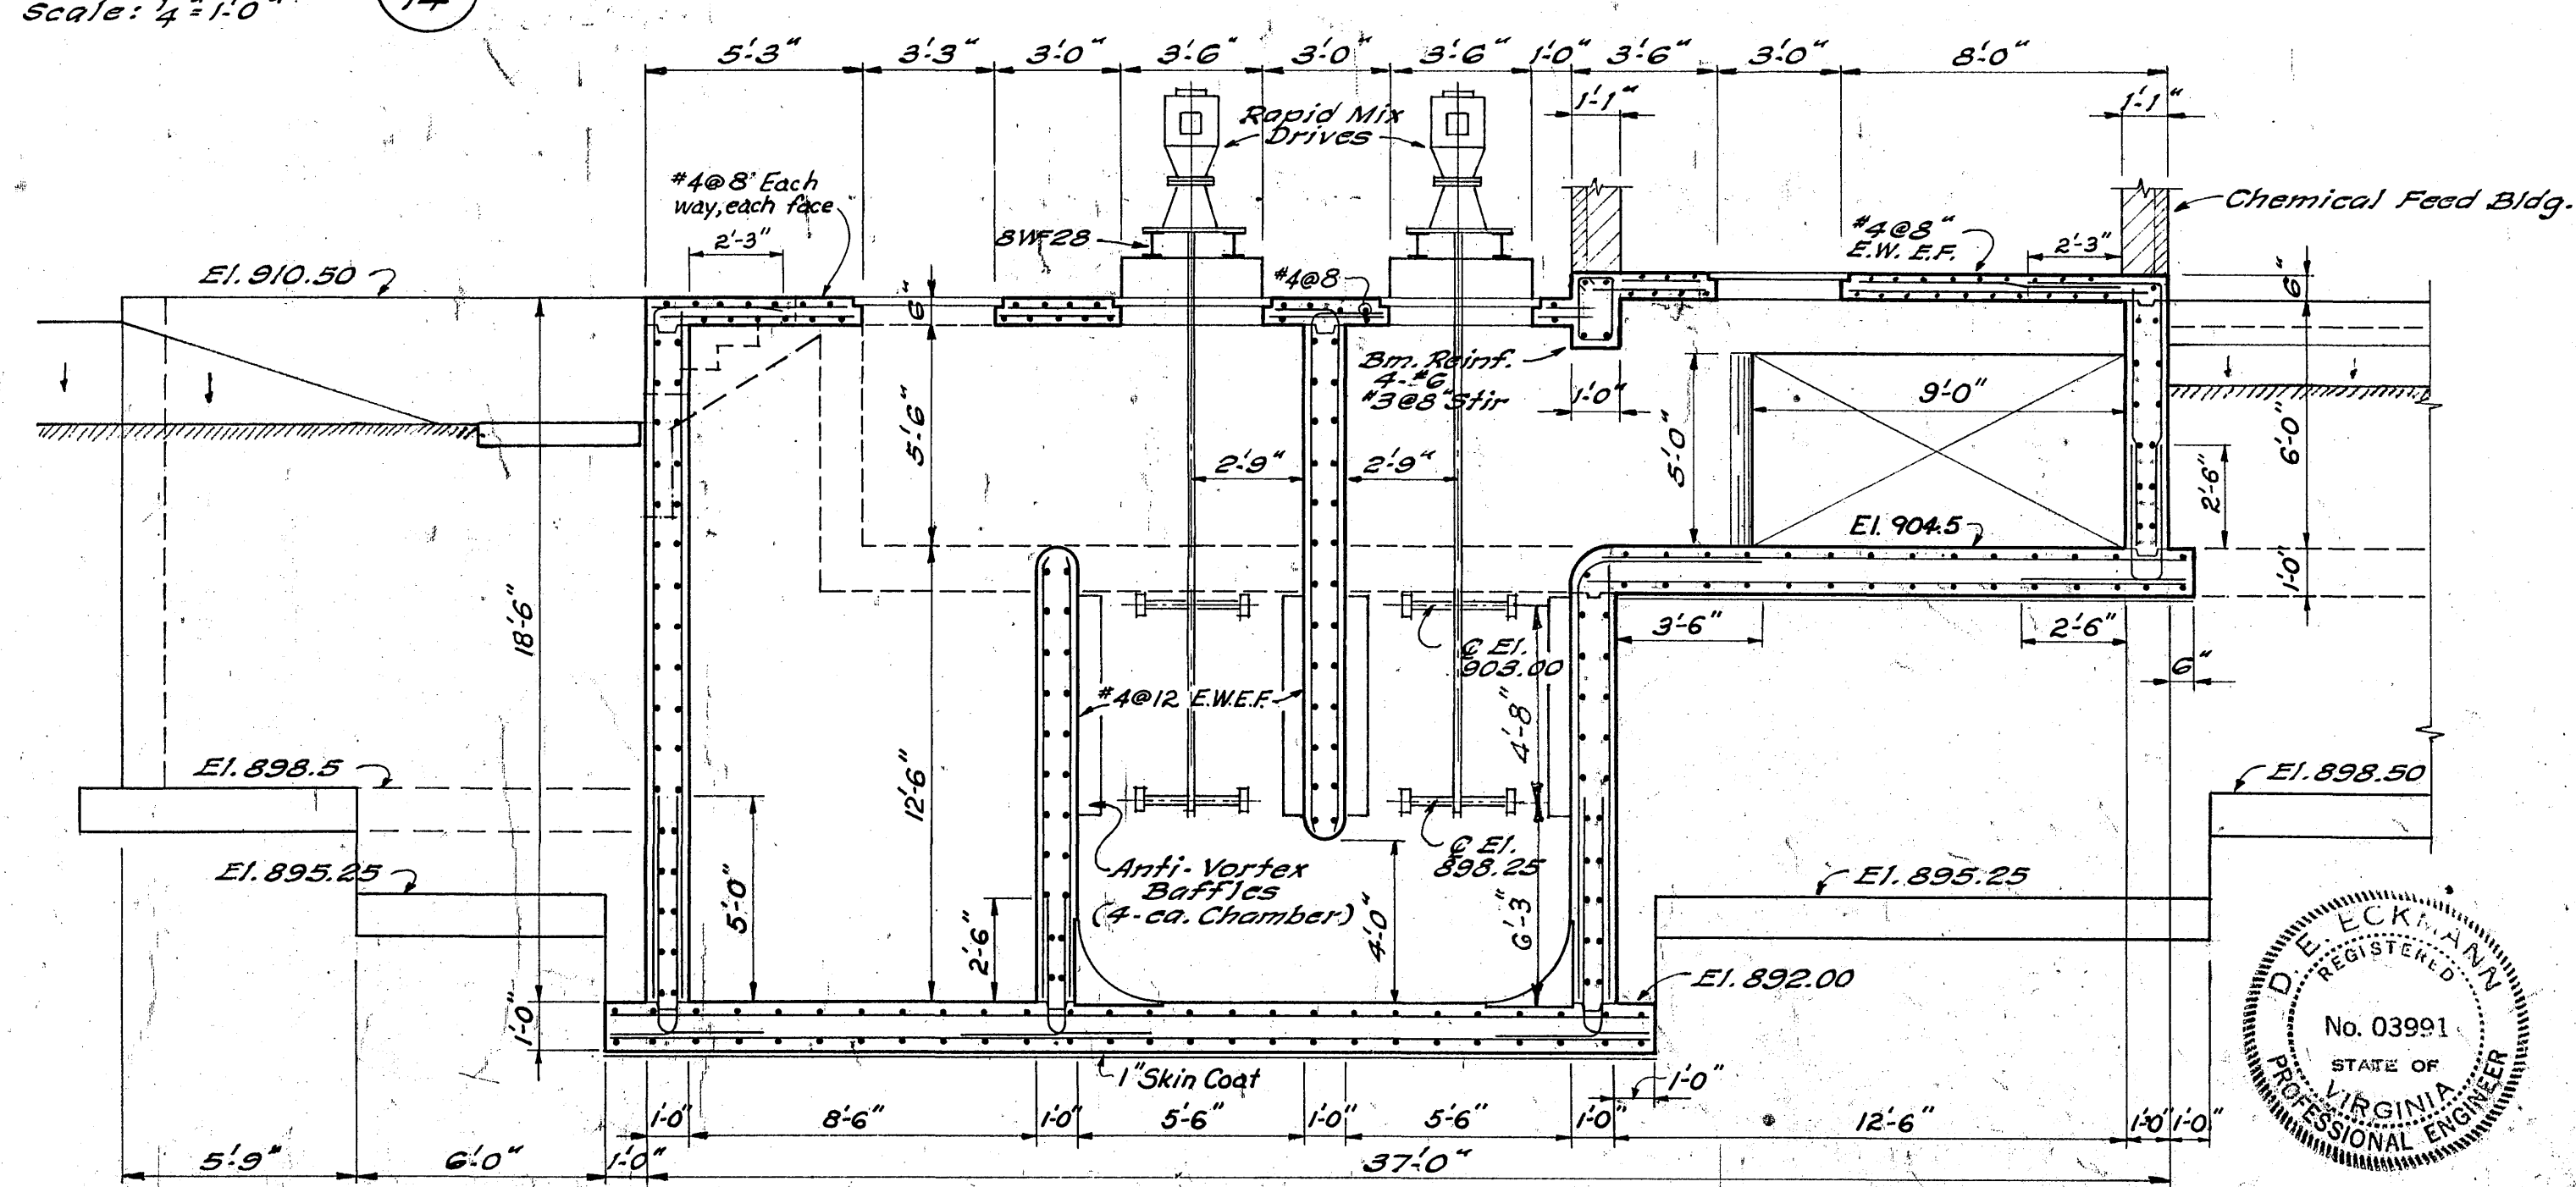

SECTION D-14
Scale: 4" = 1'-0"

AS BUILT
CONTR. "C"

ADDITIONS TO SEWAGE TREATMENT PLANT
ROANOKE, VIRGINIA
PRIMARY SETTLING BASINS
SECTIONS

ALVORD, BURDICK & HOWSON
ENGINEERS CHICAGO

1973