
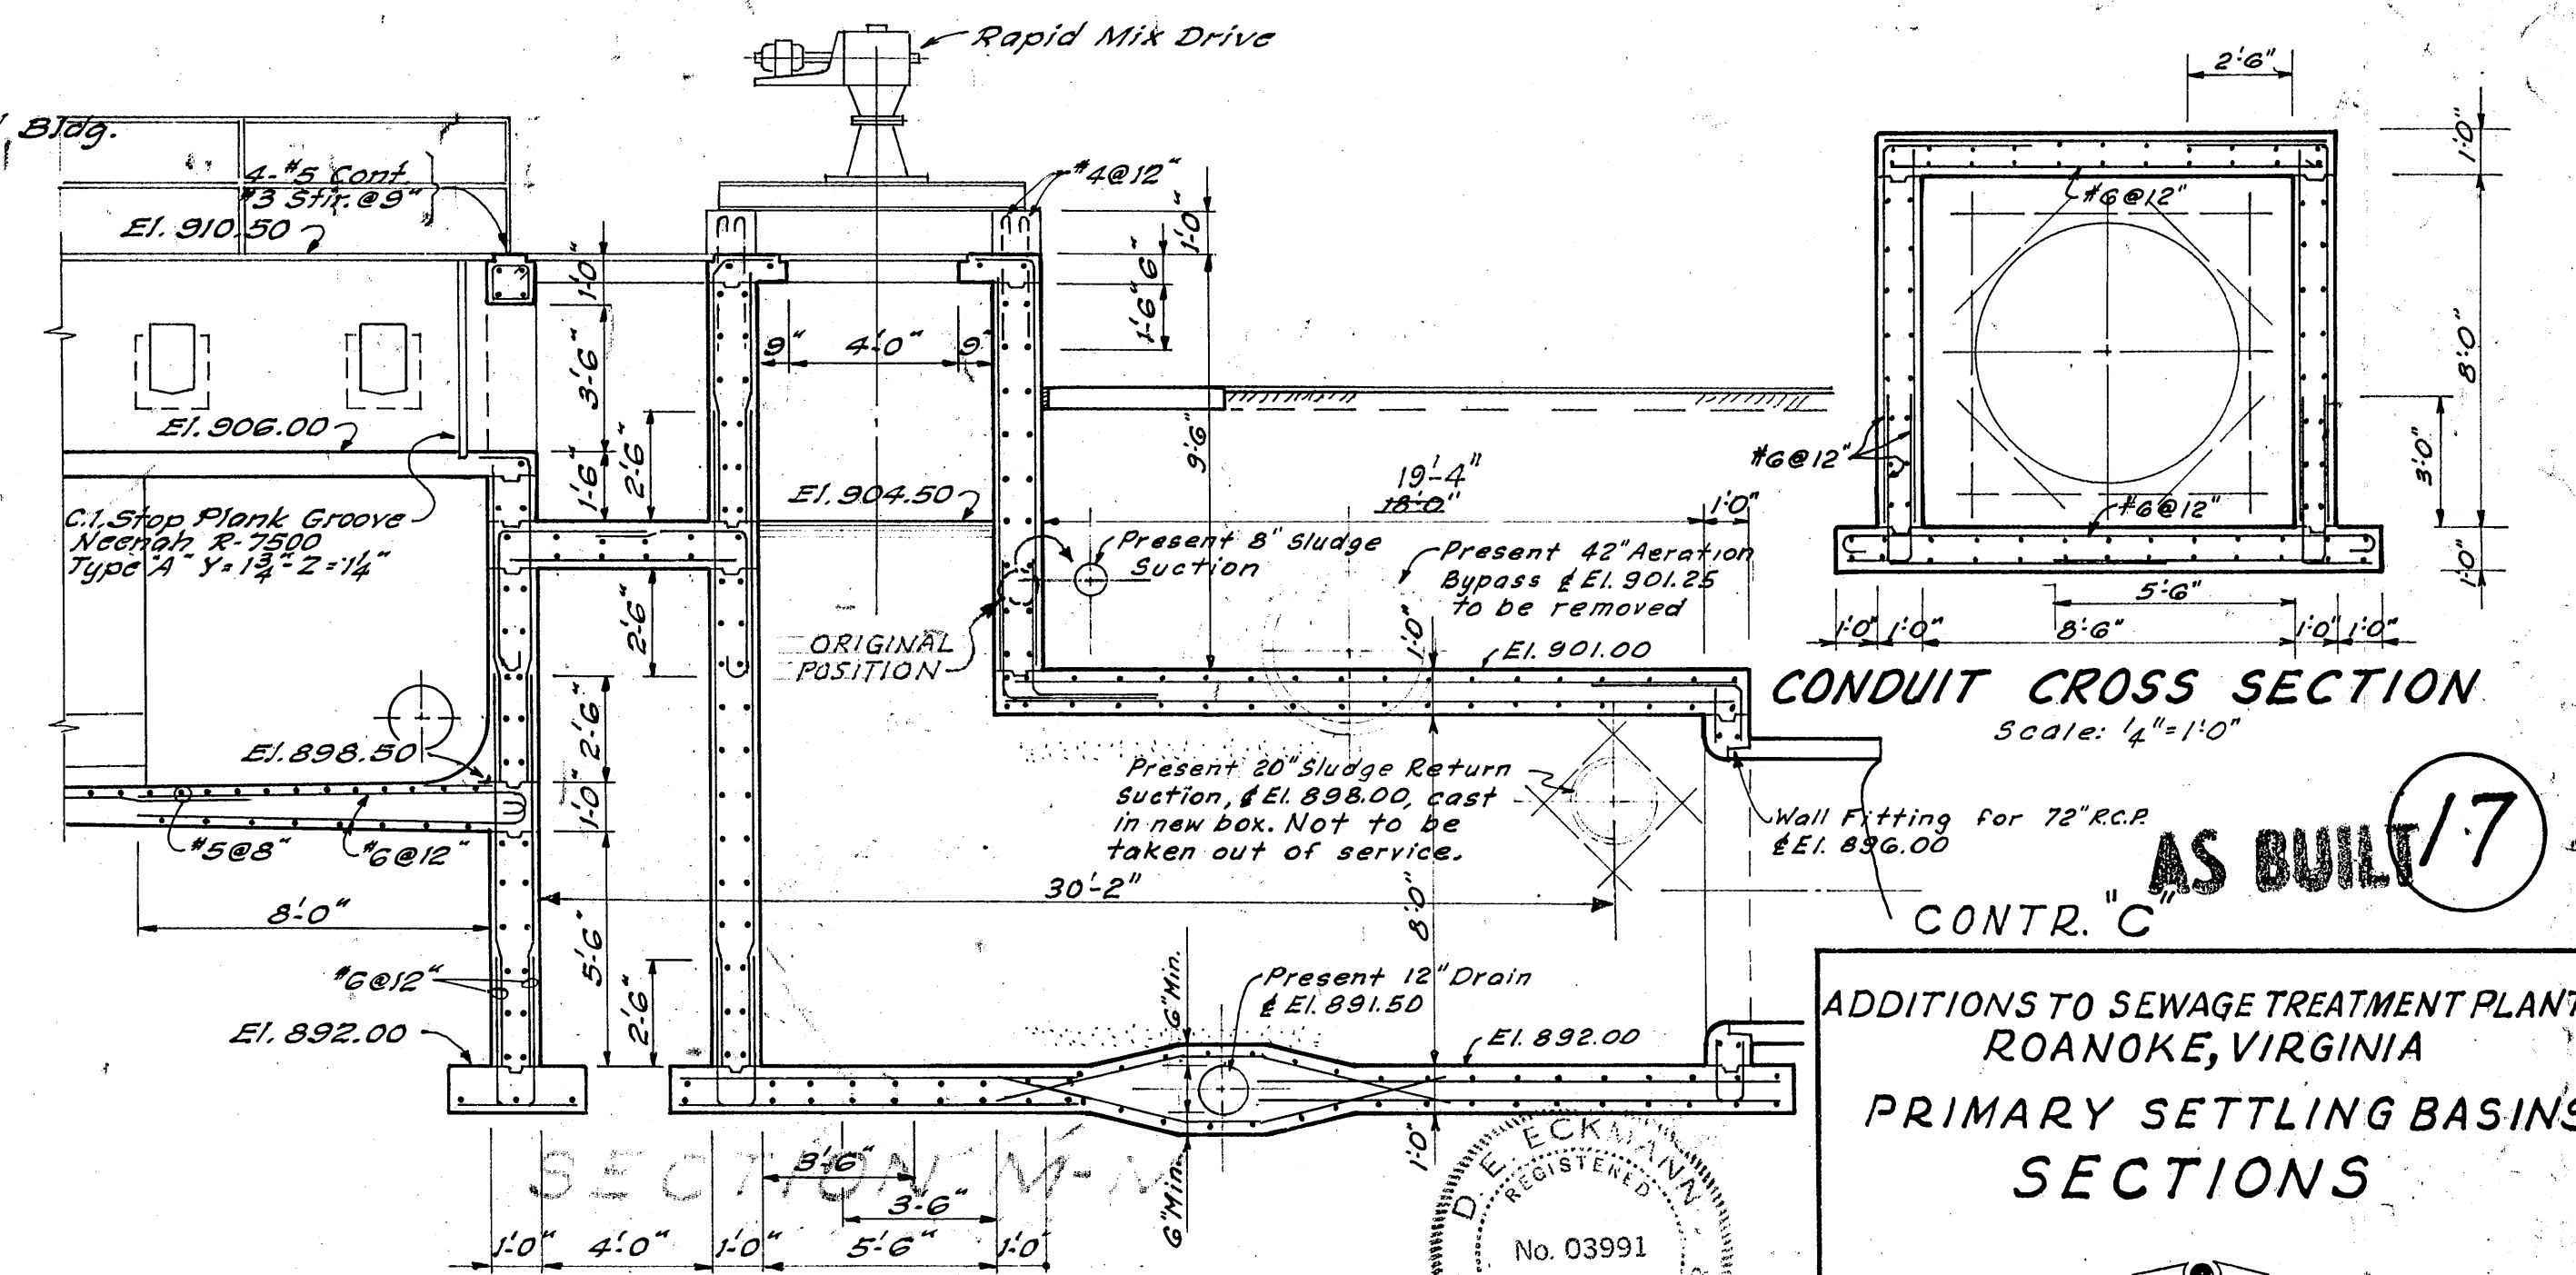
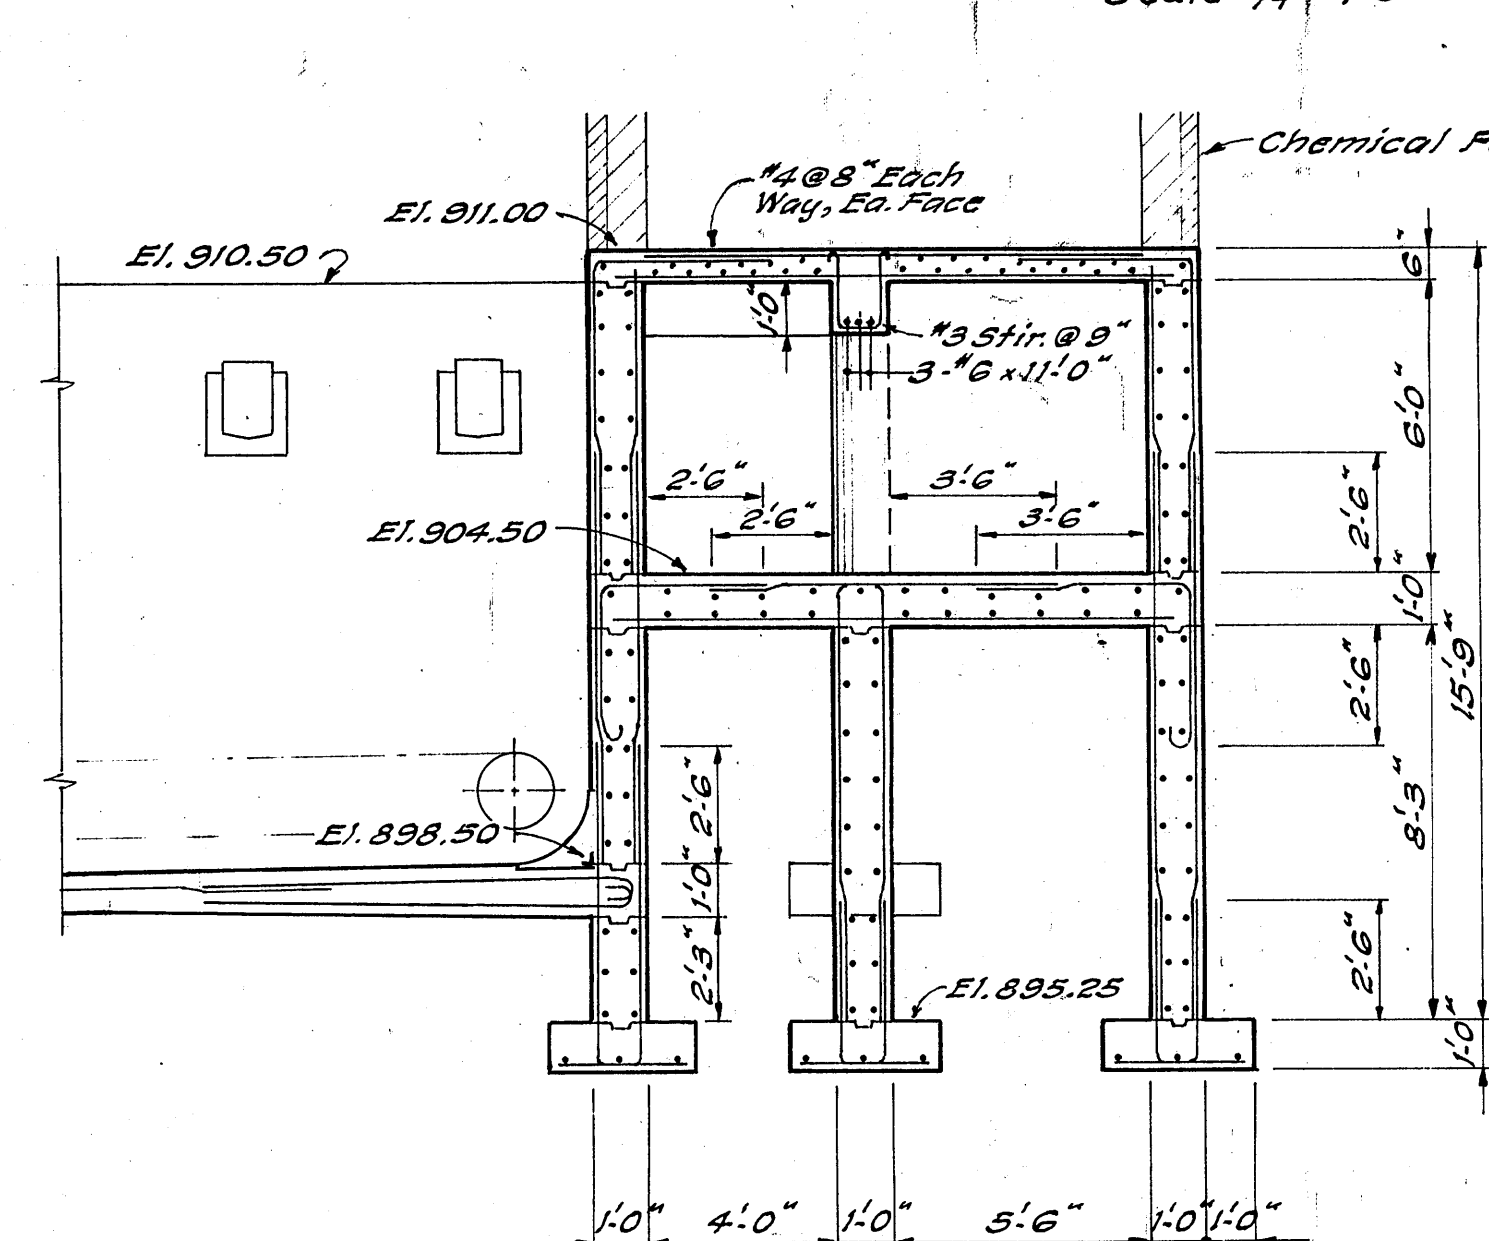
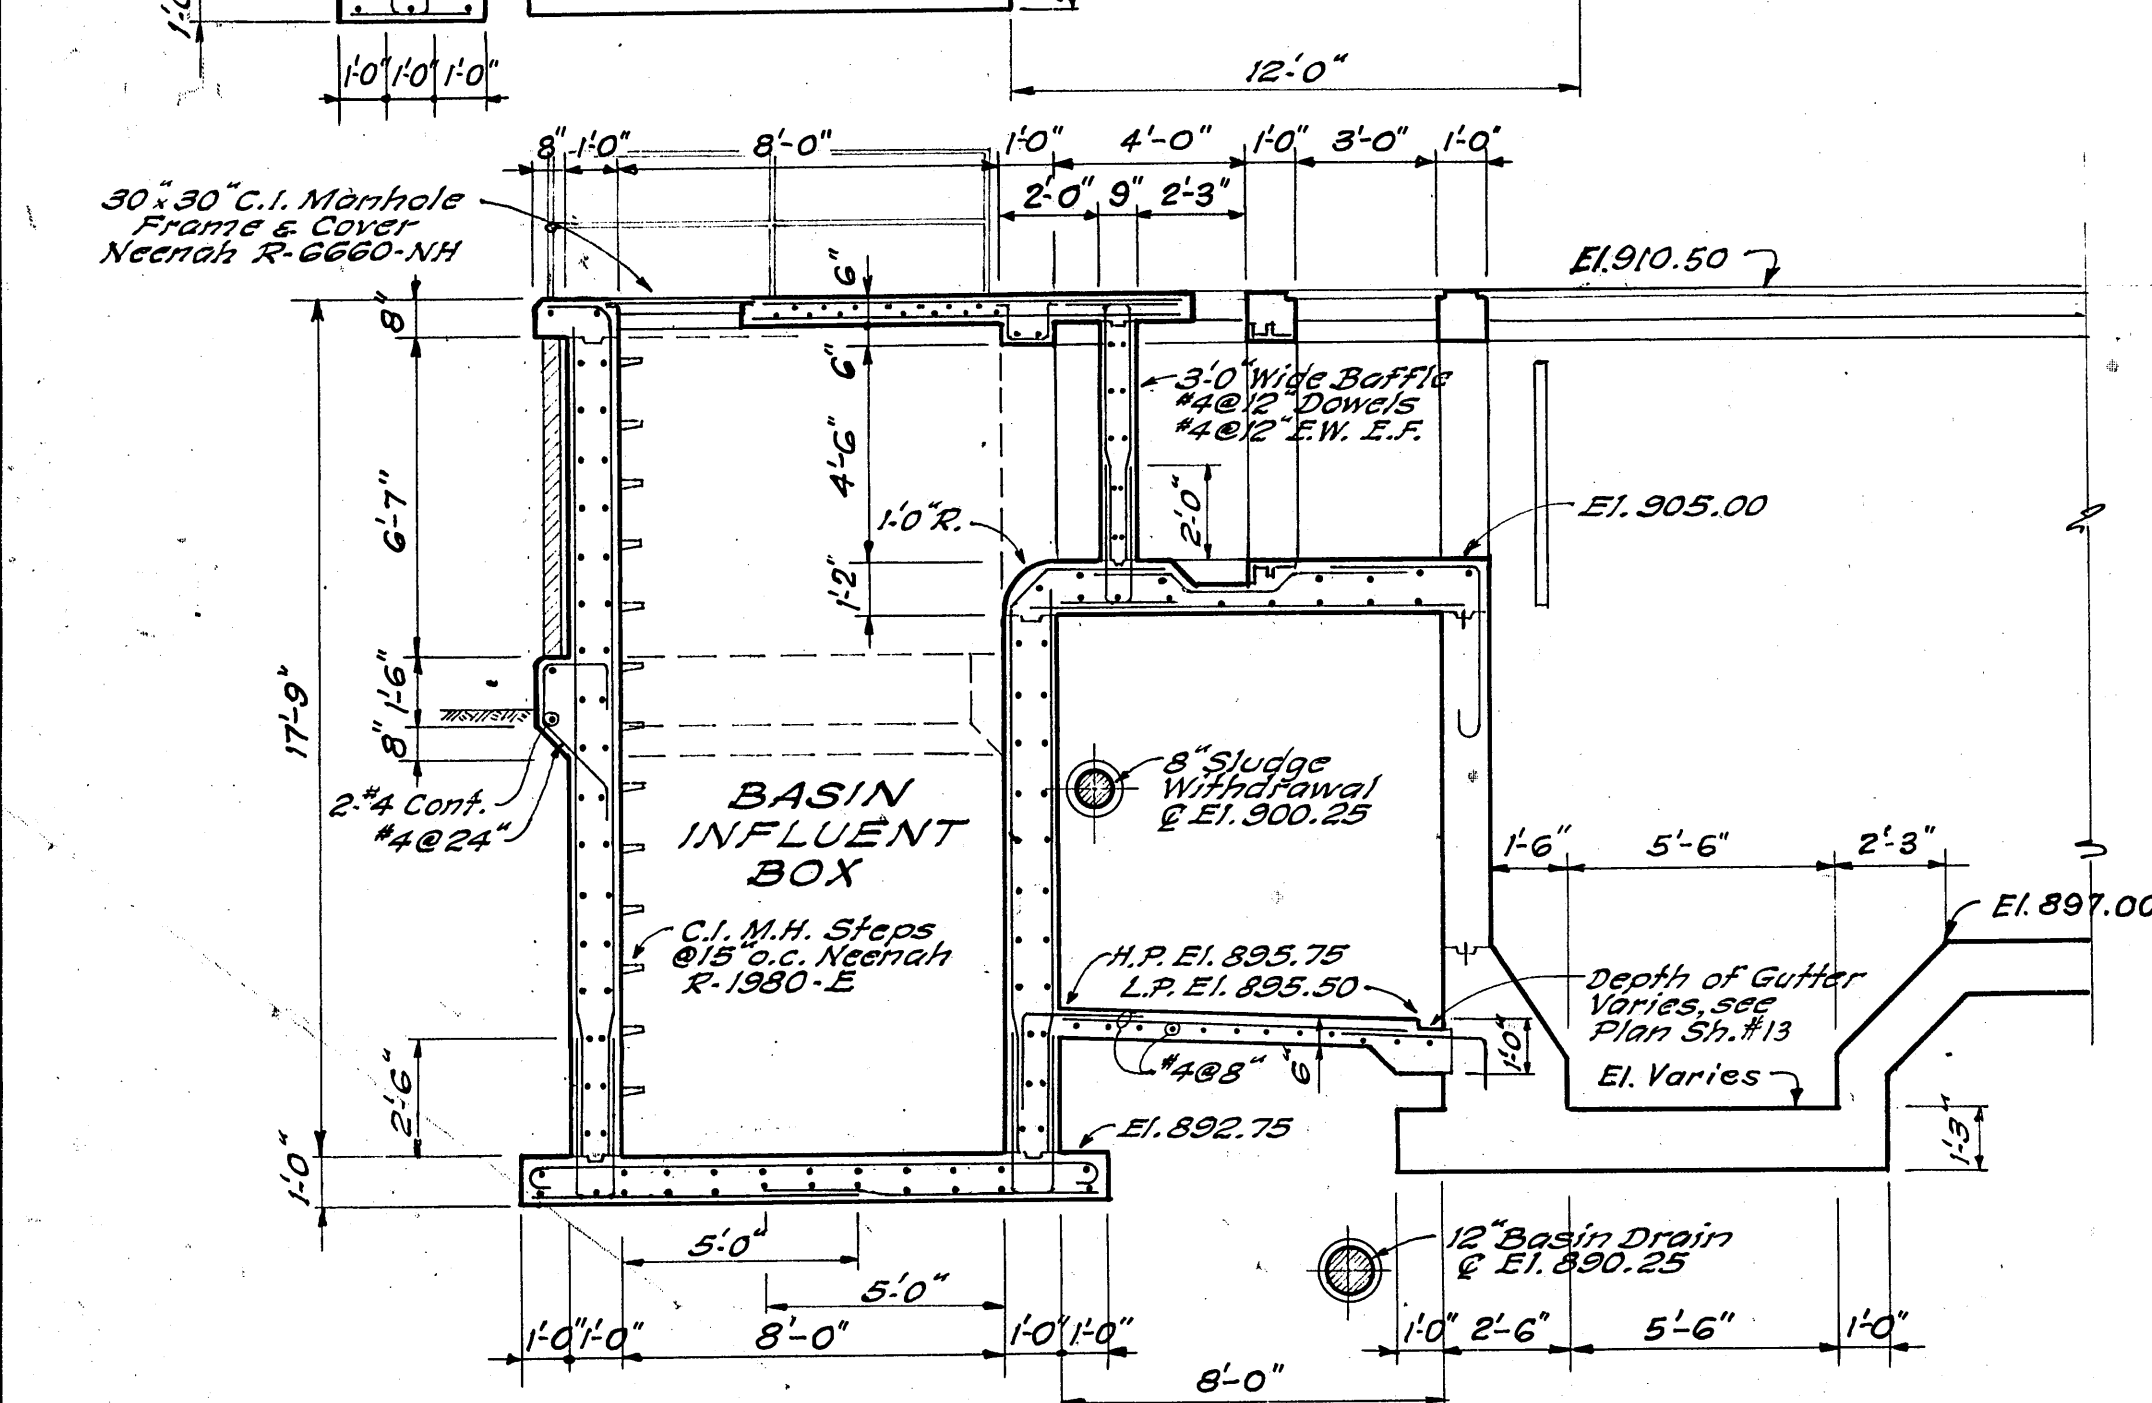
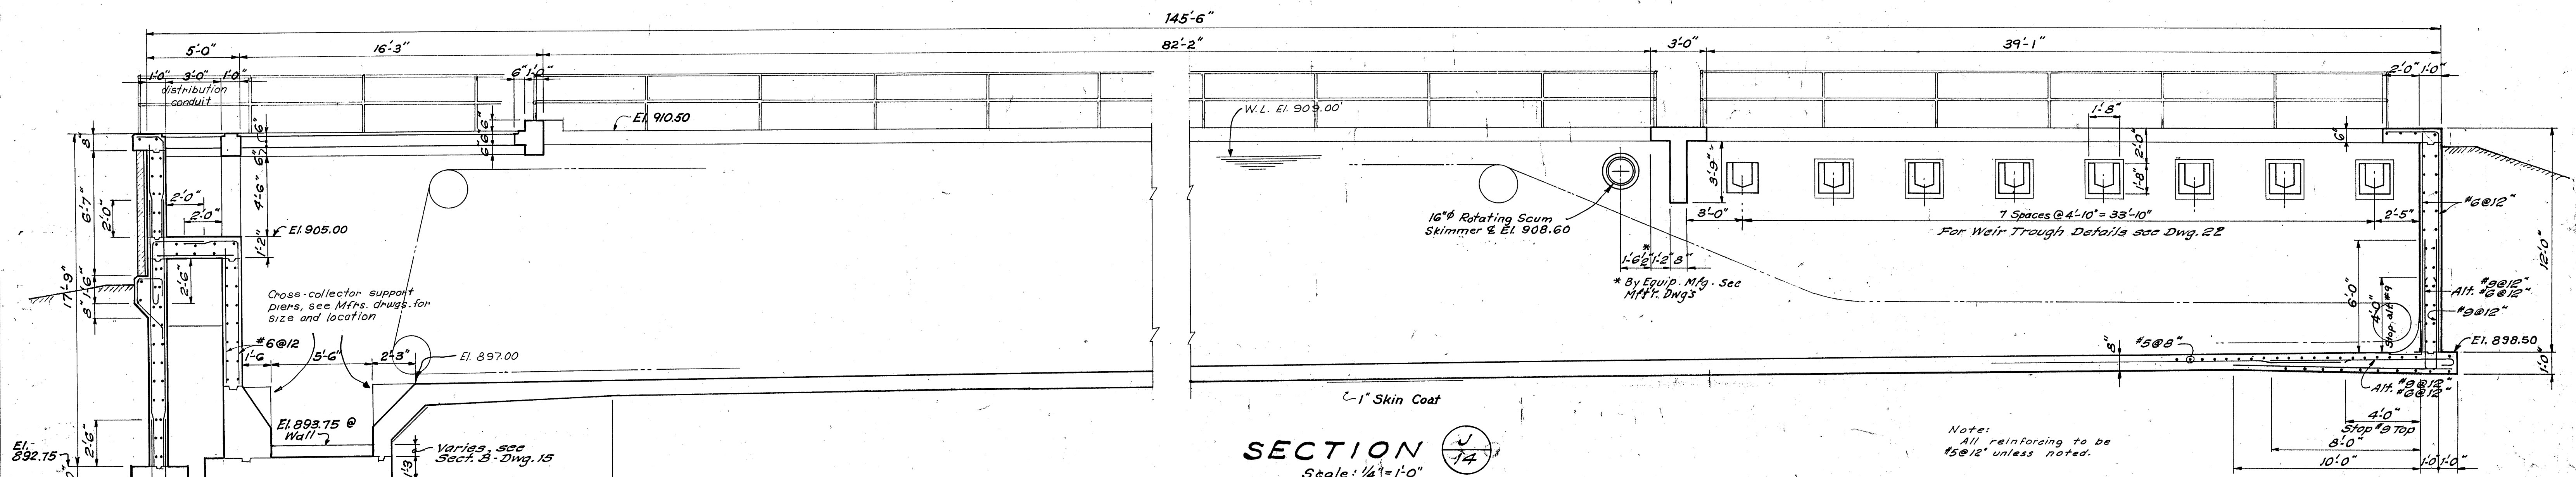


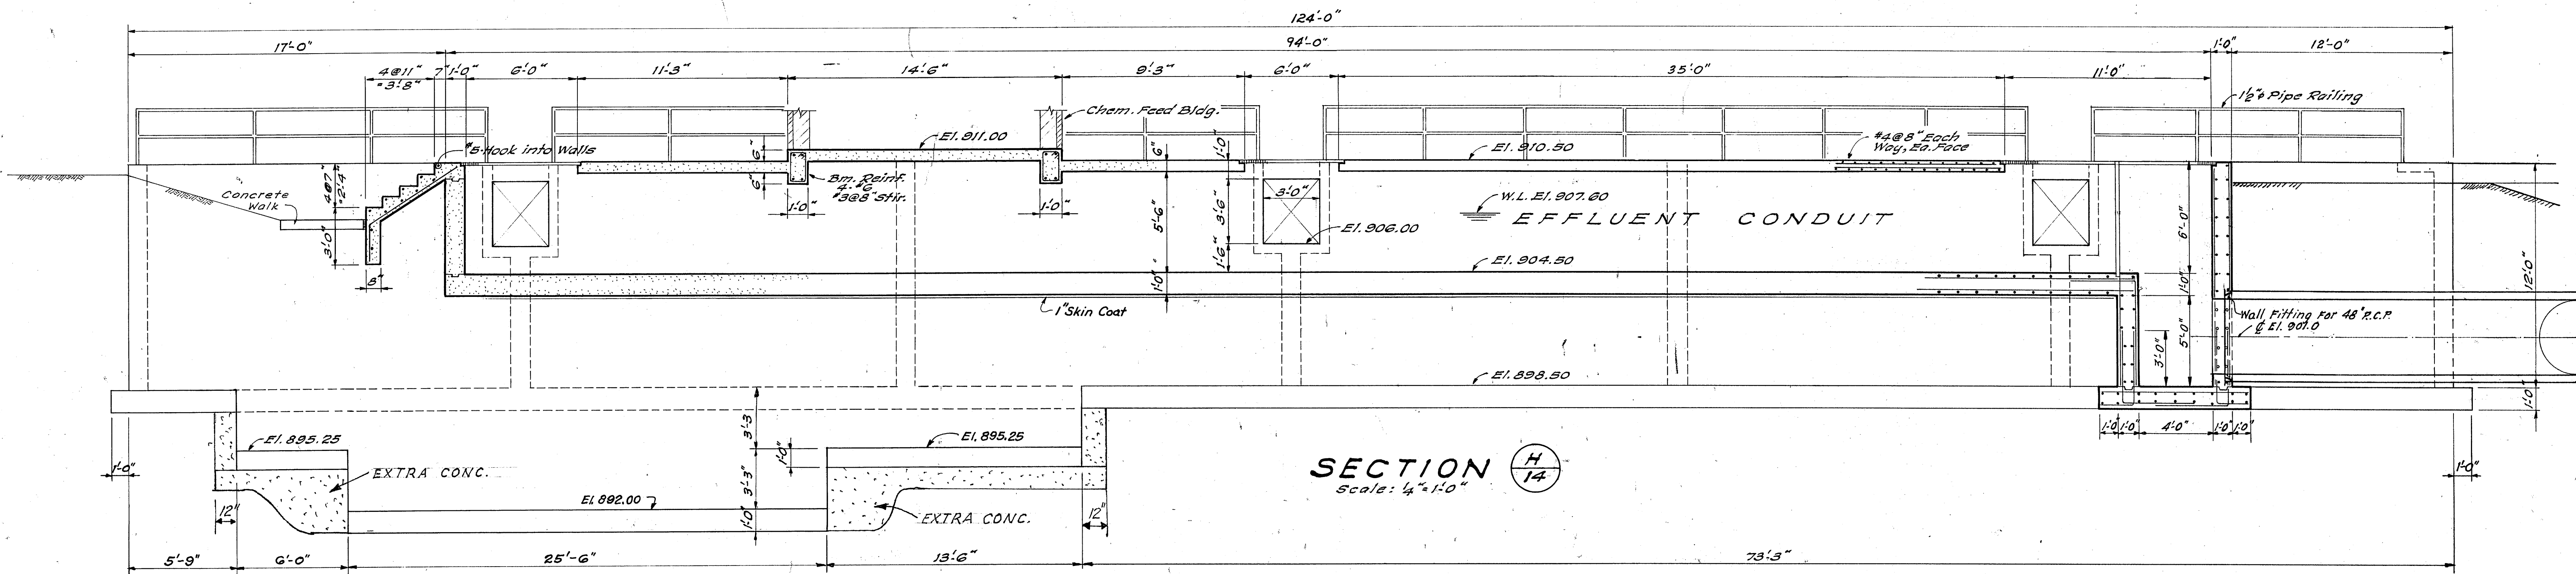

CONDUIT CROSS SECTION
Scale: 1/4" = 1'-0"

AS BUILT 17
CONTR. C

ADDITIONS TO SEWAGE TREATMENT PLANT
ROANOKE, VIRGINIA
PRIMARY SETTLING BASINS
SECTIONS

ALVORD, BURDICK & HOWSON
ENGINEERS CHICAGO

1973