


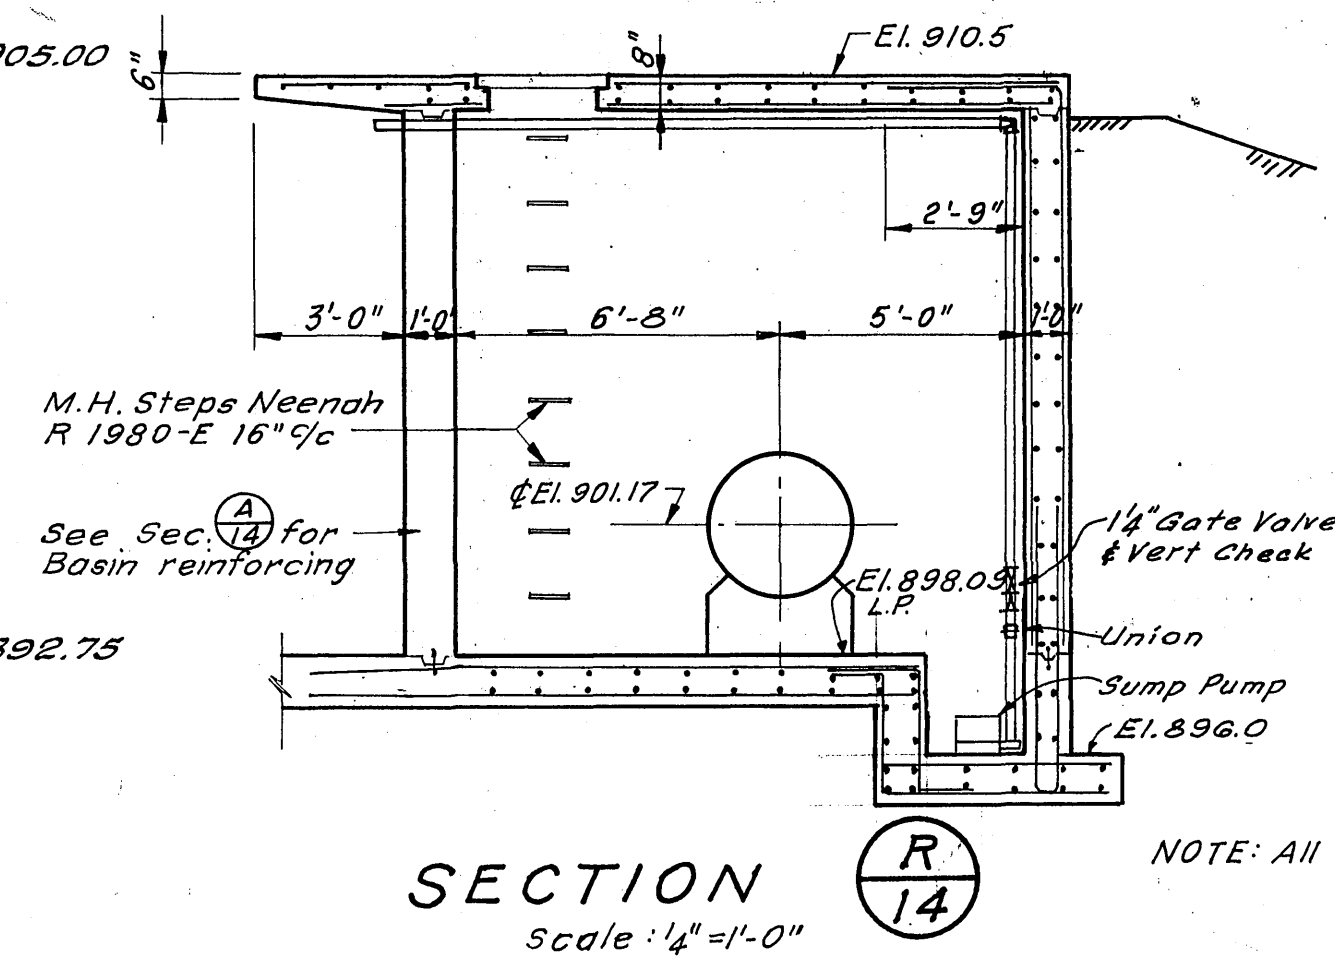
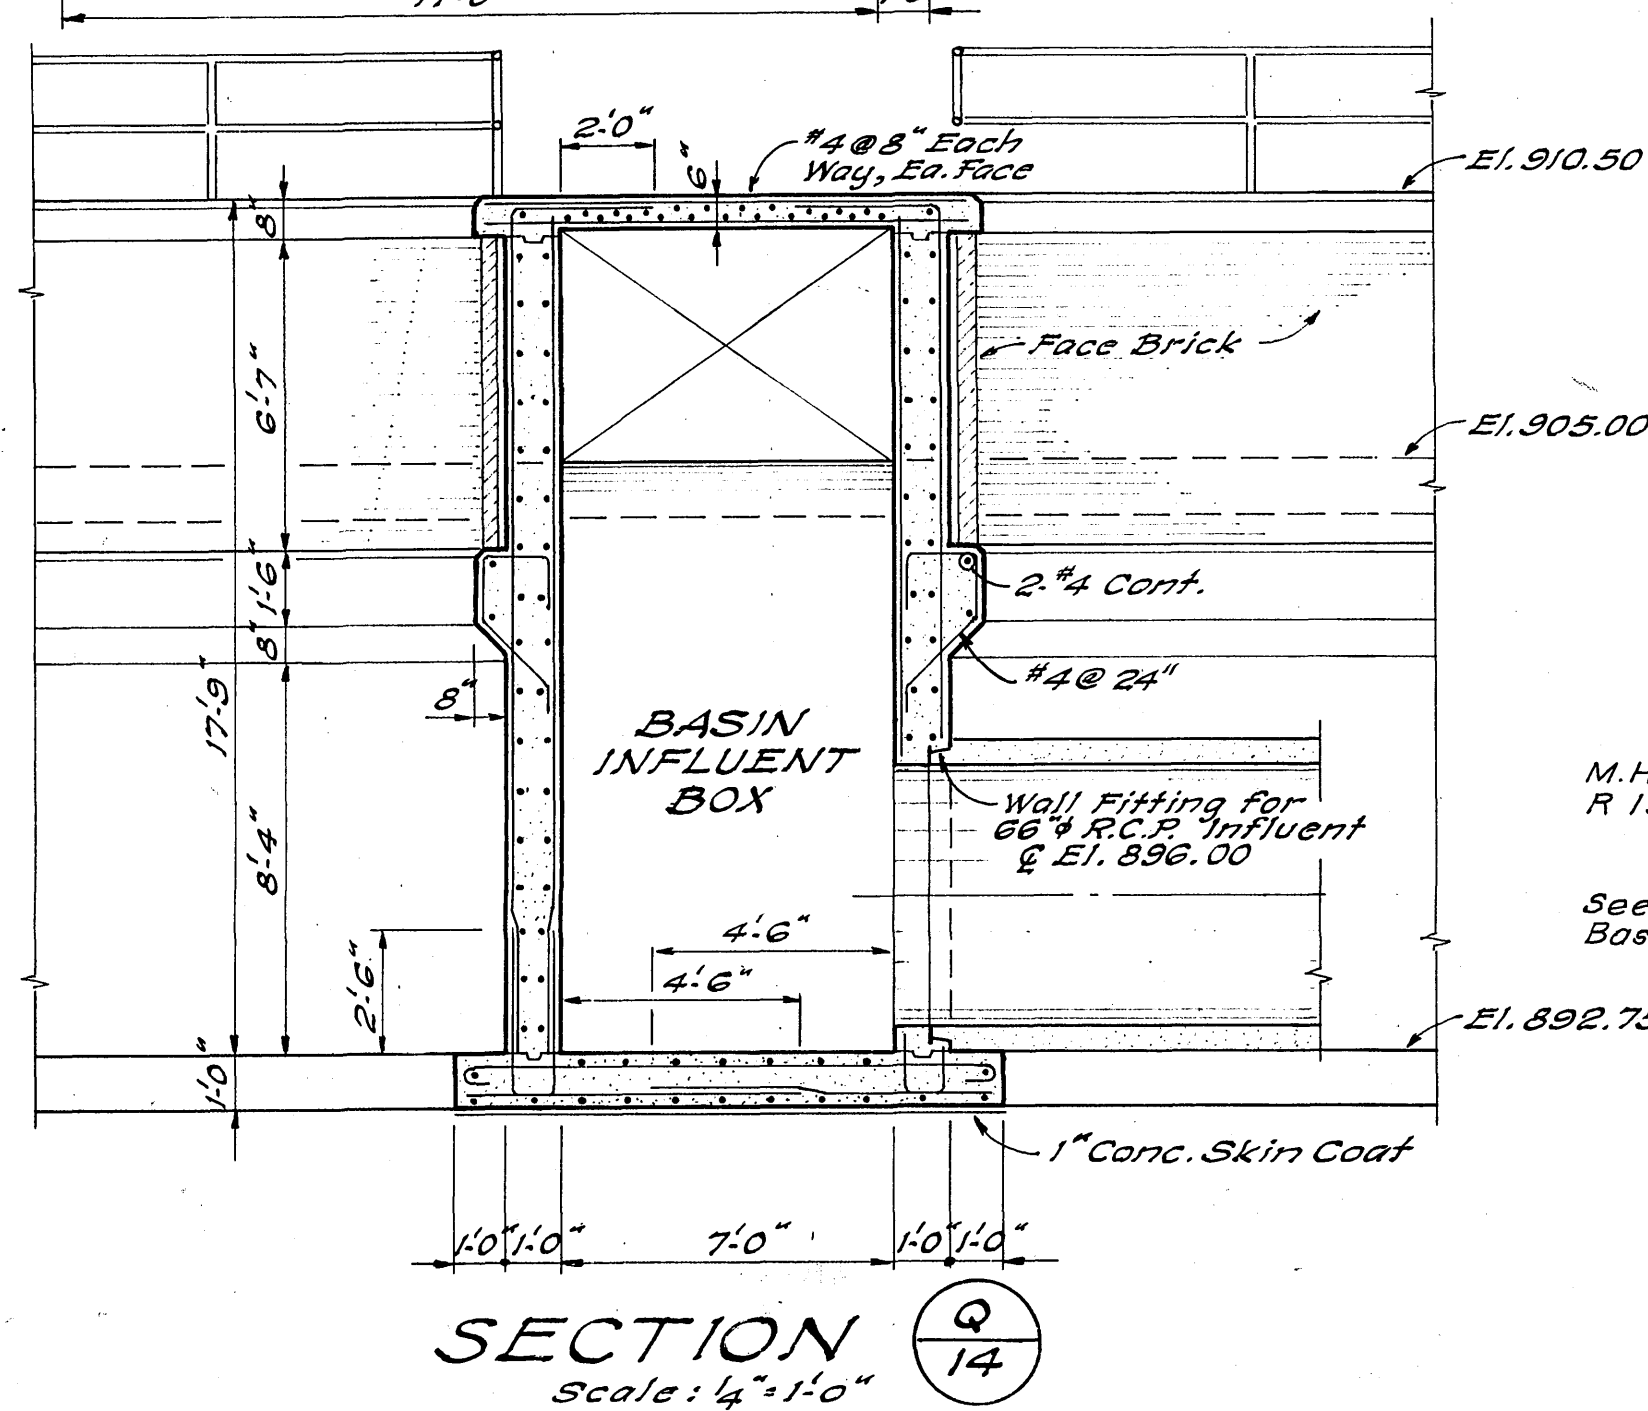
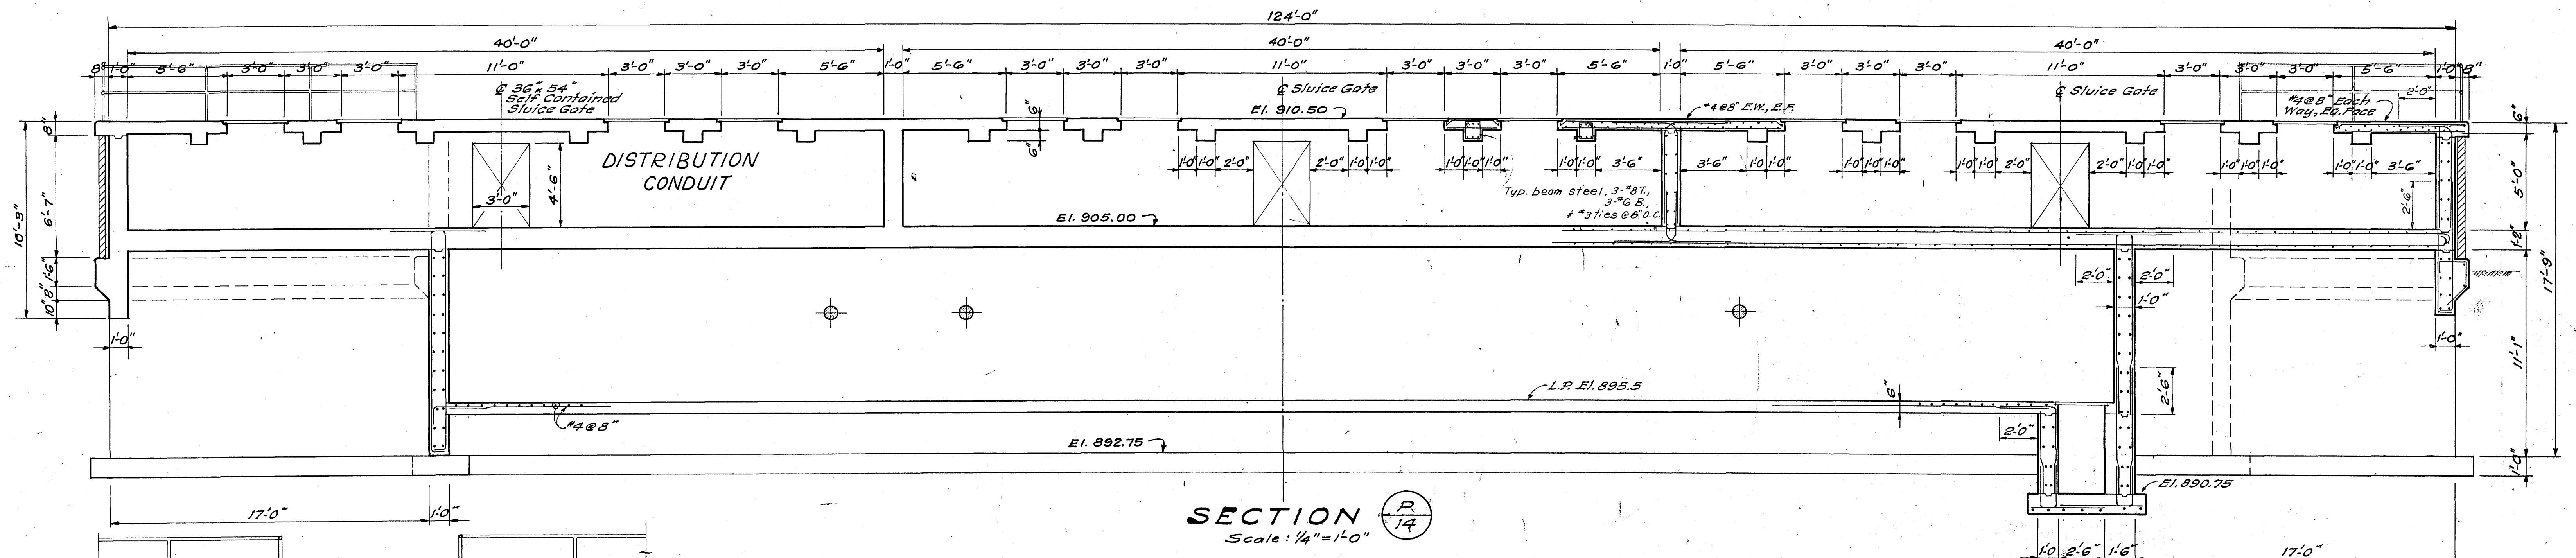
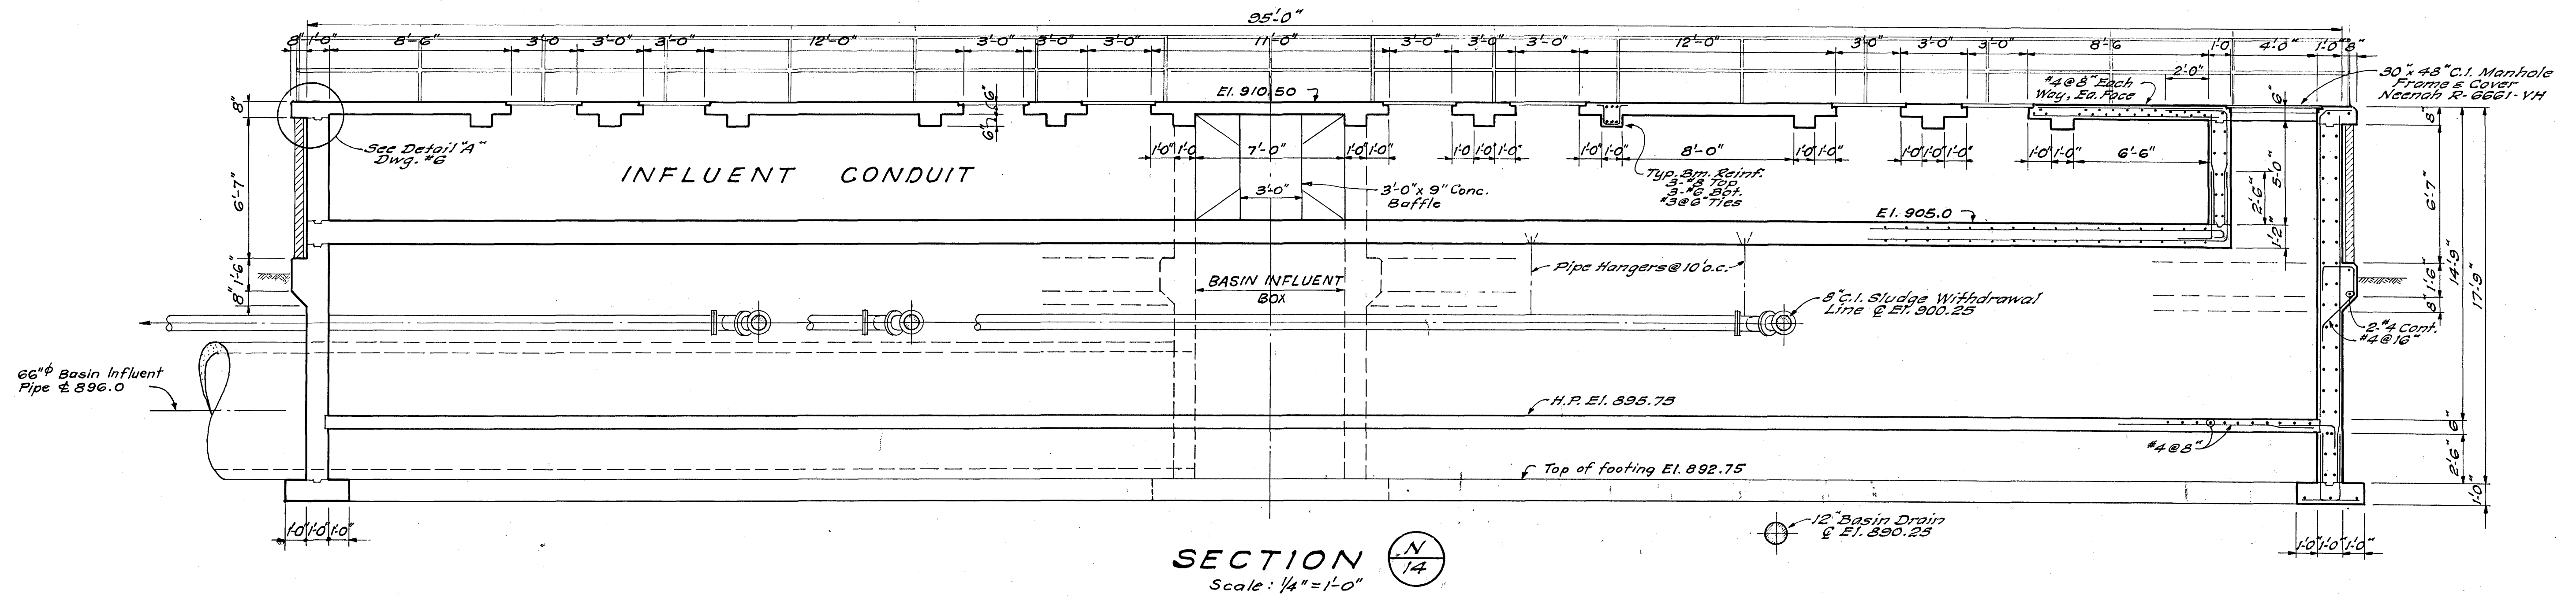


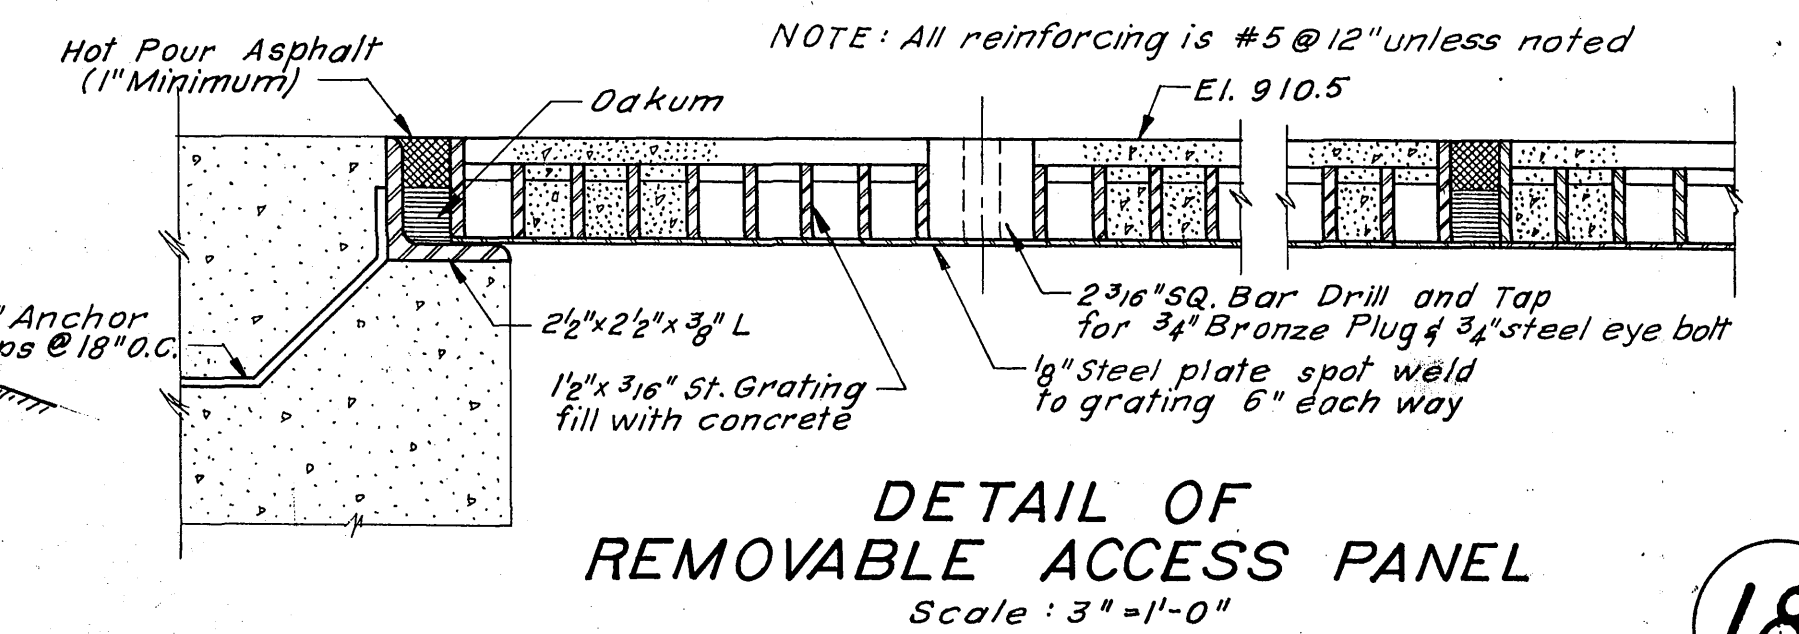

NOTE: All reinforcing #5@12" unless noted

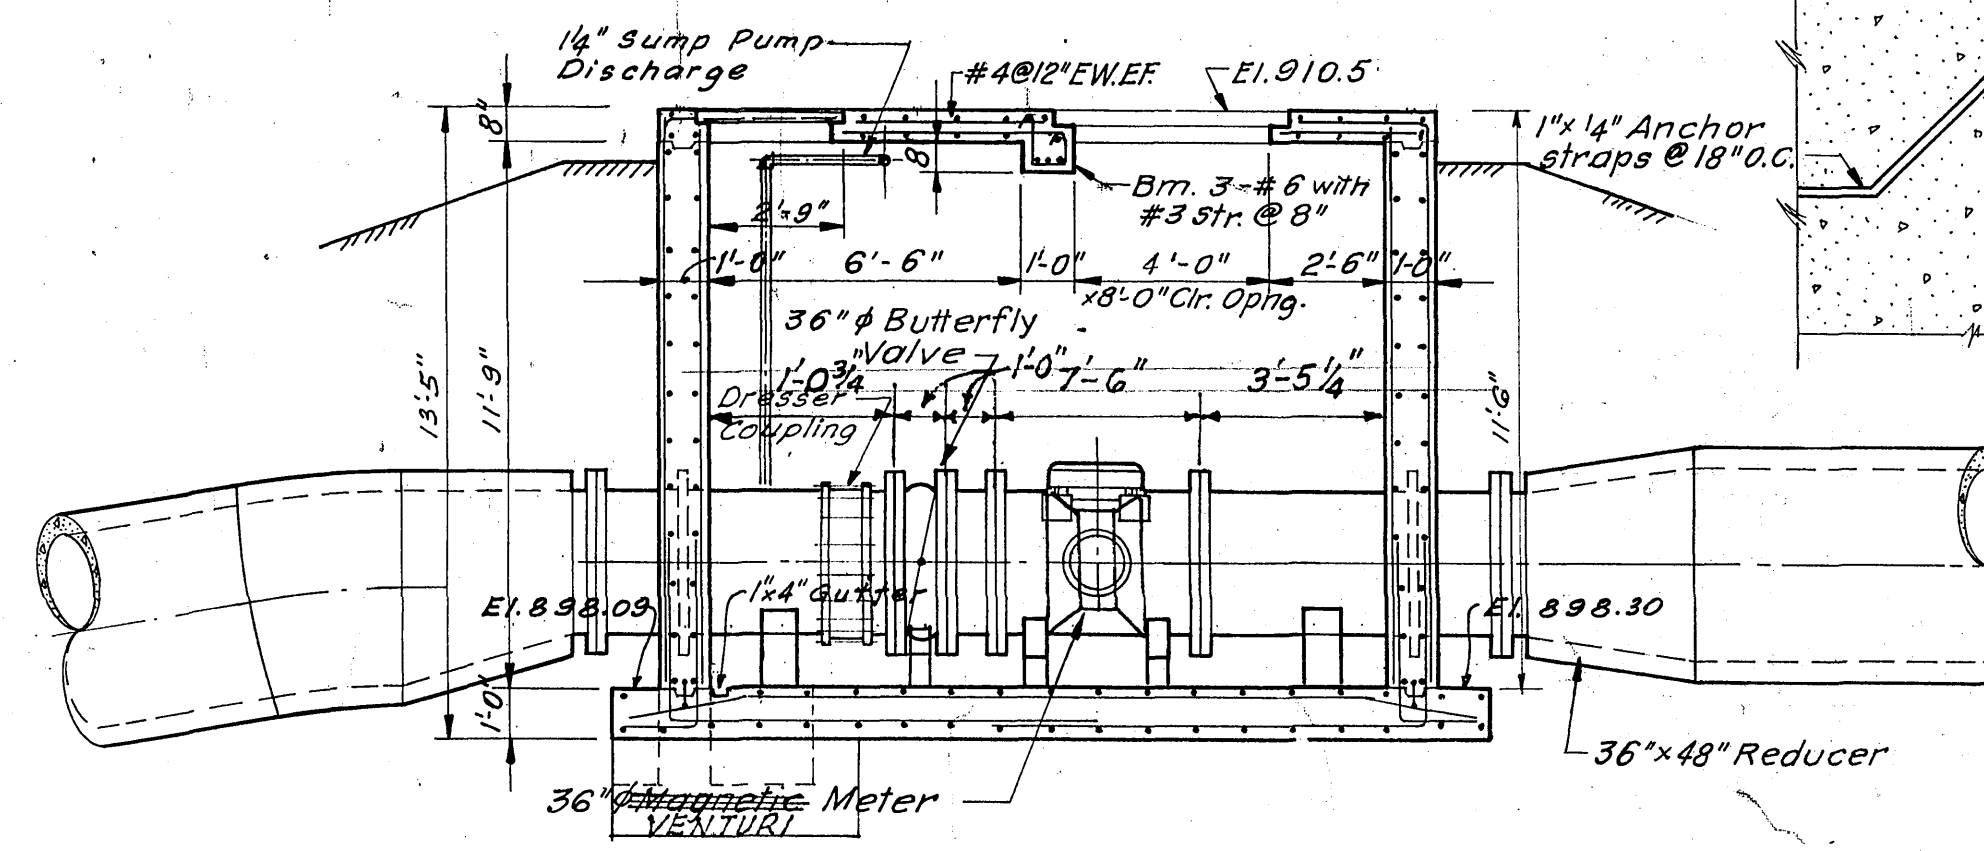

AS BUILT

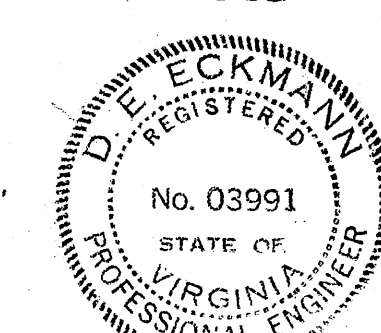

CONTR. "C"
ADDITIONS TO SEWAGE TREATMENT PLANT
ROANOKE, VIRGINIA
PRIMARY SETTLING BASINS
SECTIONS

ALVORD, BURDICK & HOWSON
ENGINEERS CHICAGO

1973