
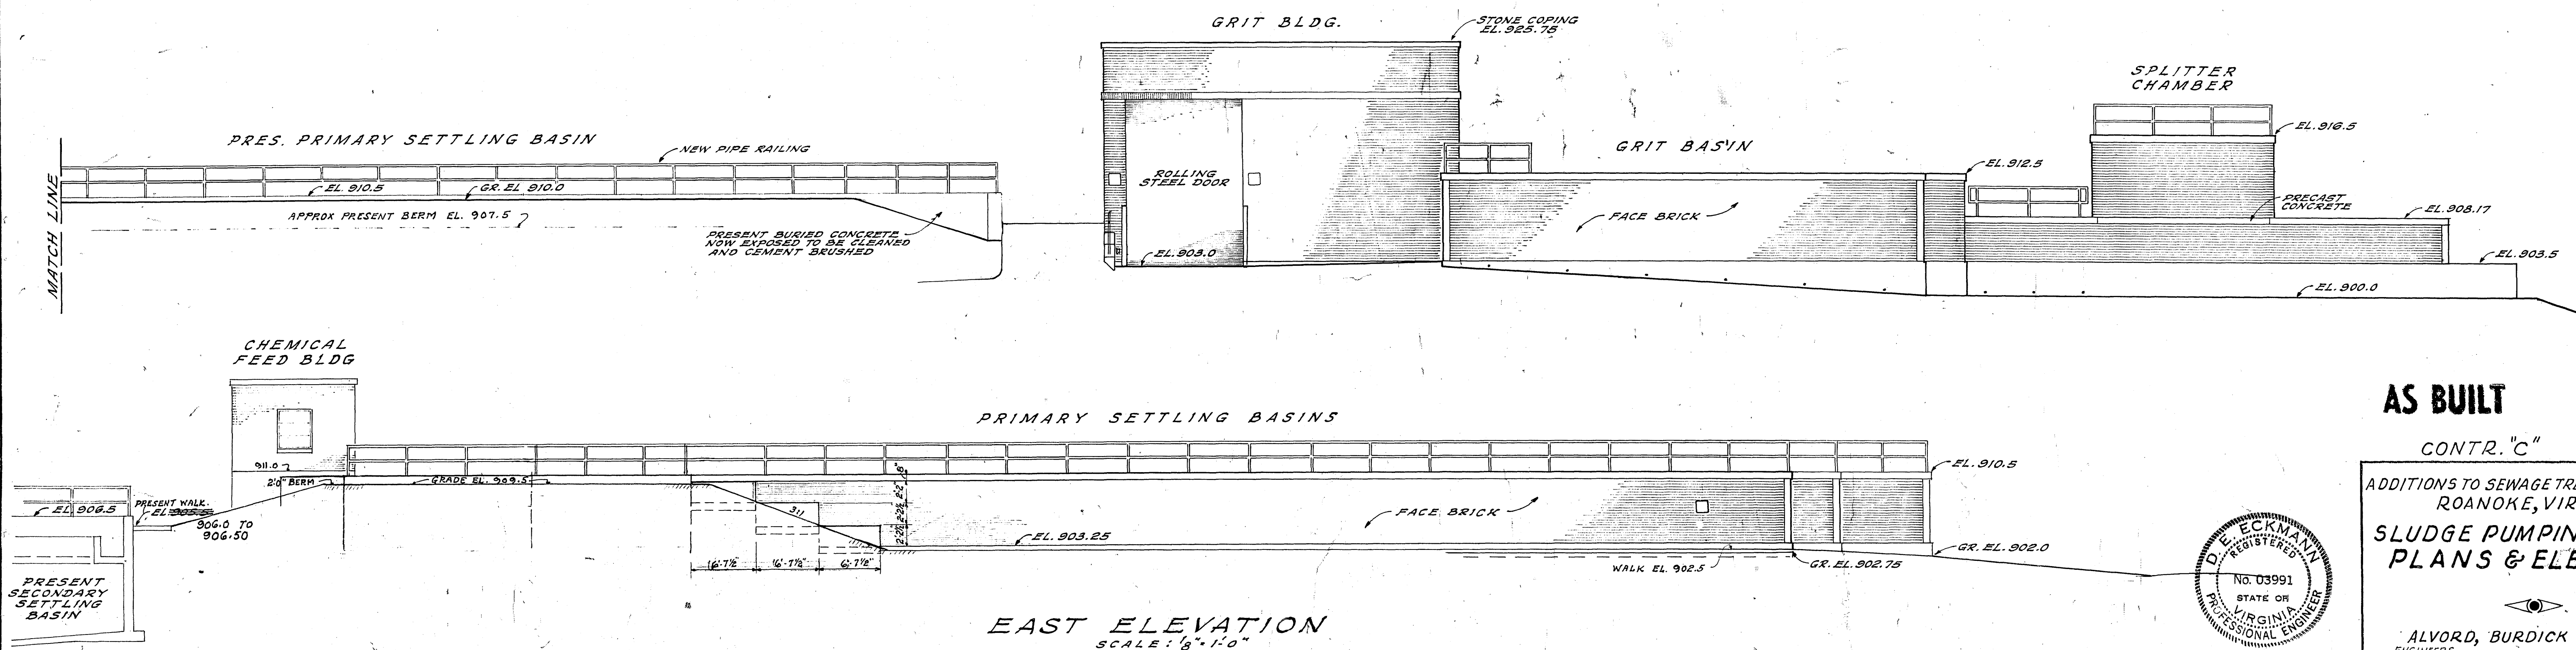
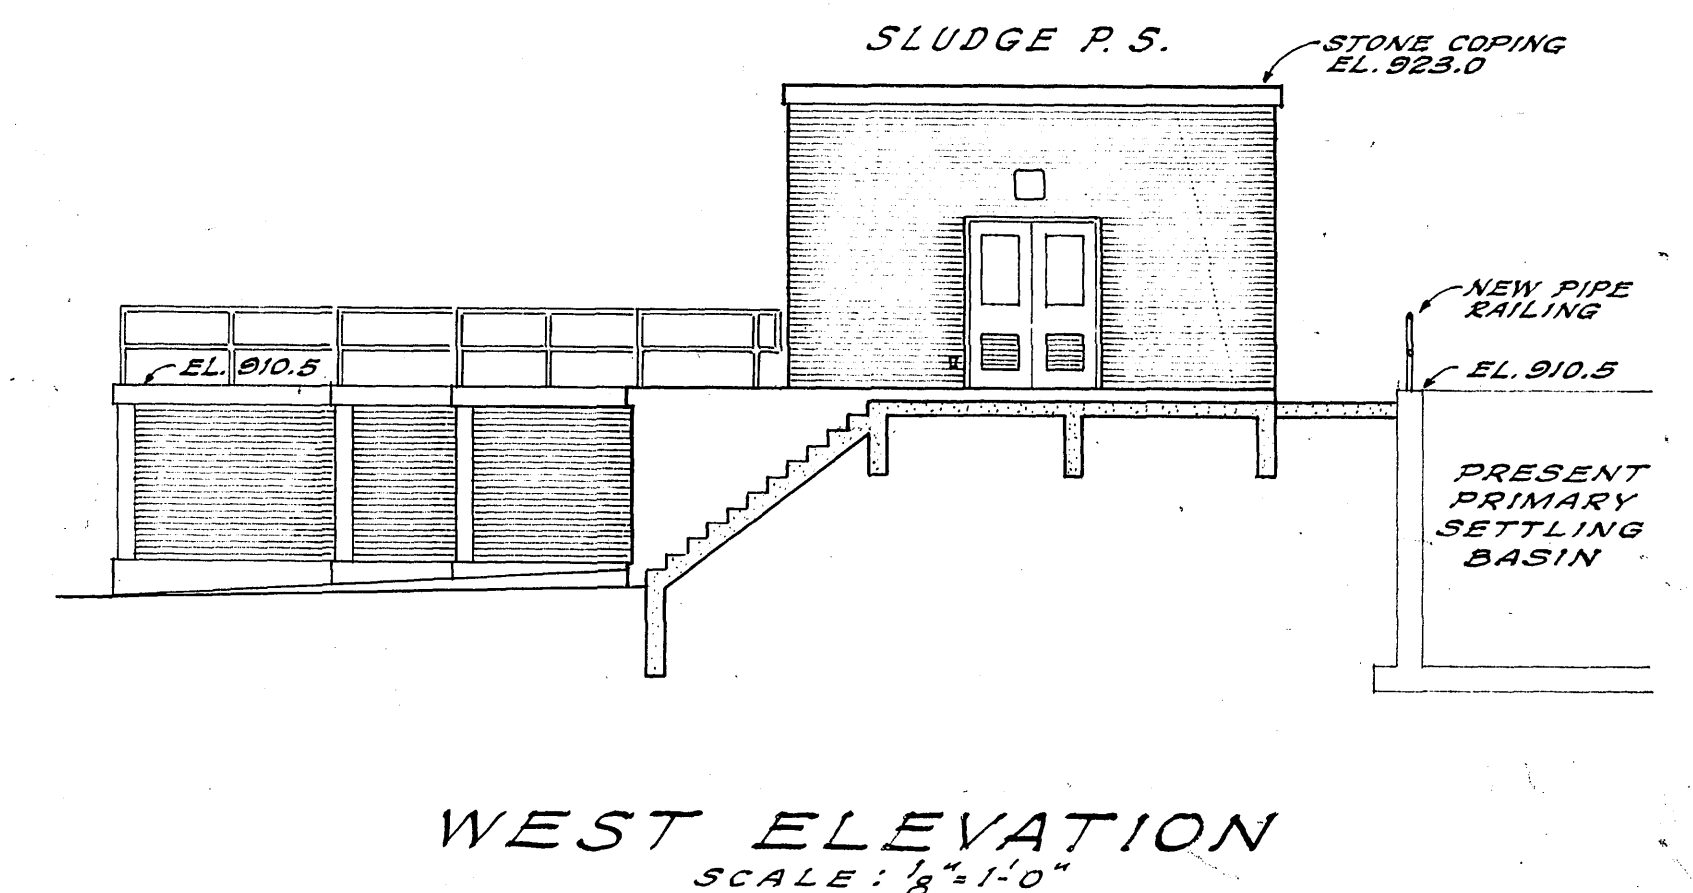
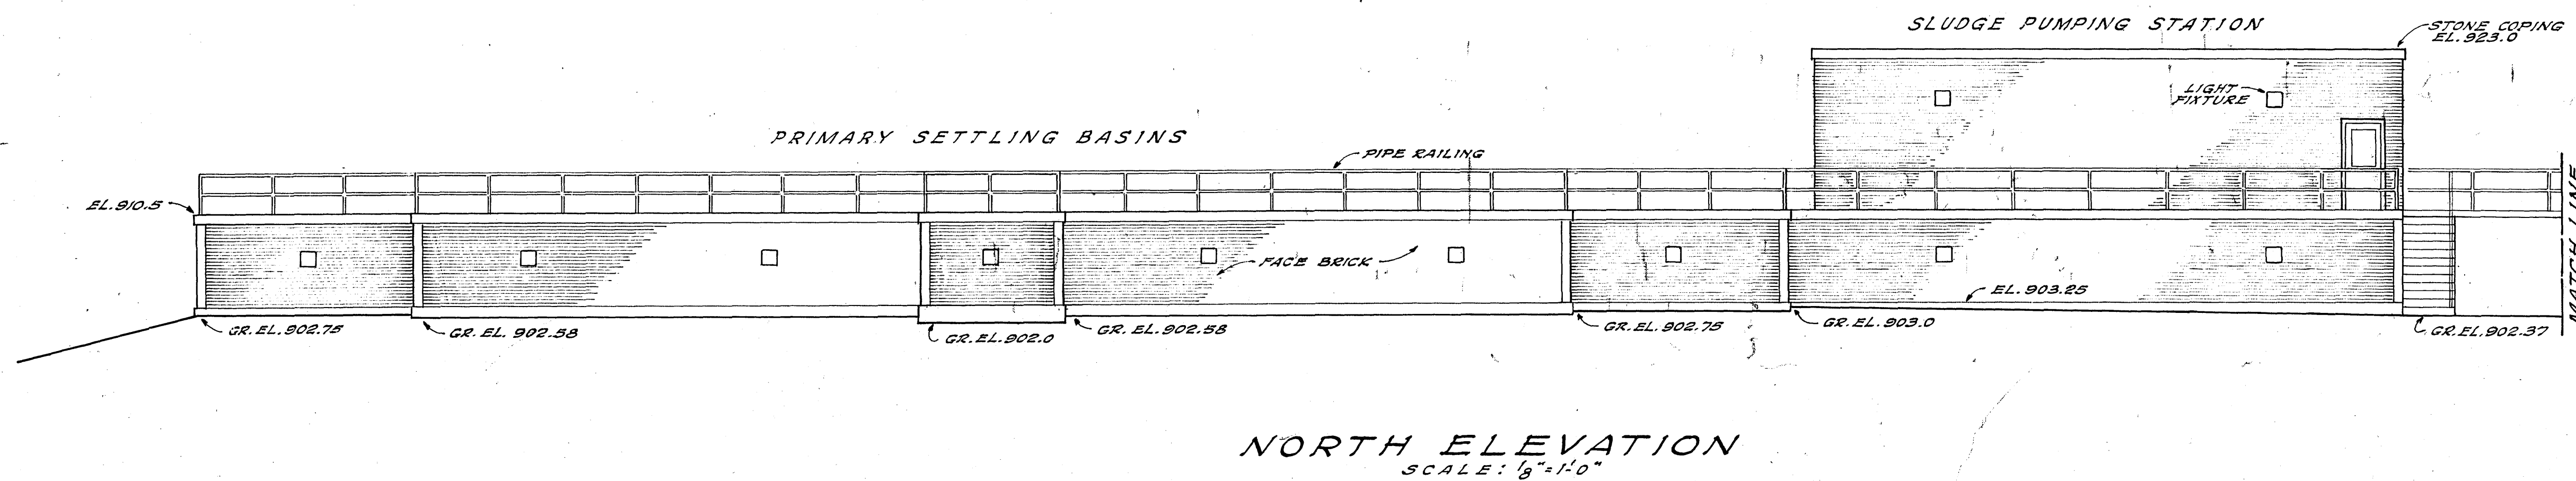
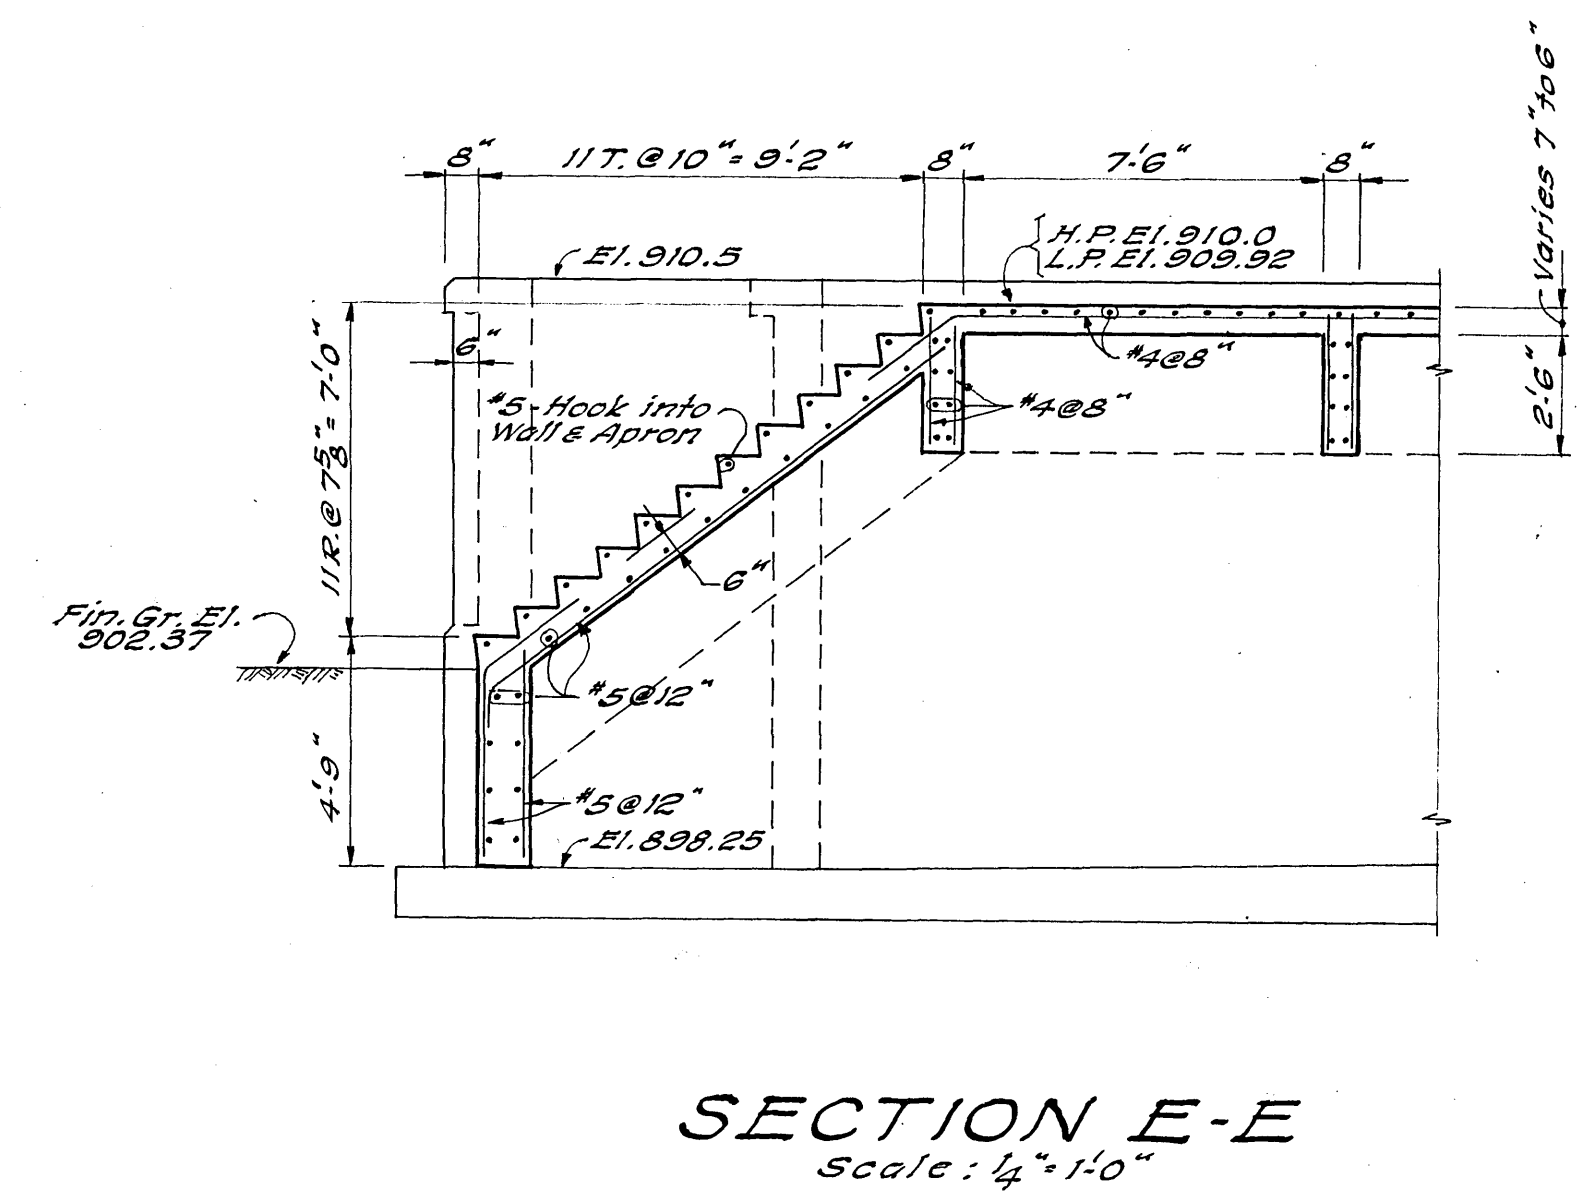


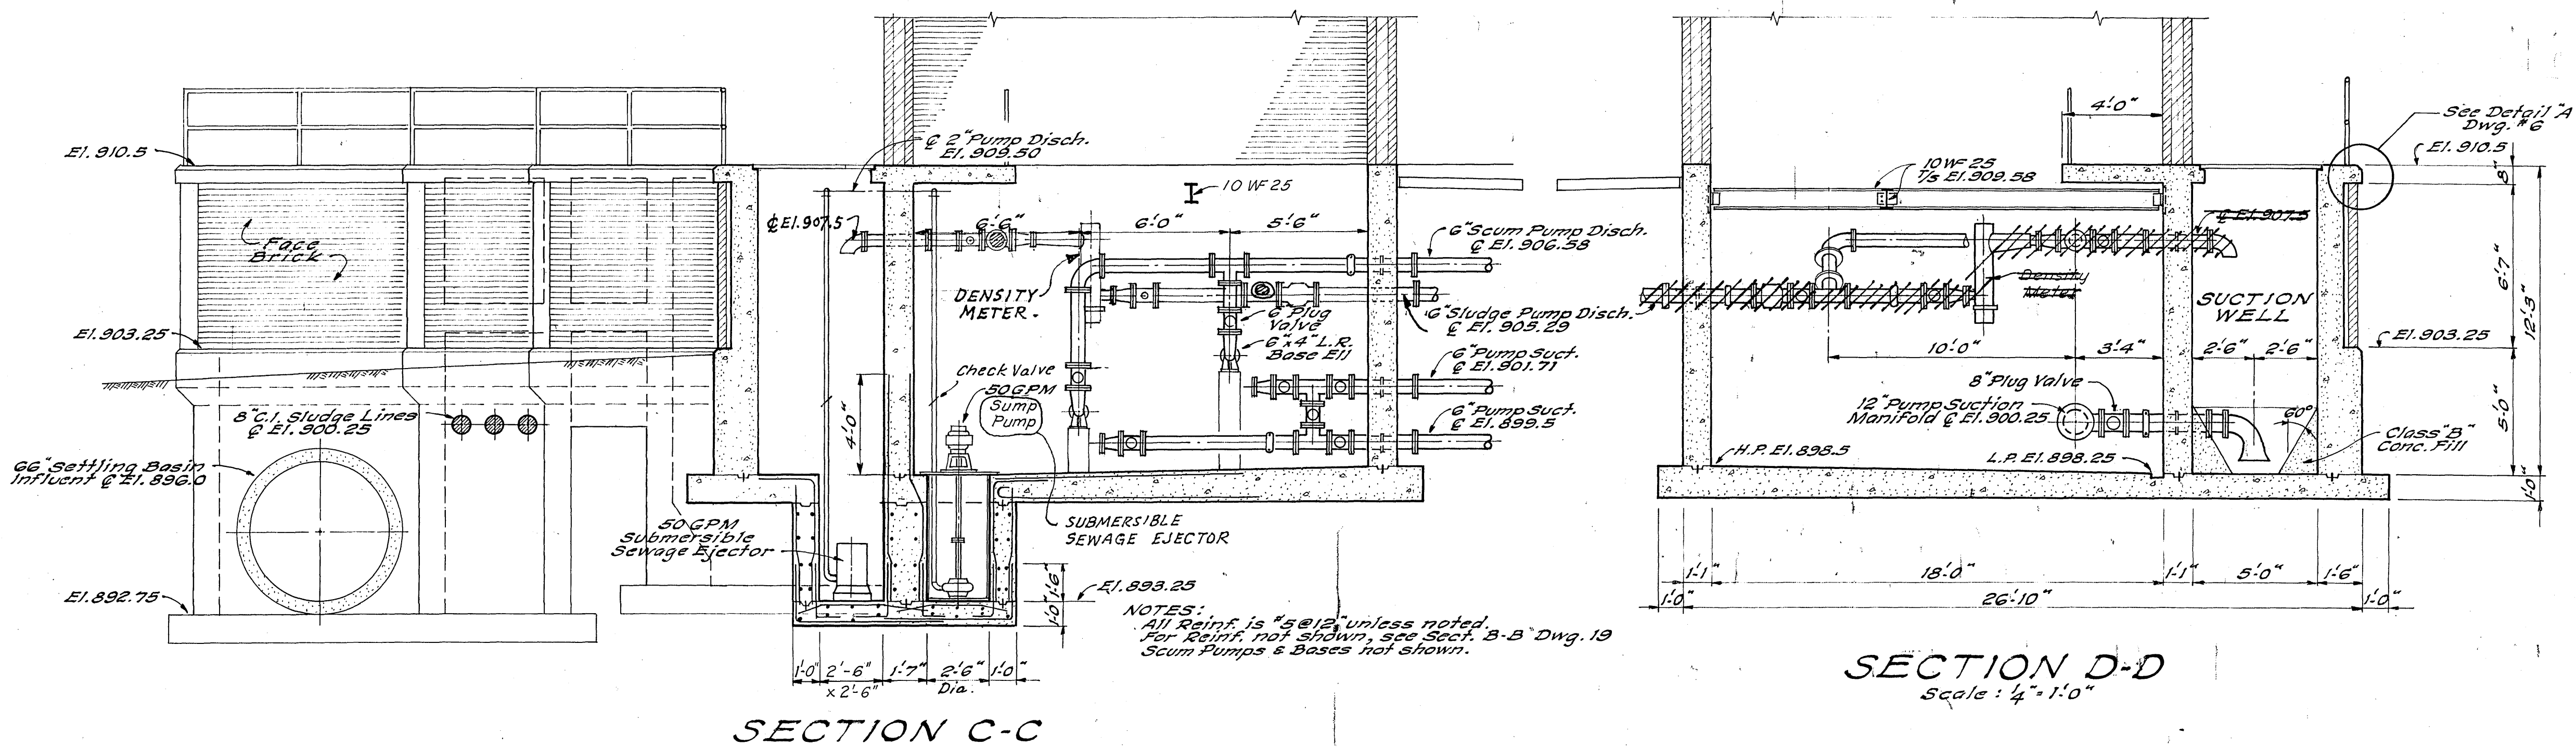

AS BUILT


CONTR. "C"

ADDITIONS TO SEWAGE TREATMENT PLANT
ROANOKE, VIRGINIA

**SLUDGE PUMPING STATION
PLANS & ELEVATIONS**

ALVORD, BURDICK & HOWSON
ENGINEERS CHICAGO

1973

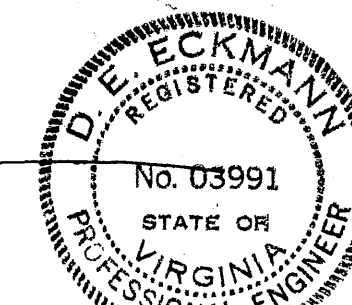

20