
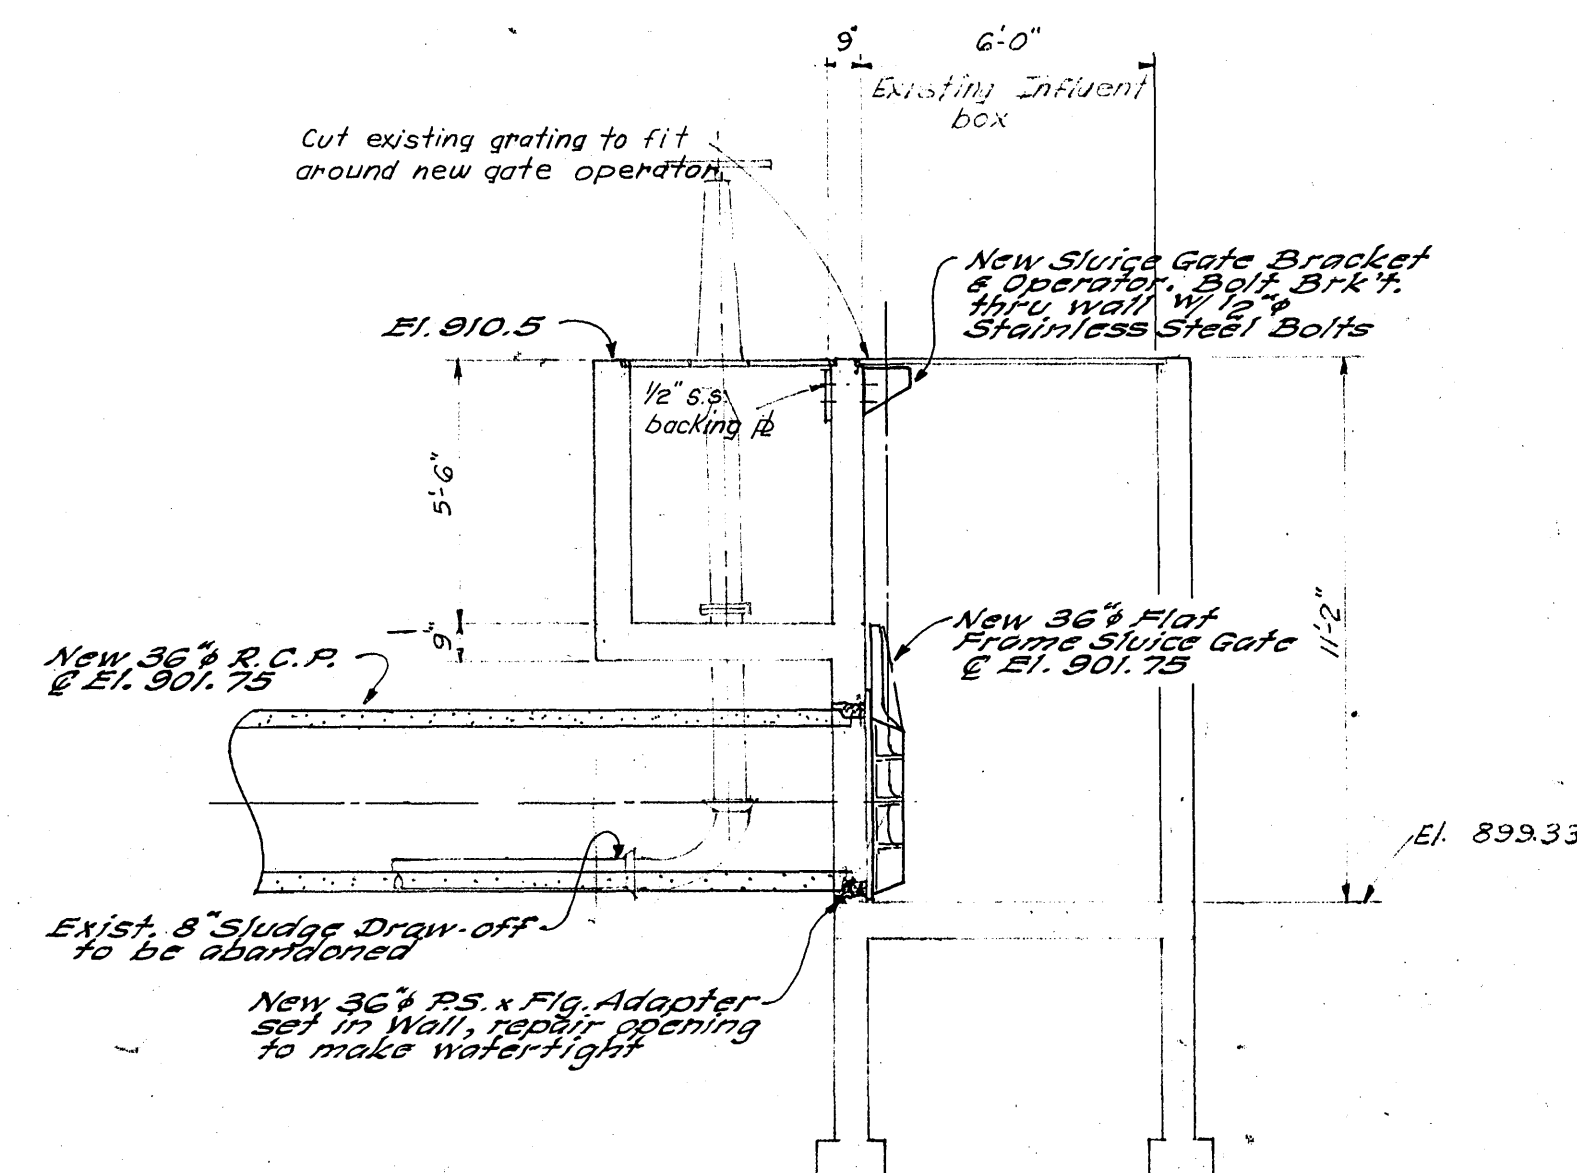
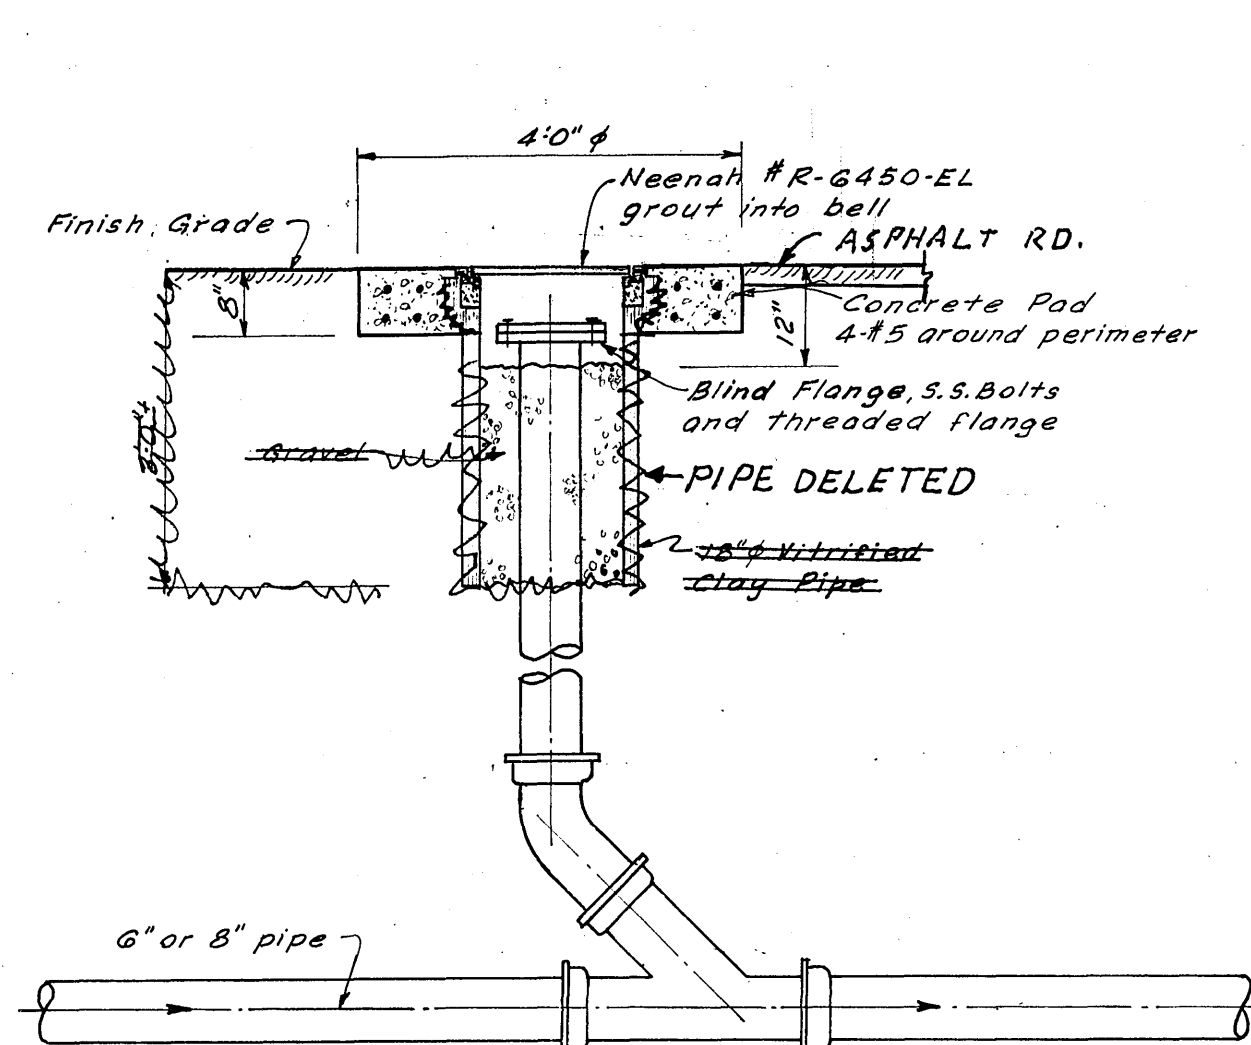
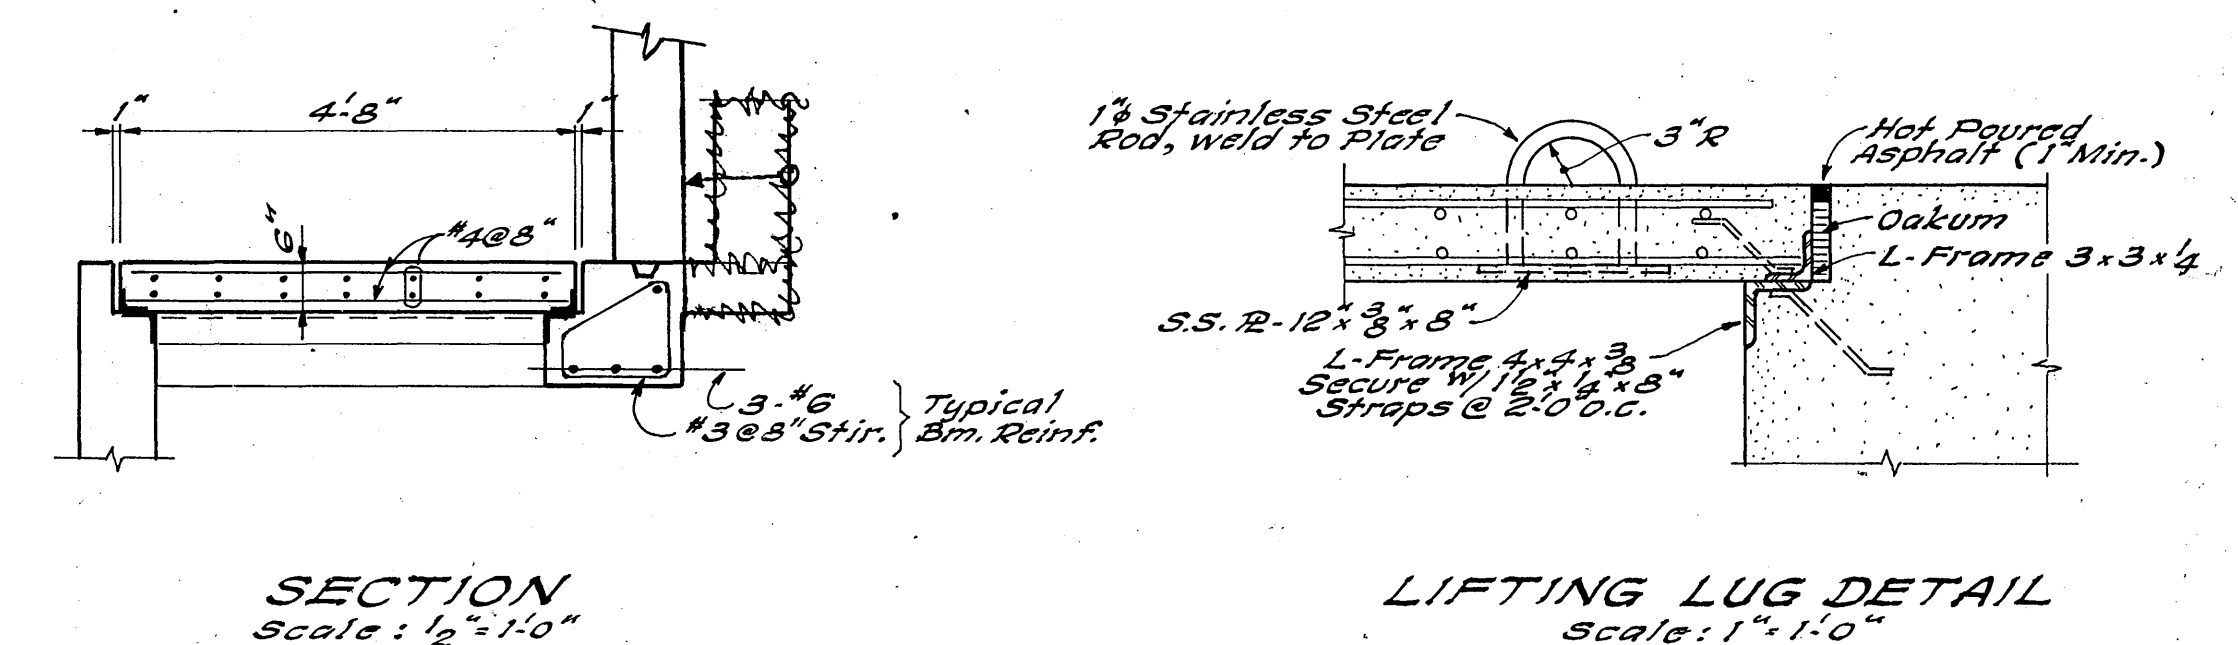
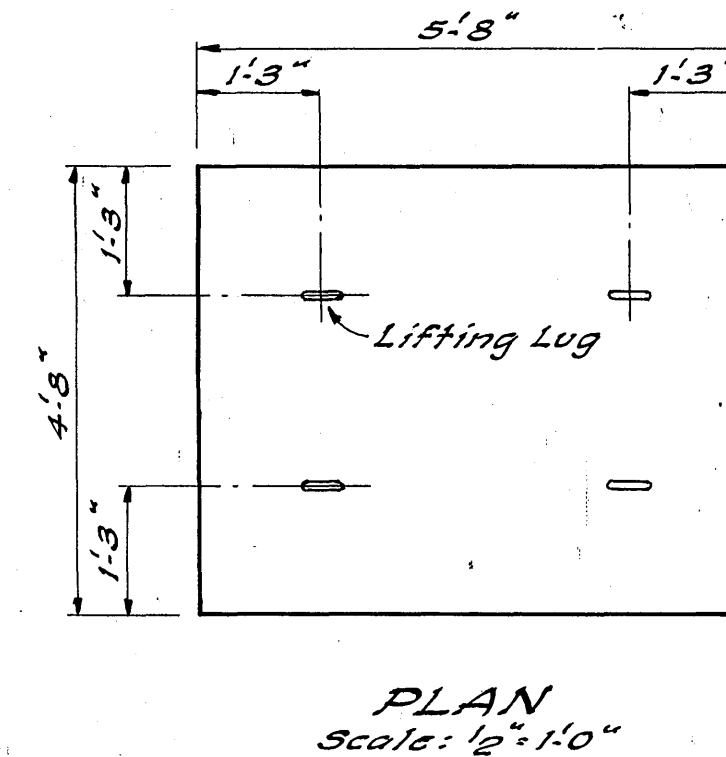
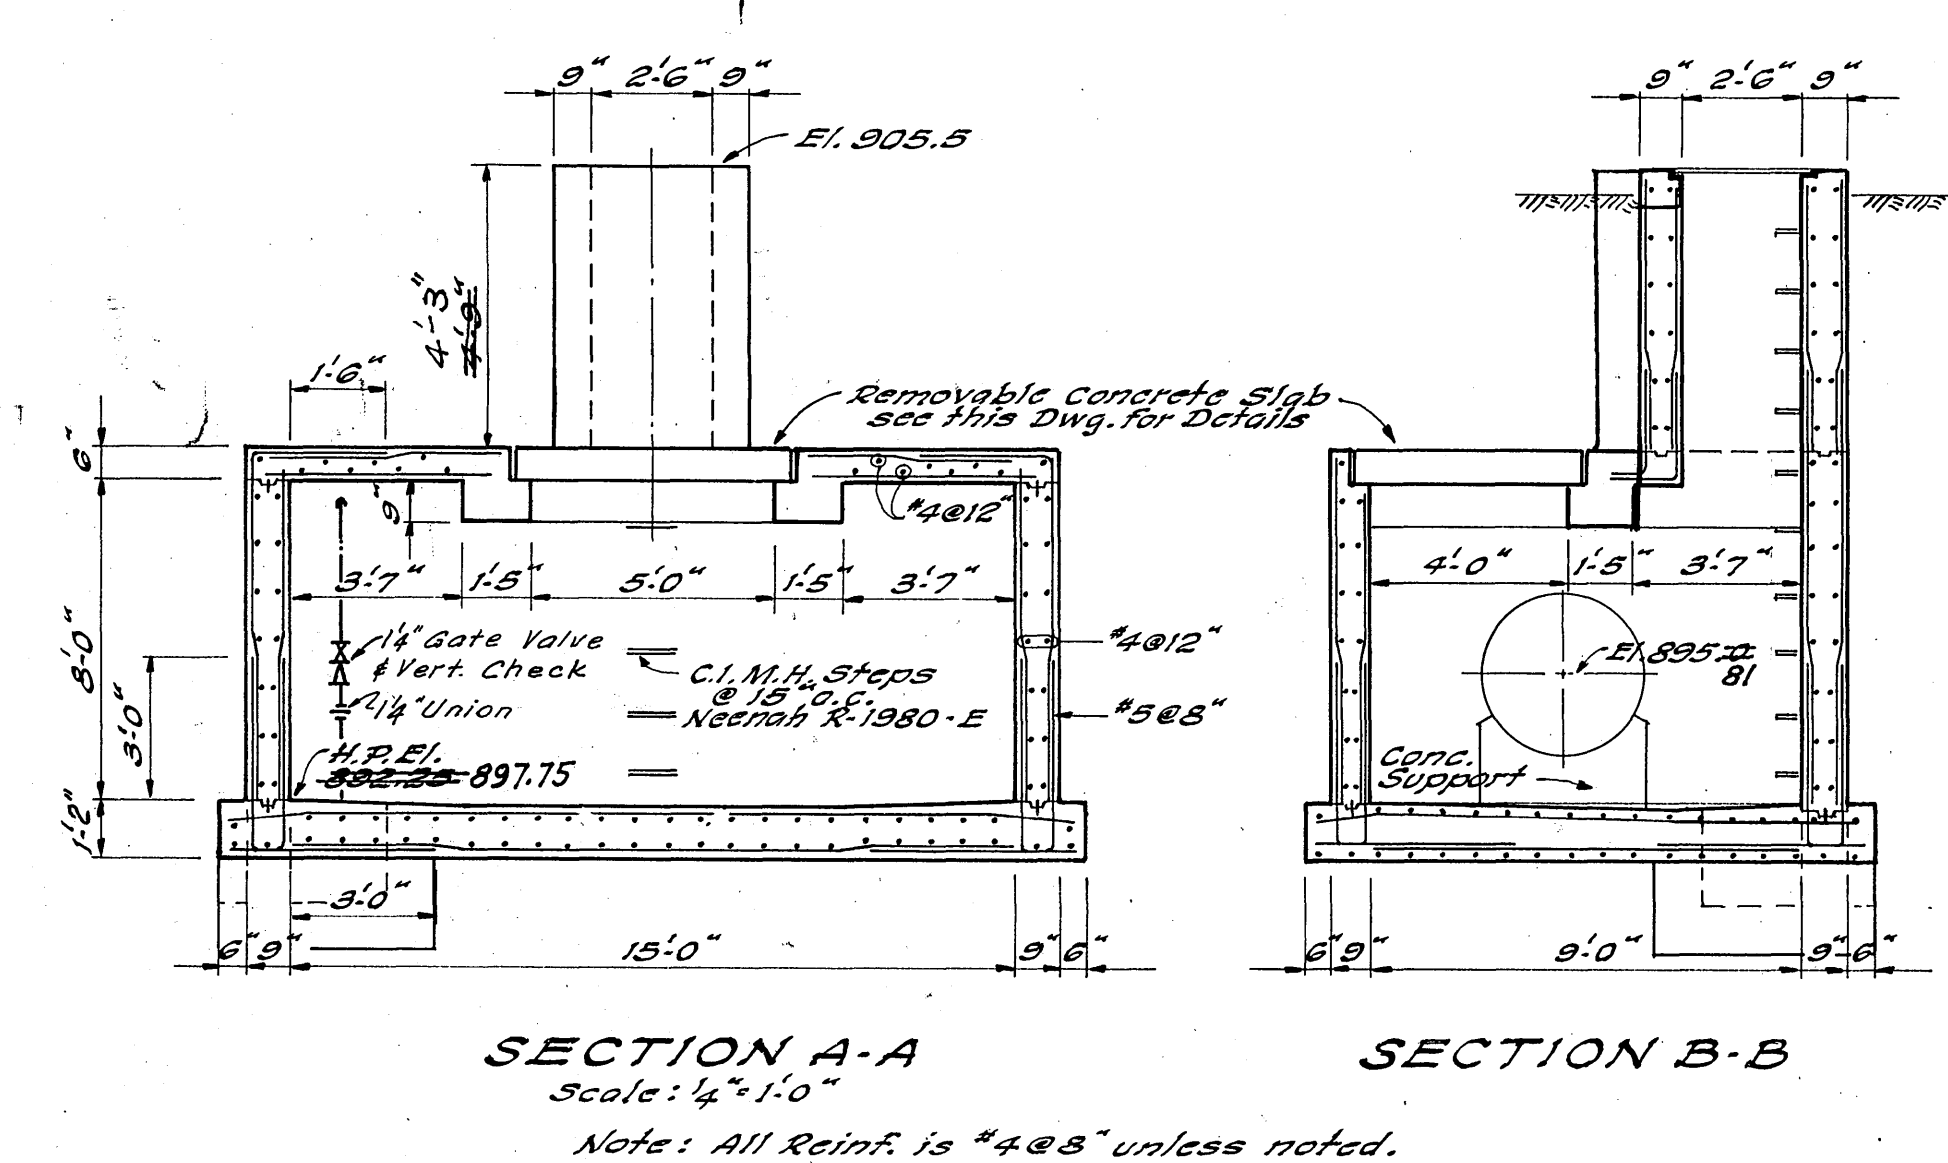
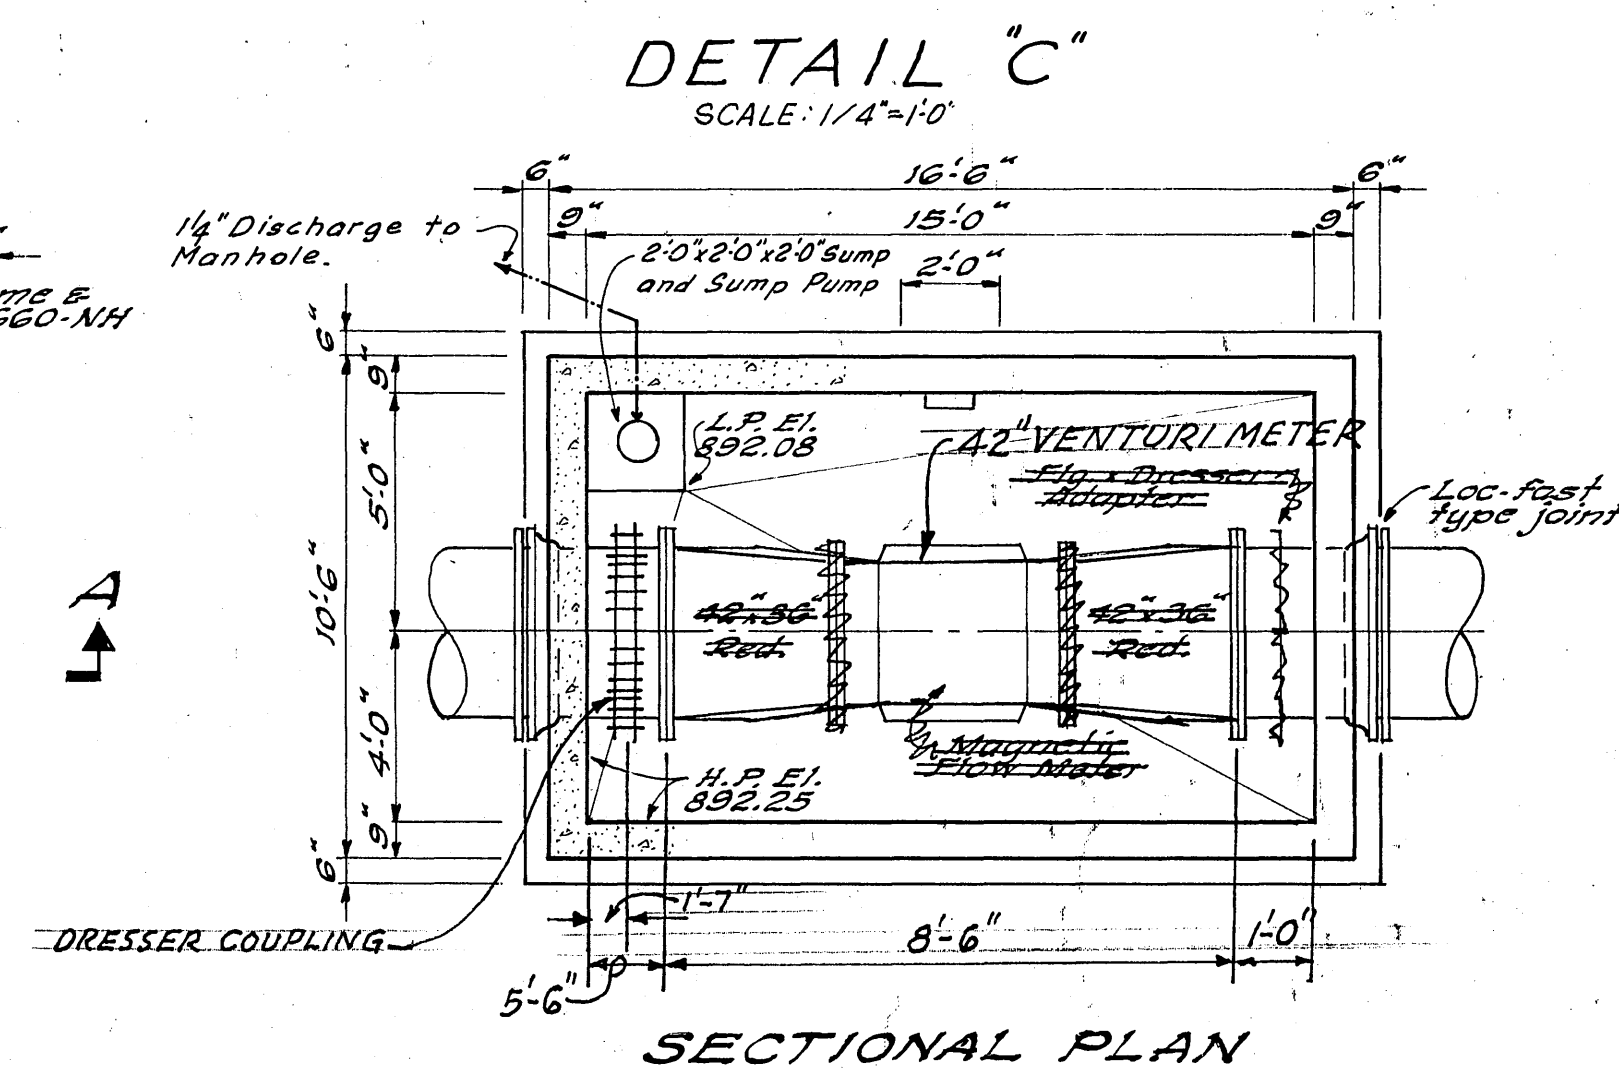
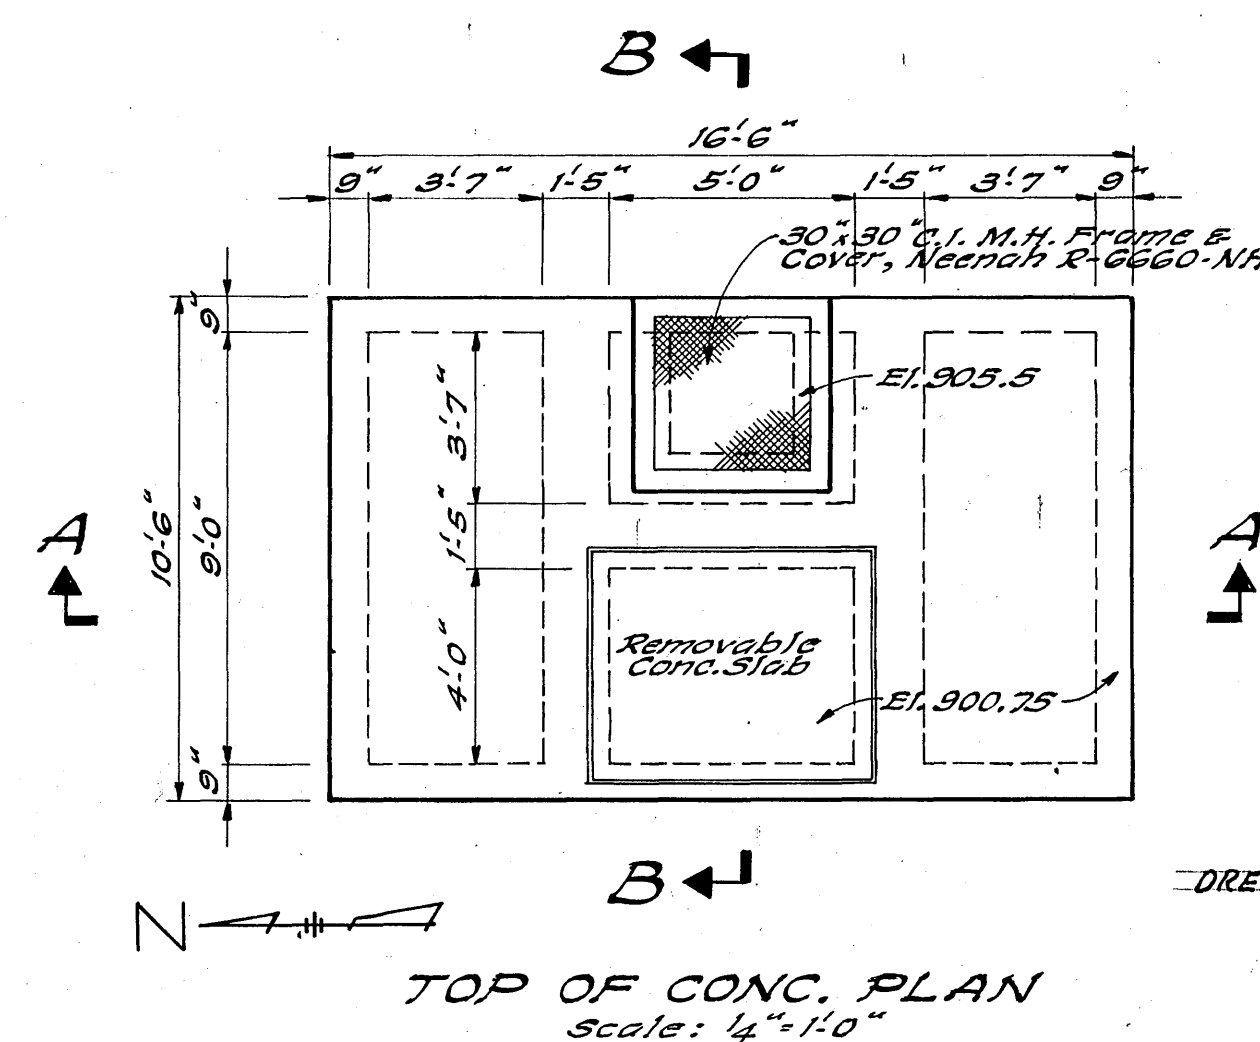


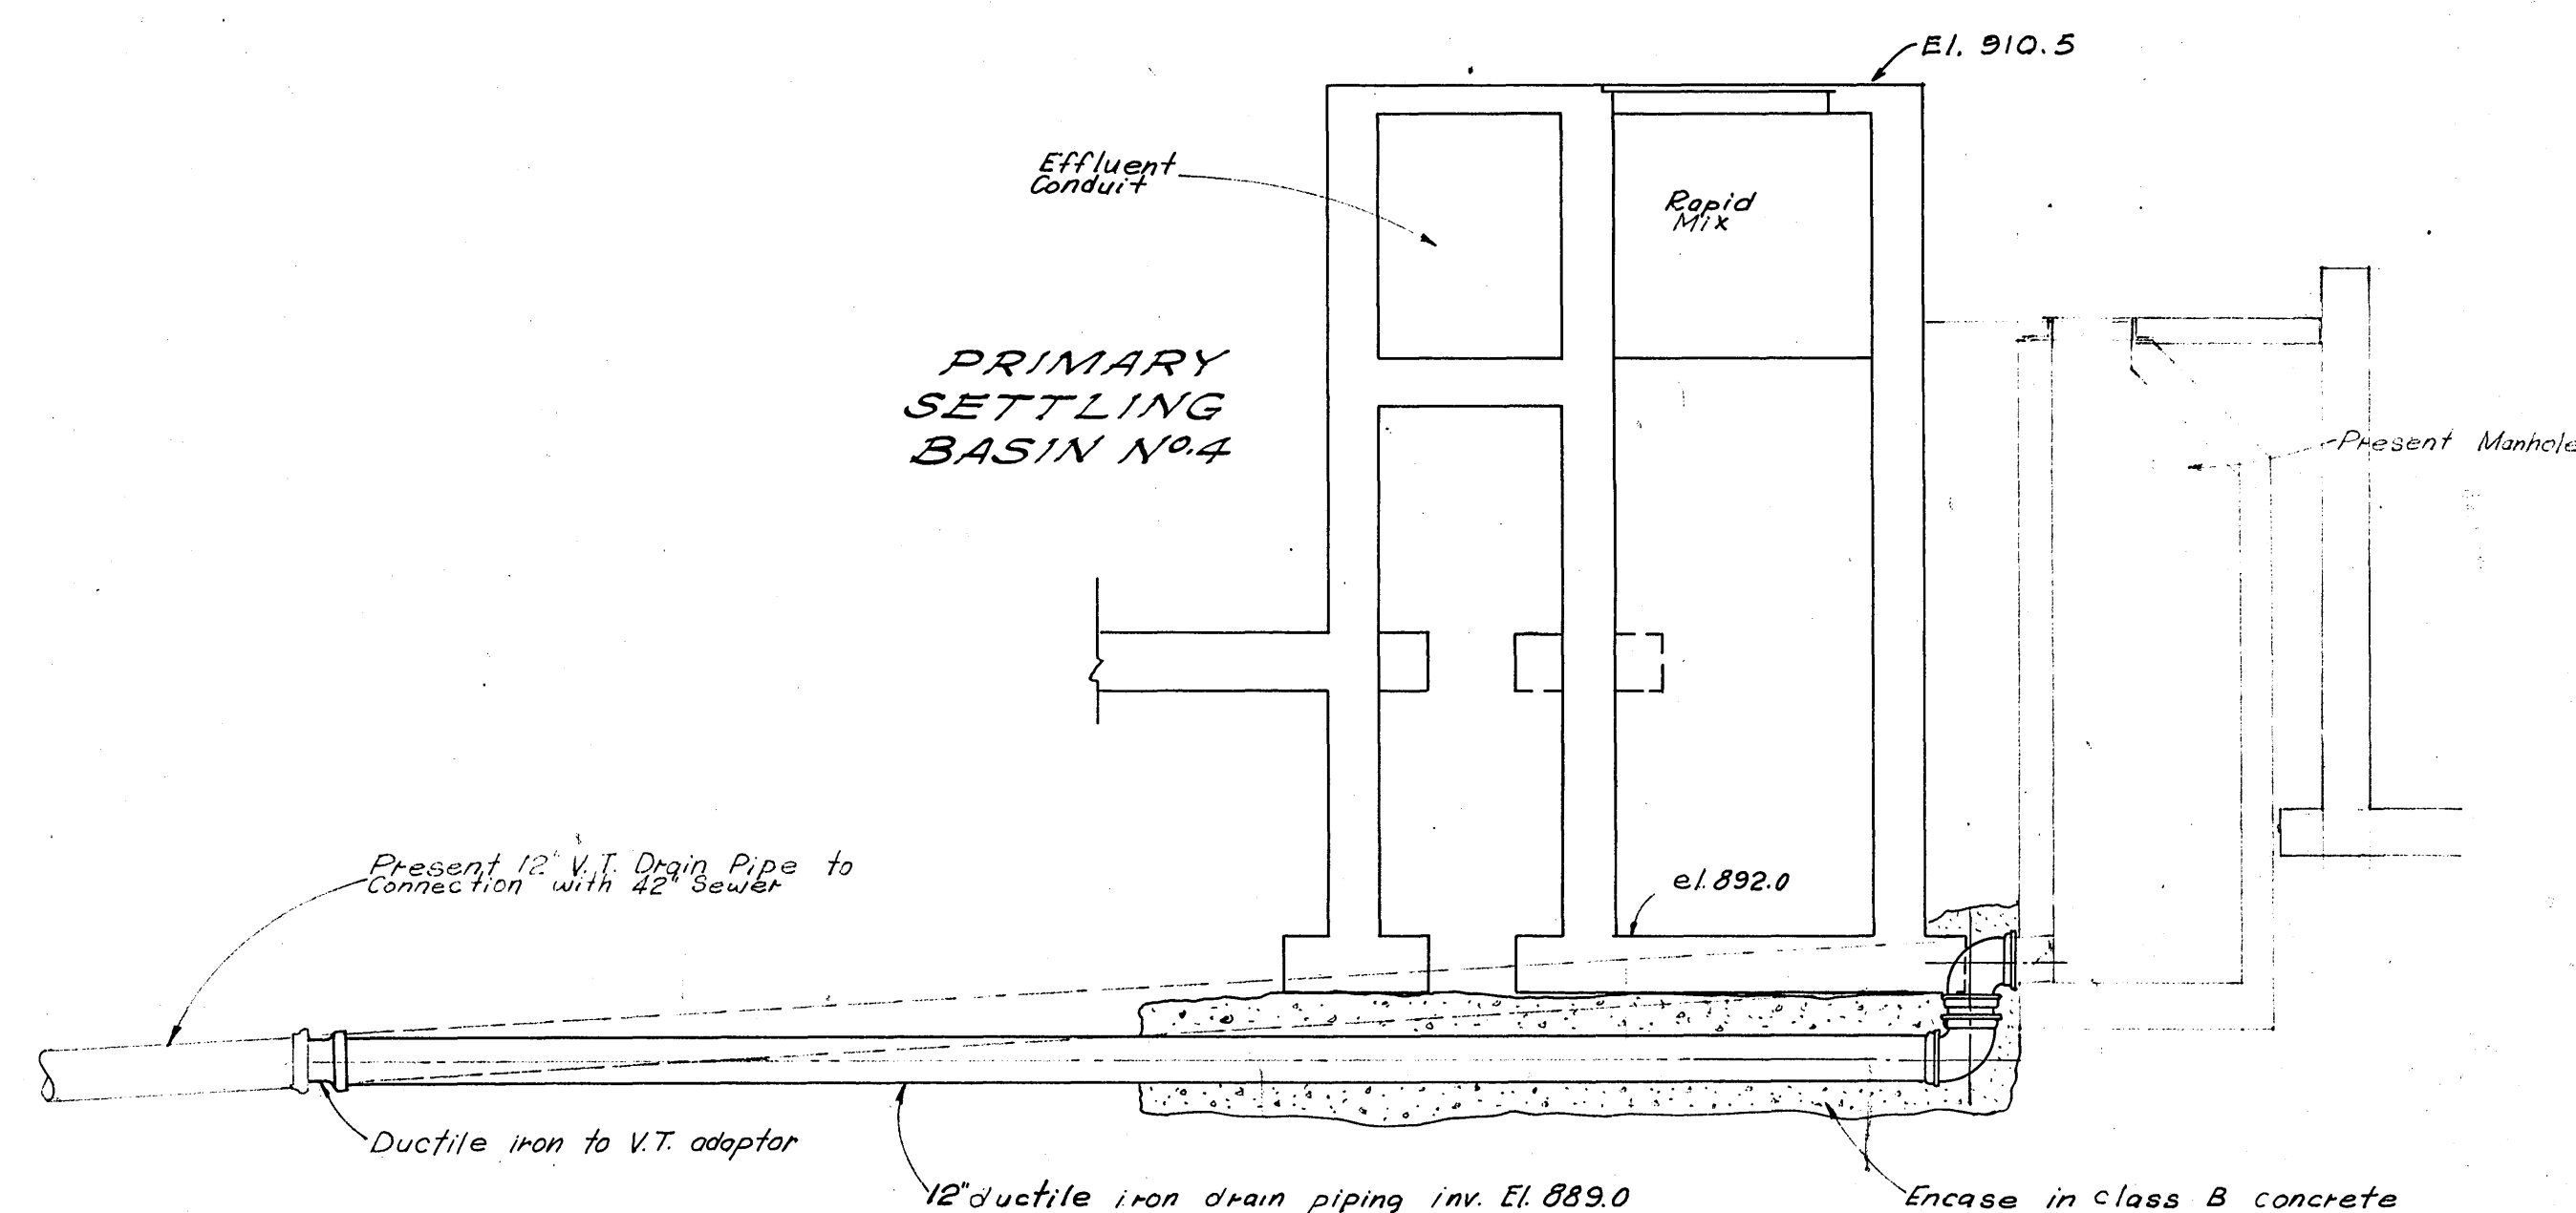

NEW 36" CROSS CONNECTION  
(AT PRES. PRIMARY BASIN INF. CHAMBER)  
Scale: 4" = 1'-0"

REMOVABLE SLAB DETAILS

METER VAULT DETAILS

**AS BUILT**  
CONTR. "C"

21)

MISCELLANEOUS  
DETAILS

1973

\*Revised 5/25/73

