




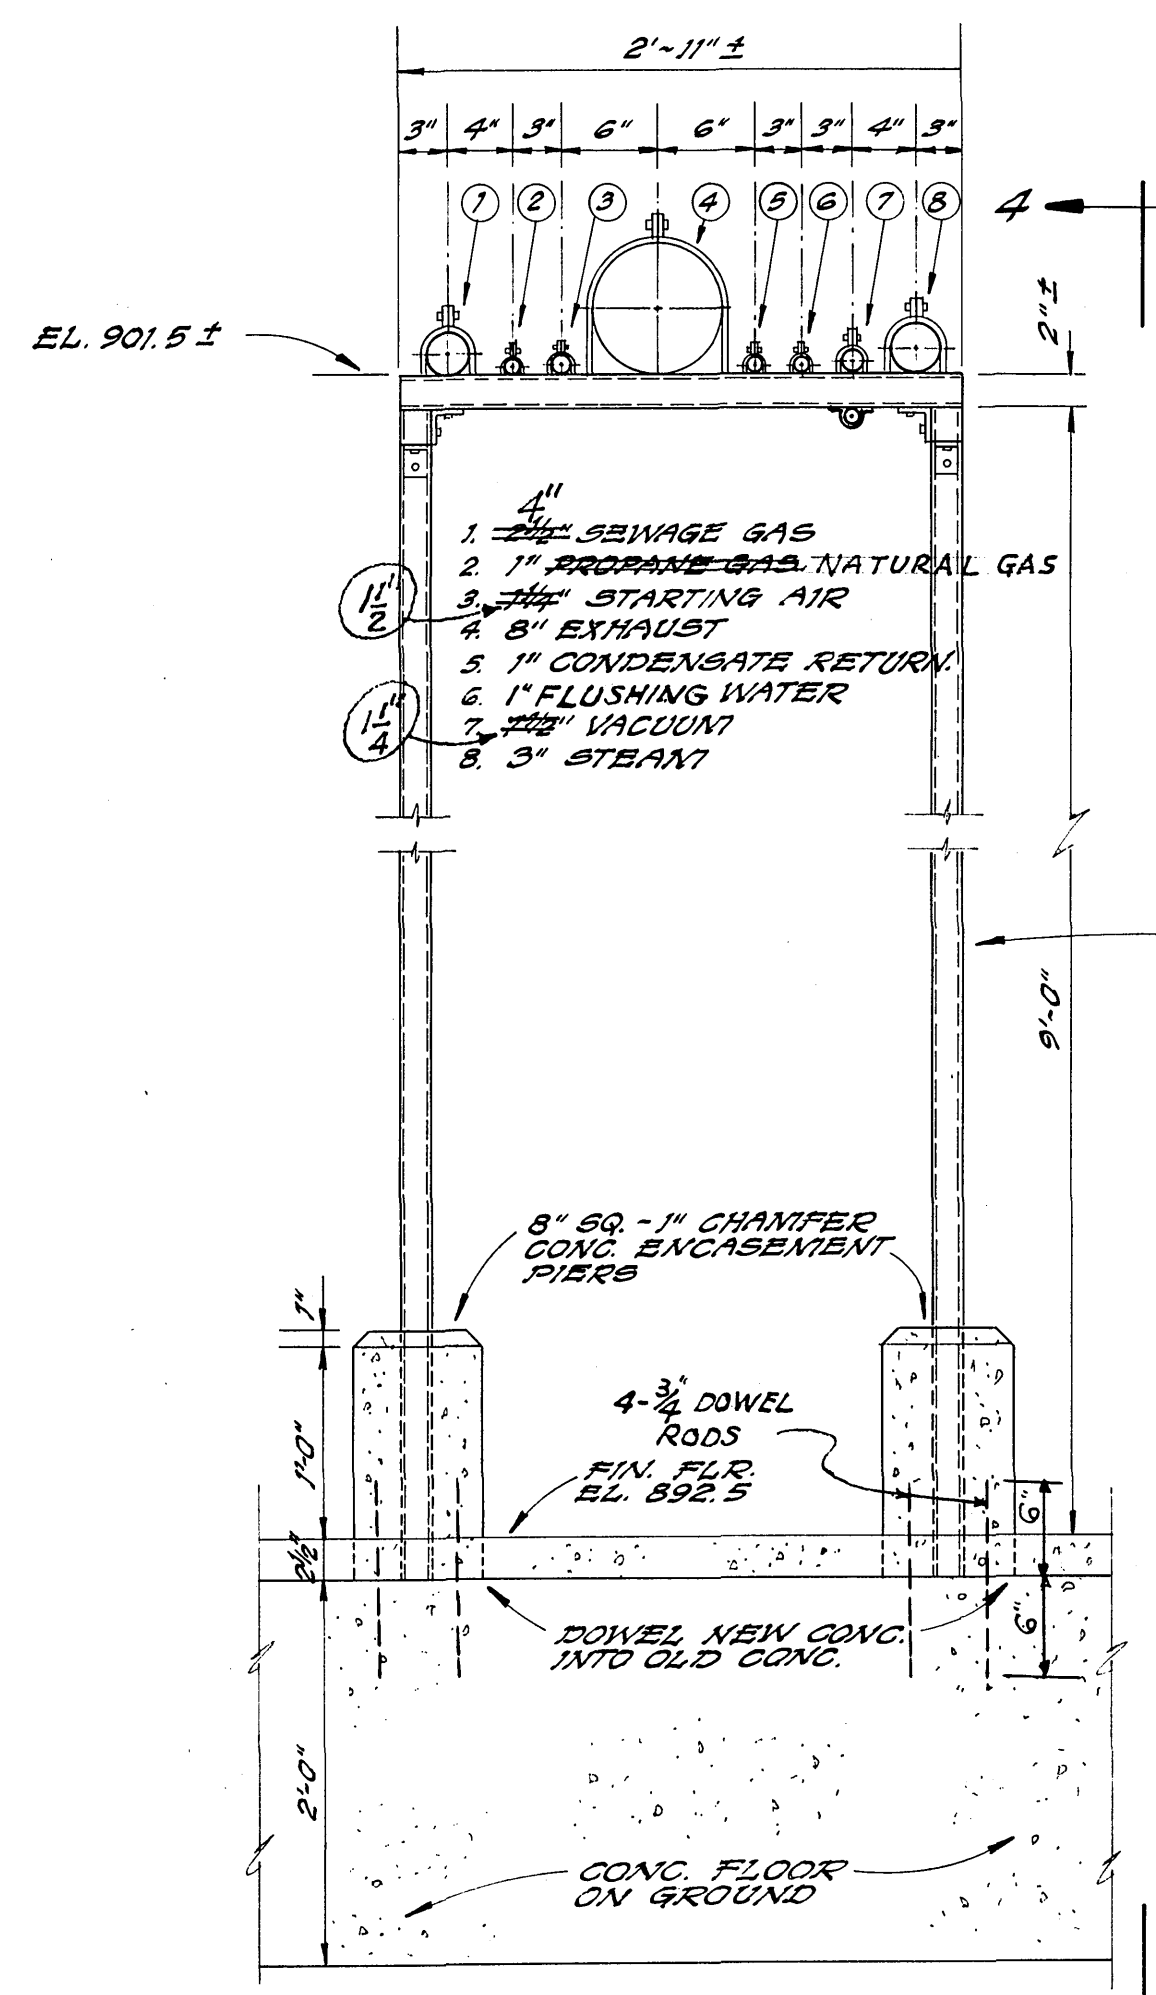


SECTION 1-1
SCALE: 1/2" = 1'-0"

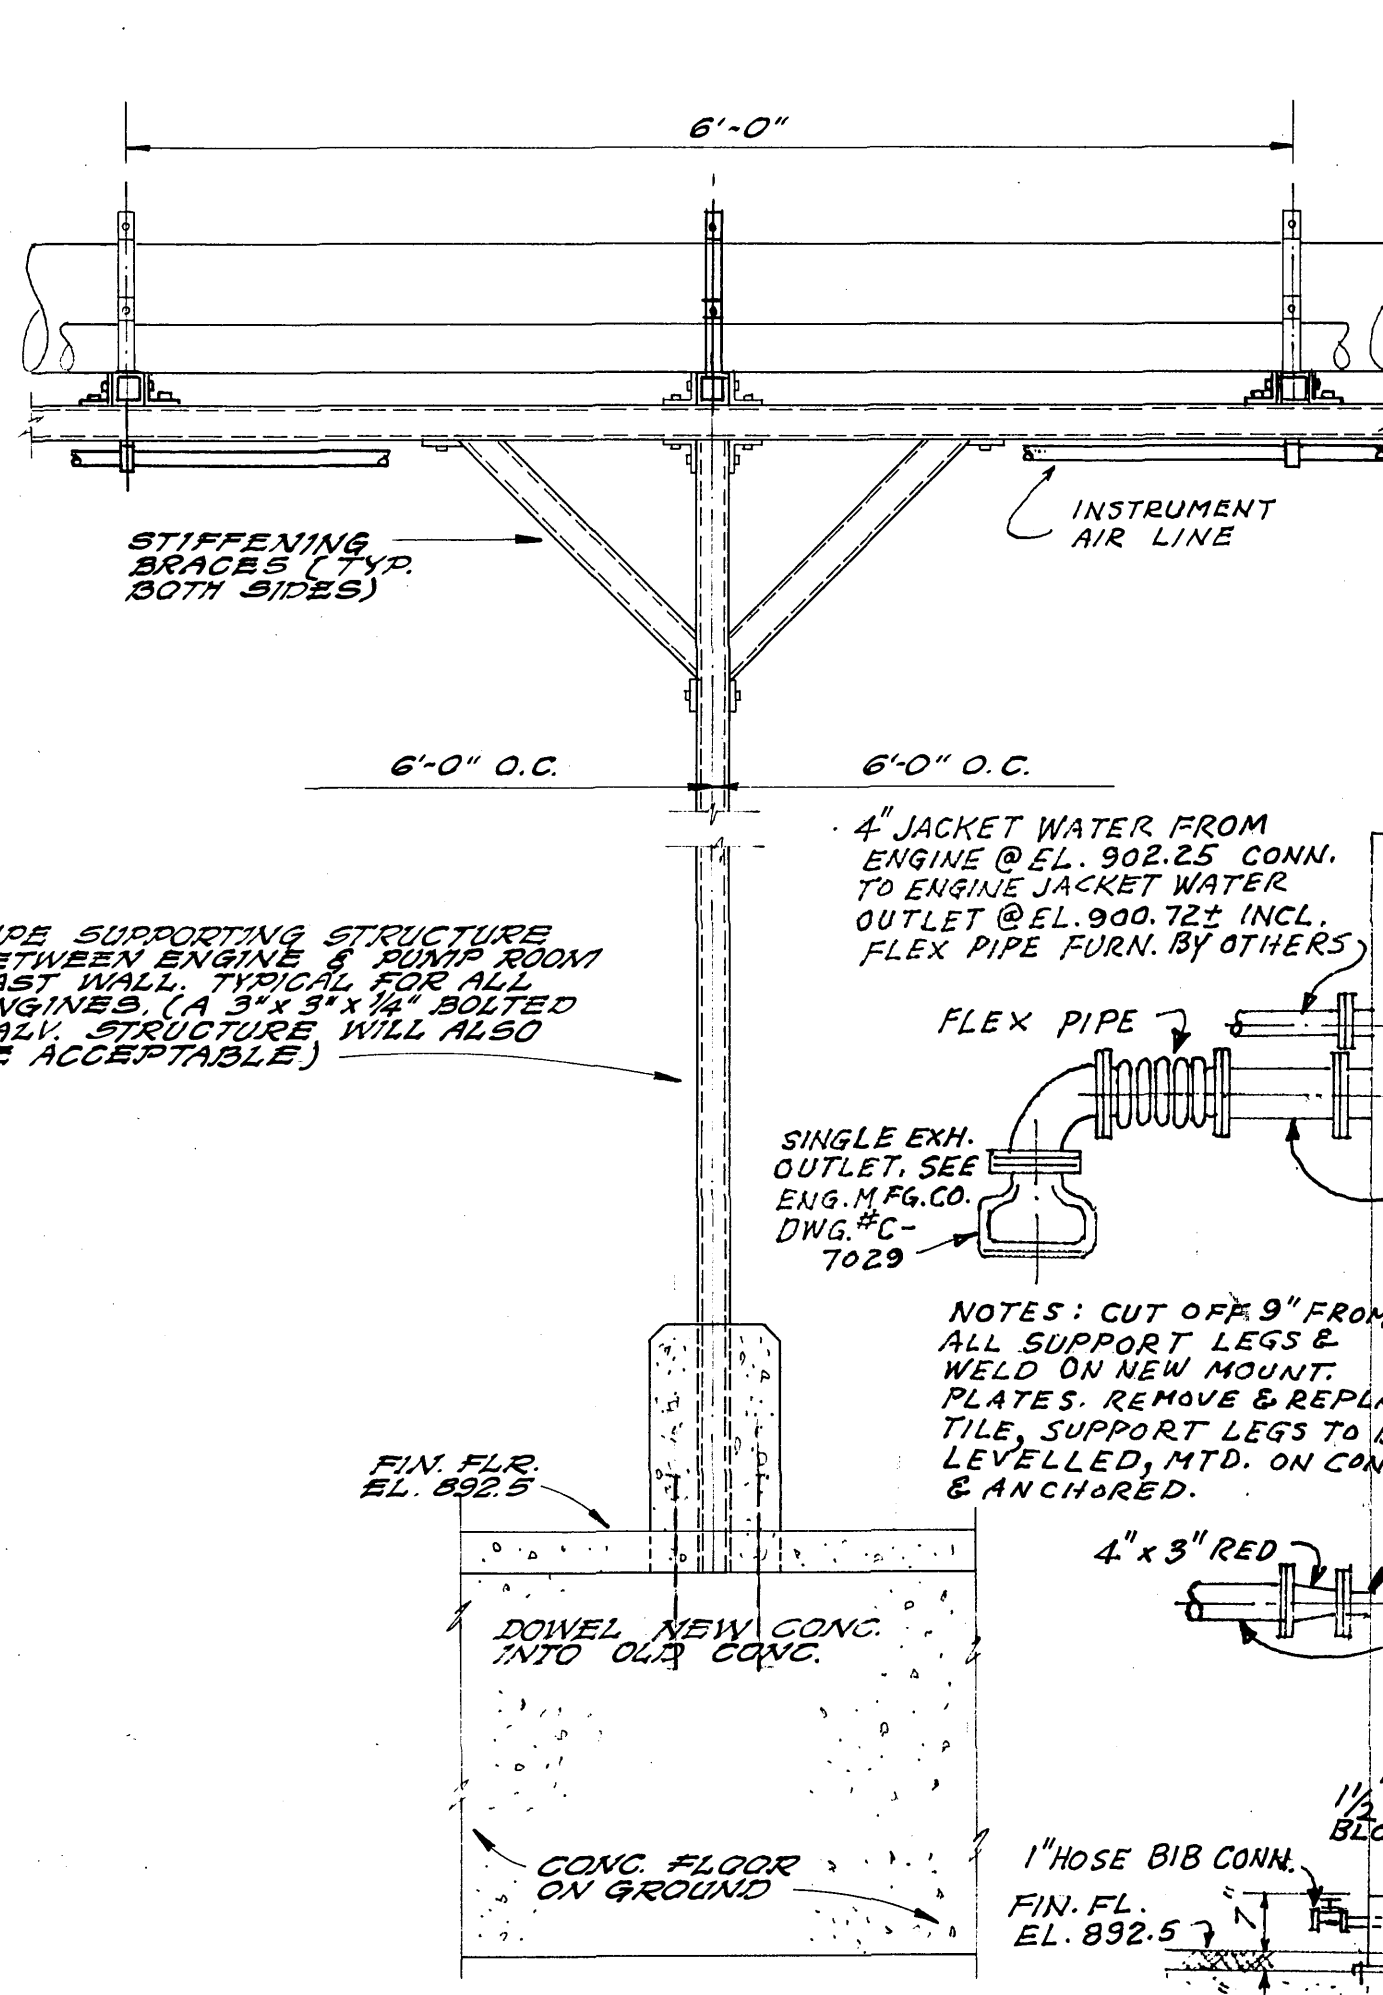


SECTION 4-4
SCALE: 1" = 1'-0"

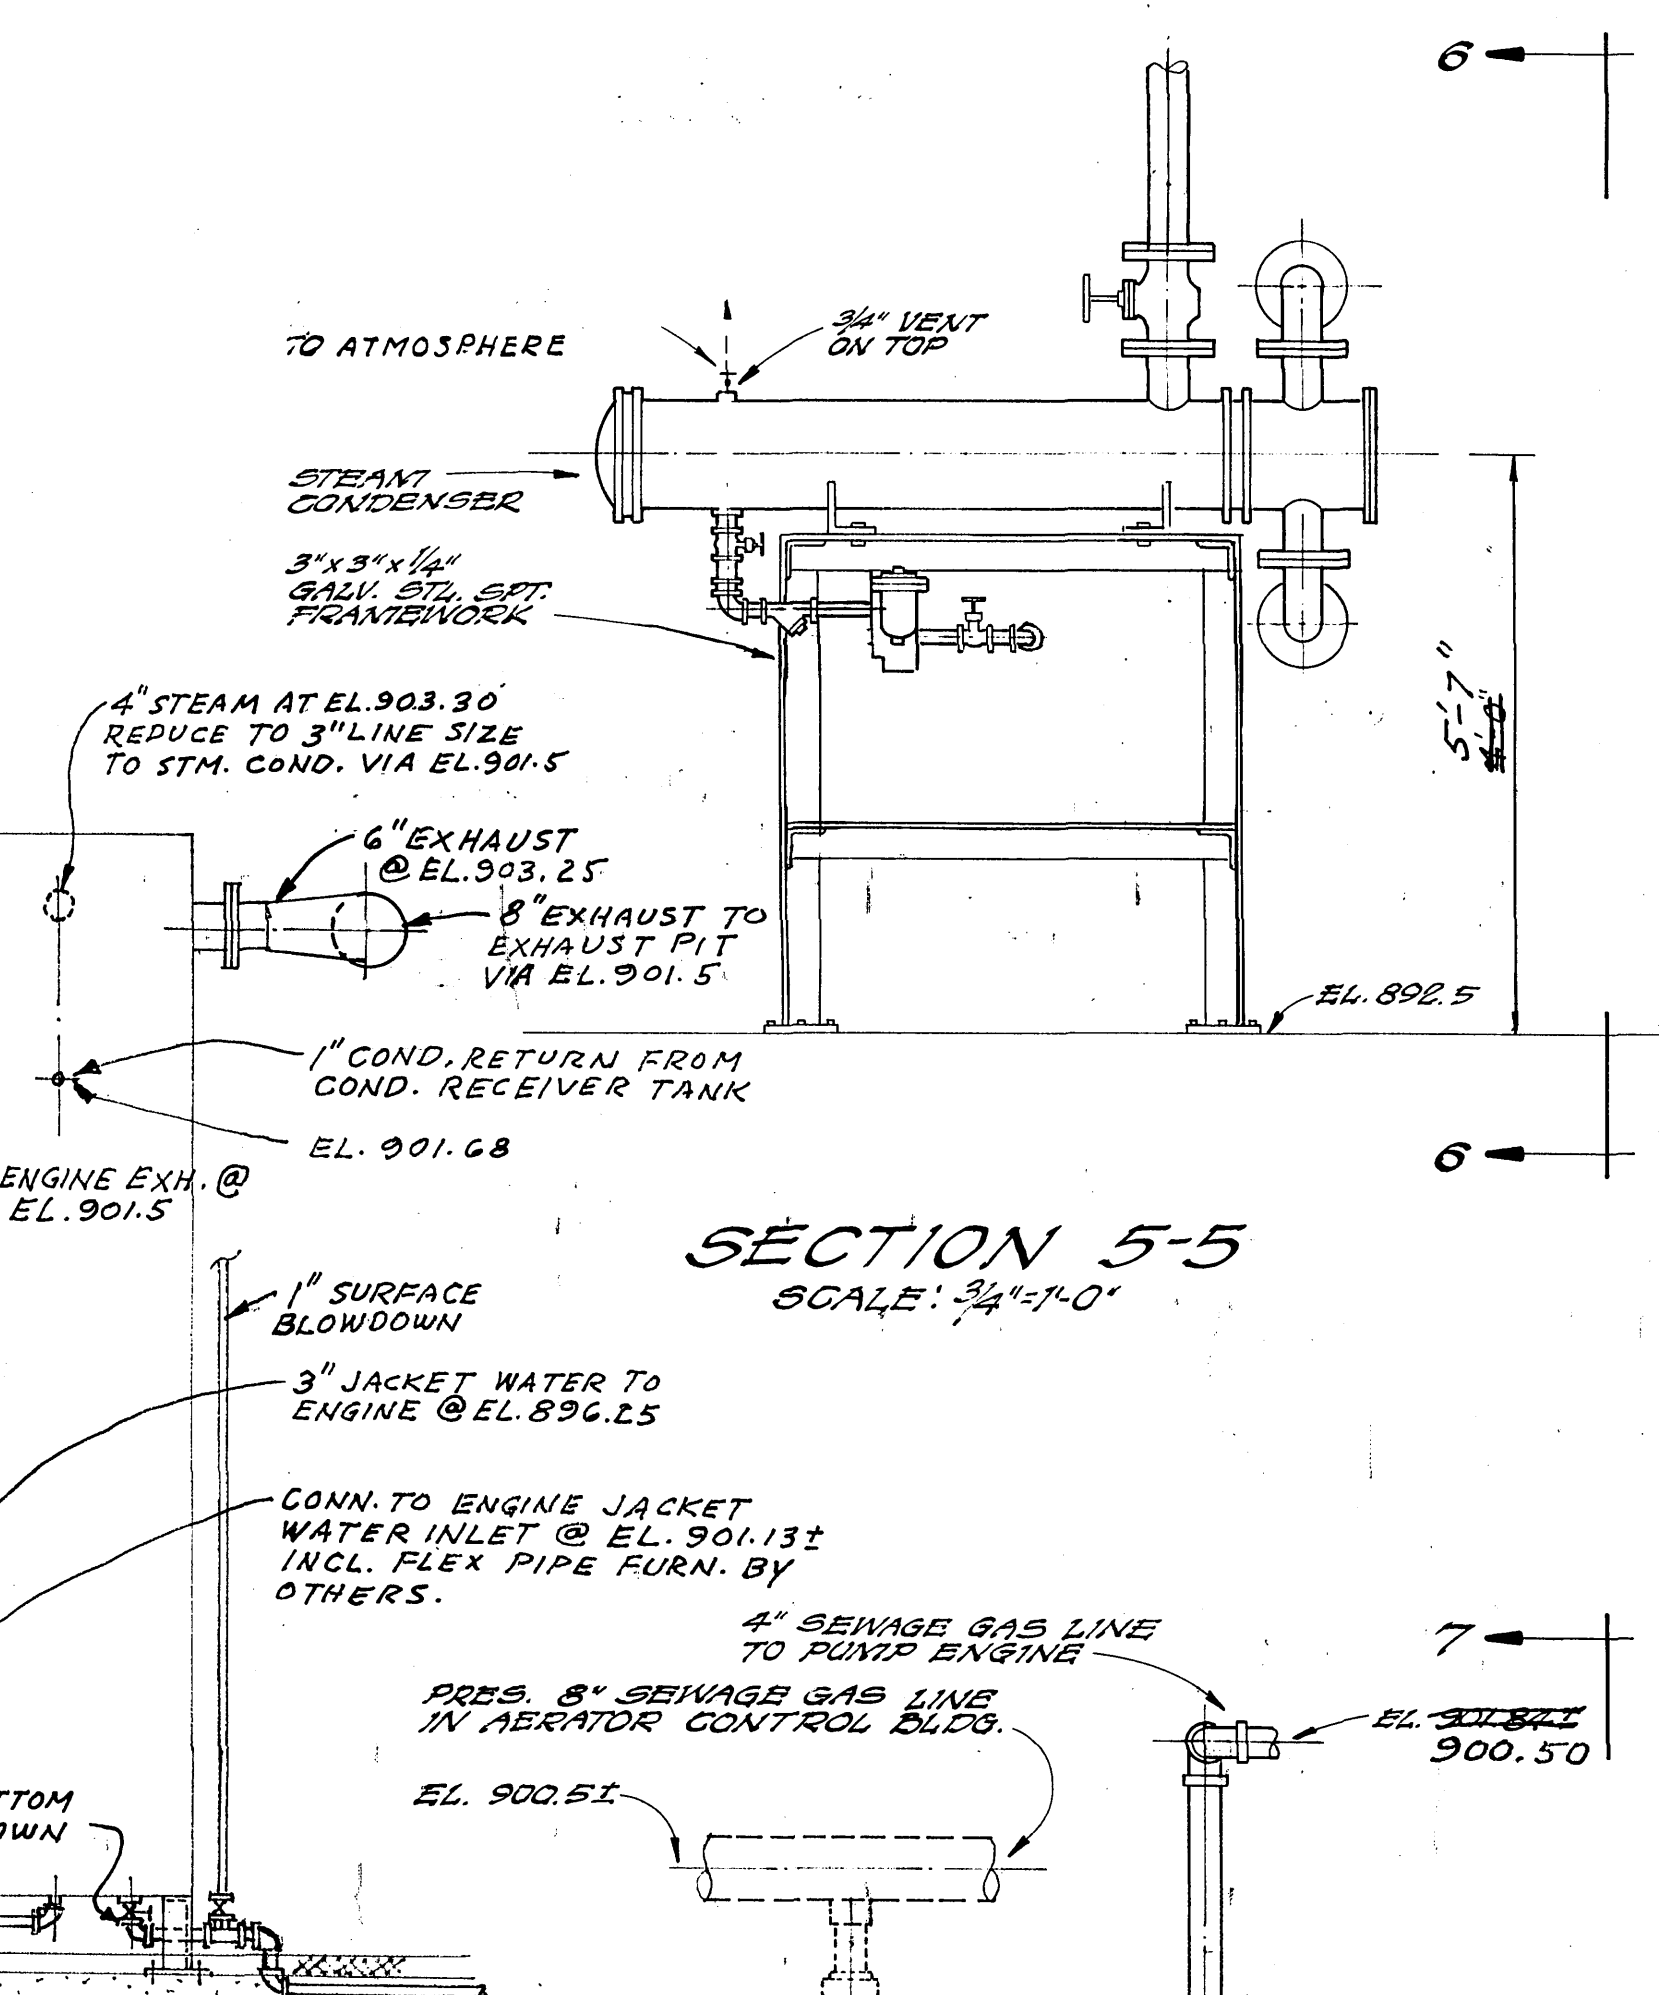


SECTION 5-5
SCALE: 3/4" = 1'-0"

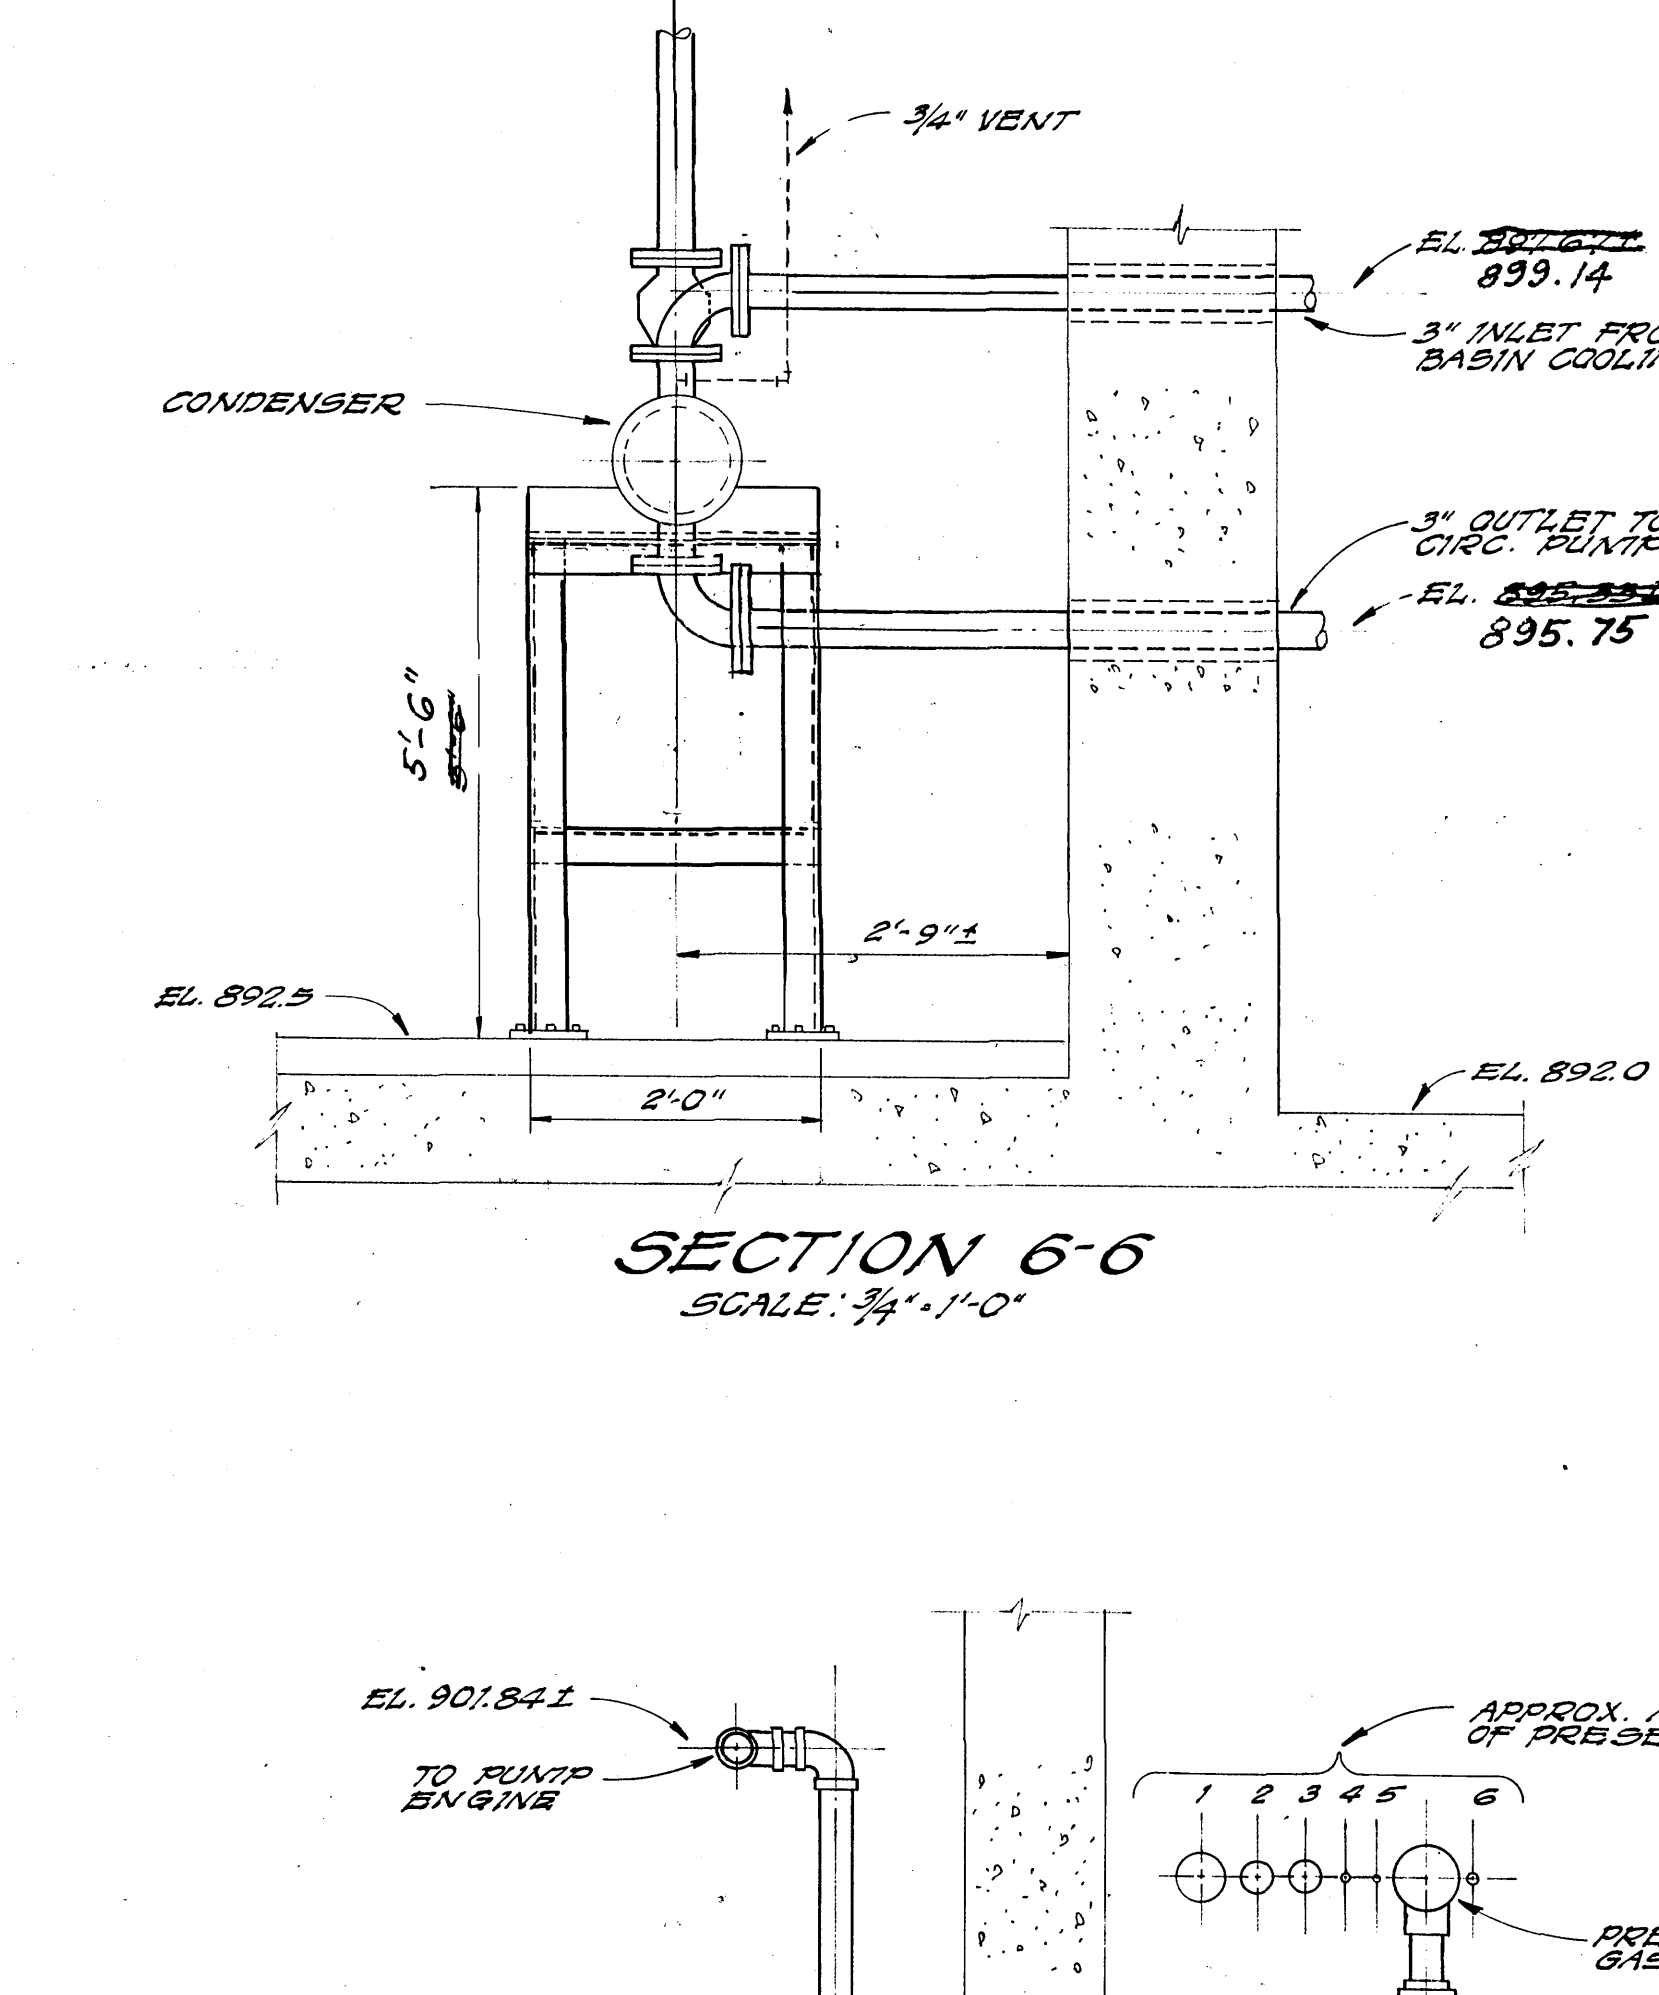





SECTION 6-6
SCALE: 3/4" = 1'-0"

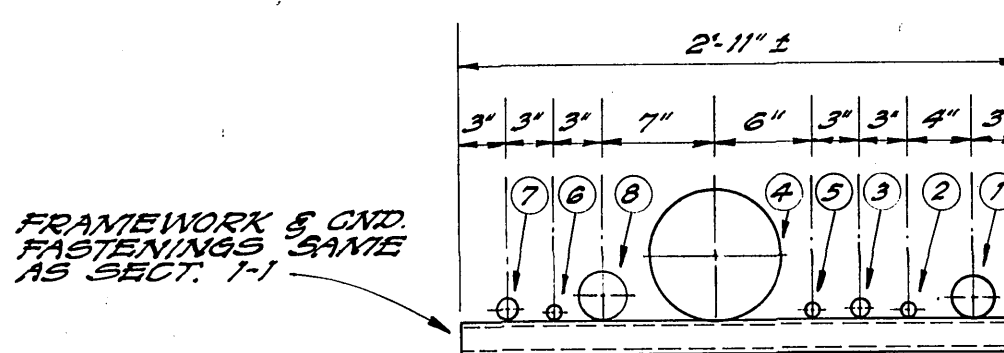

SECTION 2-2
SCALE: 1/2" = 1'-0"

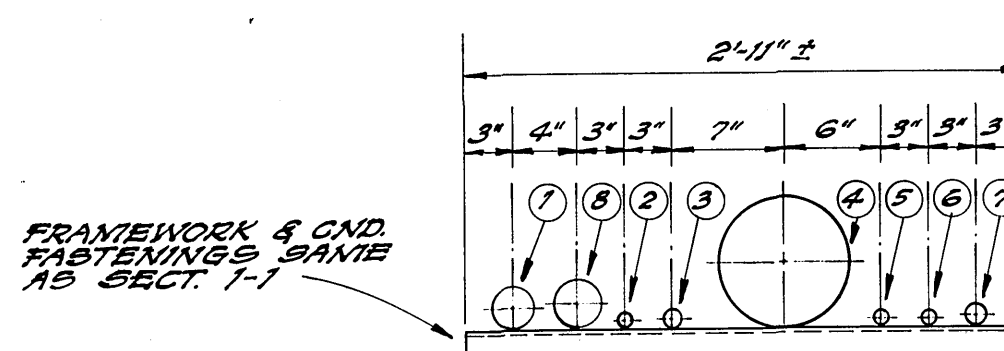

SECTION 3-3
SCALE: 1/2" = 1'-0"

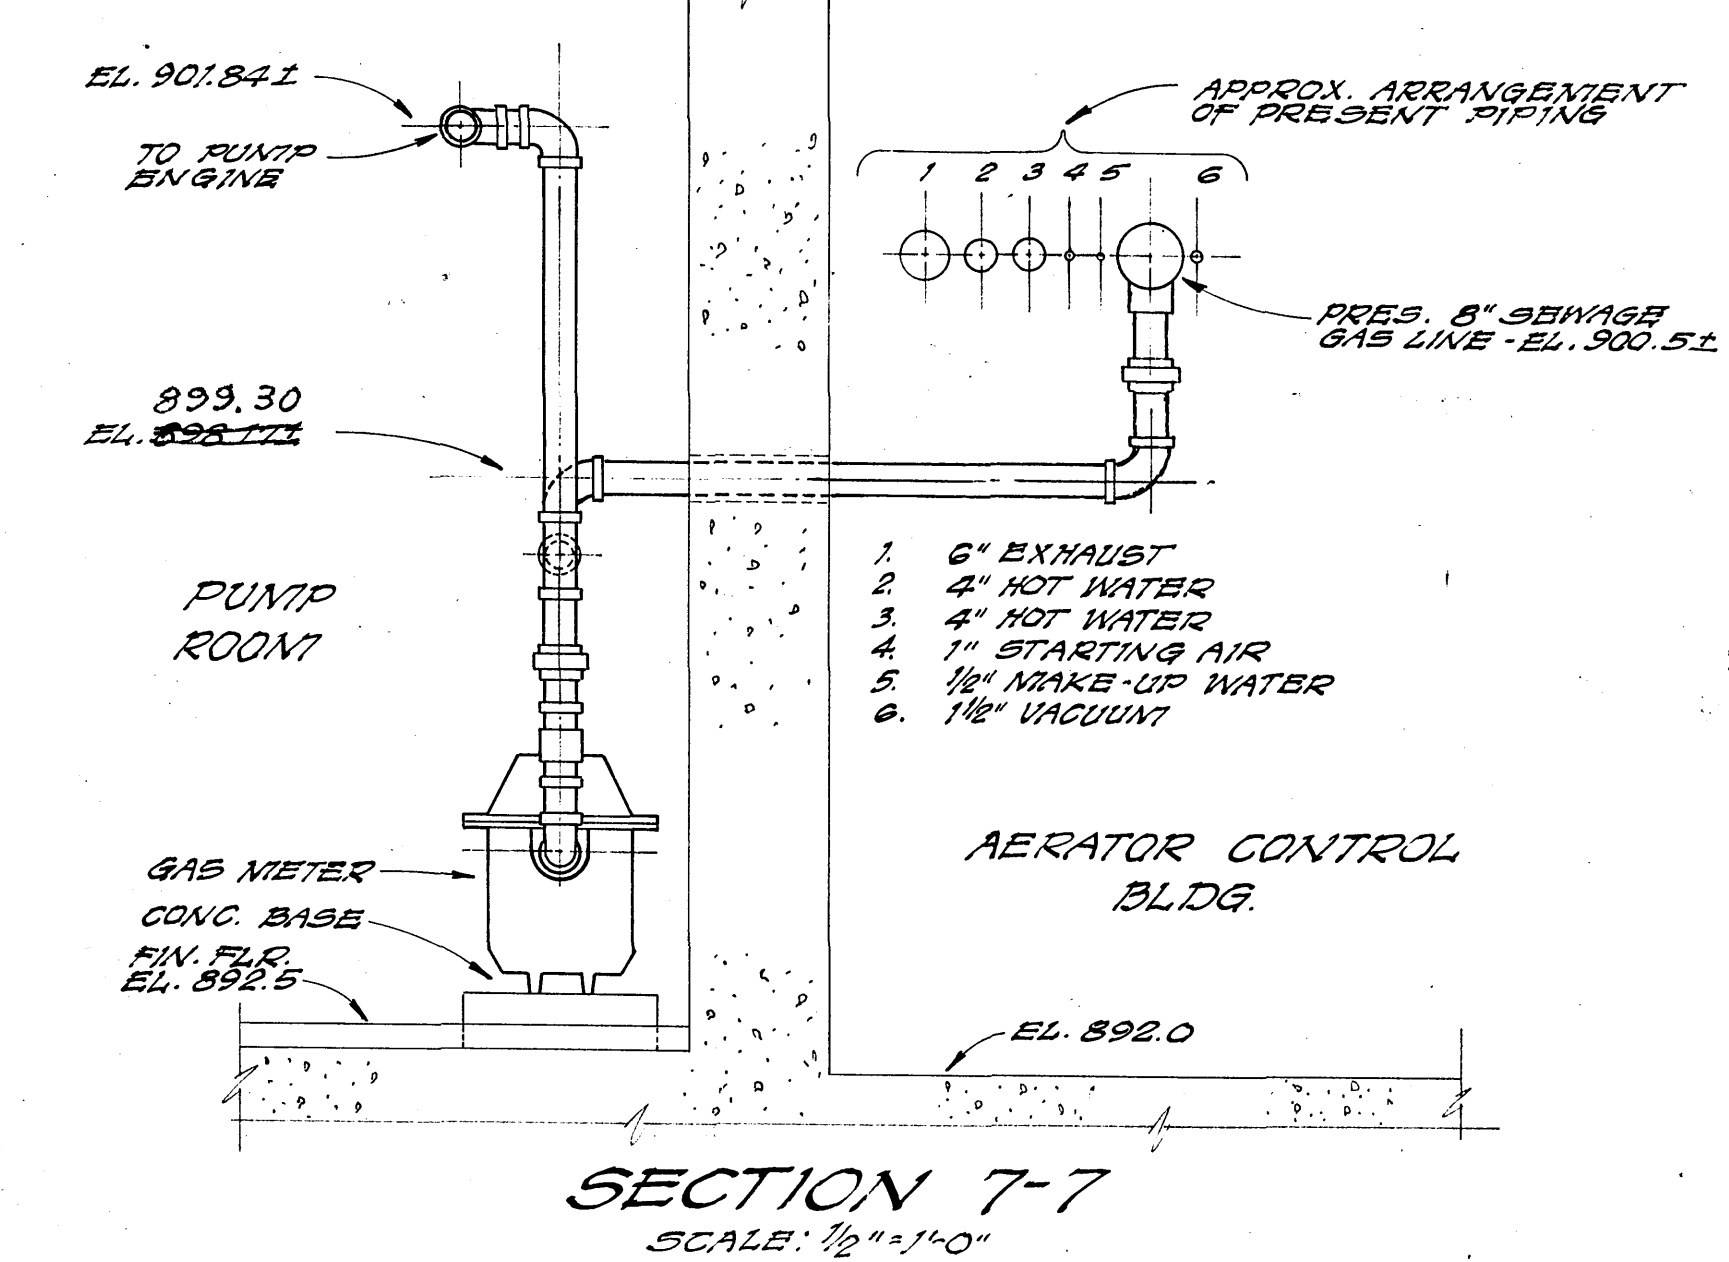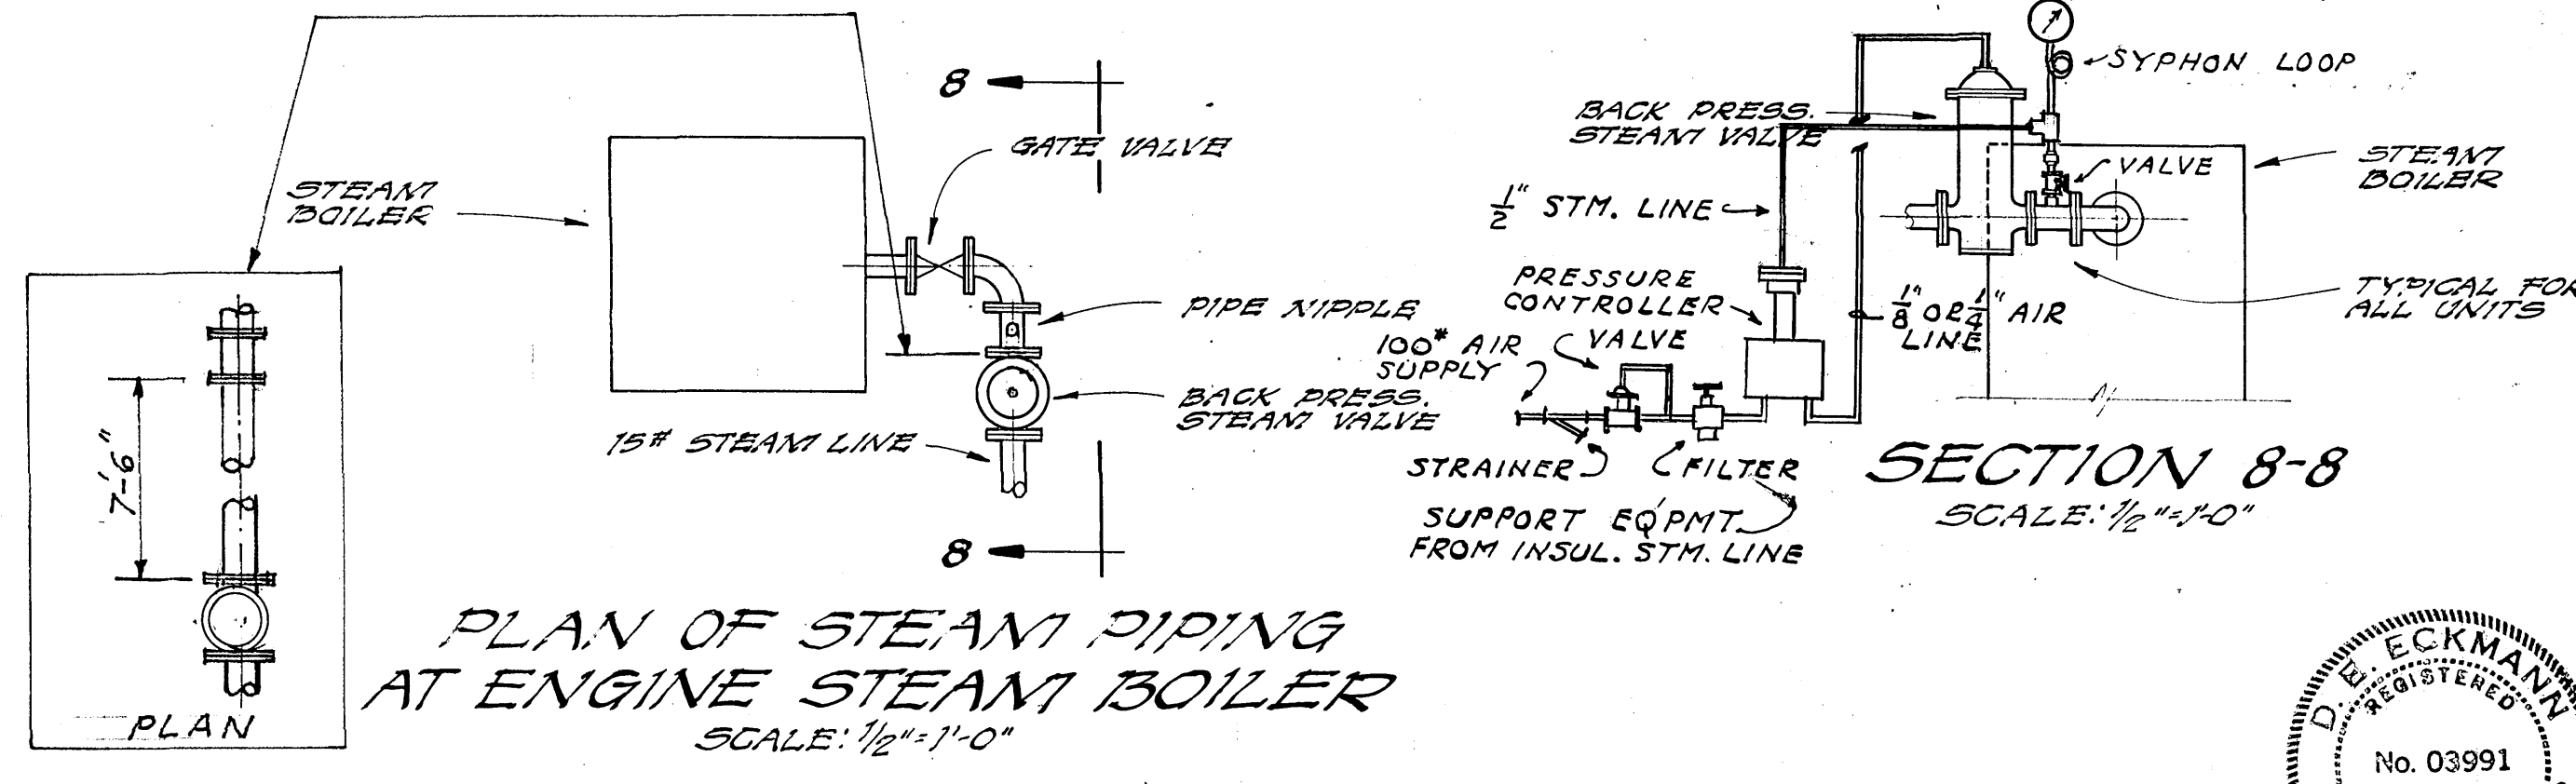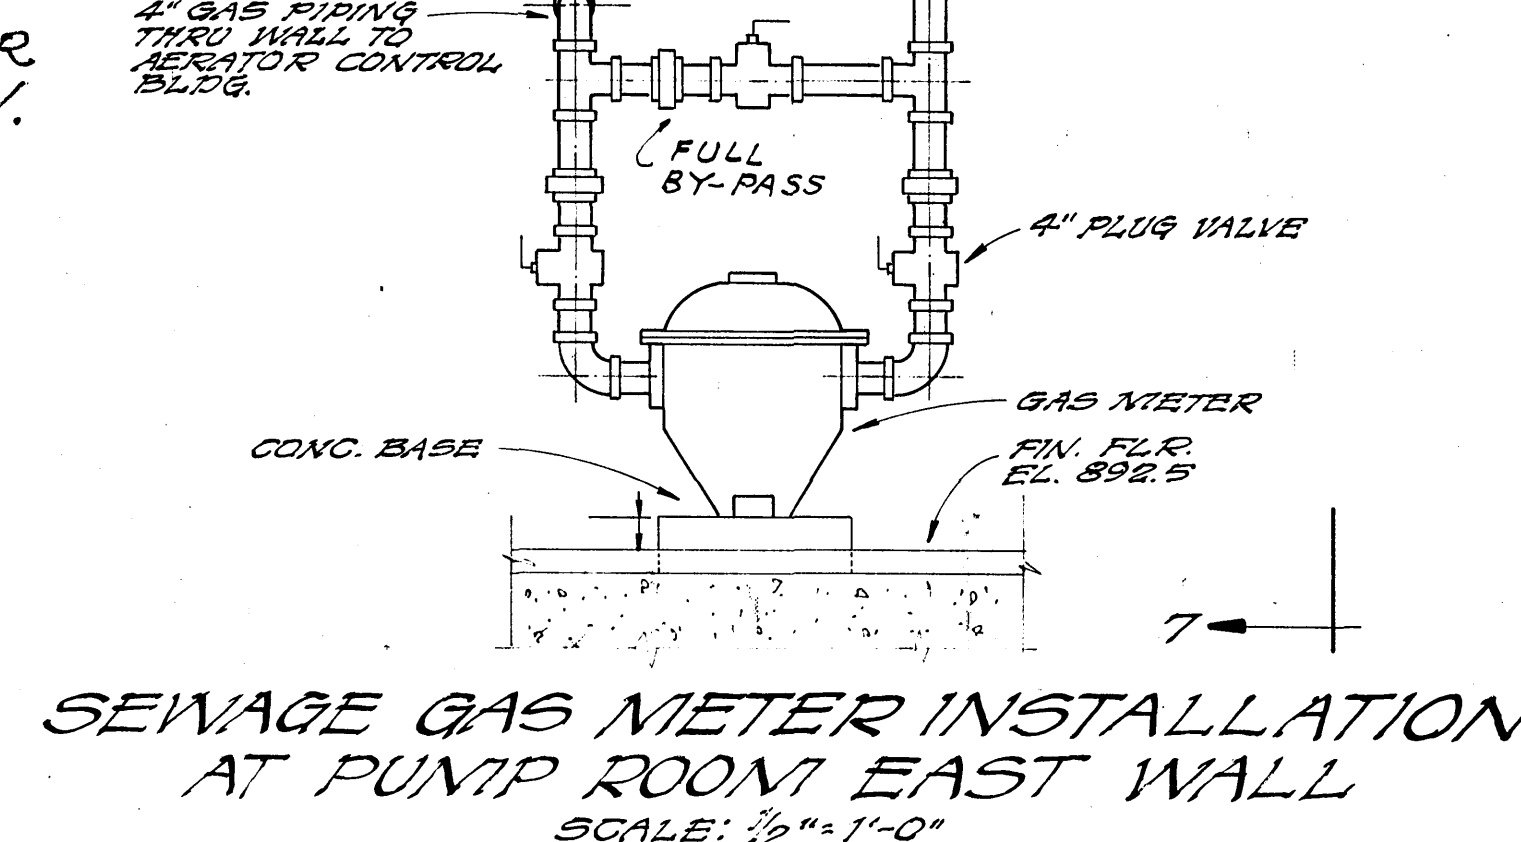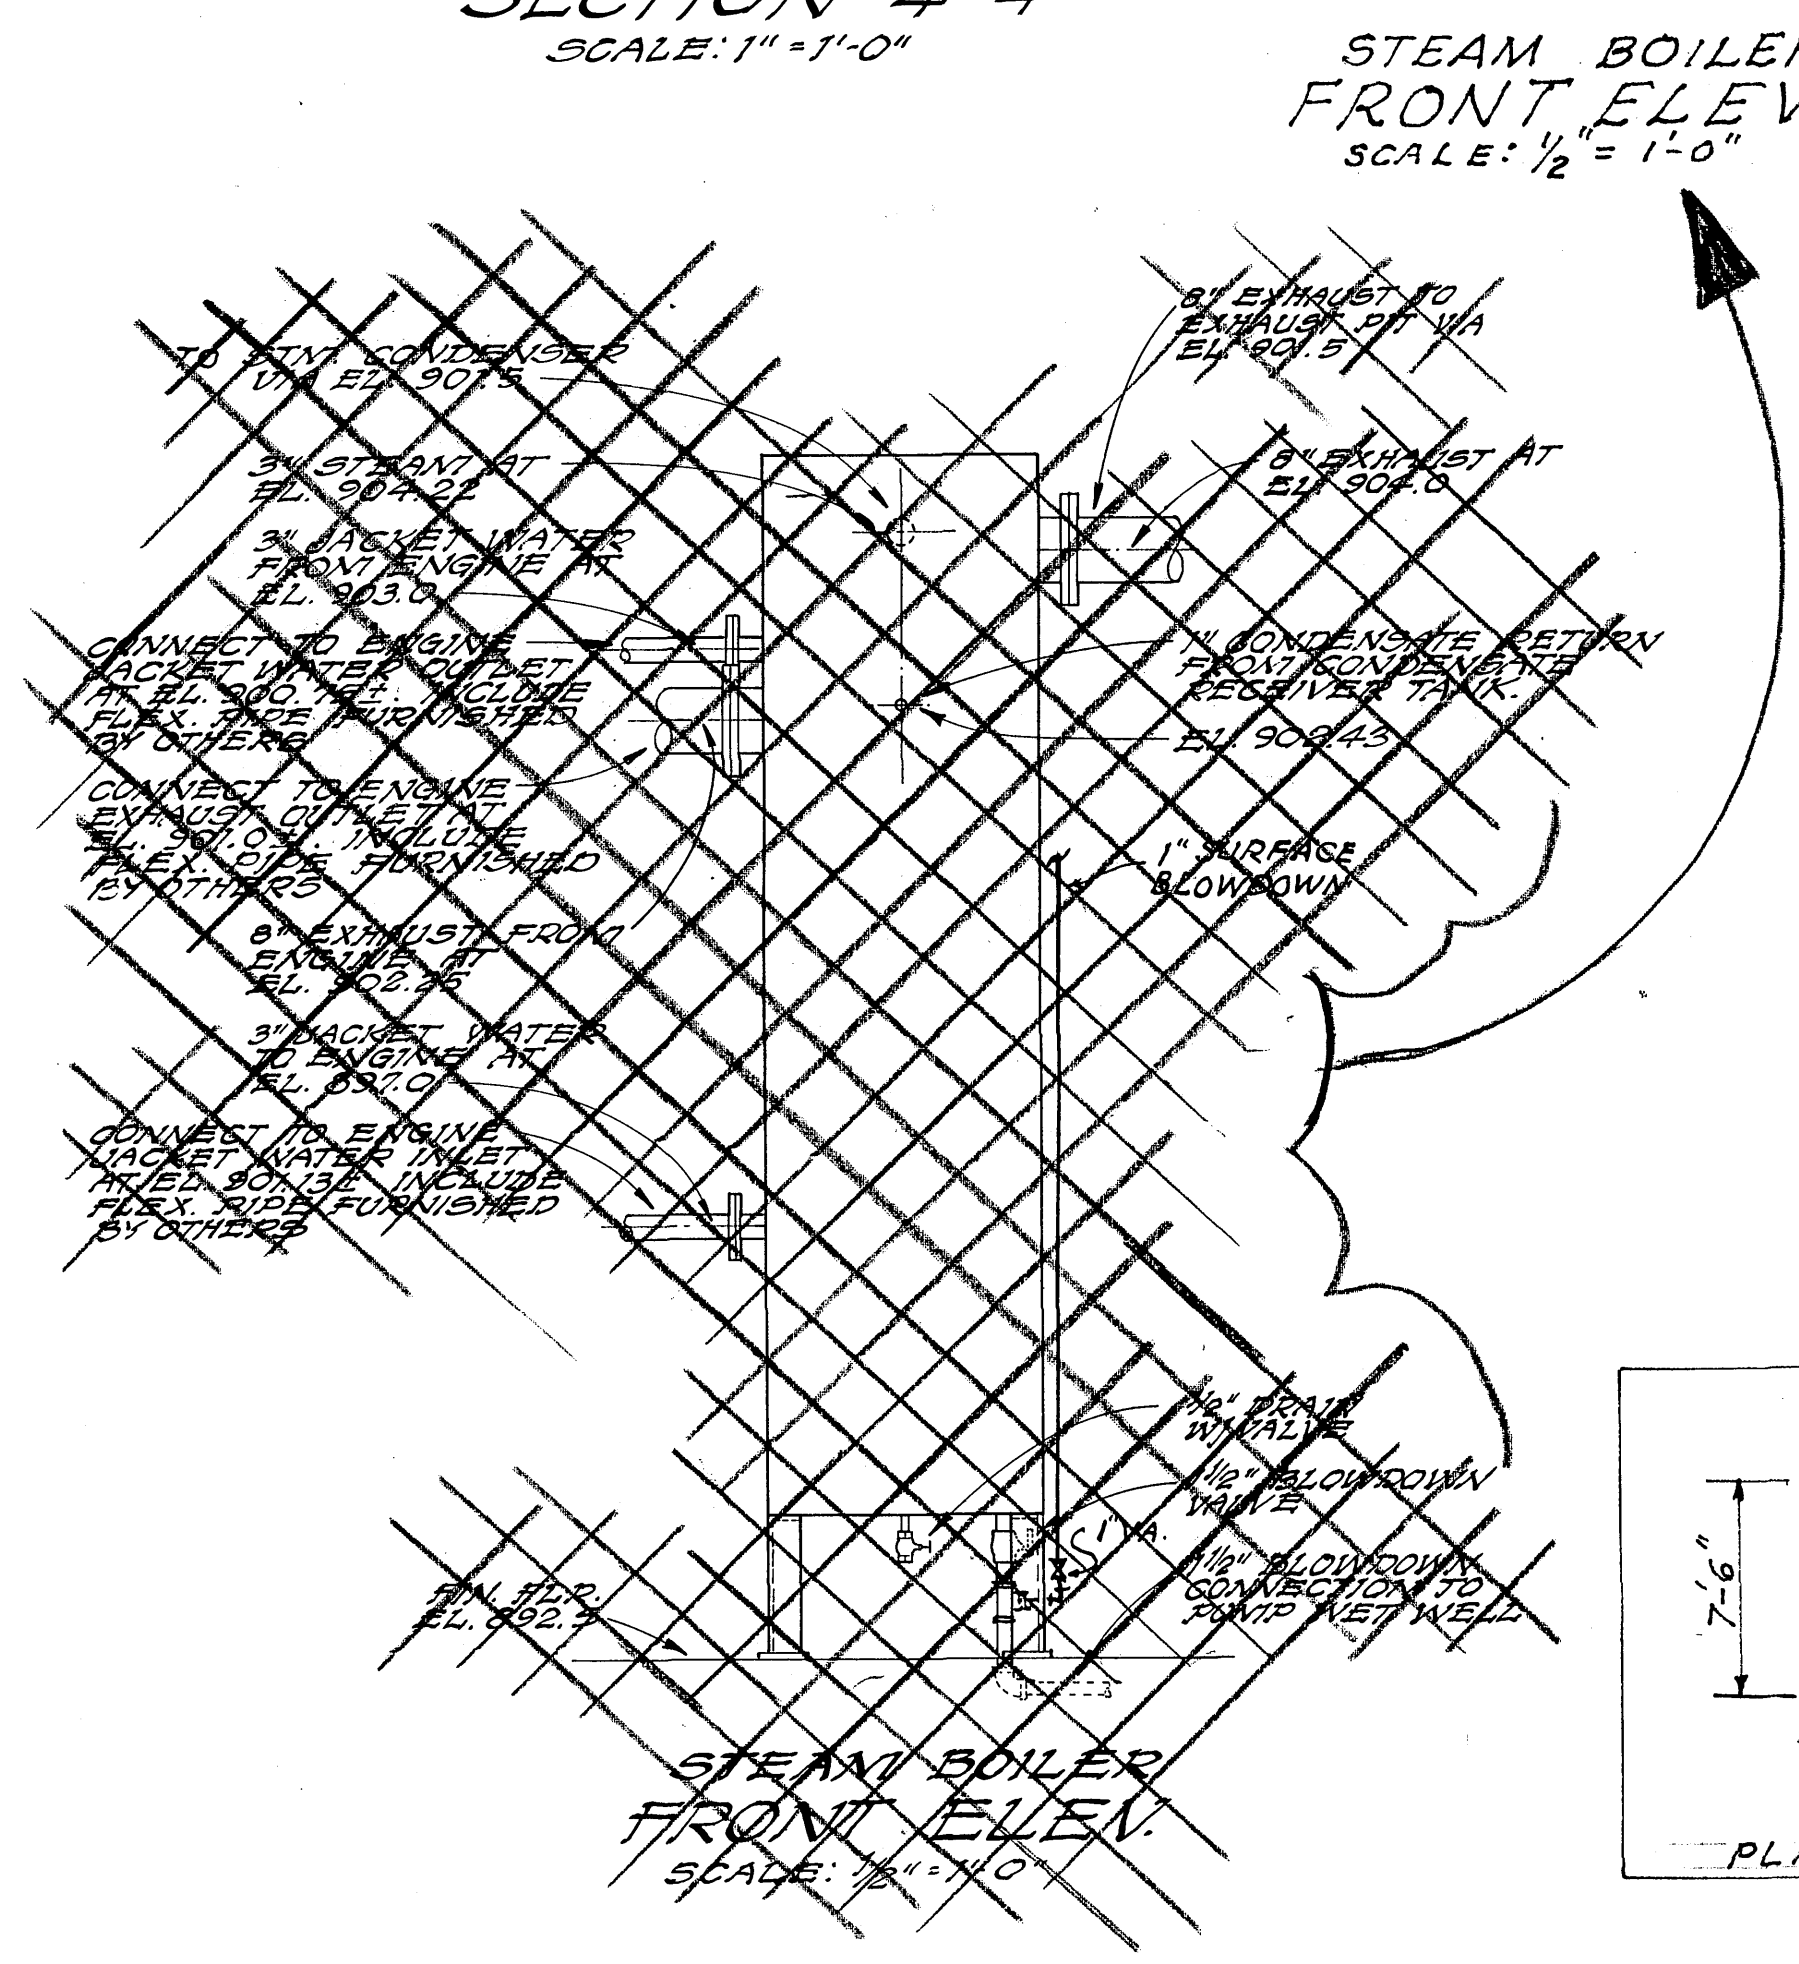

SECTION 7-7
SCALE: 1/2" = 1'-0"

AS BUILT
CONTR. "C"

25

ADDITIONS TO SEWAGE TREATMENT PLANT
ROANOKE, VIRGINIA
RAW SEWAGE PUMPING UNITS
DETAILS

ALVORD, BURDICK & HOWSON
ENGINEERS CHICAGO

1973

REVISED 5/16/74