


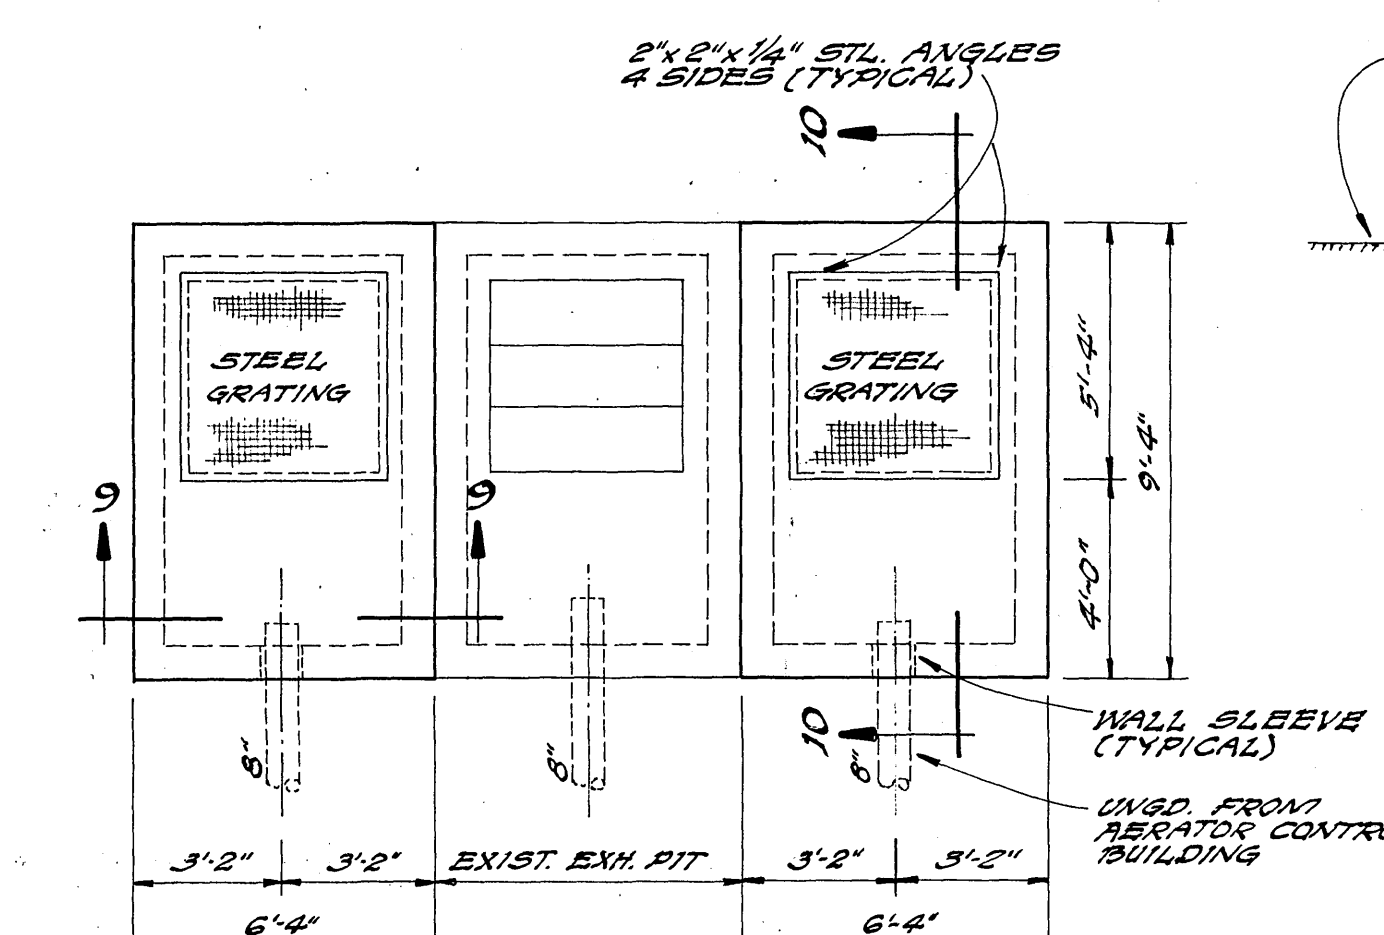
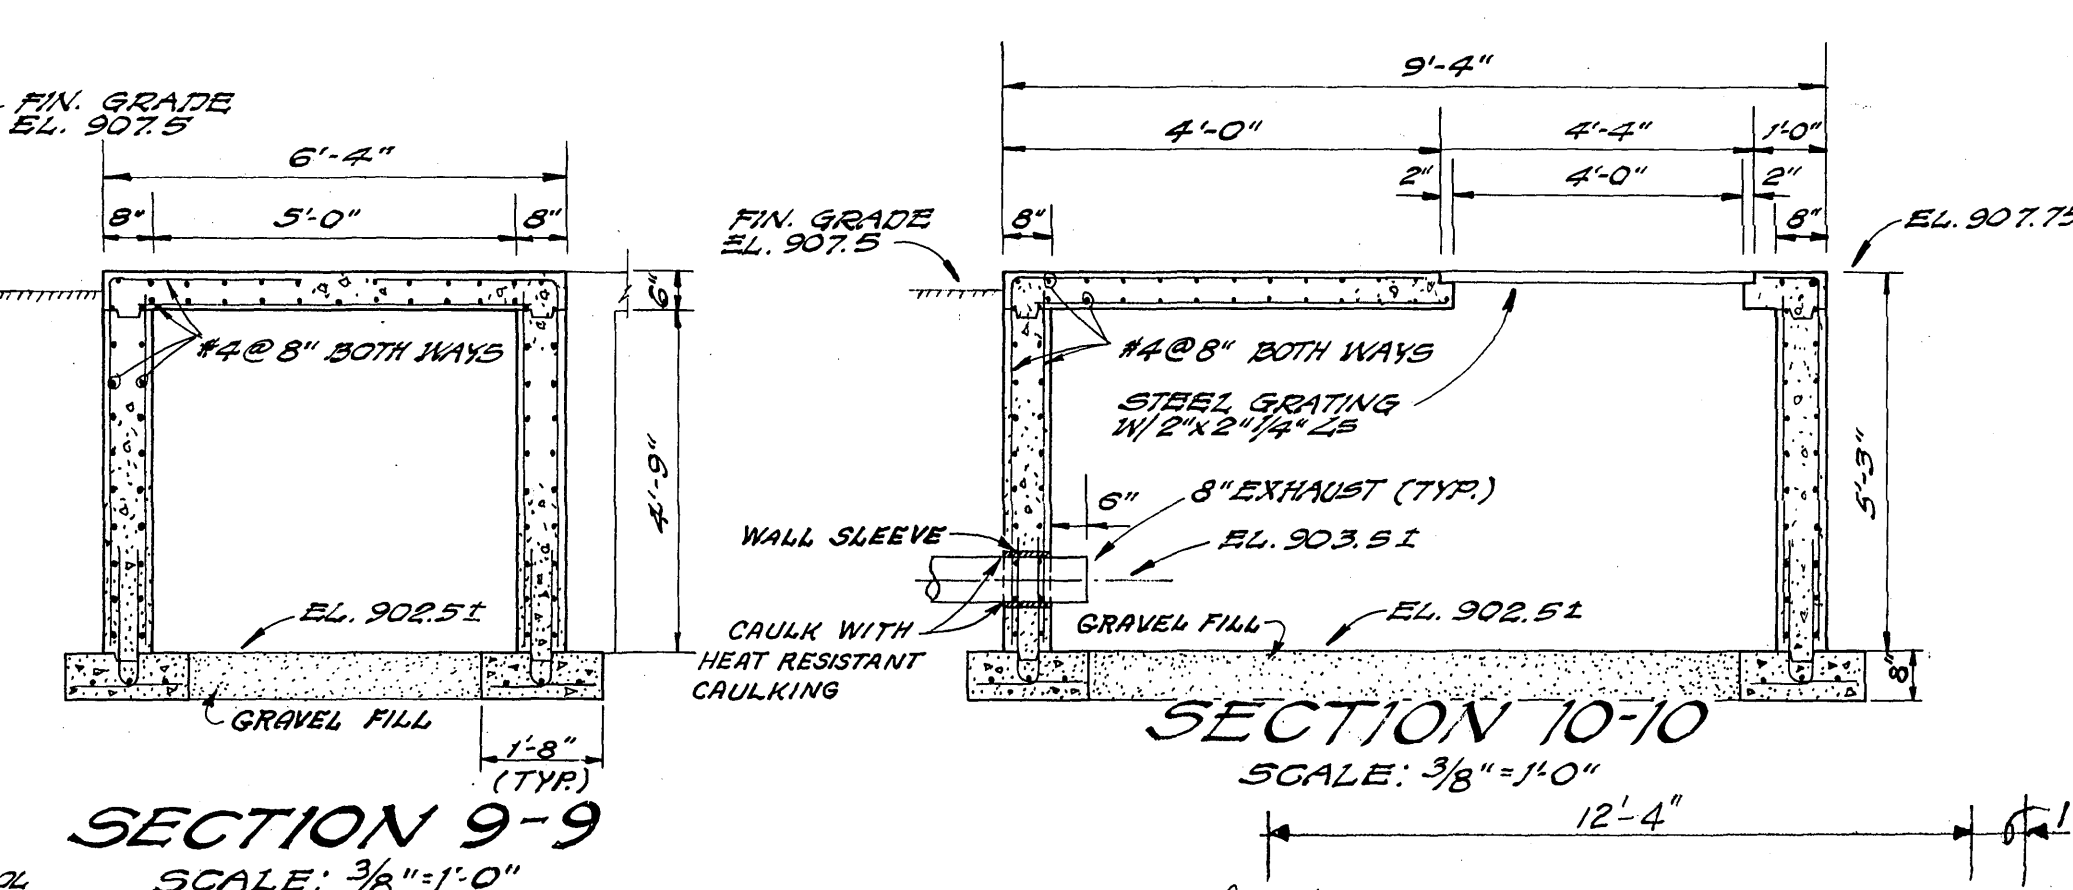
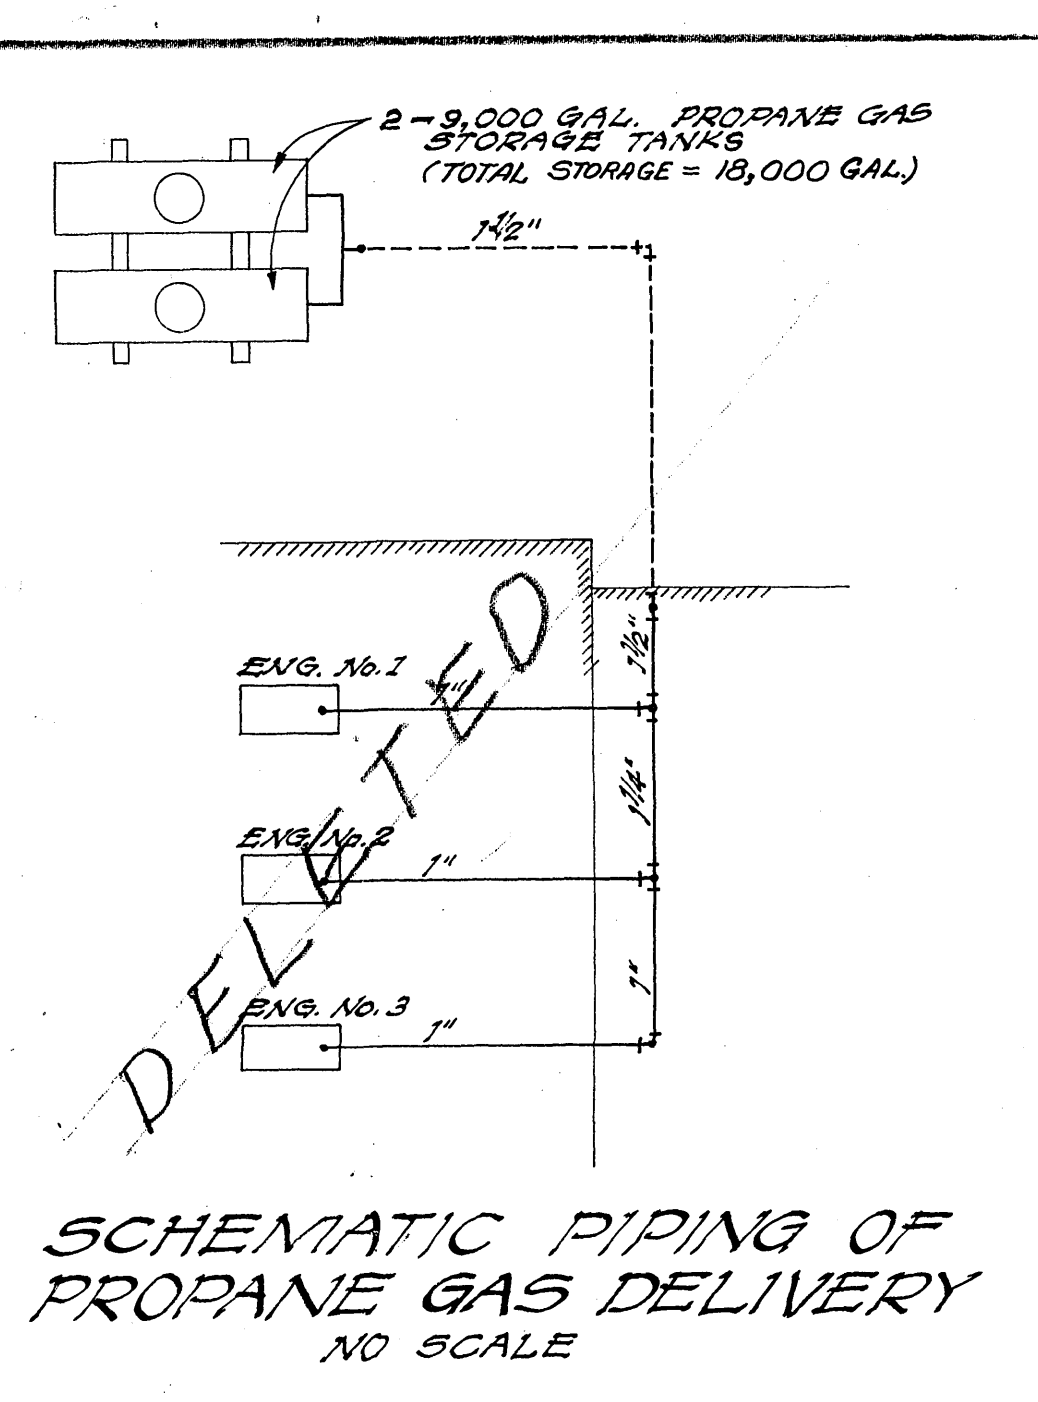


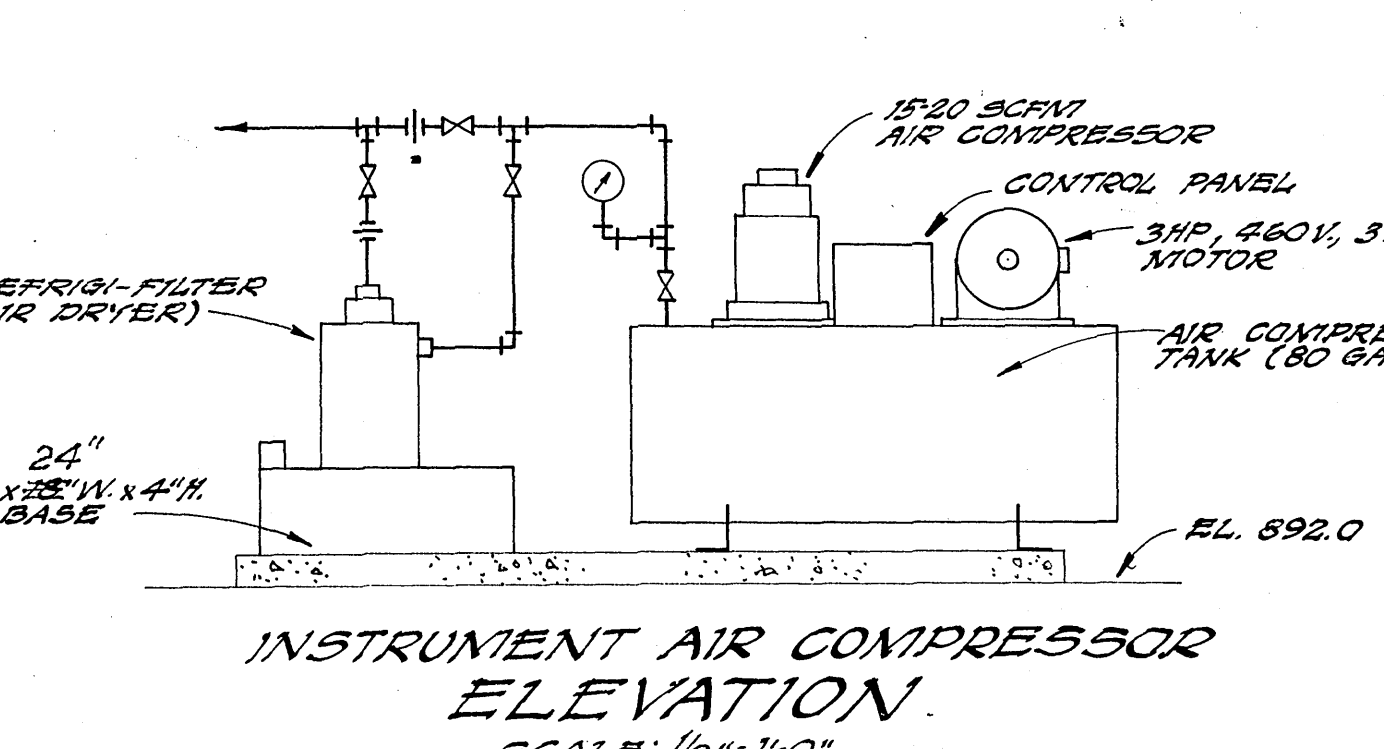


PLAN OF ENGINE EXHAUST PIT
SCALE: 1/4"=1'-0"

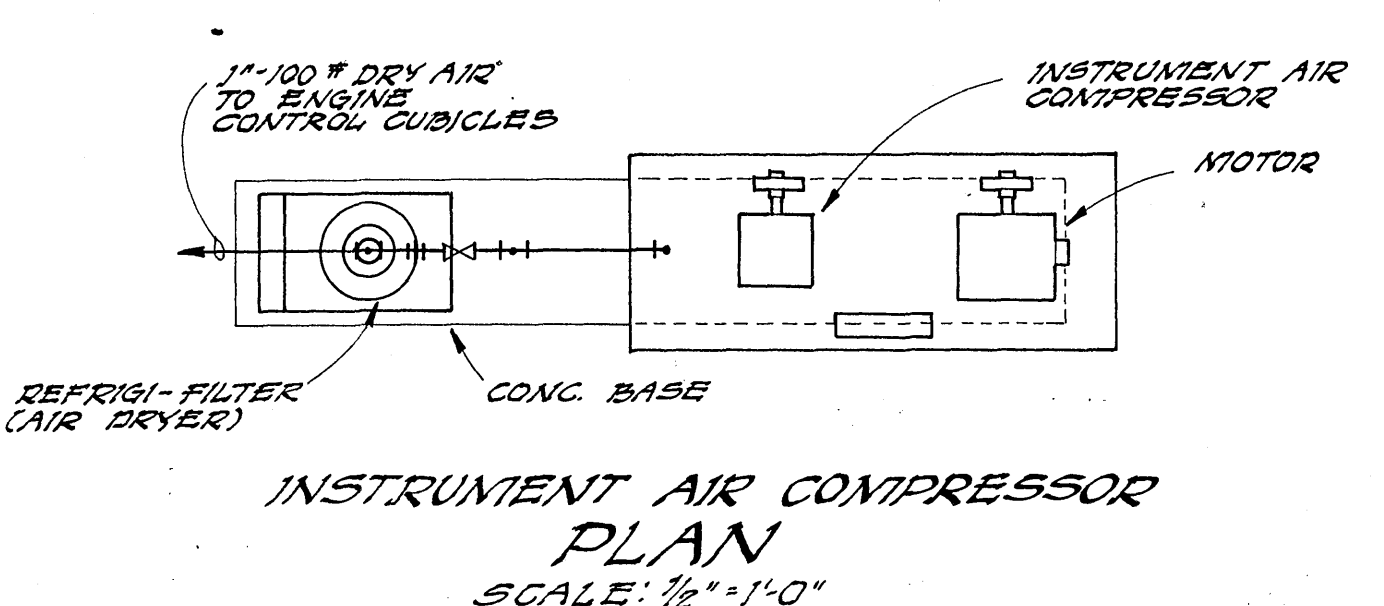

SECTION 9-9
SCALE: 3/8"=1'-0"

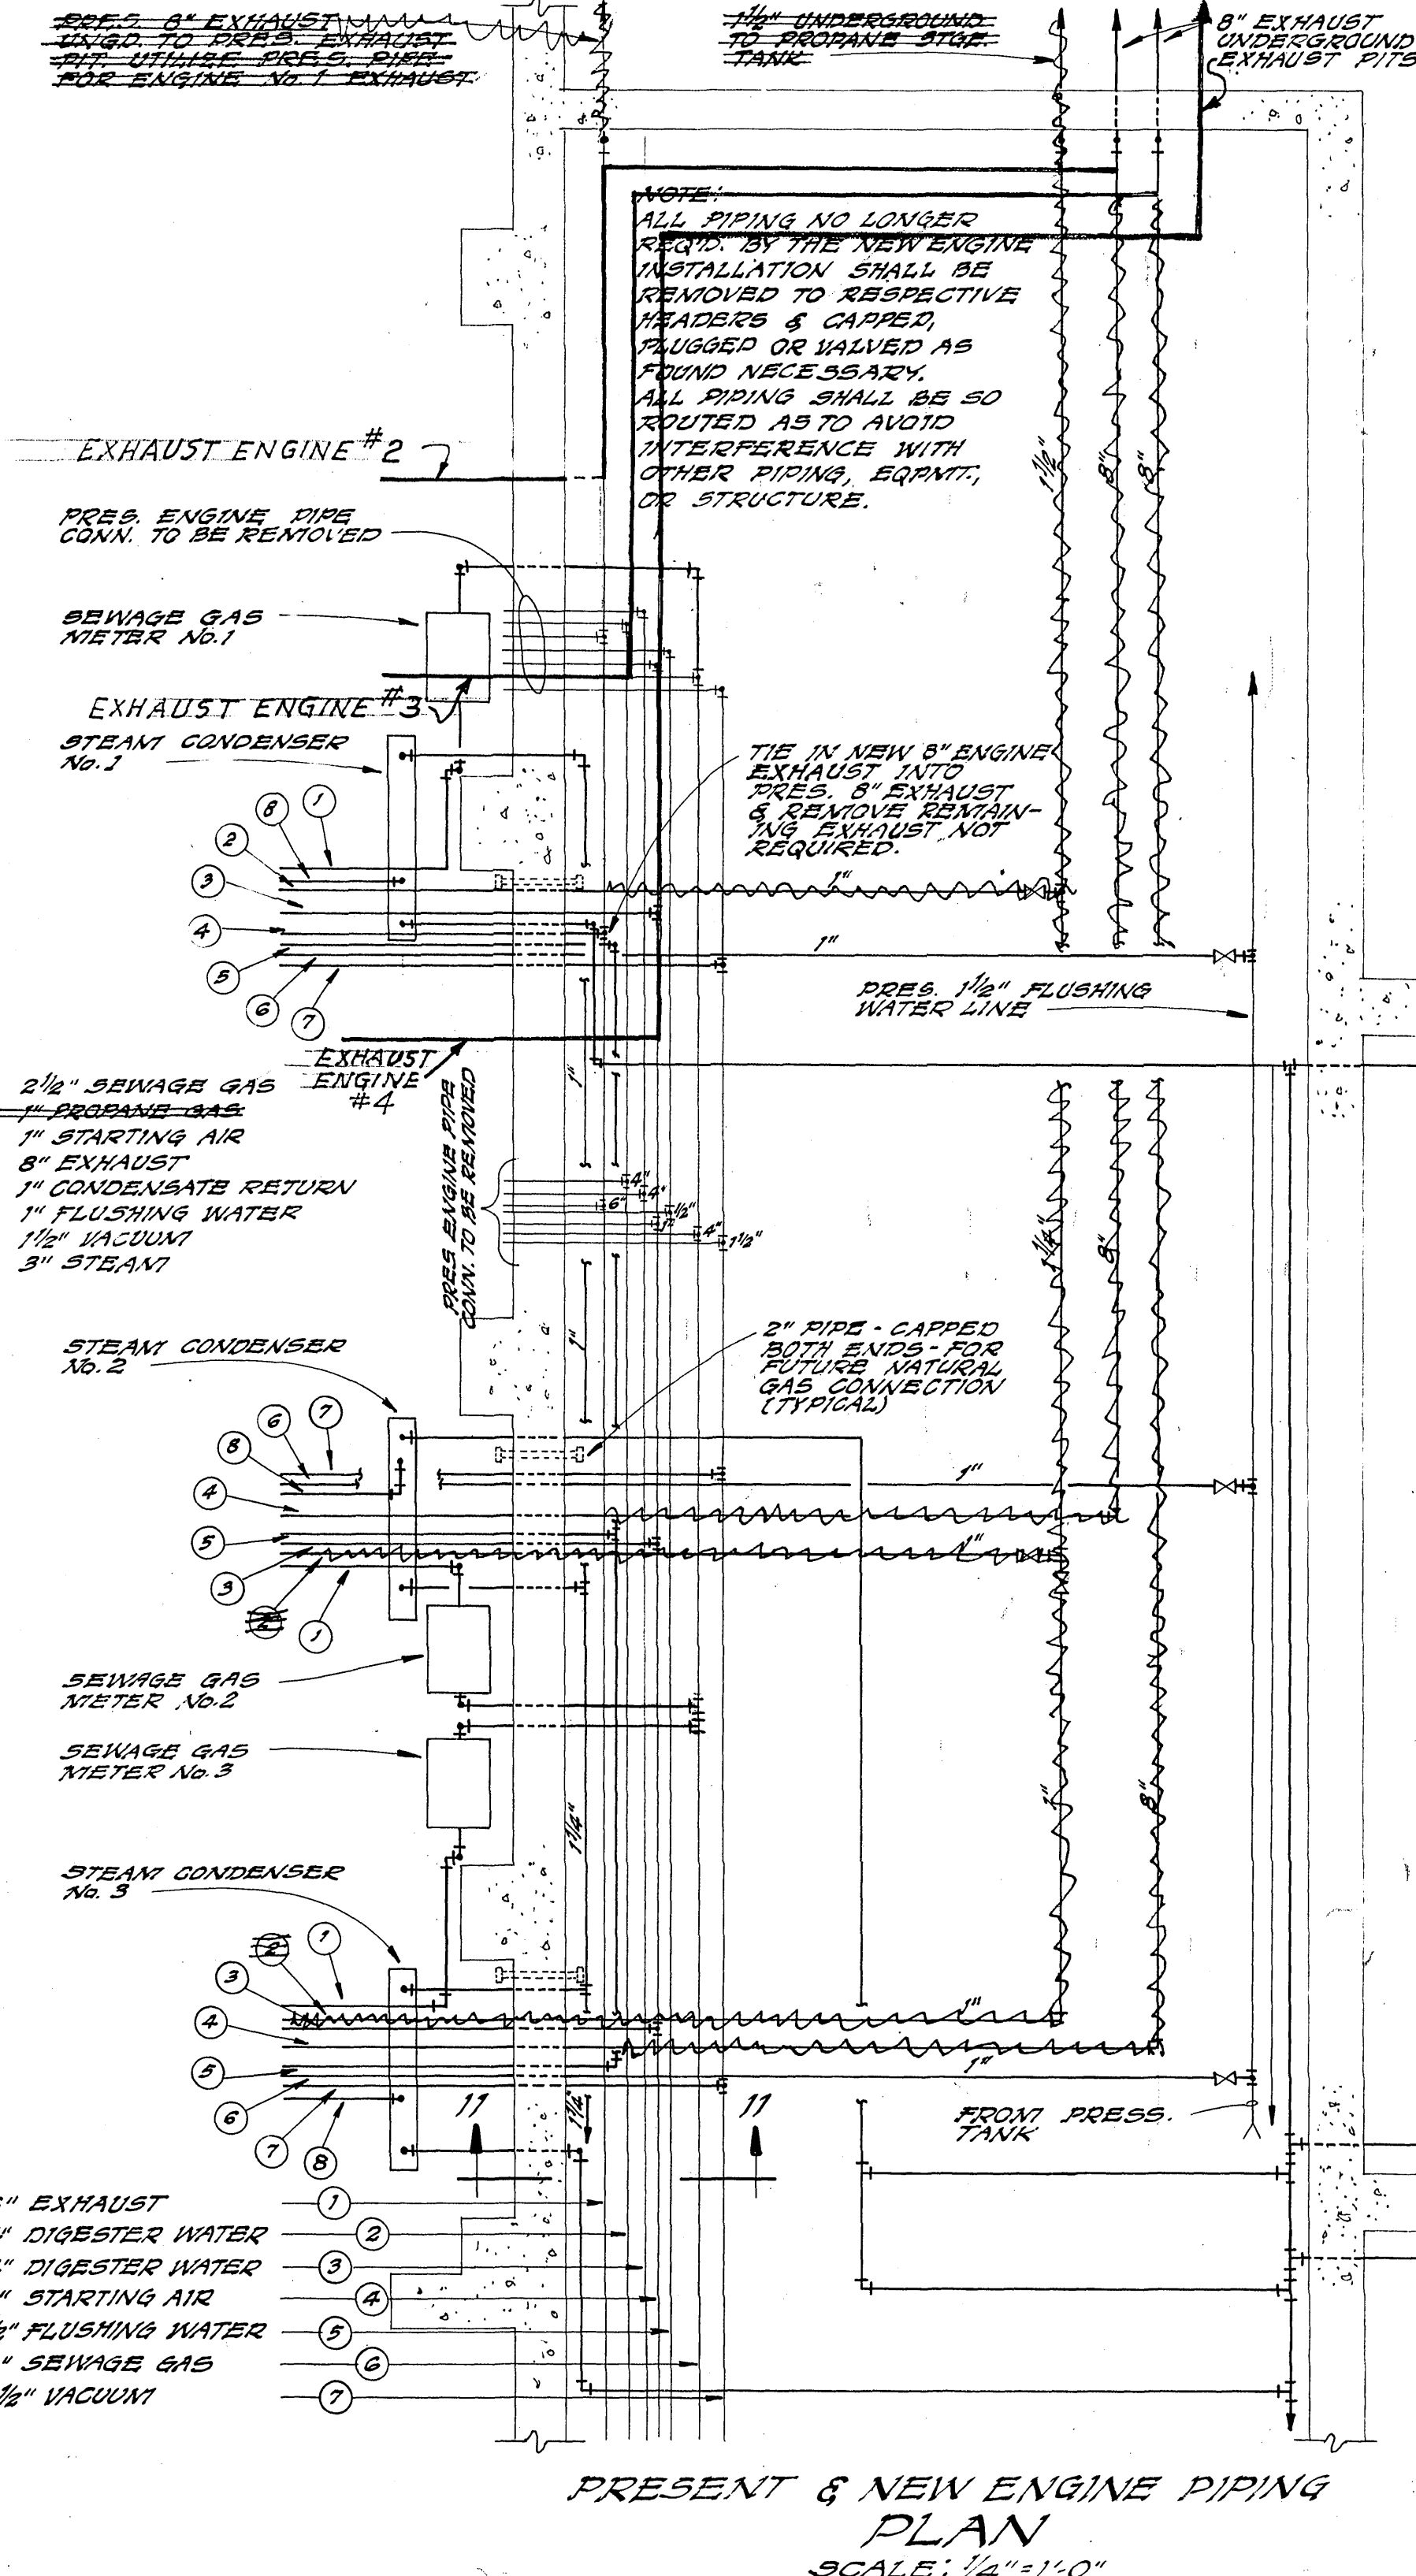


PRESENT & NEW ENGINE PIPING
PLAN
SCALE: 1/4"=1'-0"

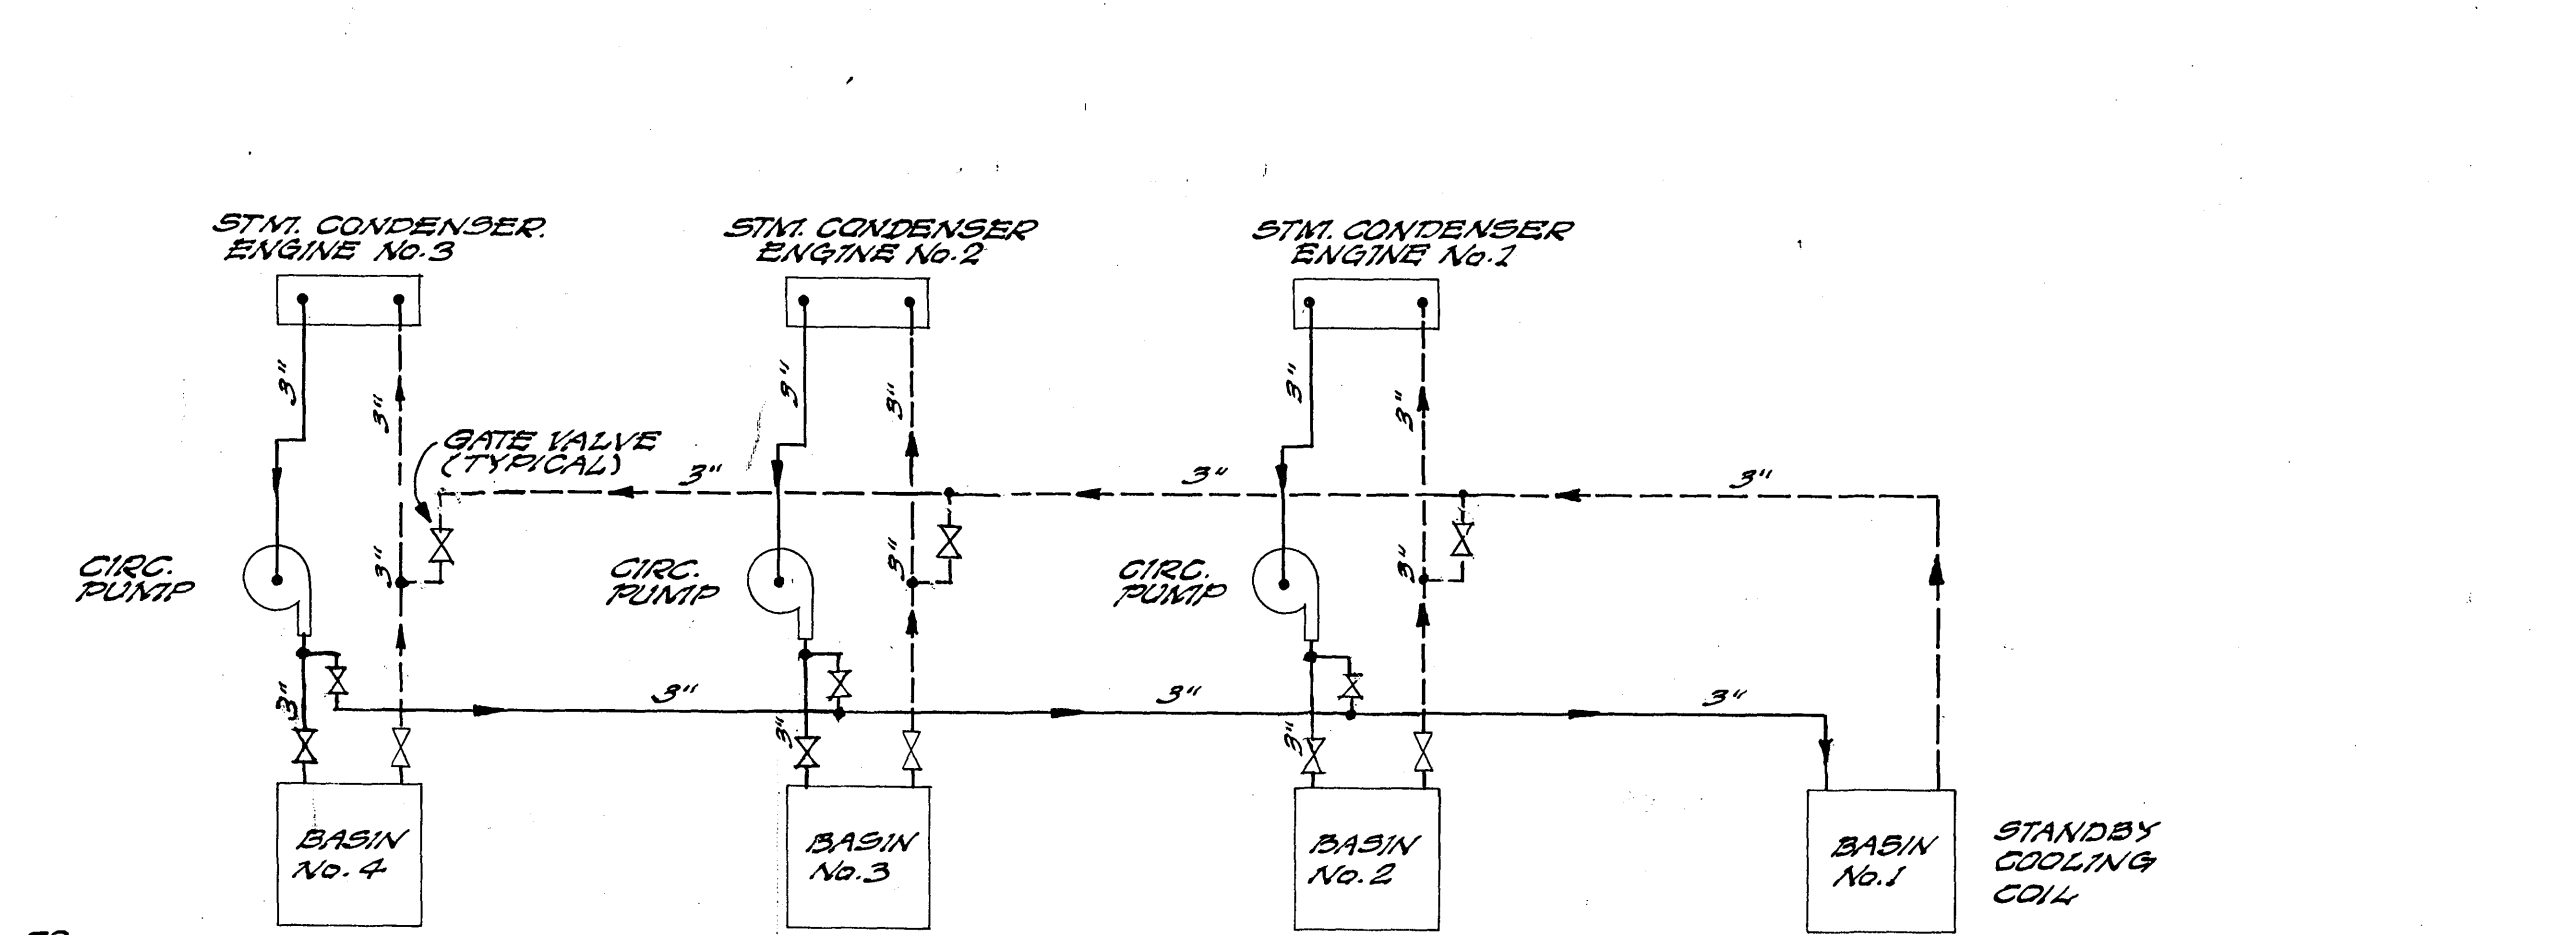


SCHEMATIC OF ENGINE JACKET WATER AND
EXHAUST AUXILIARY WASTE HEAT COOLING SYSTEM


NOTE: SEE SHEET 27-A "AS BUILT"
FOR ADD'L. DETAILS.

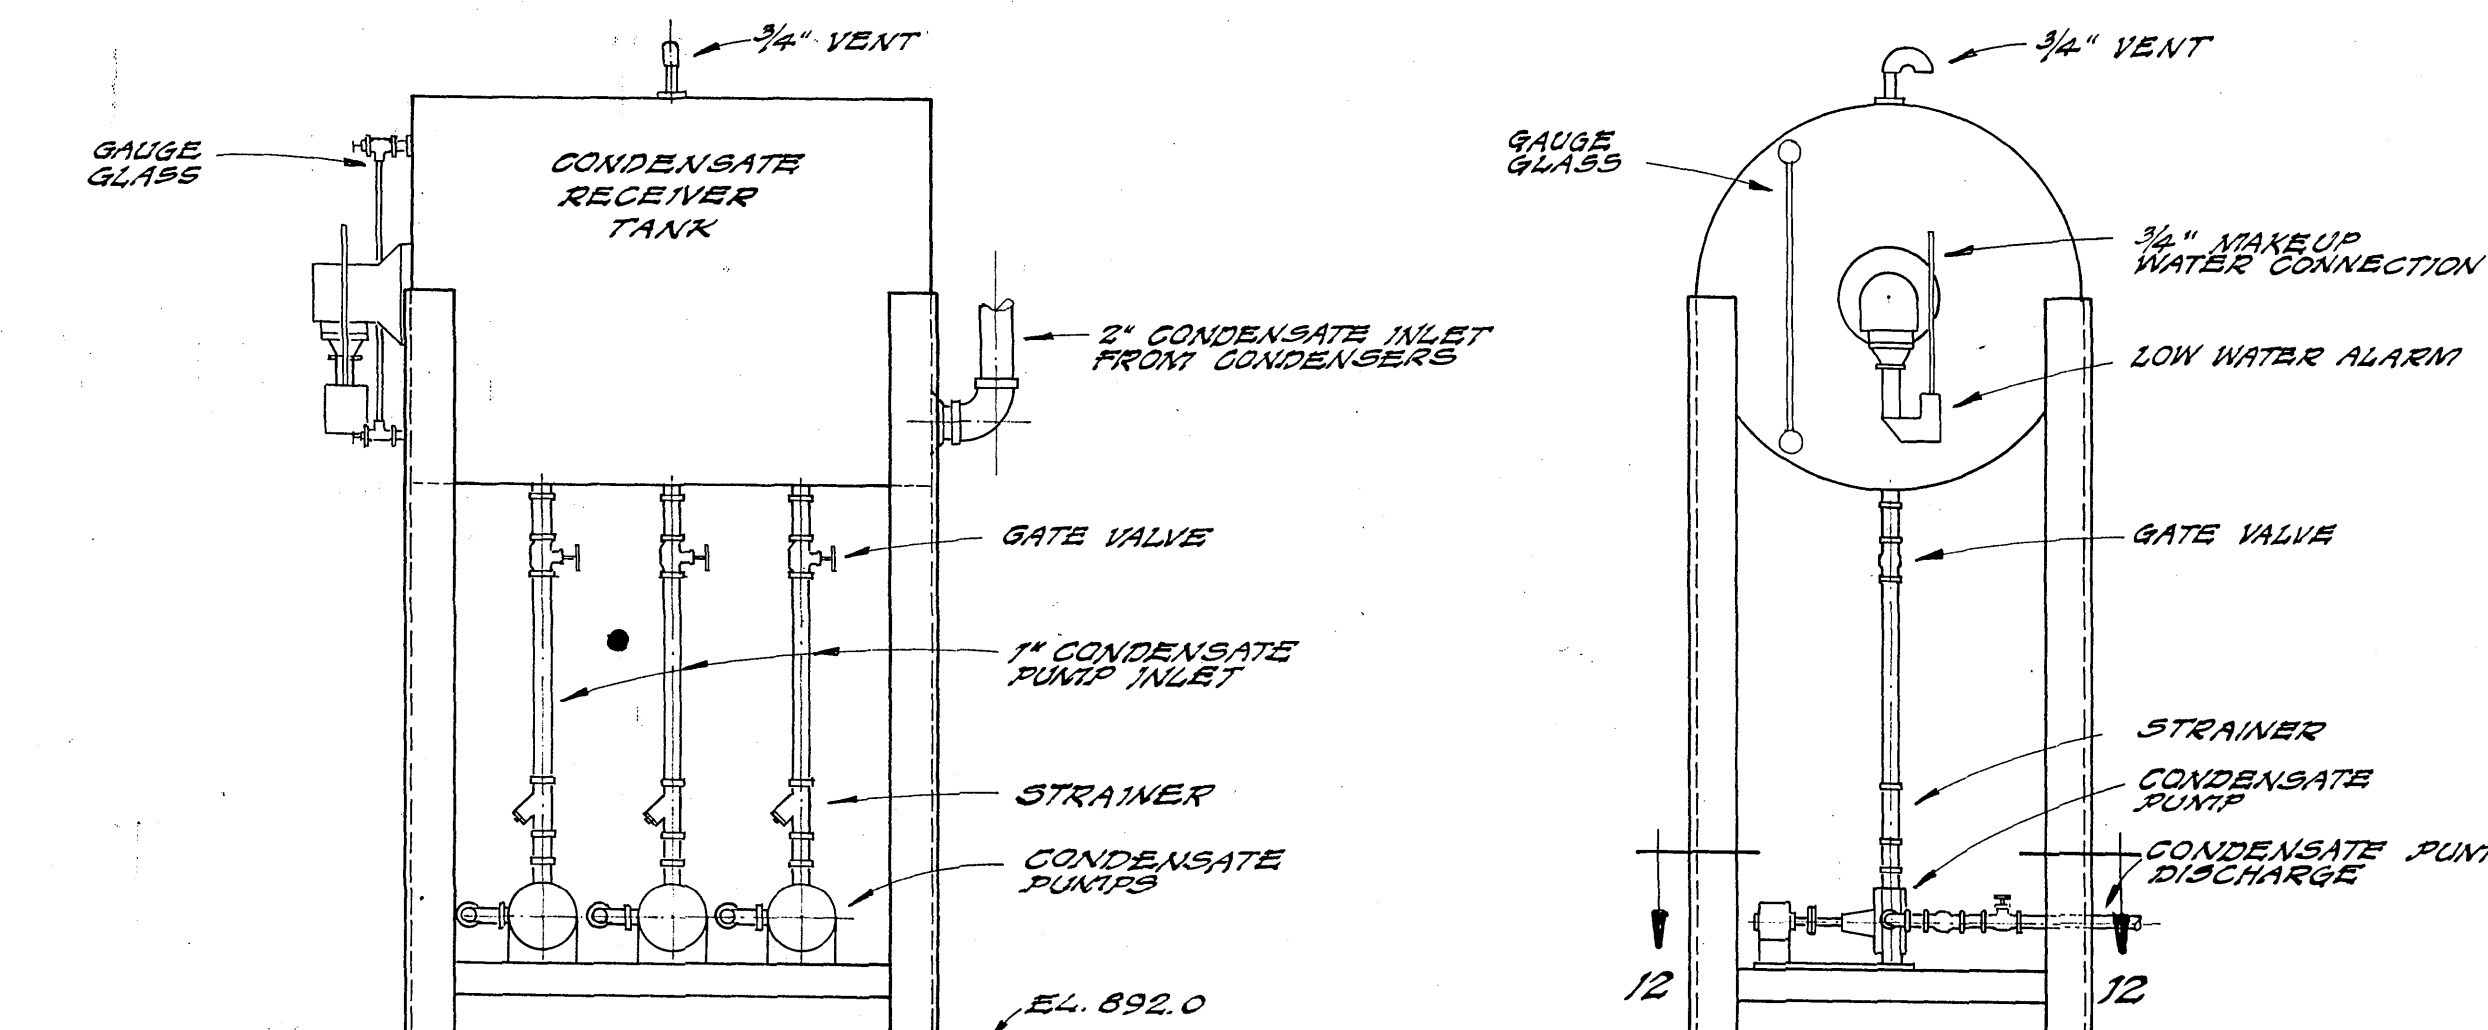


FRONT ELEV.
CONDENSATE RECEIVER TANK
SCALE: 1"=1'-0"

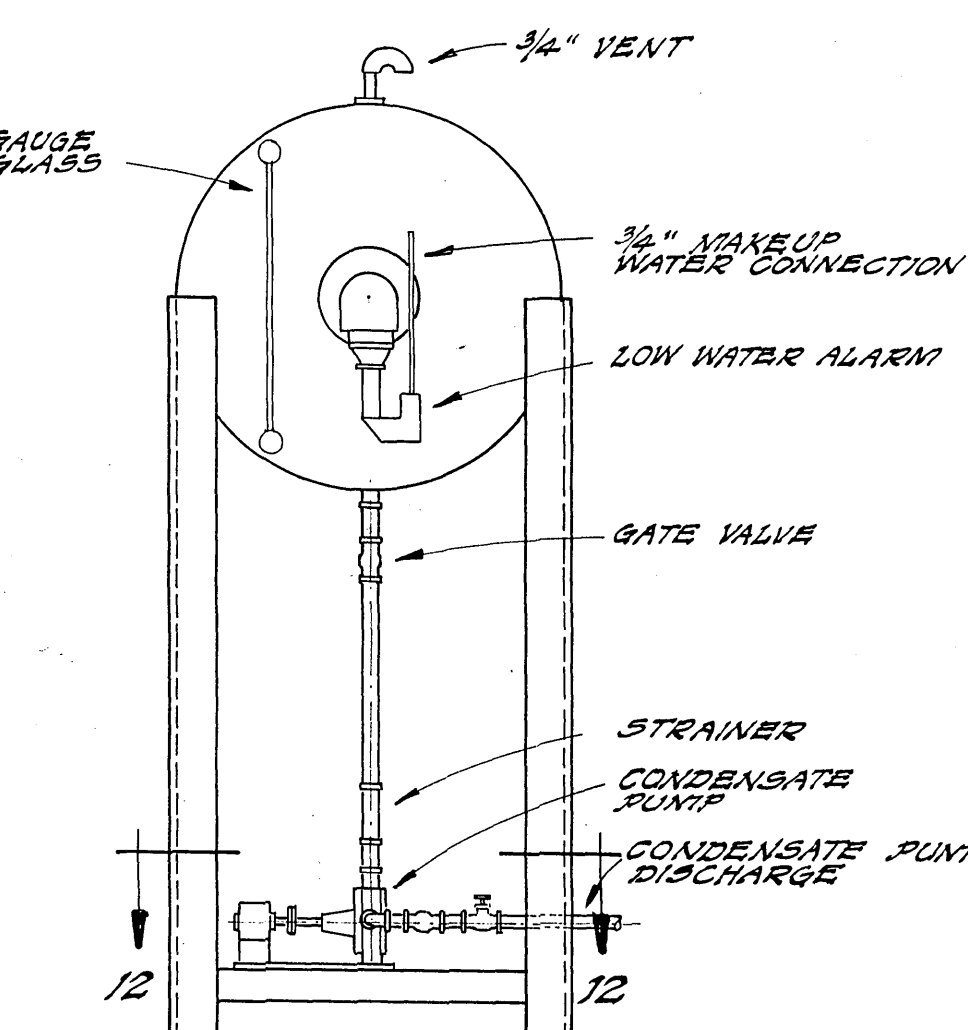

SIDE ELEV.

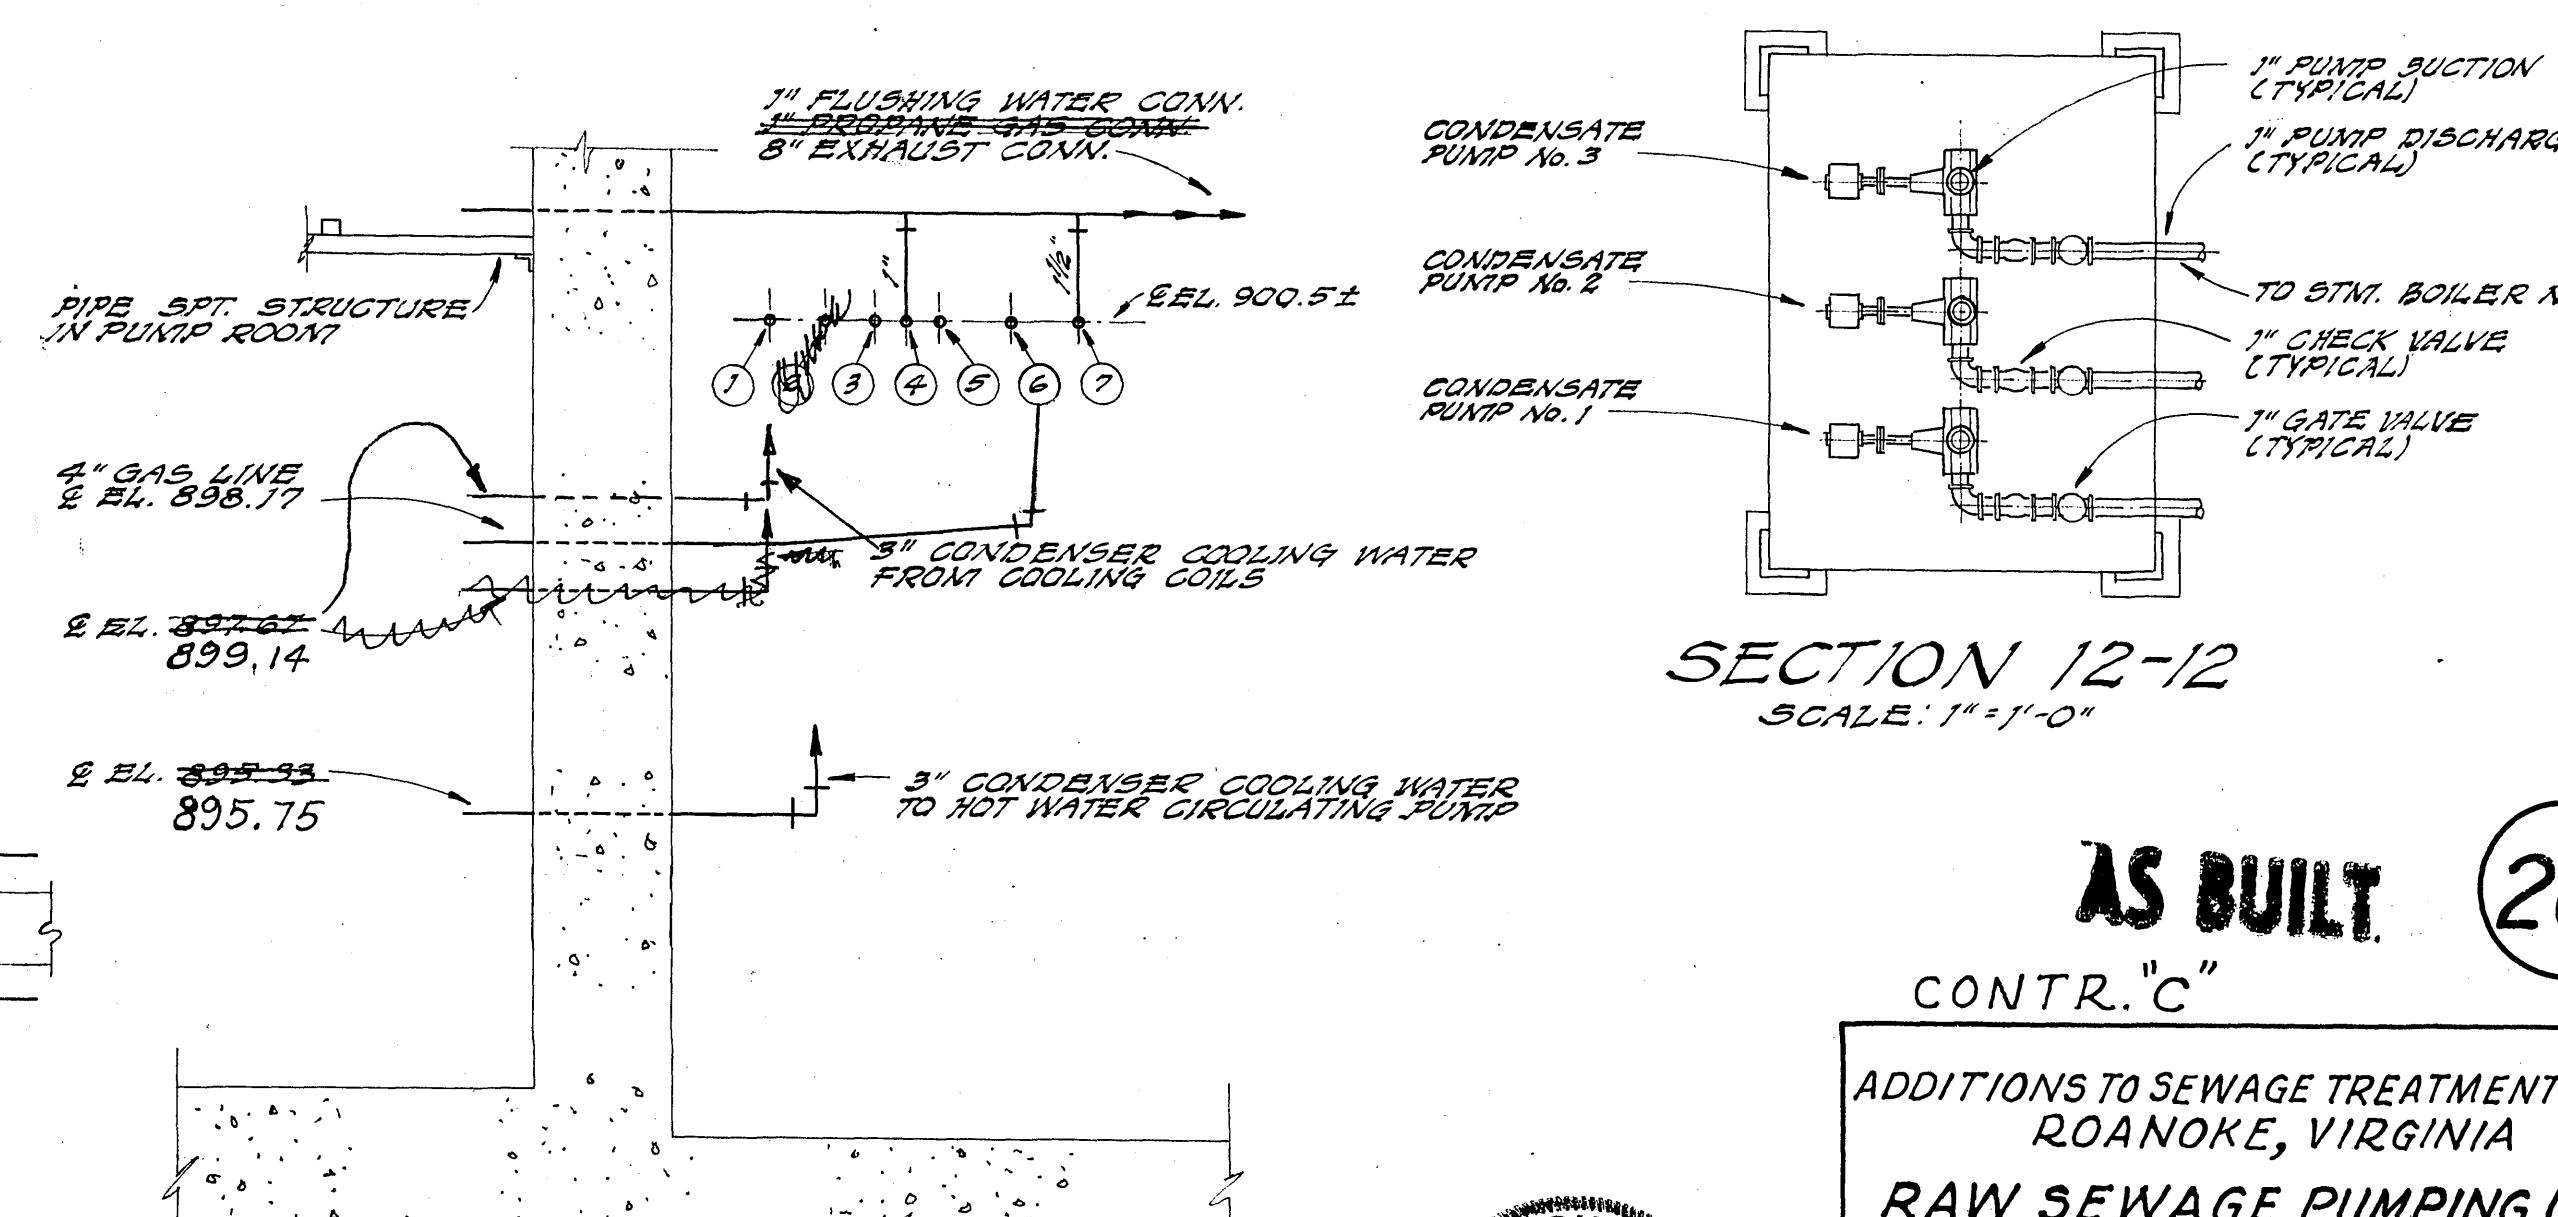

SECTION 11-11
SCALE: 1/2"=1'-0"

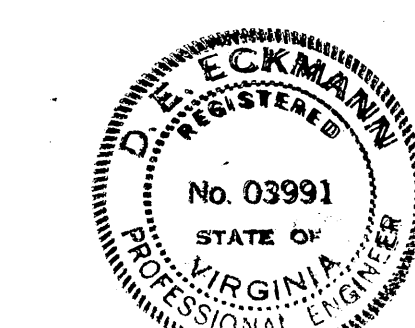

AS BUILT 26

CONTR. "C"
ADDITIONS TO SEWAGE TREATMENT PLANT
ROANOKE, VIRGINIA
RAW SEWAGE PUMPING UNITS
DETAILS

ALVORD, BURDICK & HOWSON
ENGINEERS CHICAGO

1973