




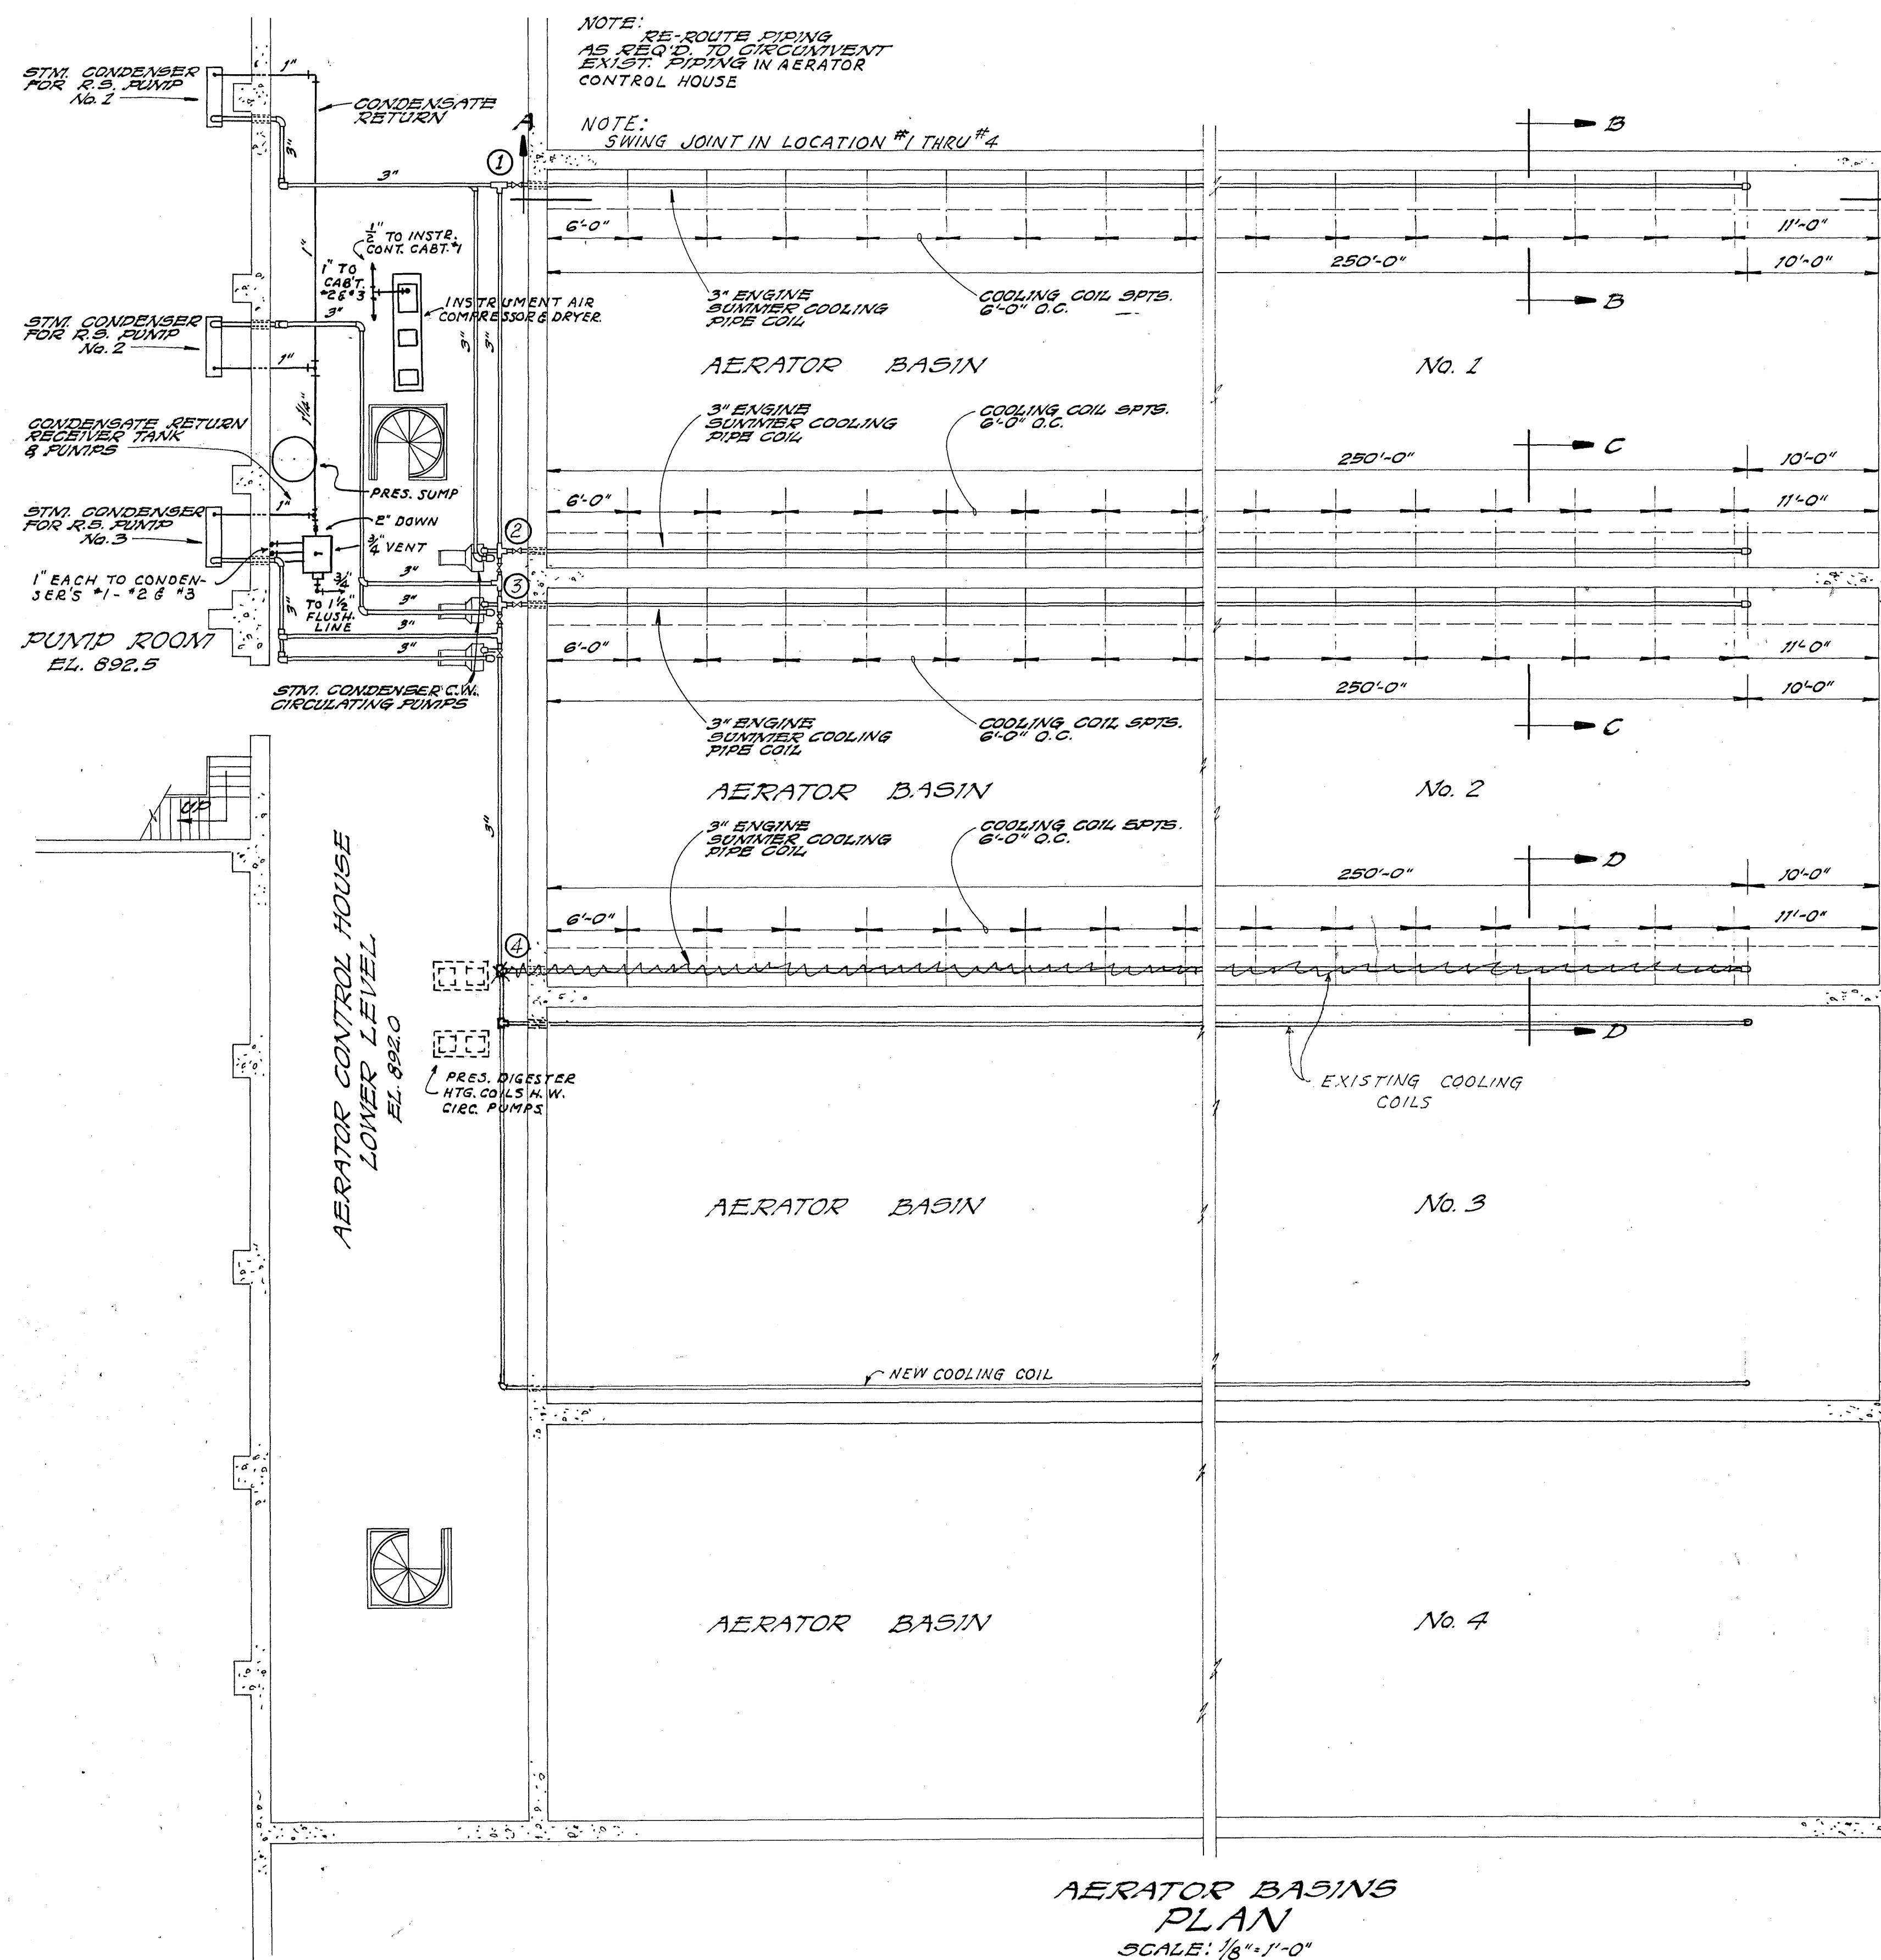


AERATOR BASINS
PLAN
SCALE: 1/8" = 1'-0"

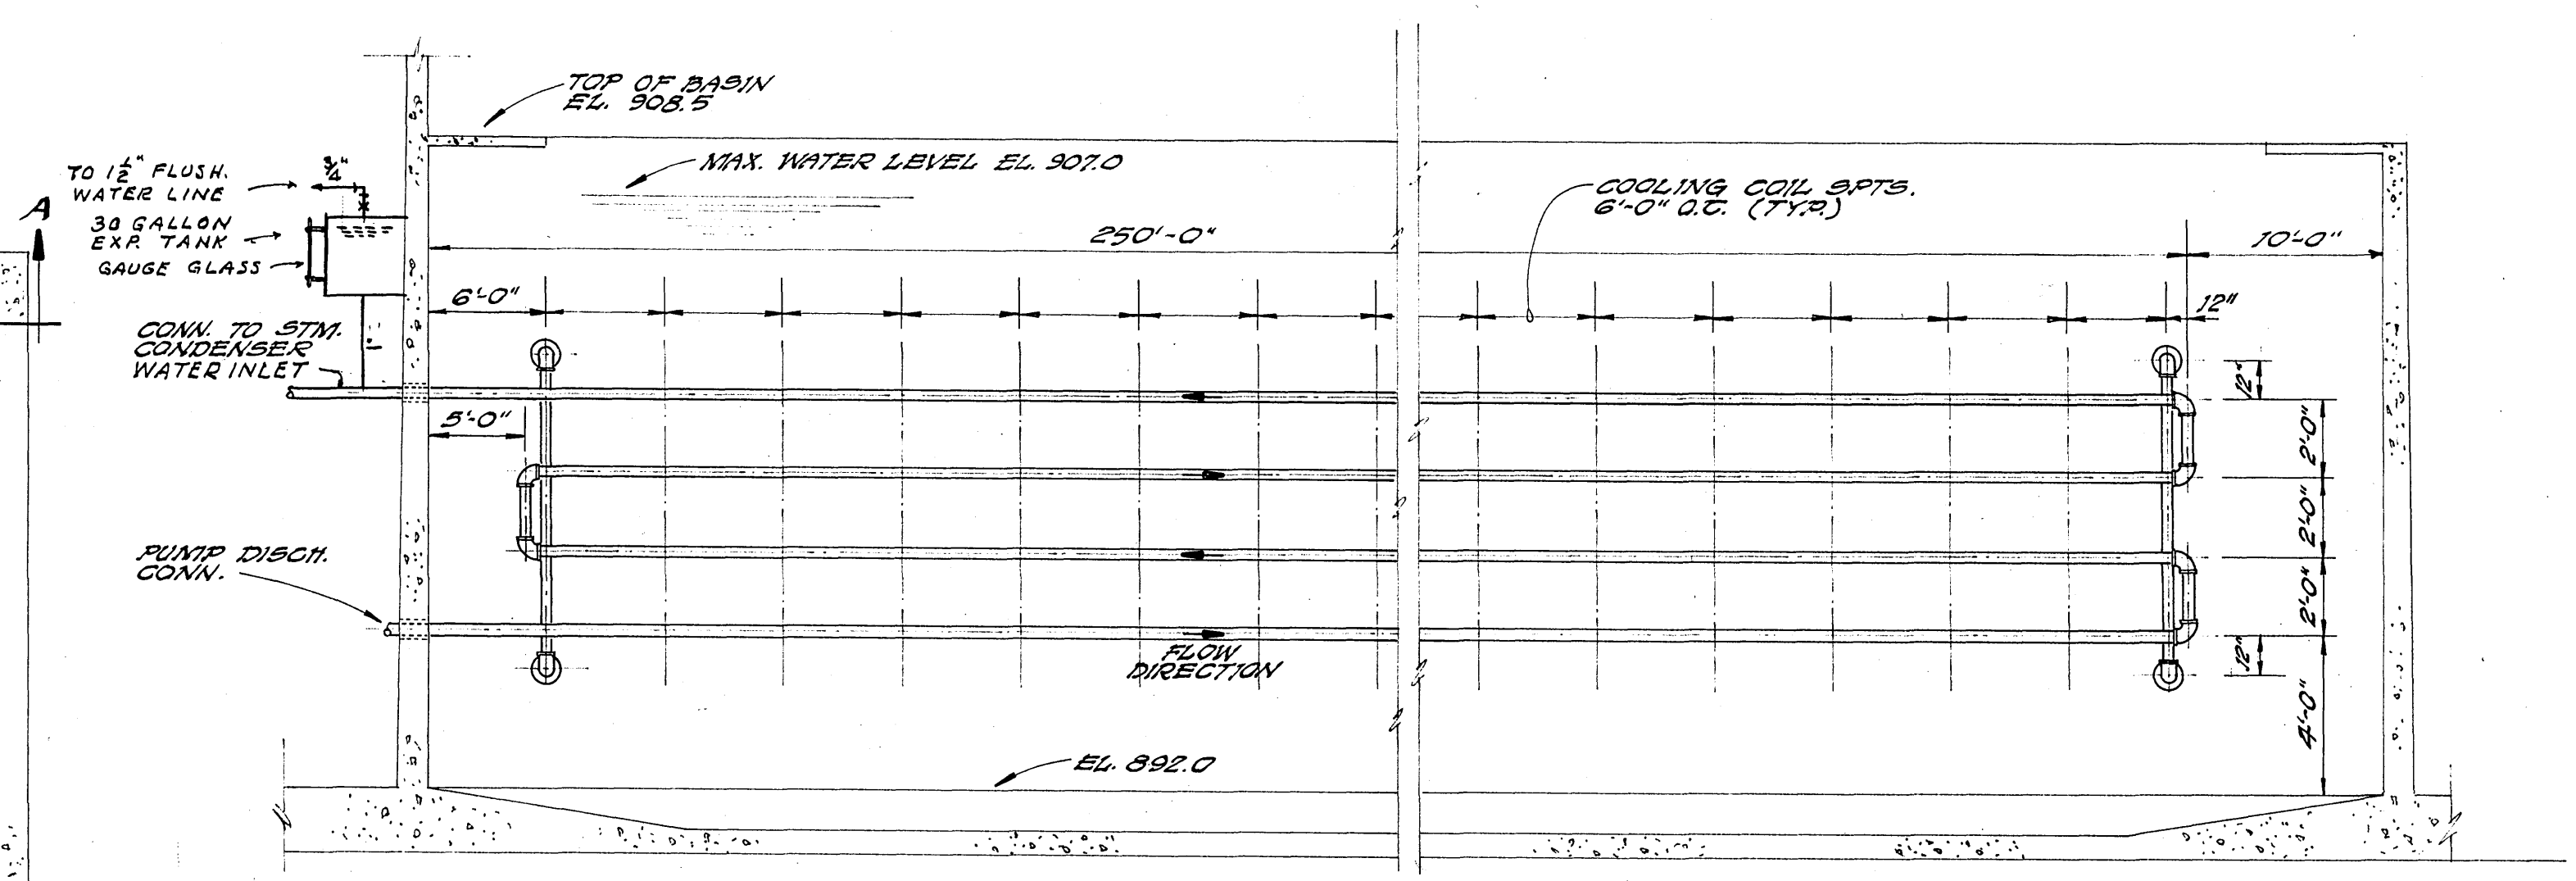


SECTION A-A
SCALE: 1/8" = 1'-0" HOR.
1/4" = 1'-0" VERT.

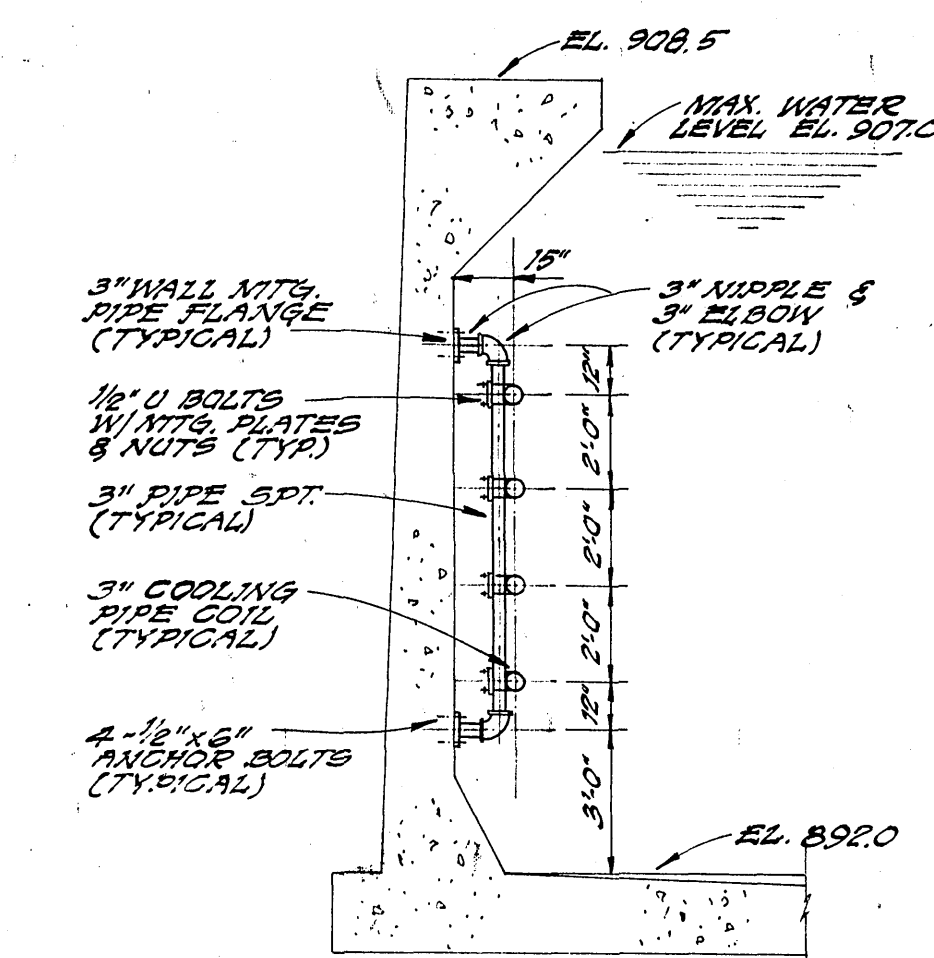


SECTION B-B
SCALE: 1/4" = 1'-0"
SECTION D-D SIMILAR
BUT OPPOSITE HAND

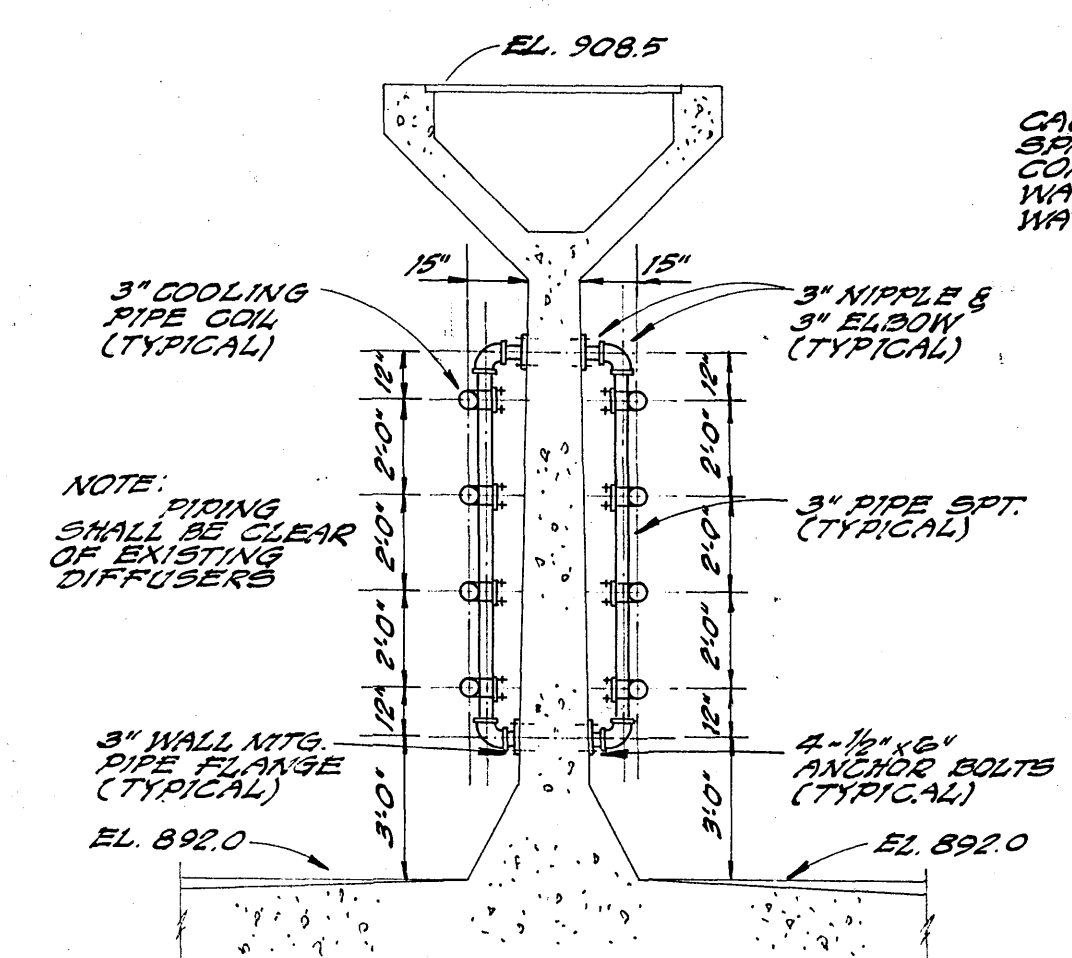


SECTION C-C
SCALE: 1/4" = 1'-0"

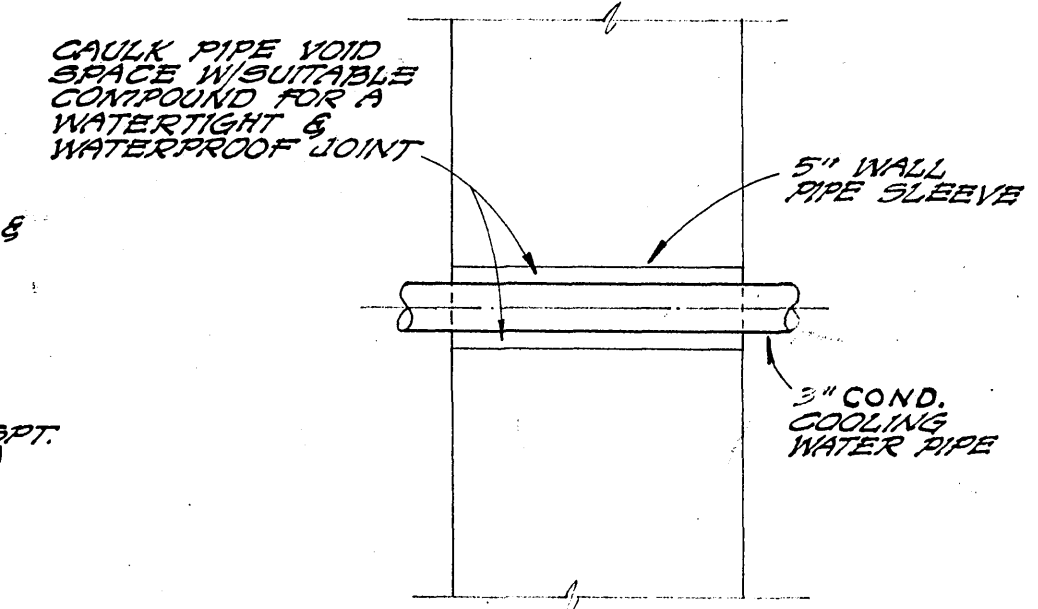


WALL SLEEVE
DETAIL
SCALE: 1" = 1'-0"

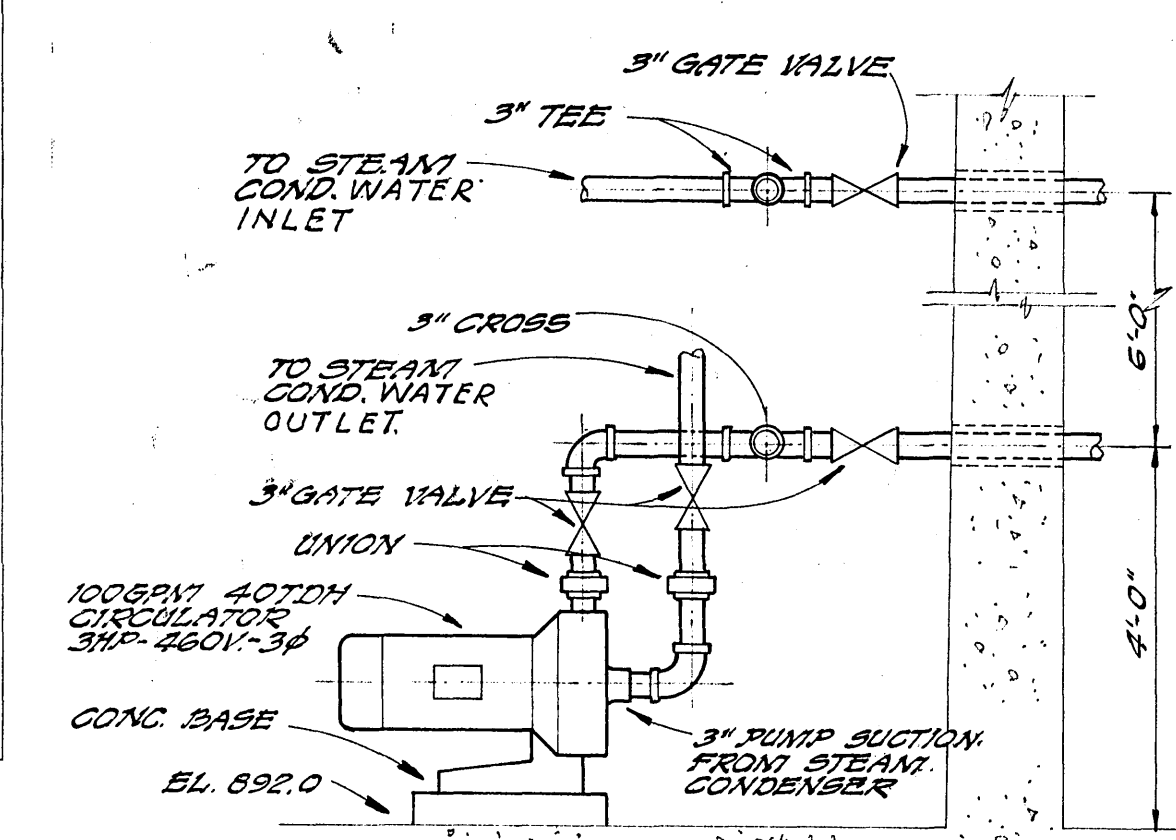

STN. CONDENSER HW. CIRCULATOR
(TYP. INSTALLATION)
SCALE: 1/2" = 1'-0"

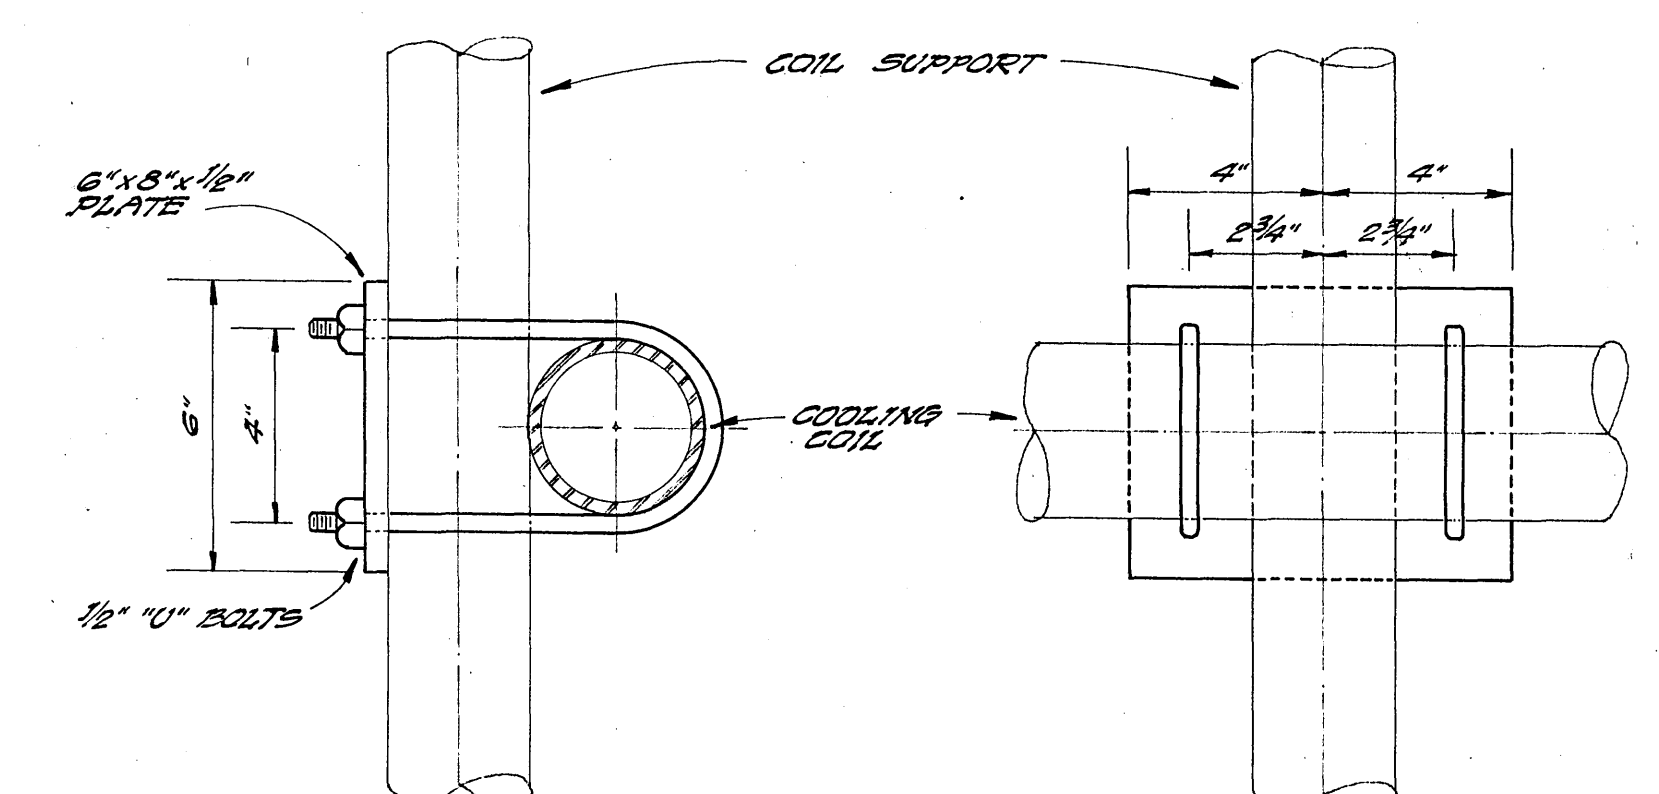

PIPE COIL FASTENING
DETAIL
SCALE: 3/4" = 1'-0"

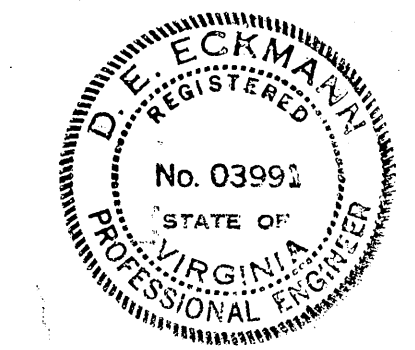

AS BUILT 27
CONTR. C

ADDITIONS TO SEWAGE TREATMENT PLANT
ROANOKE, VIRGINIA

**RAW SEWAGE PUMPING UNITS
DETAILS**

ALVORD, BURDICK & HOWSON
ENGINEERS CHICAGO

1973