


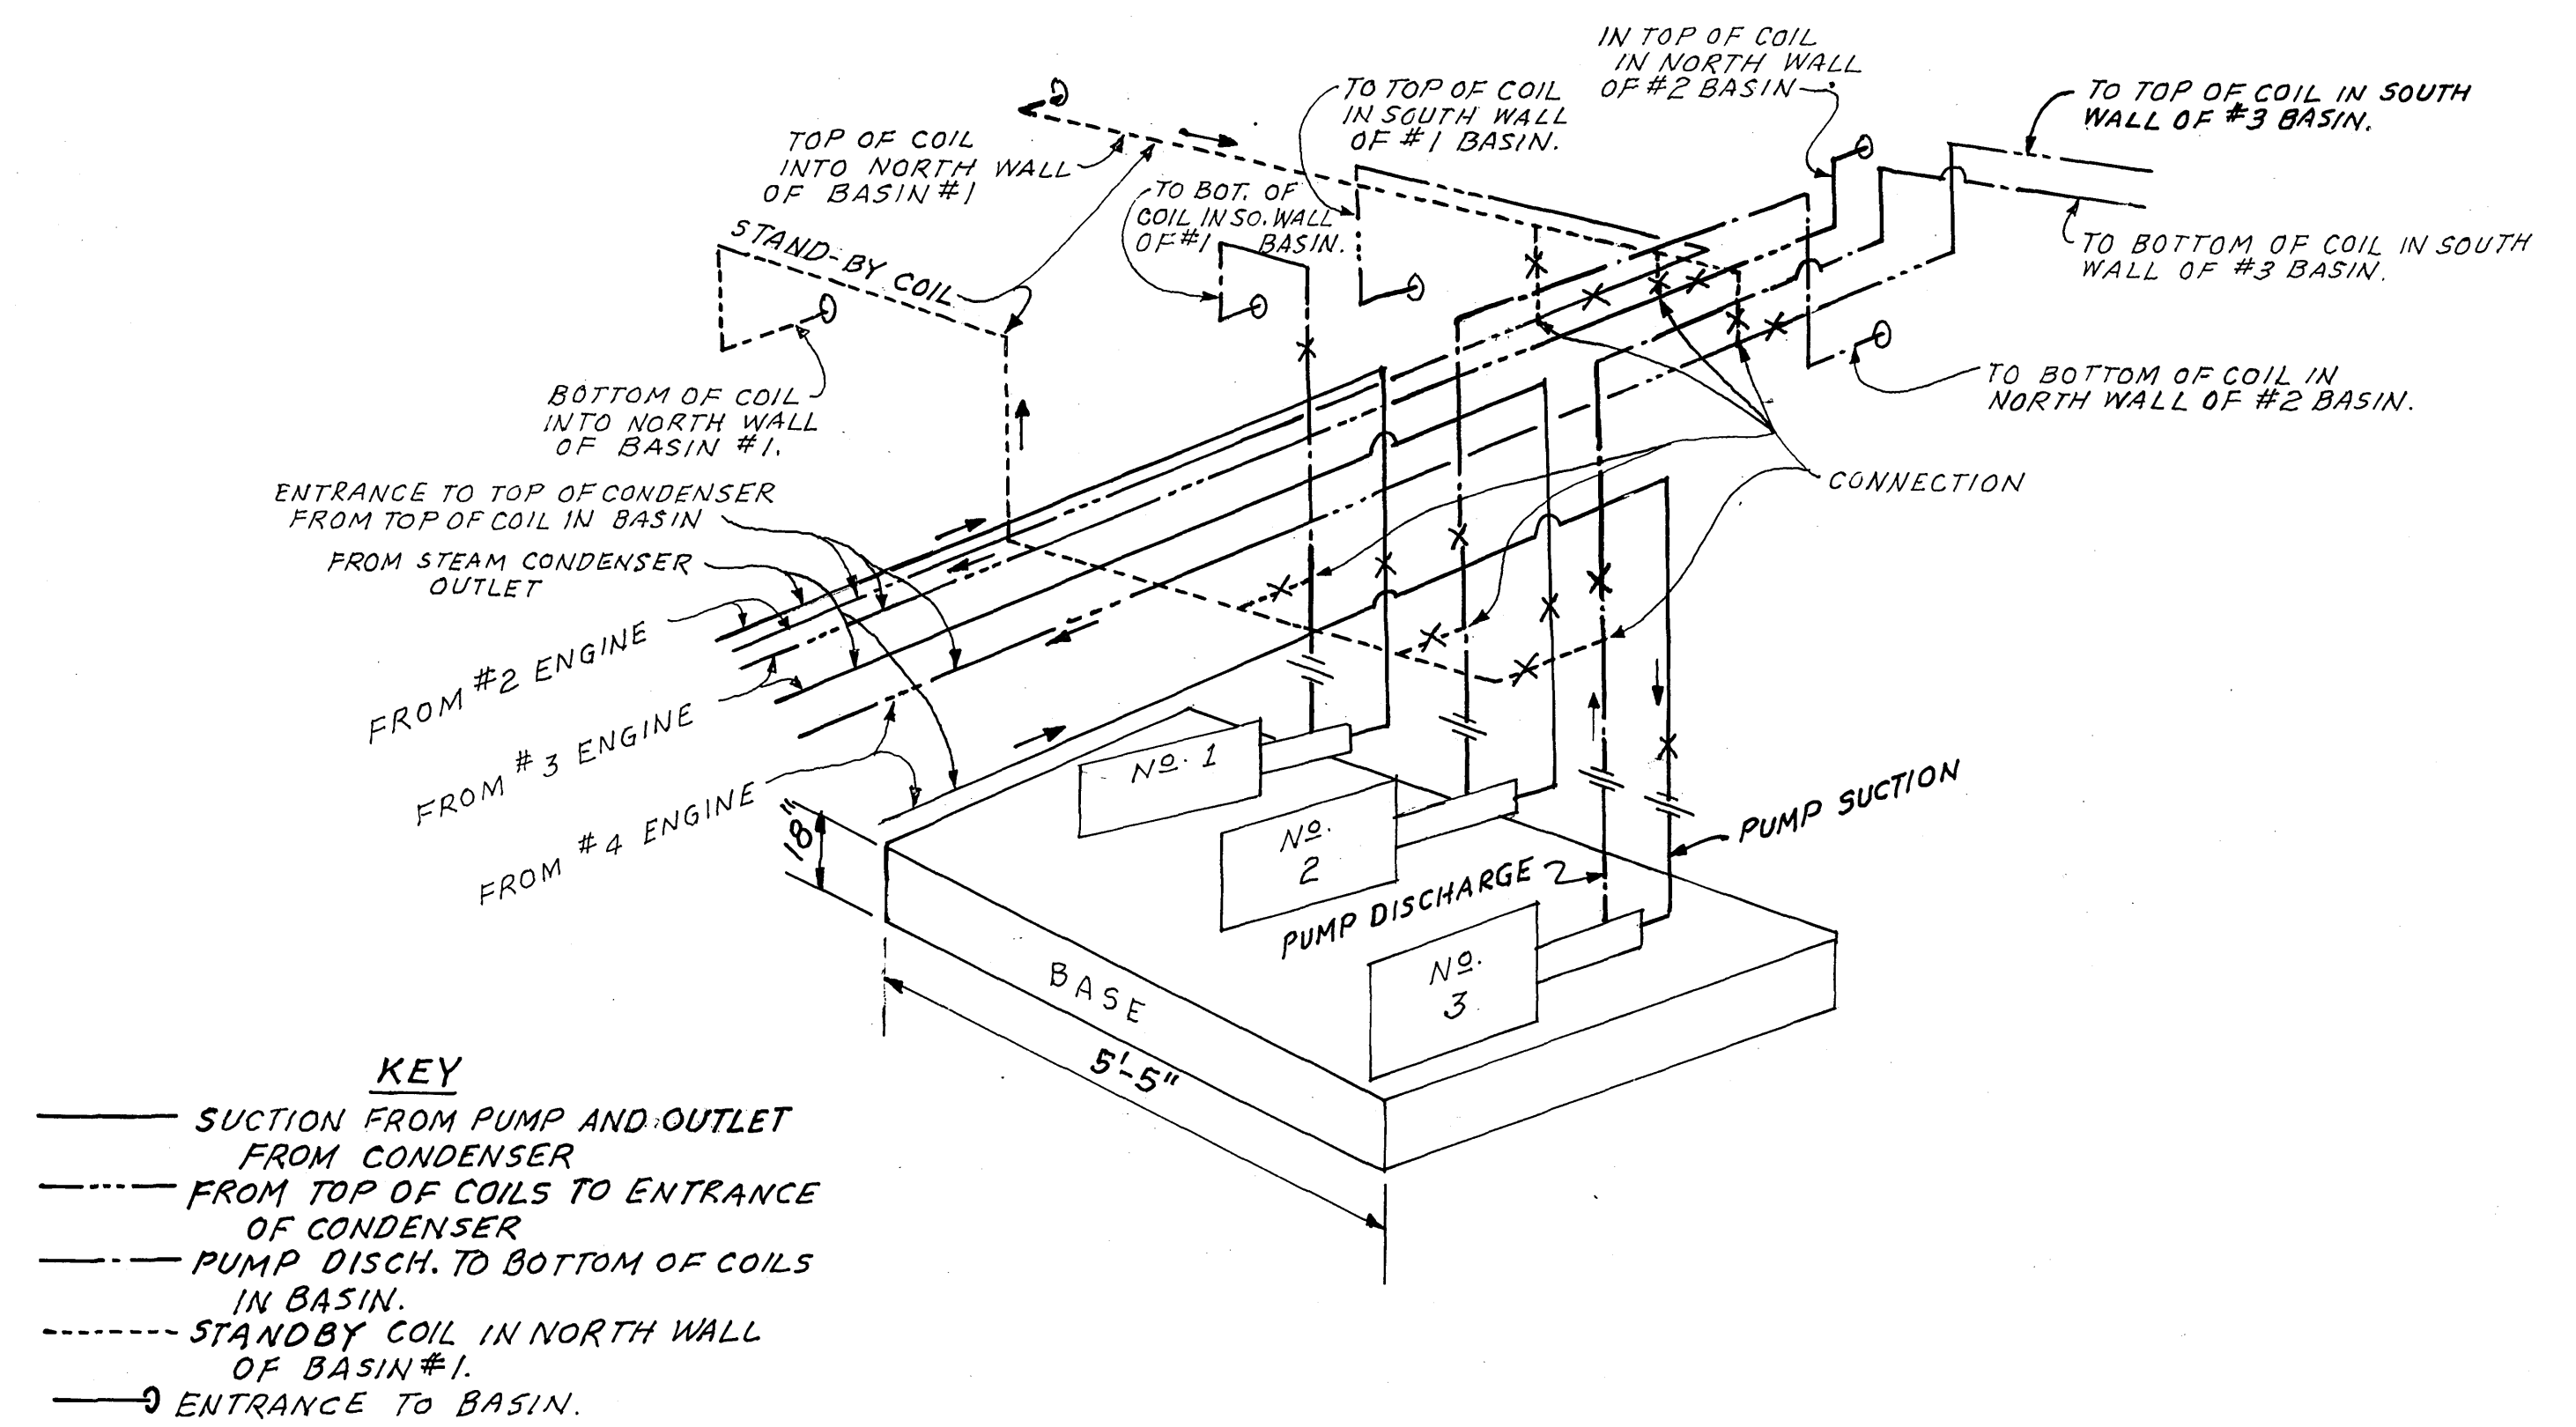

SCHEMATIC DIAGRAM OF ENGINE JACKET WATER & EXHAUST AUXILIARY WASTE HEAT COOLING SYSTEM ("AS BUILT")

