
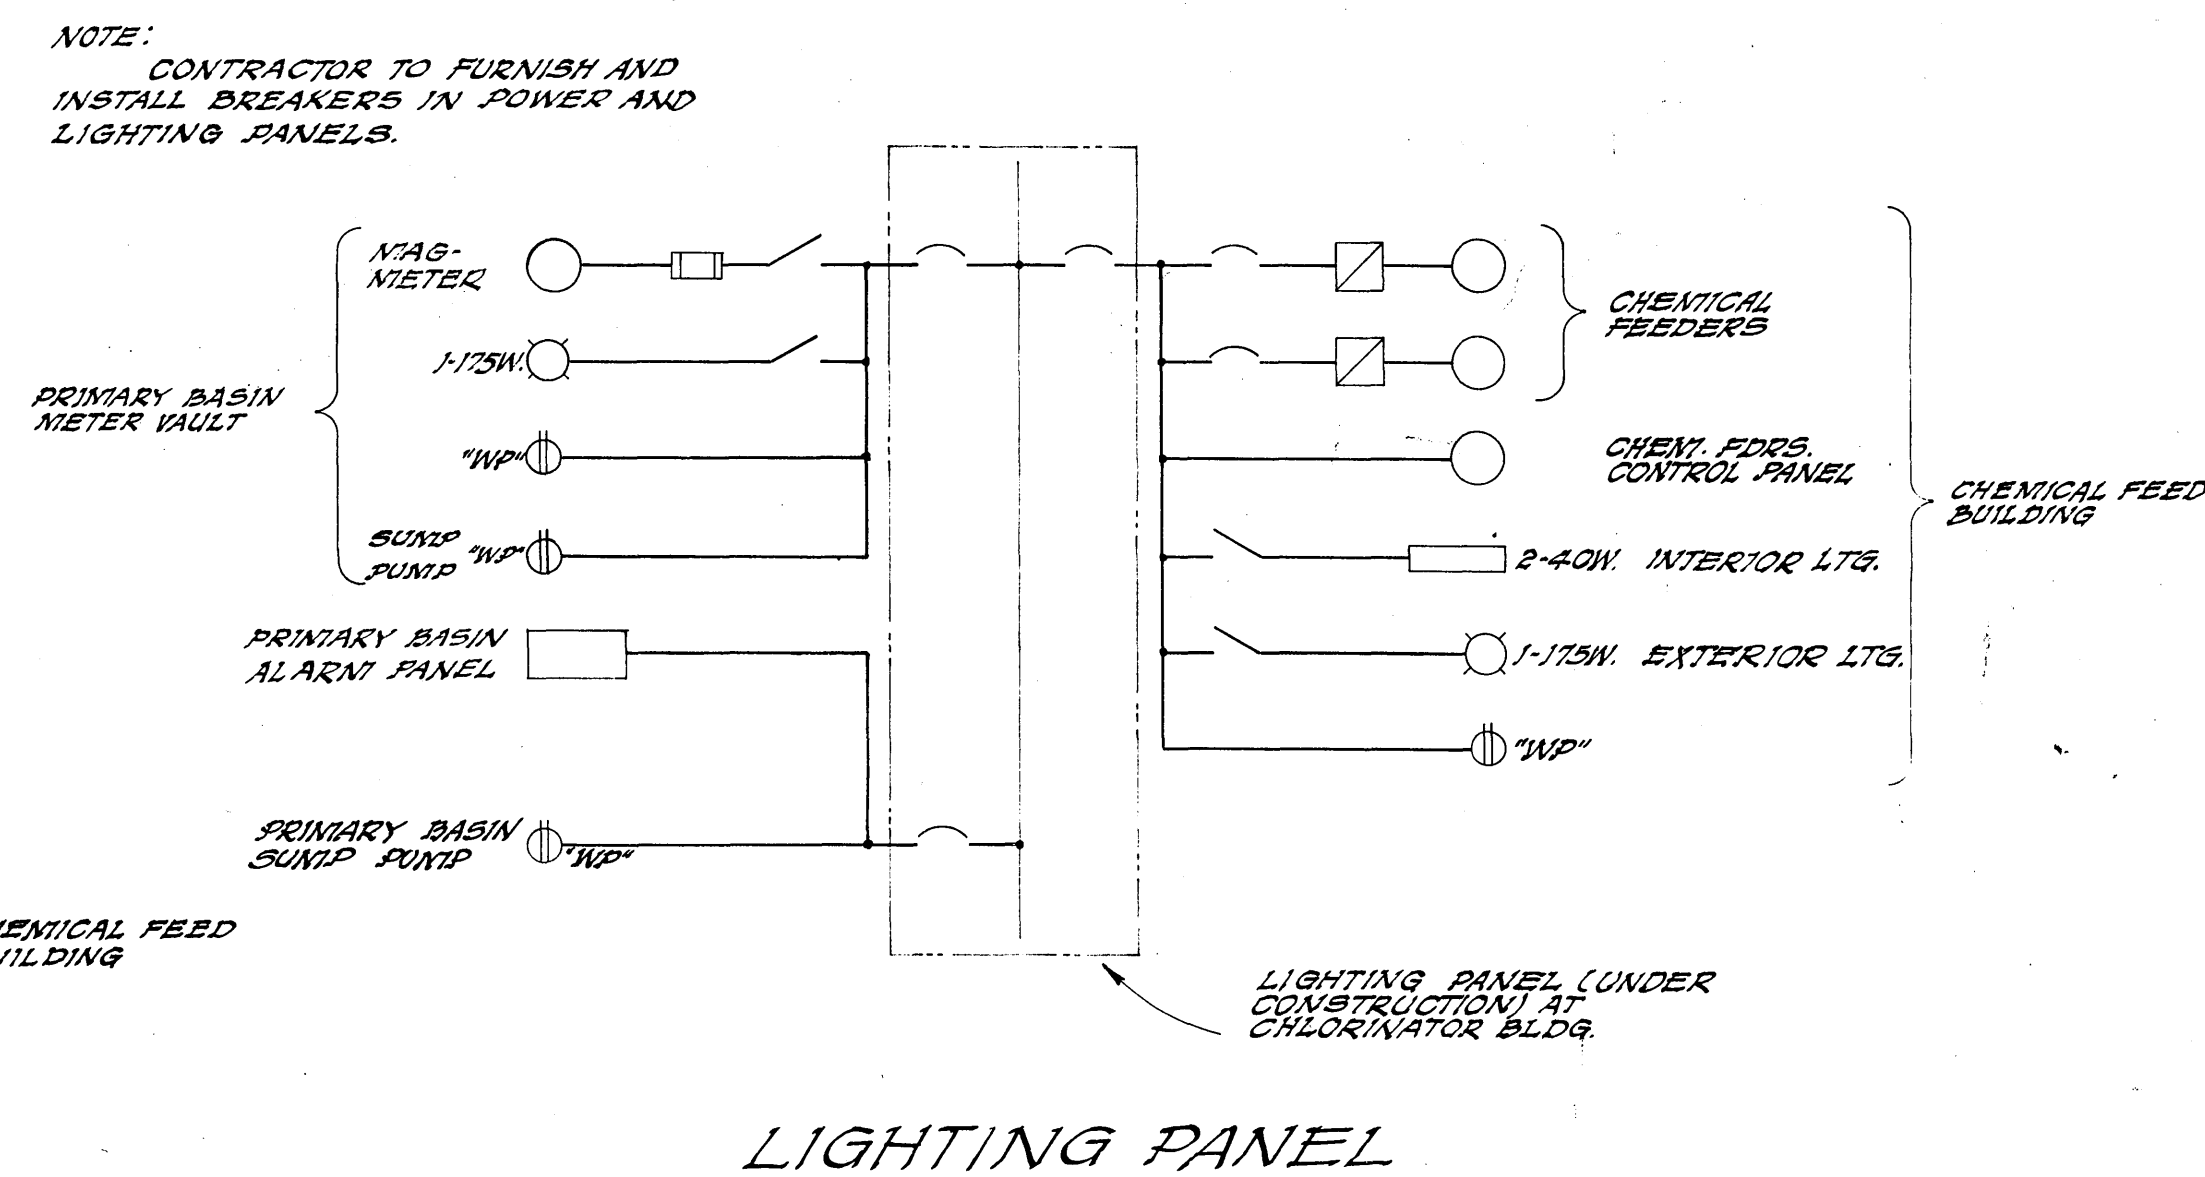
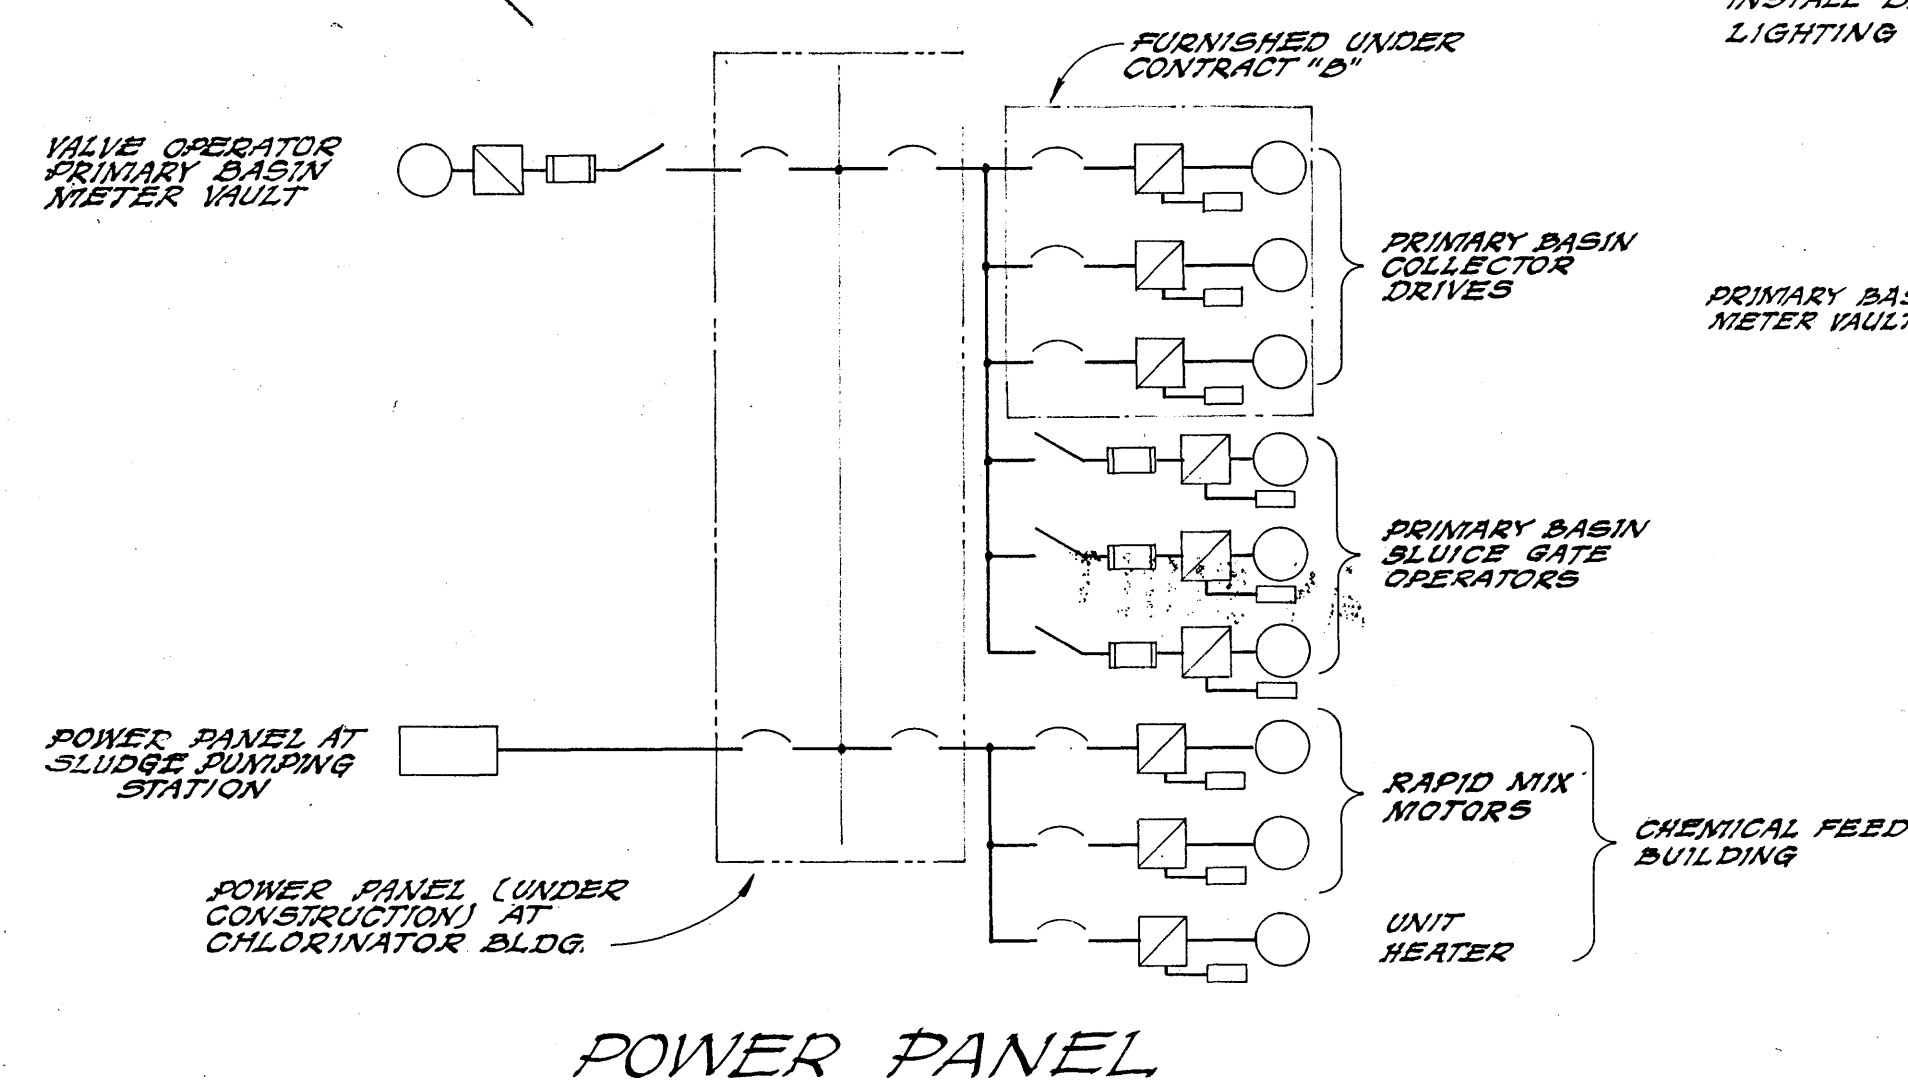
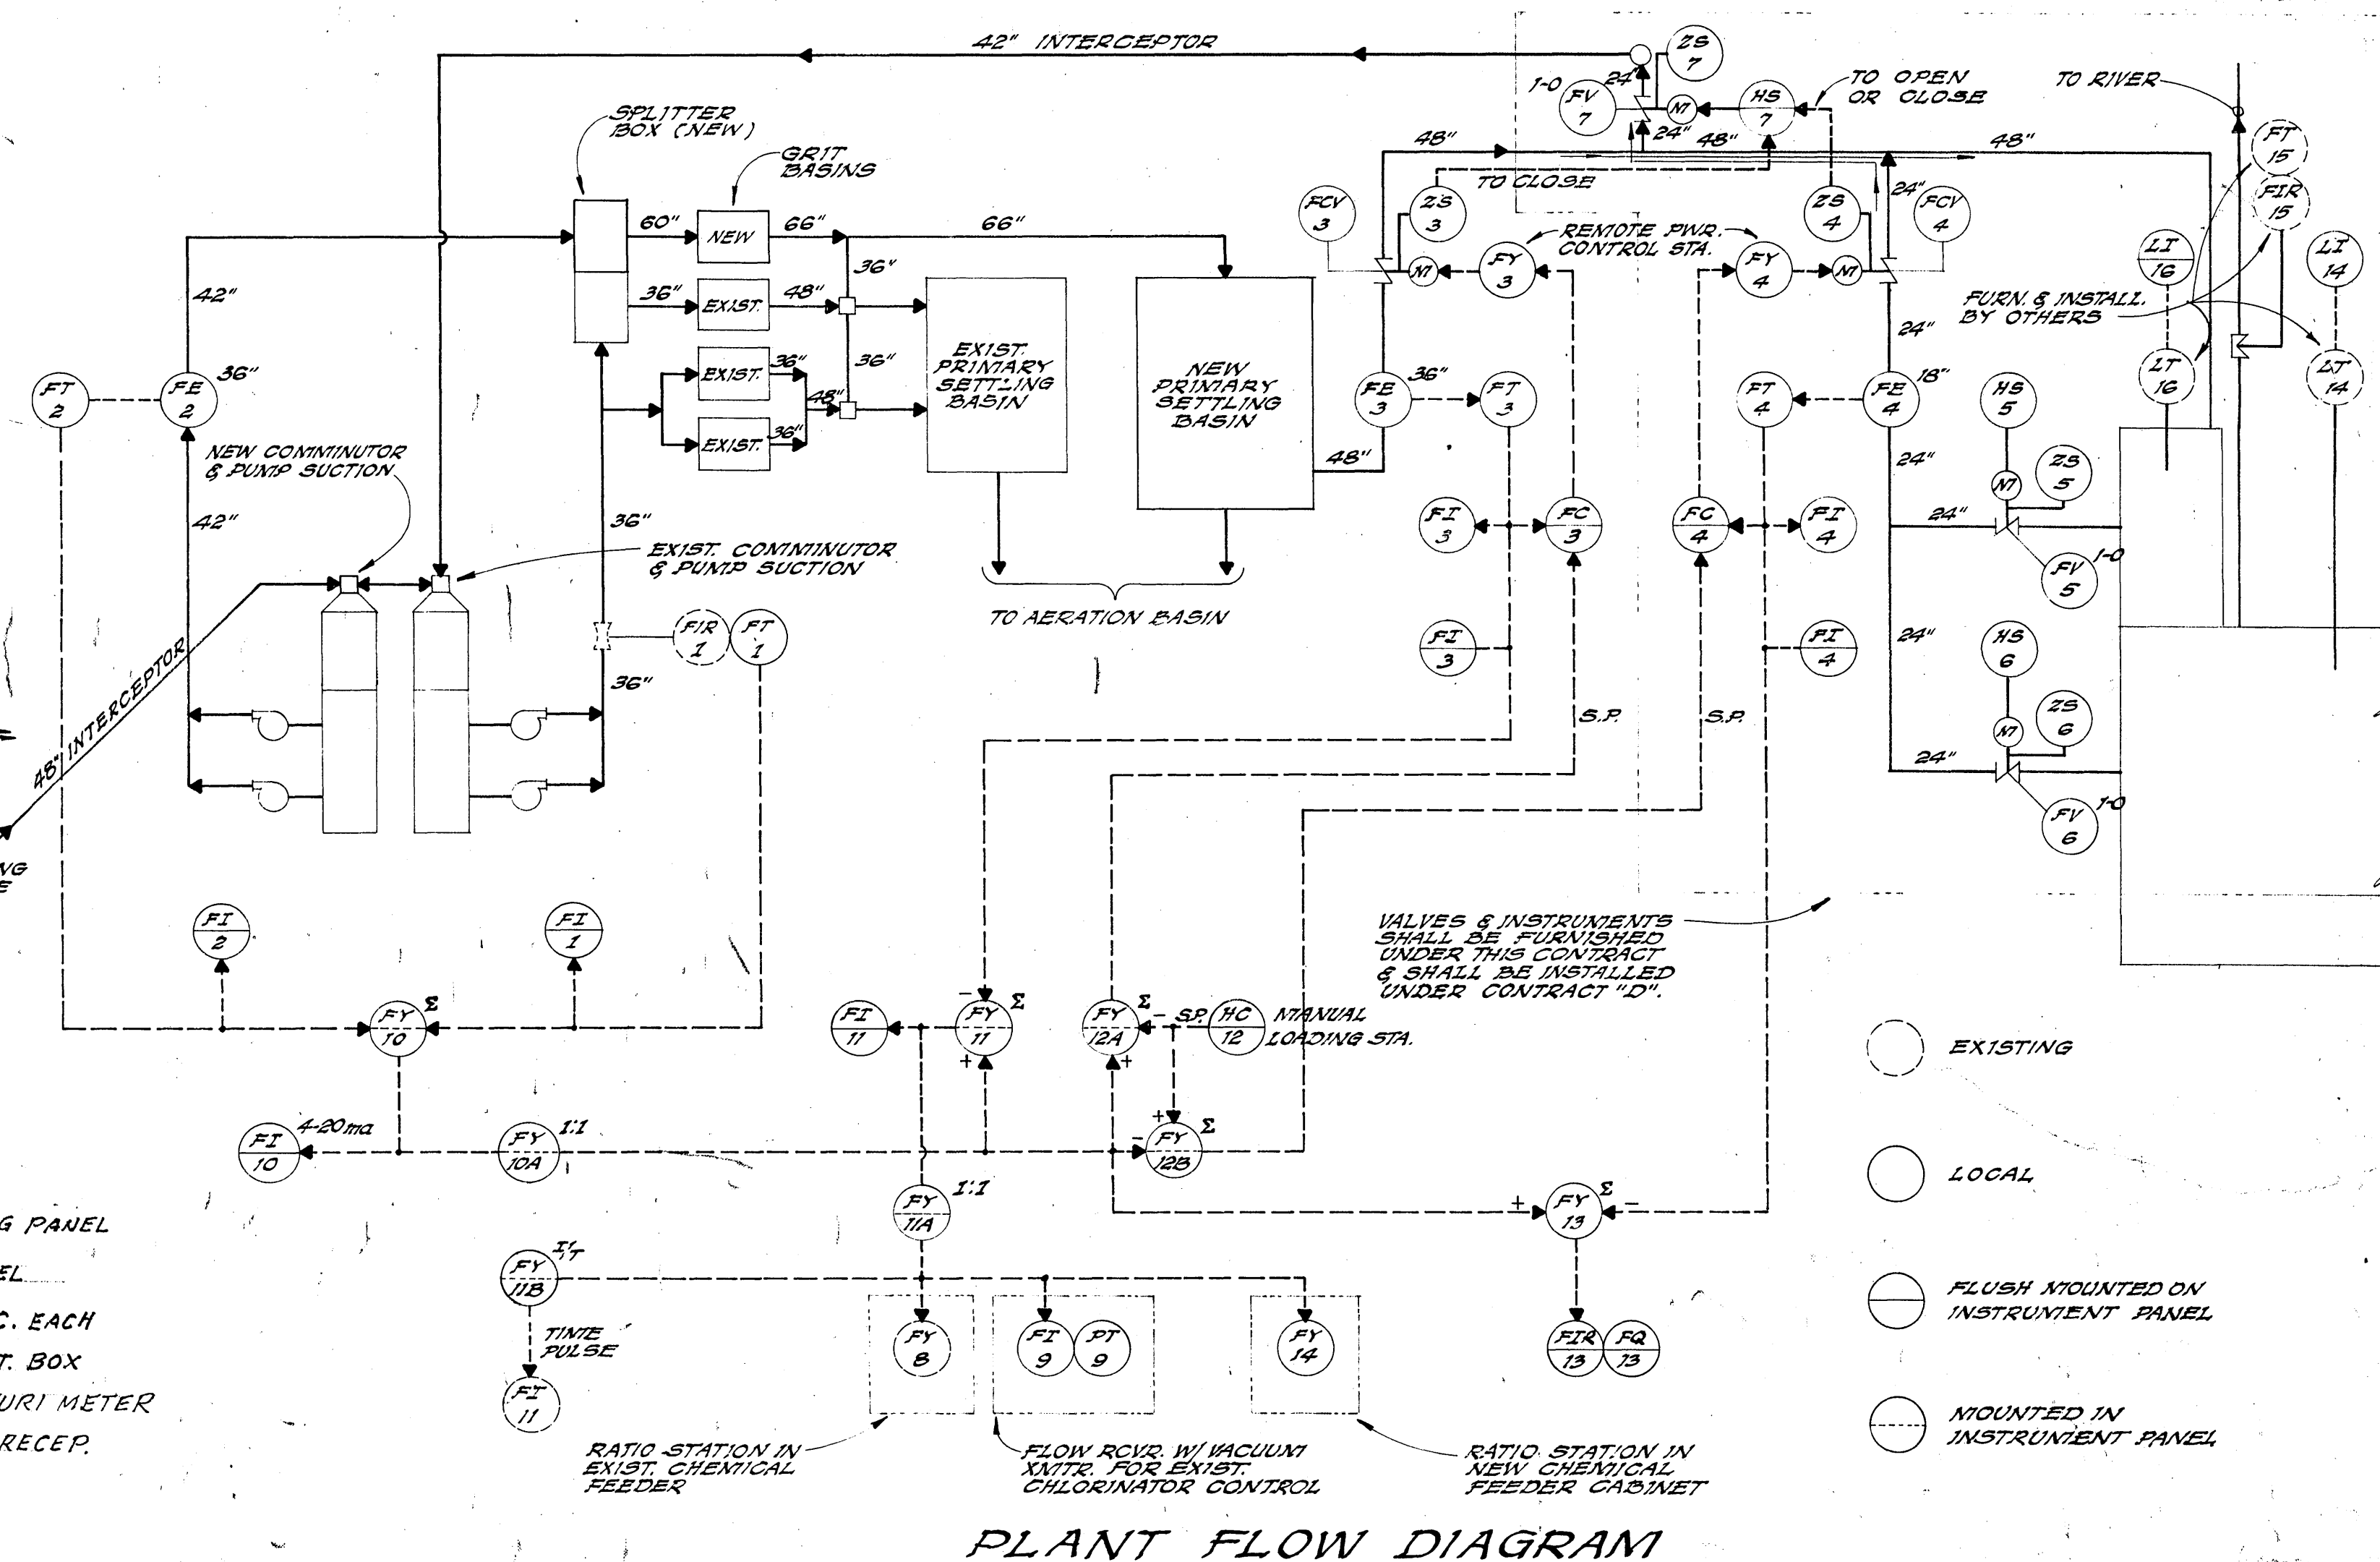
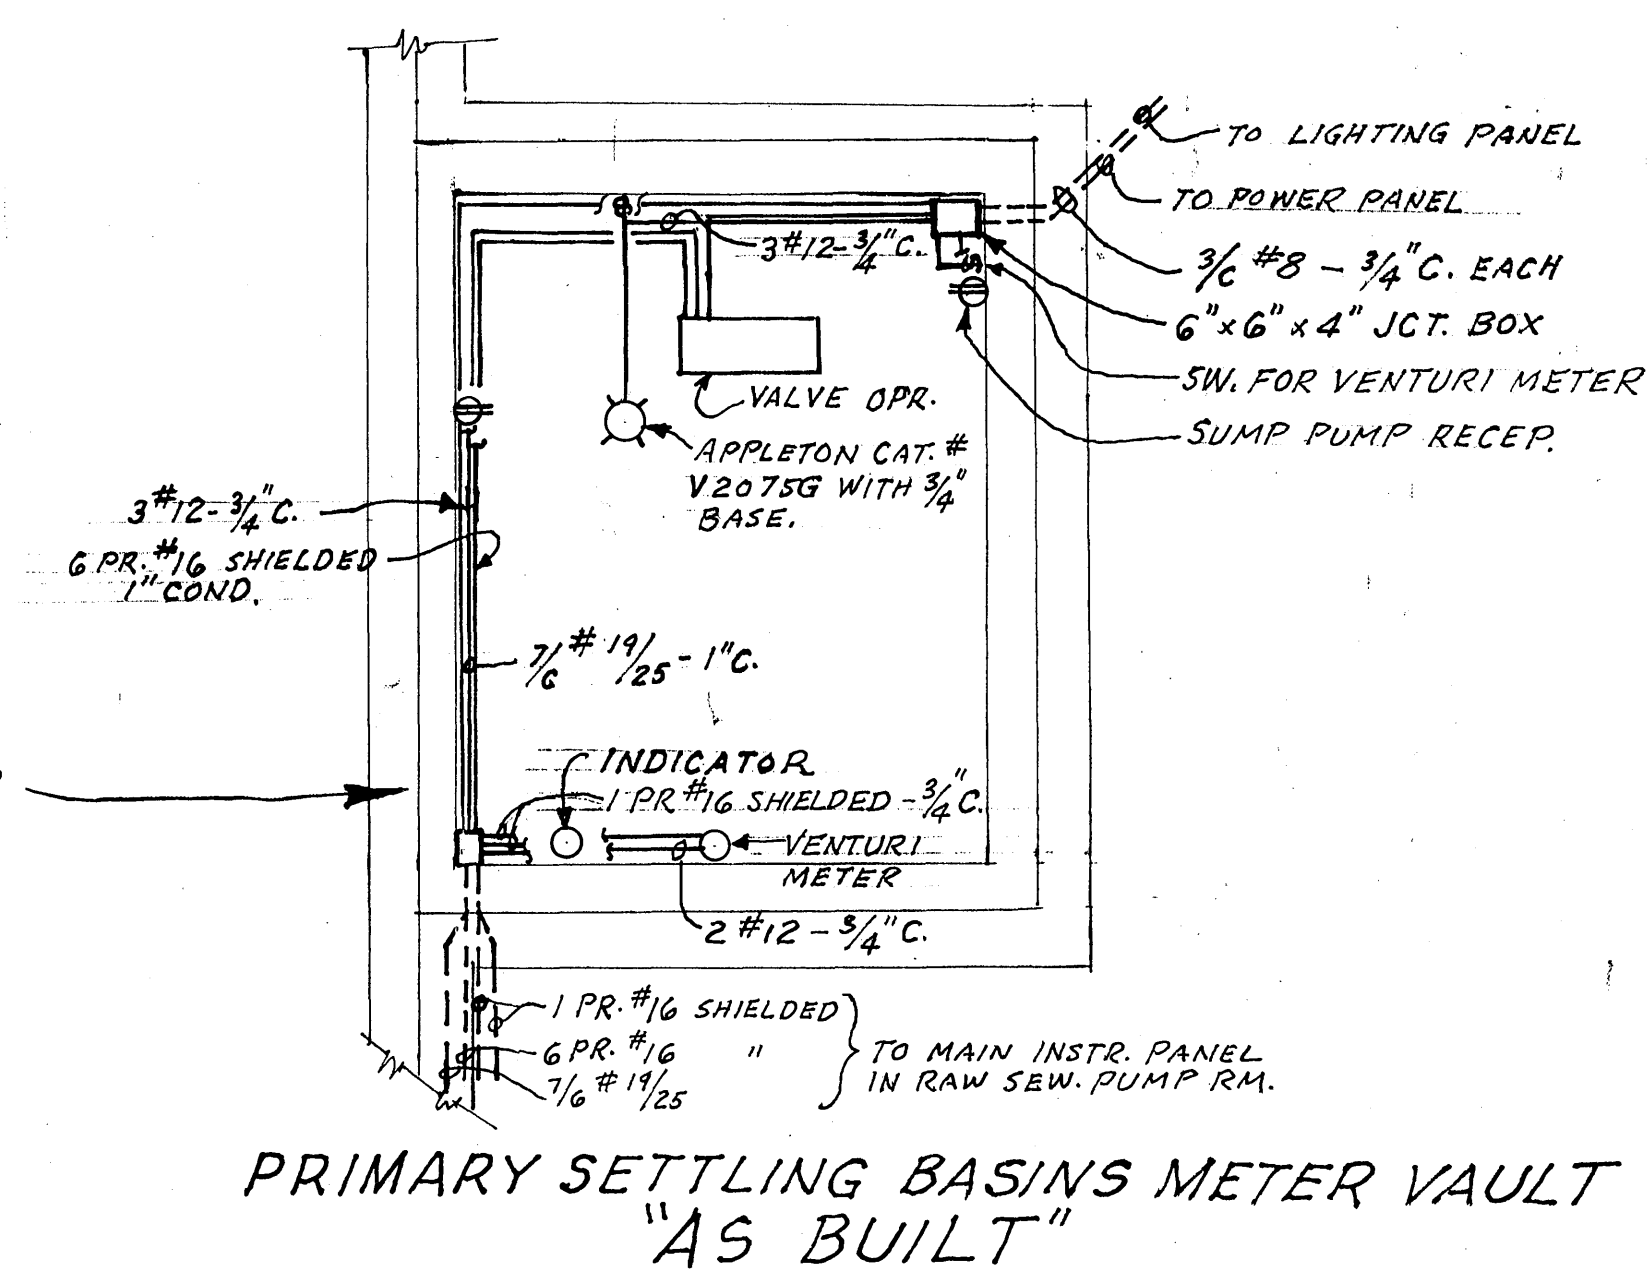
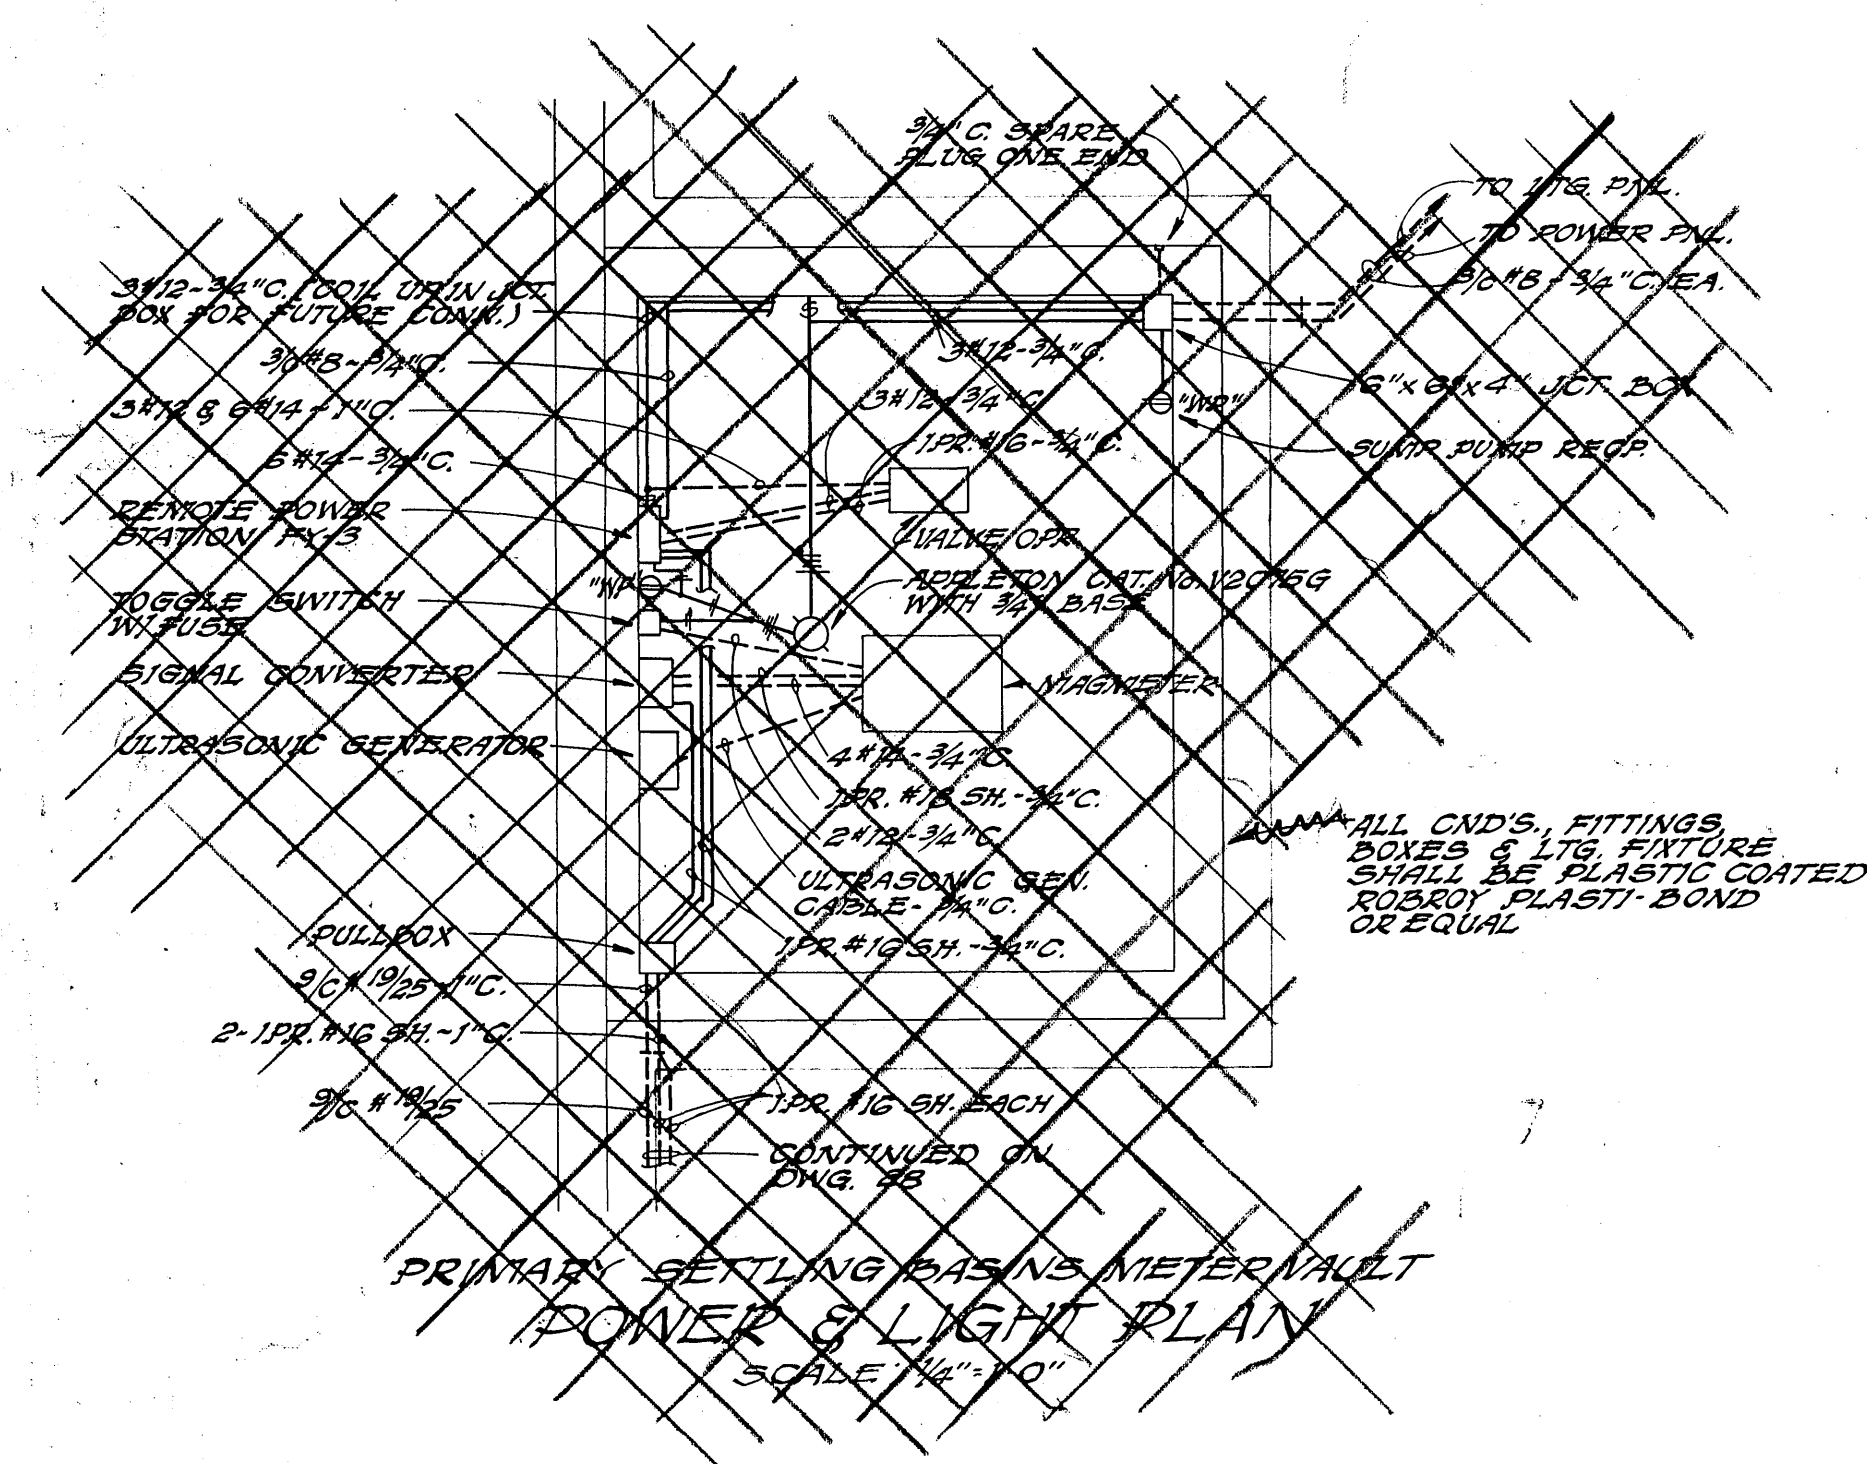


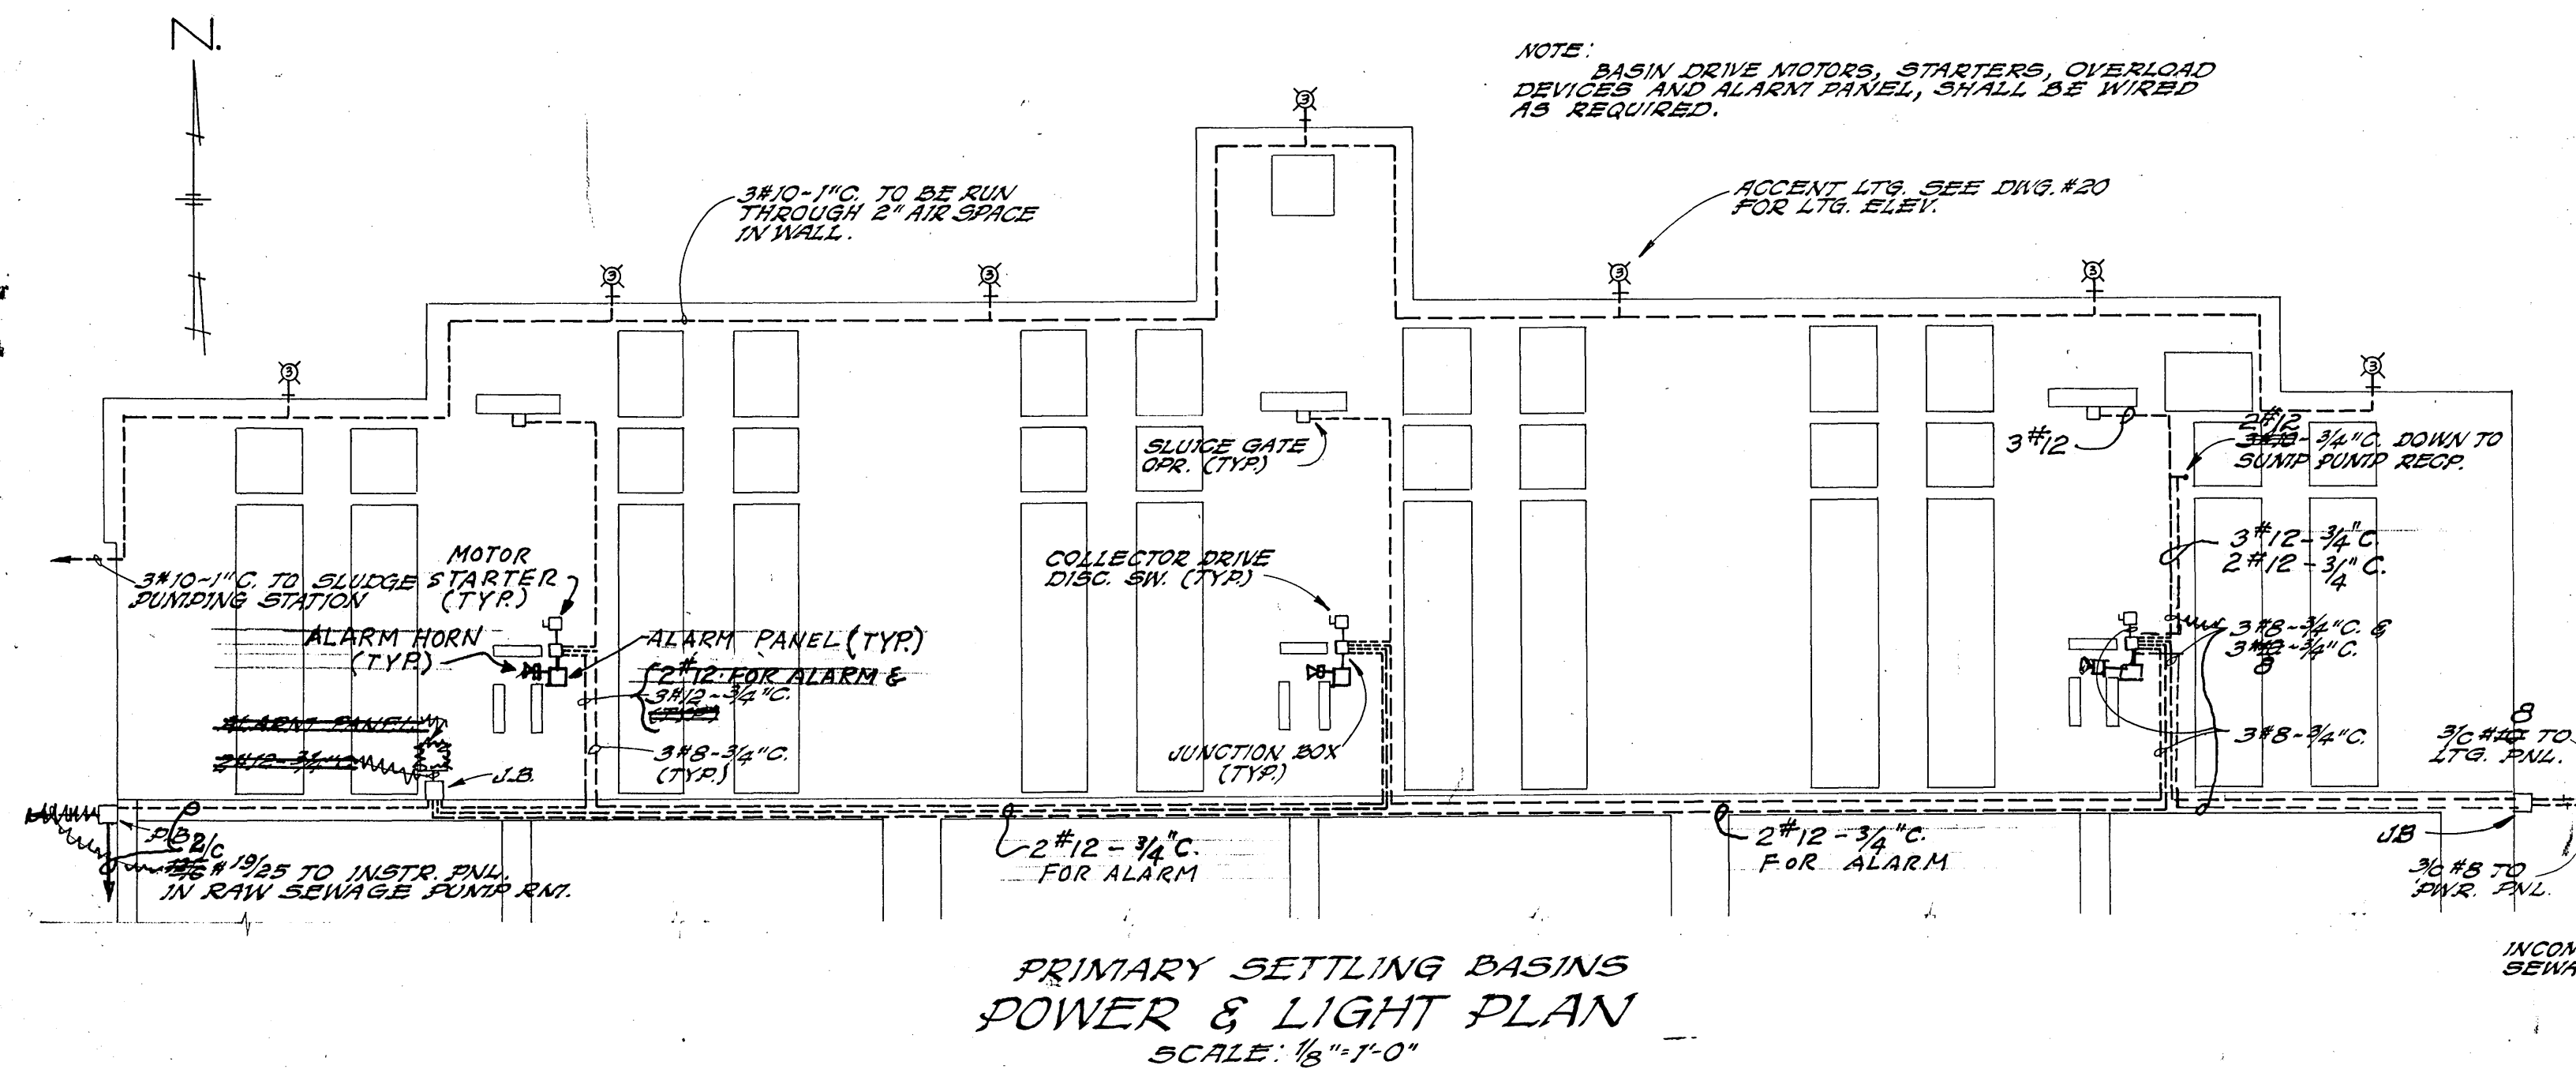

AS BUILT

30

CONTR. "C"

ADDITIONS TO SEWAGE TREATMENT PLANT
ROANOKE, VIRGINIA

ELECTRICAL PLANS

ALVORD, BURDICK & HOWSON
ENGINEERS CHICAGO

1973