
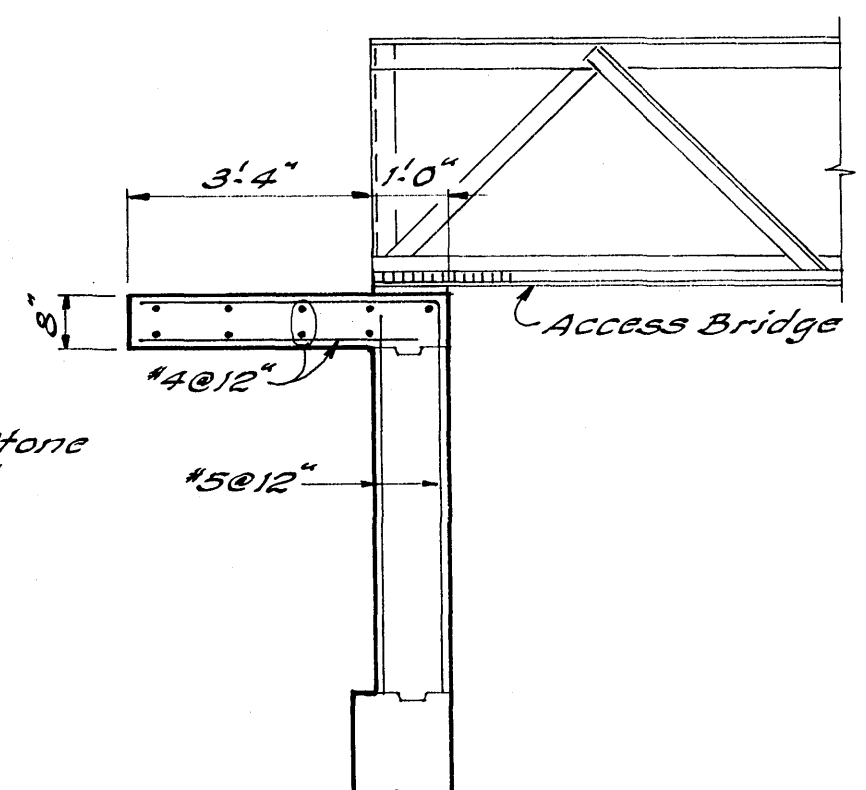
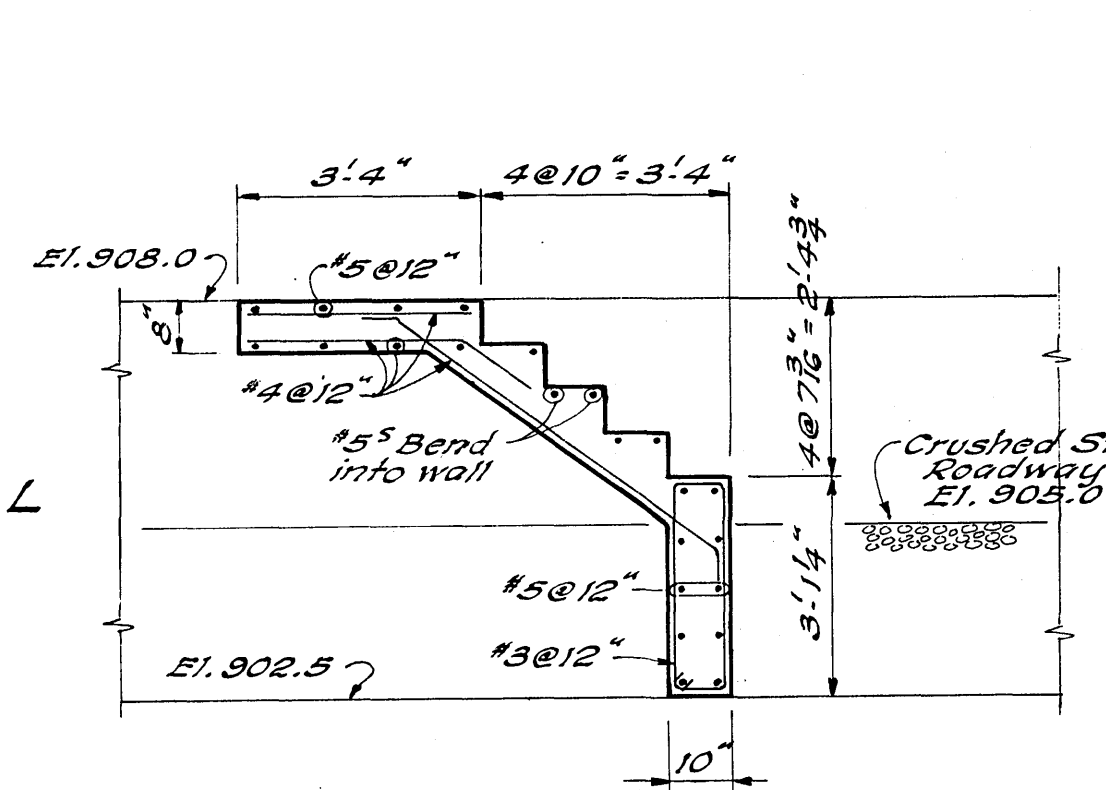
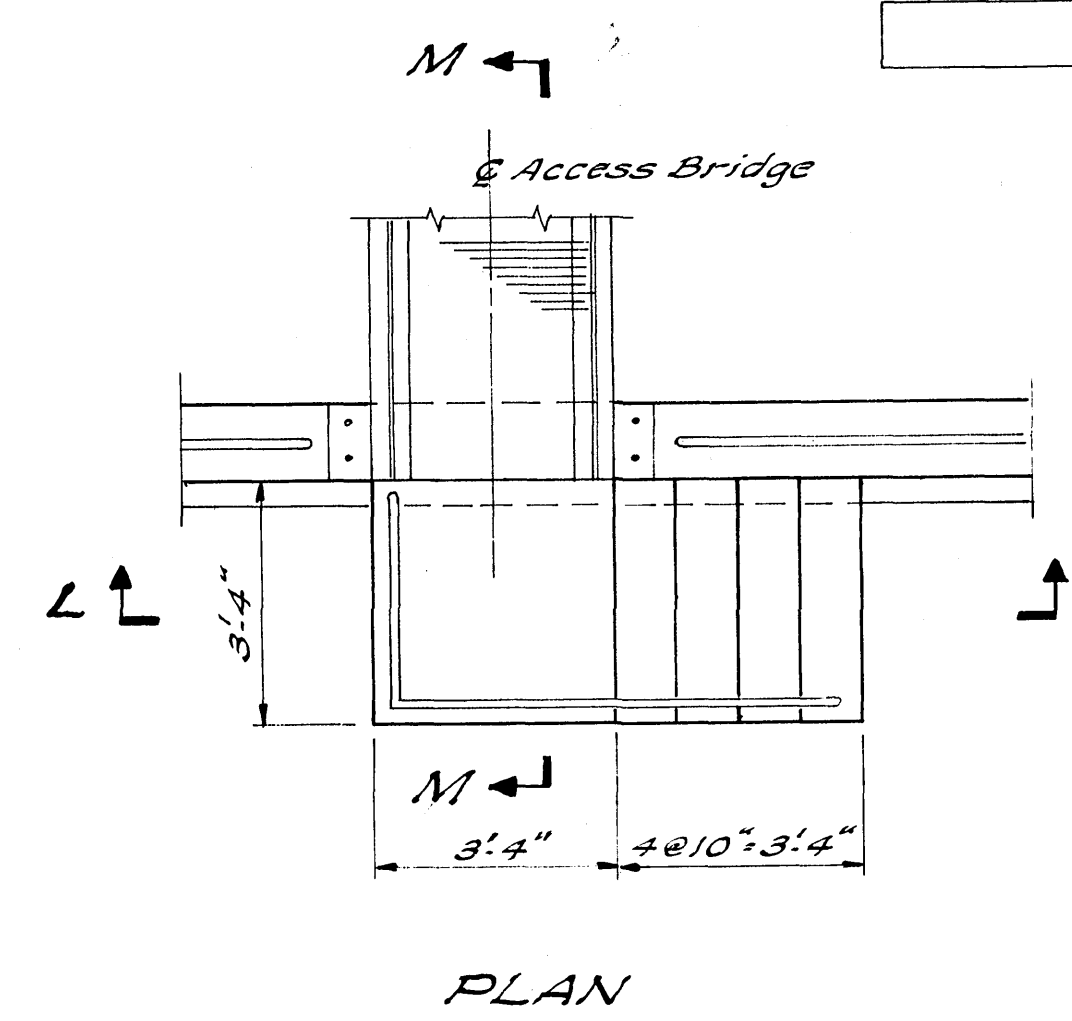
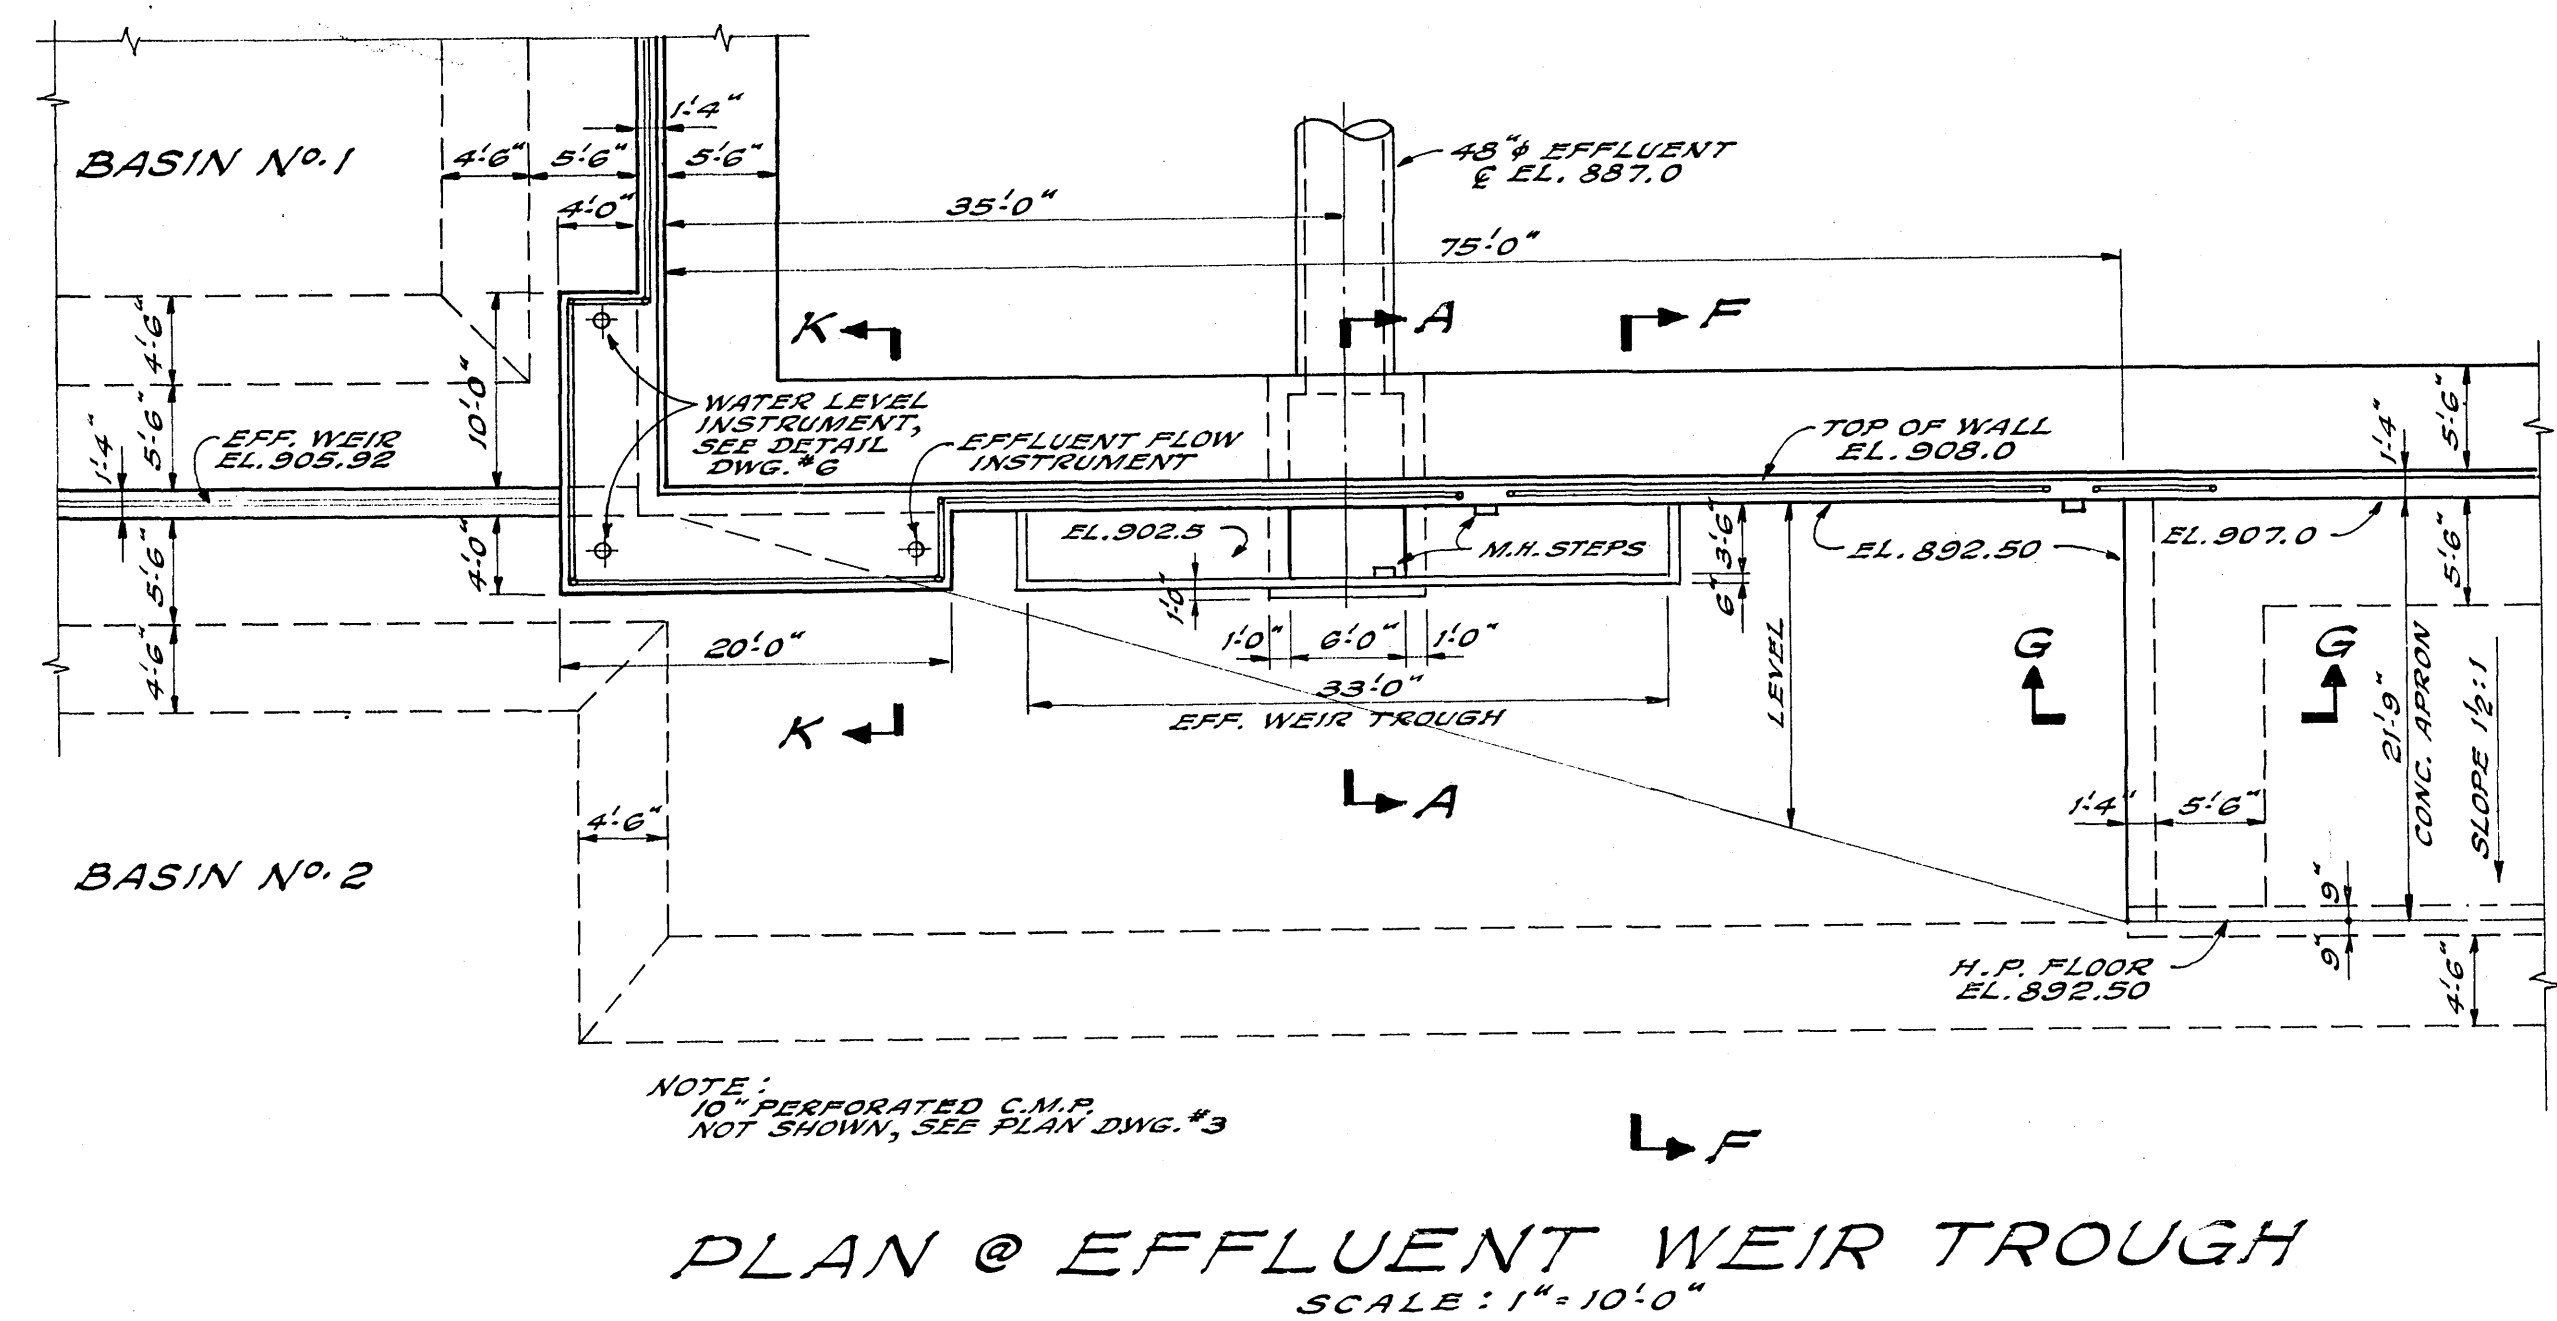
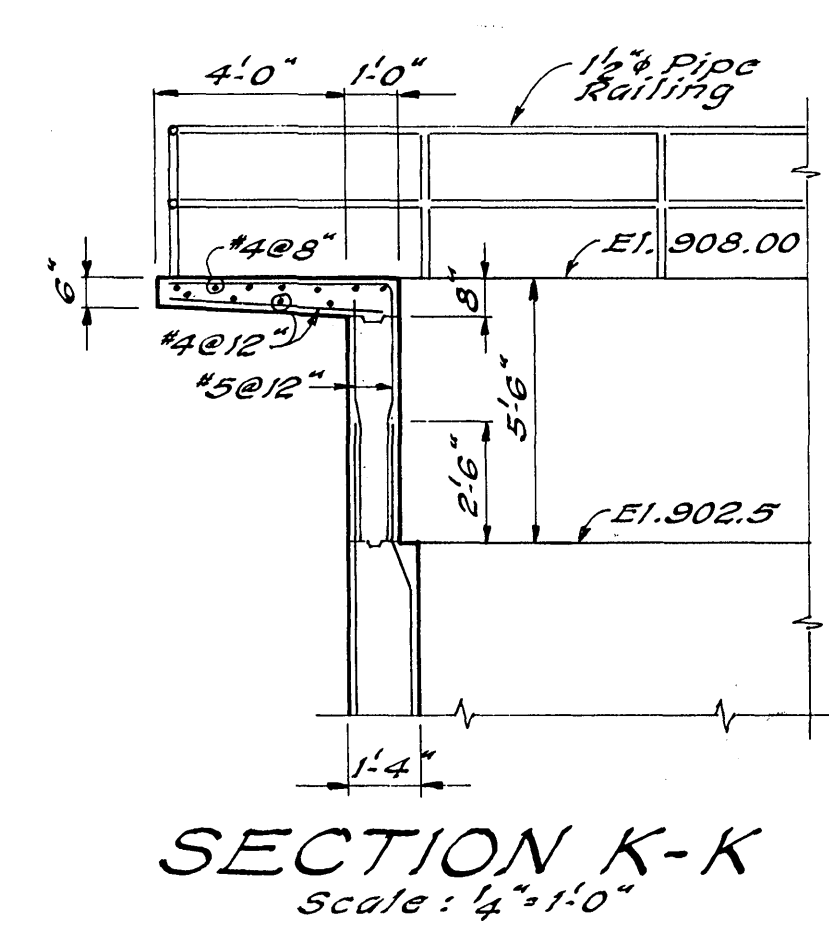
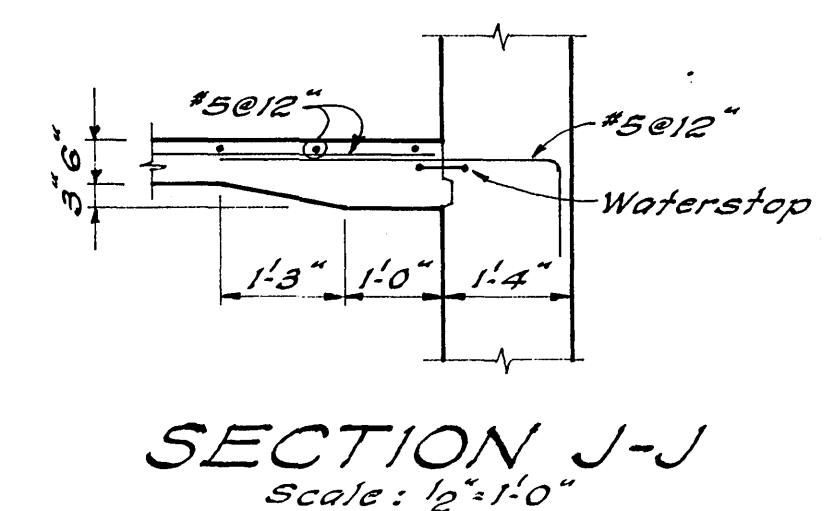
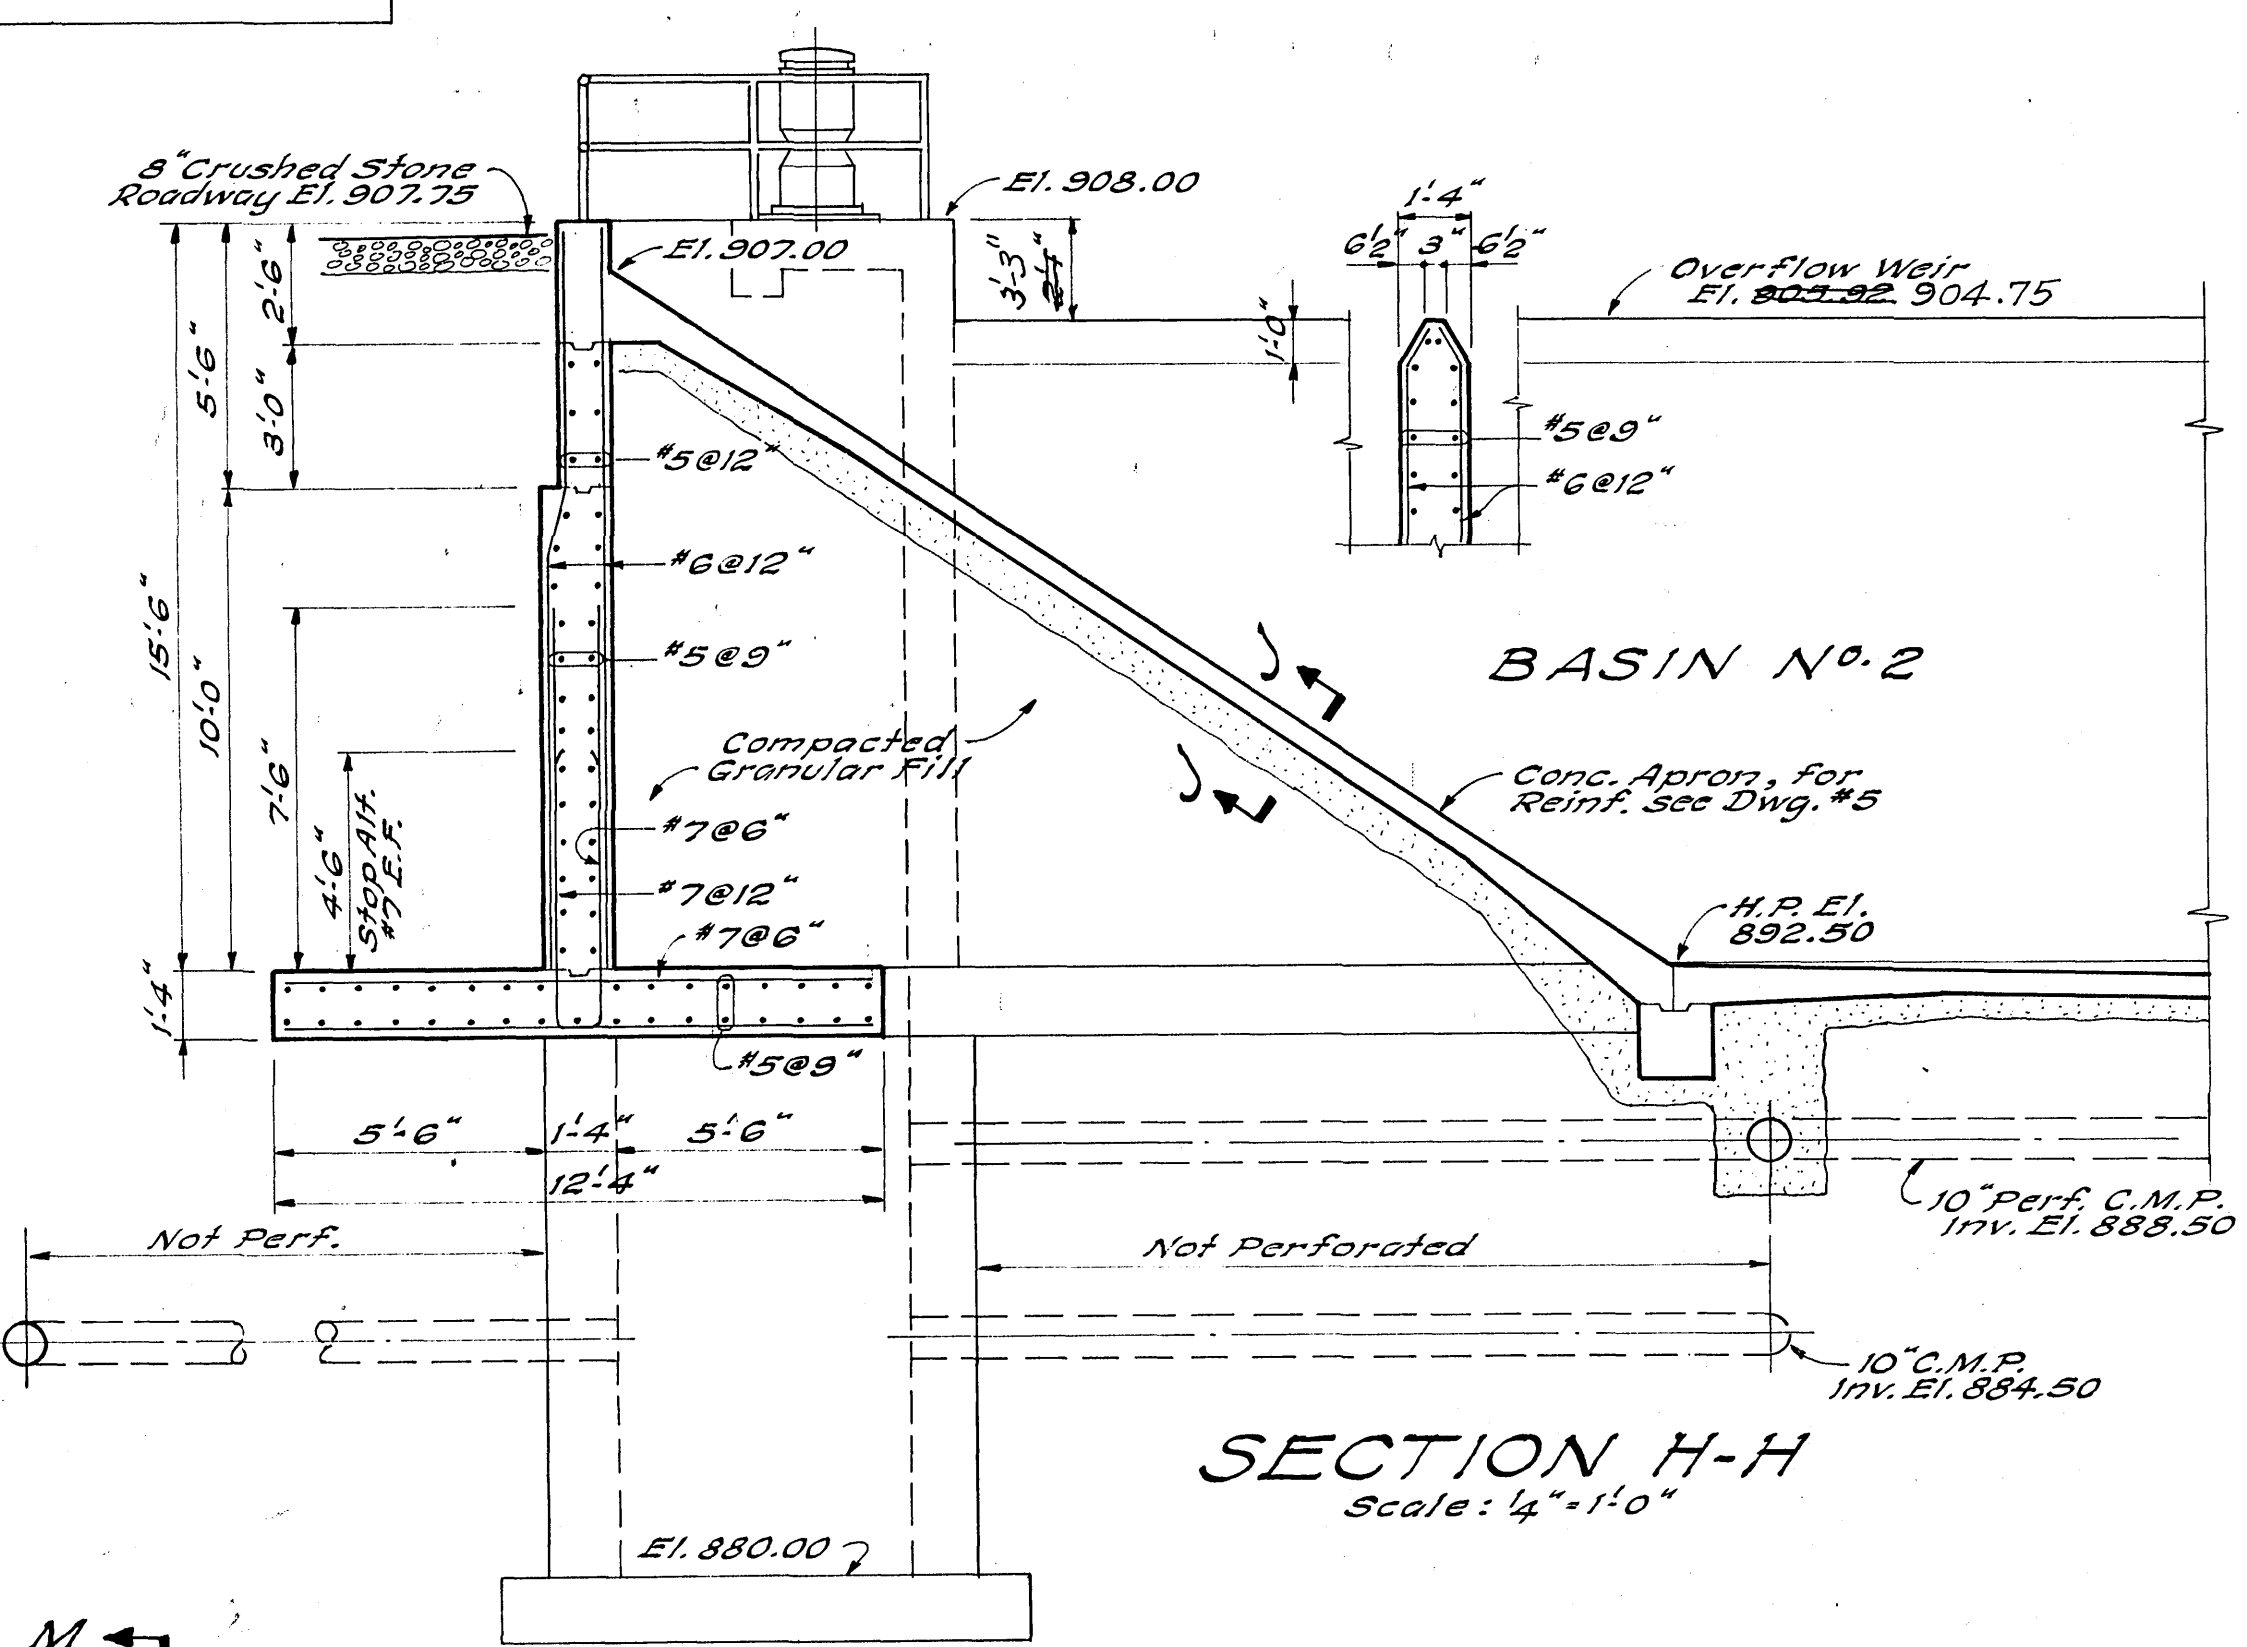
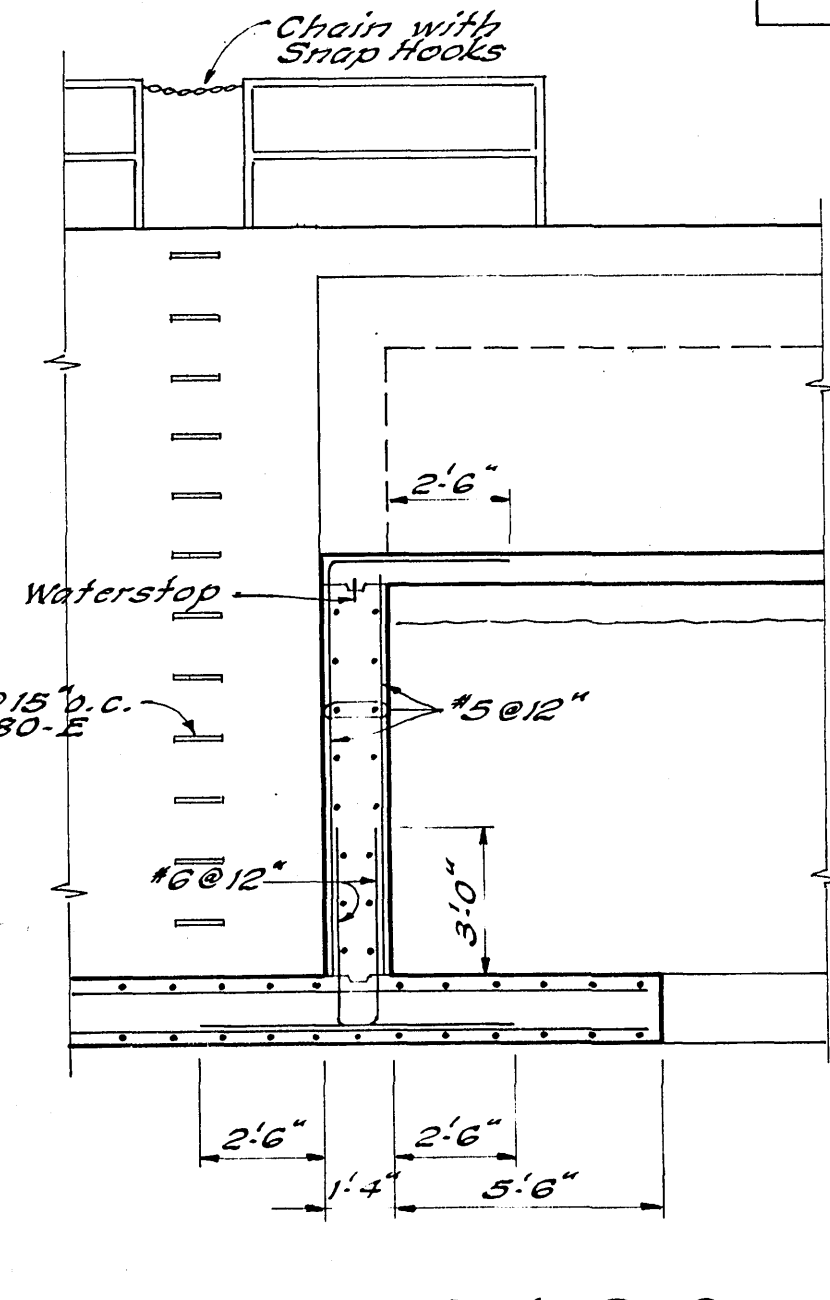
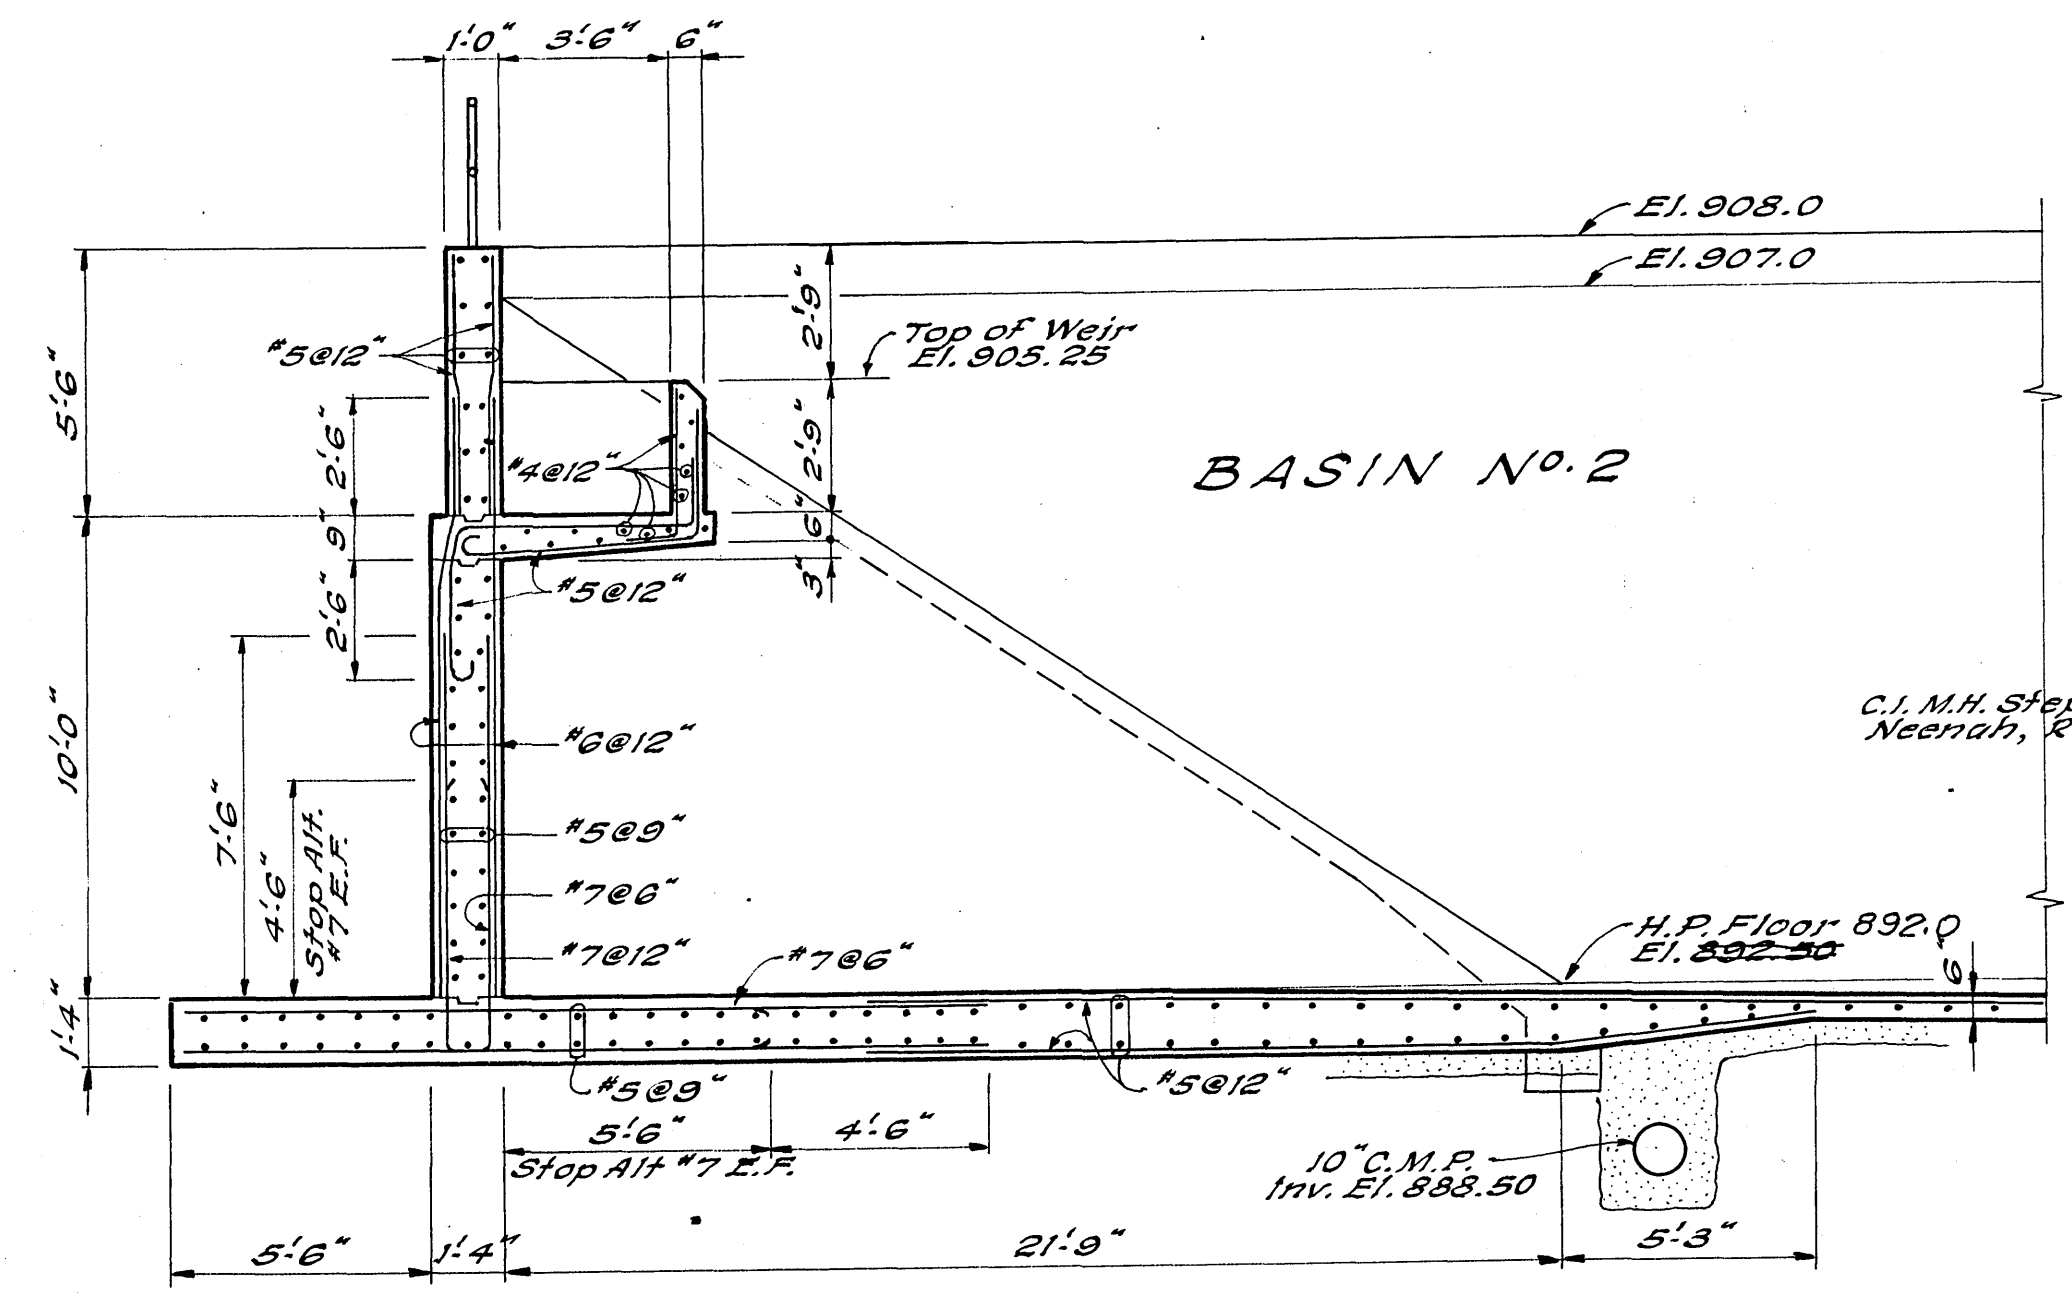


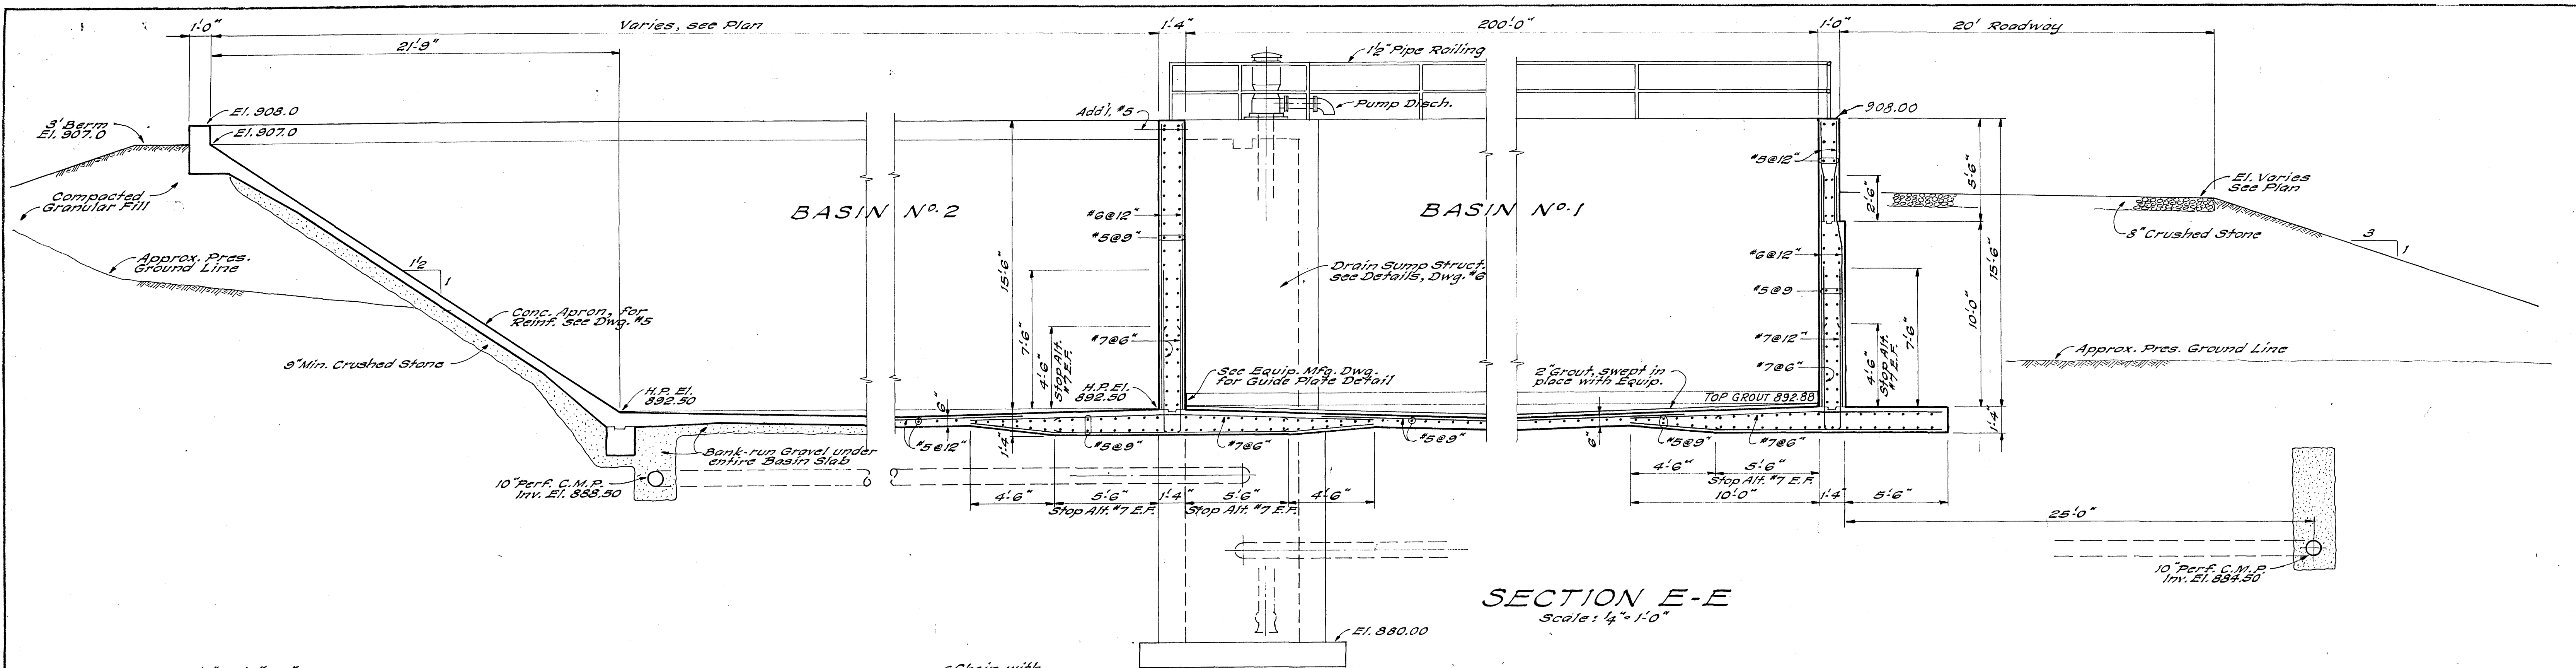

AS BUILT

CONTRACT D

ADDITIONS TO SEWAGE TREATMENT PLANT
ROANOKE, VIRGINIA

30 MG BASIN SECTIONS

ALYORD BURDICK & HOWSON
ENGINEERS CHICAGO

1973

4