
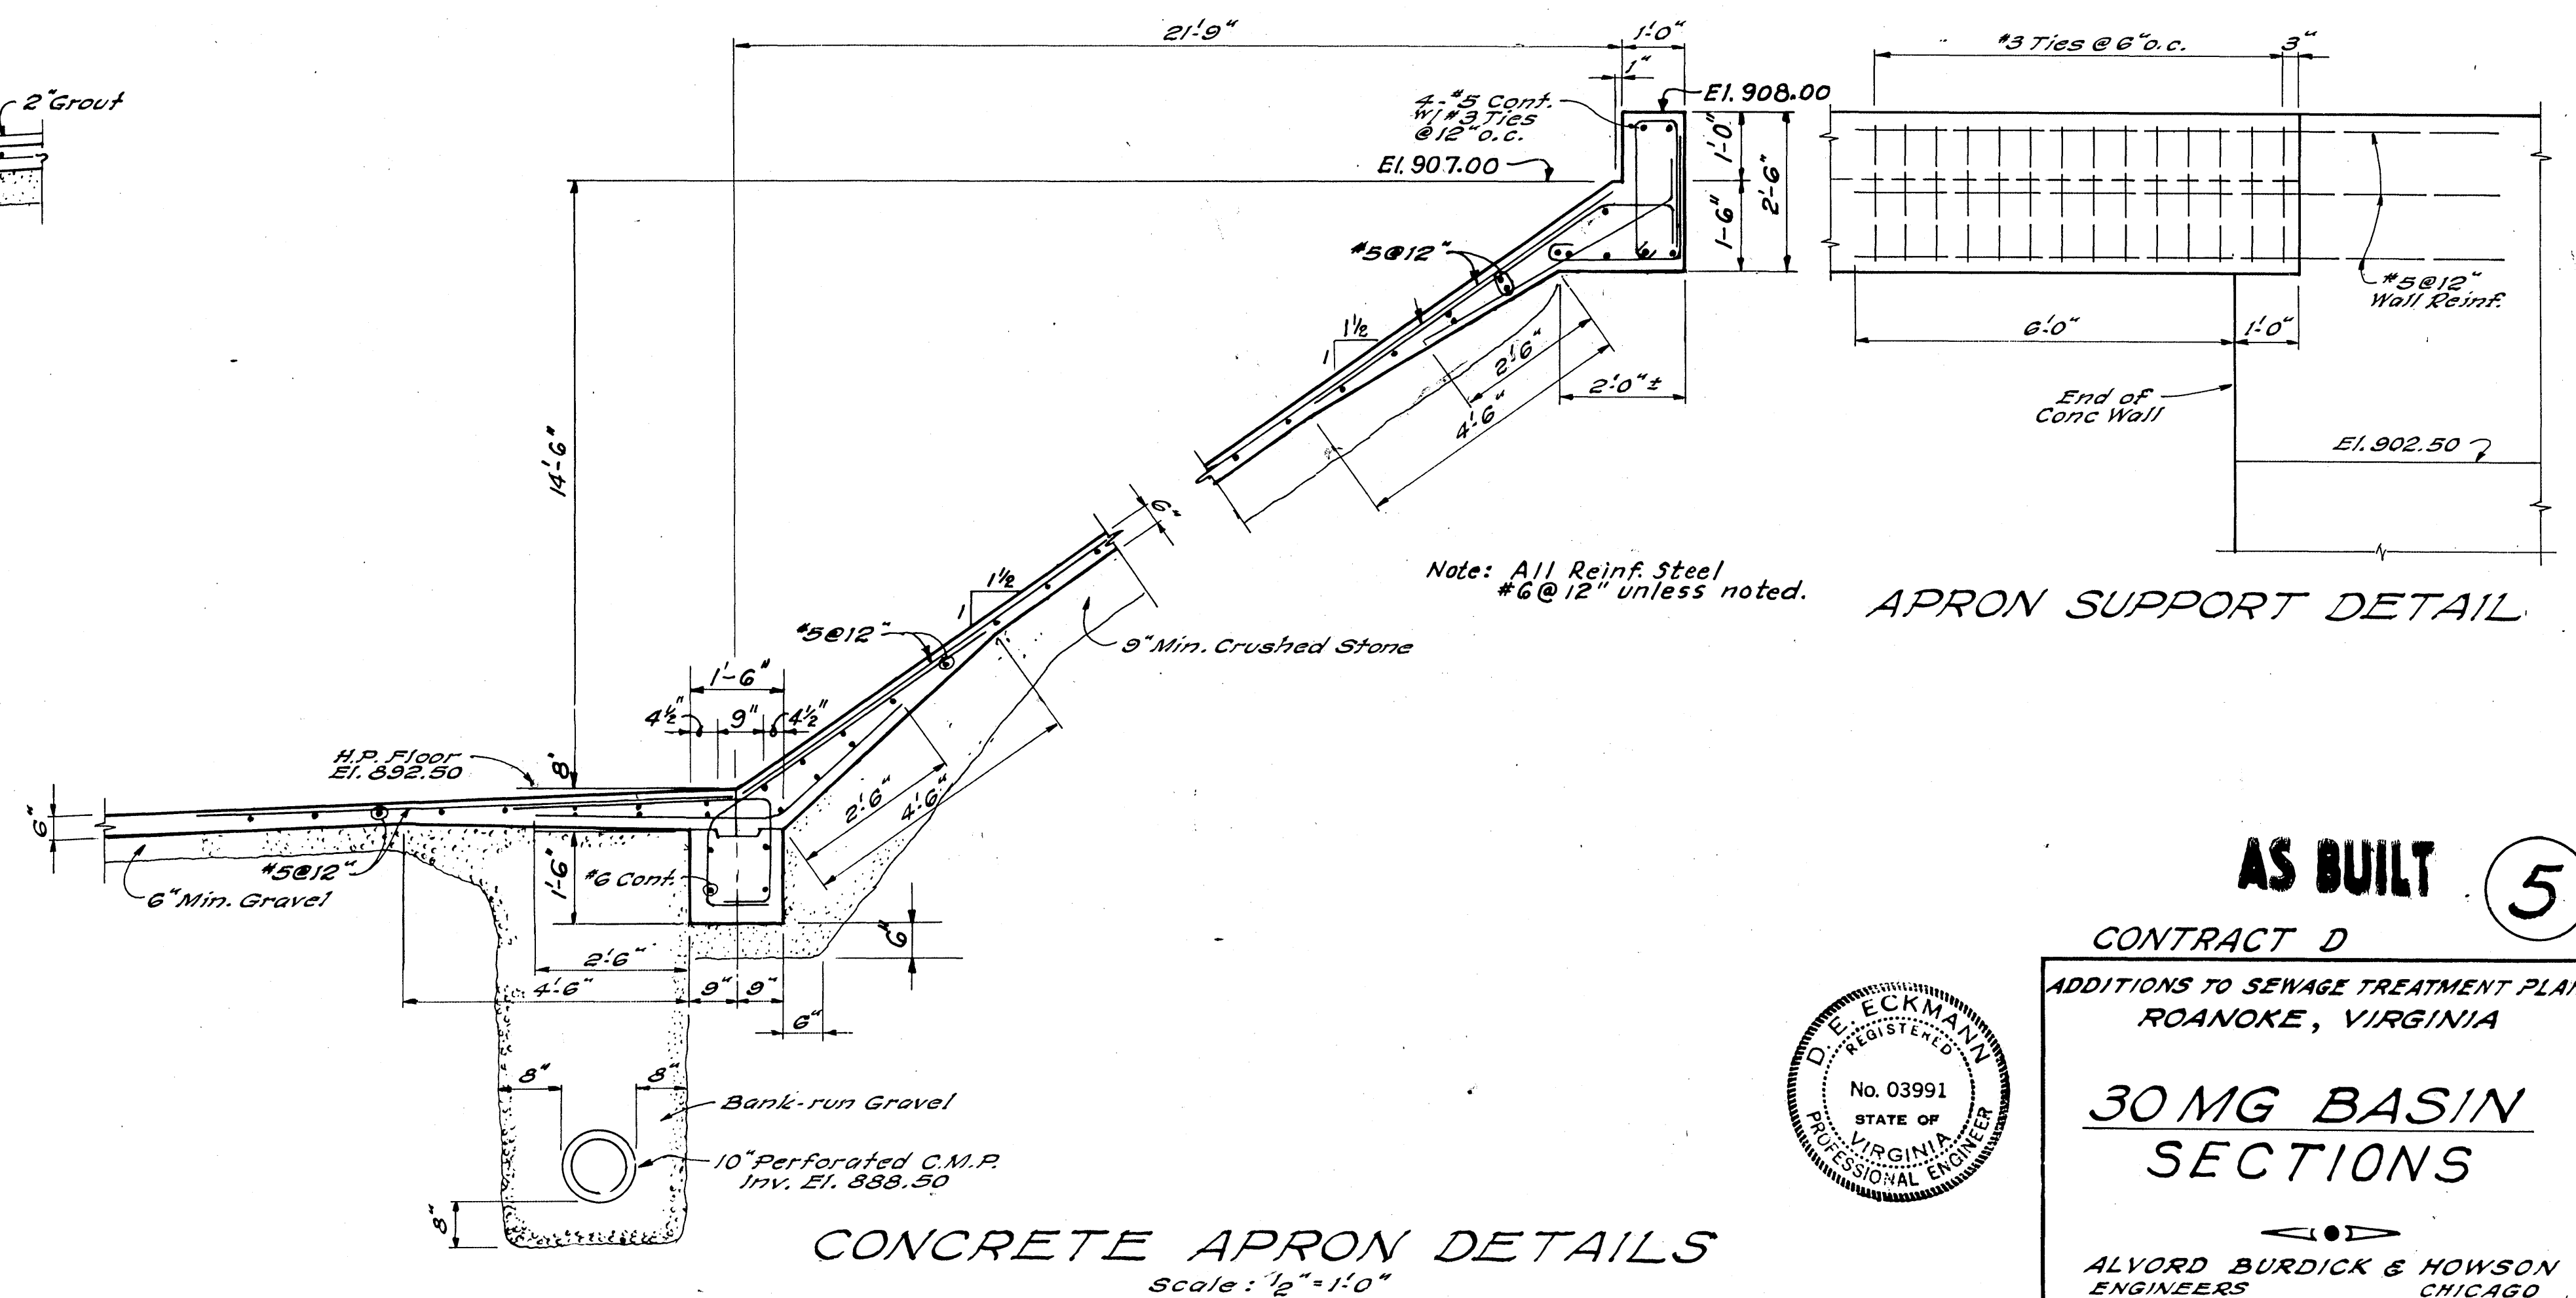
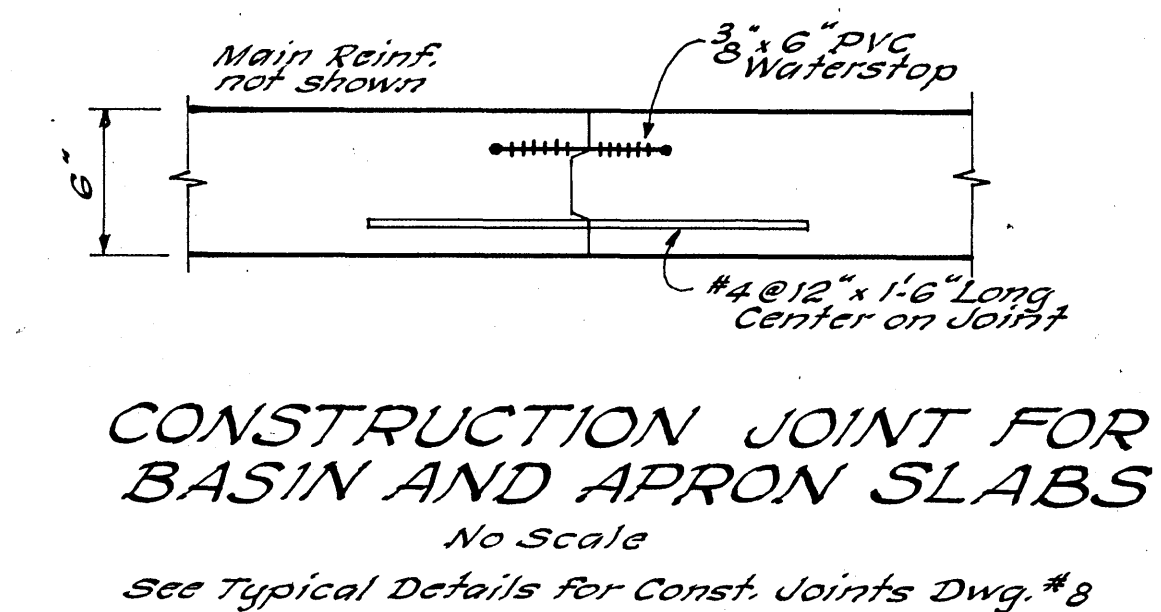
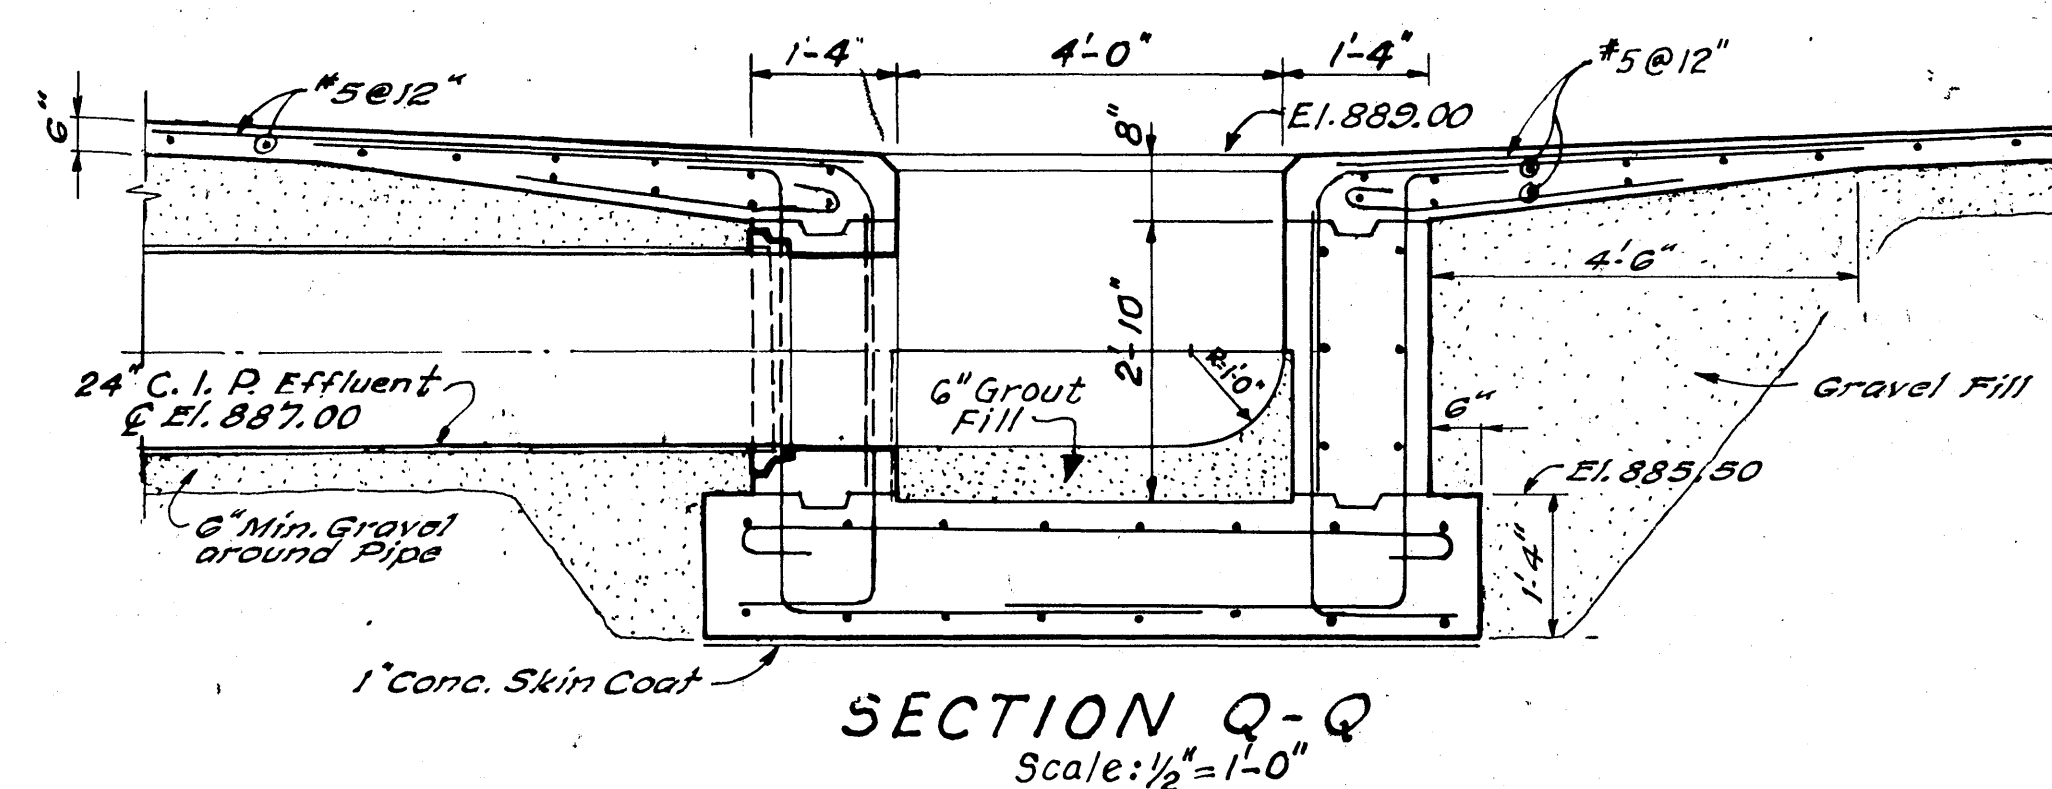
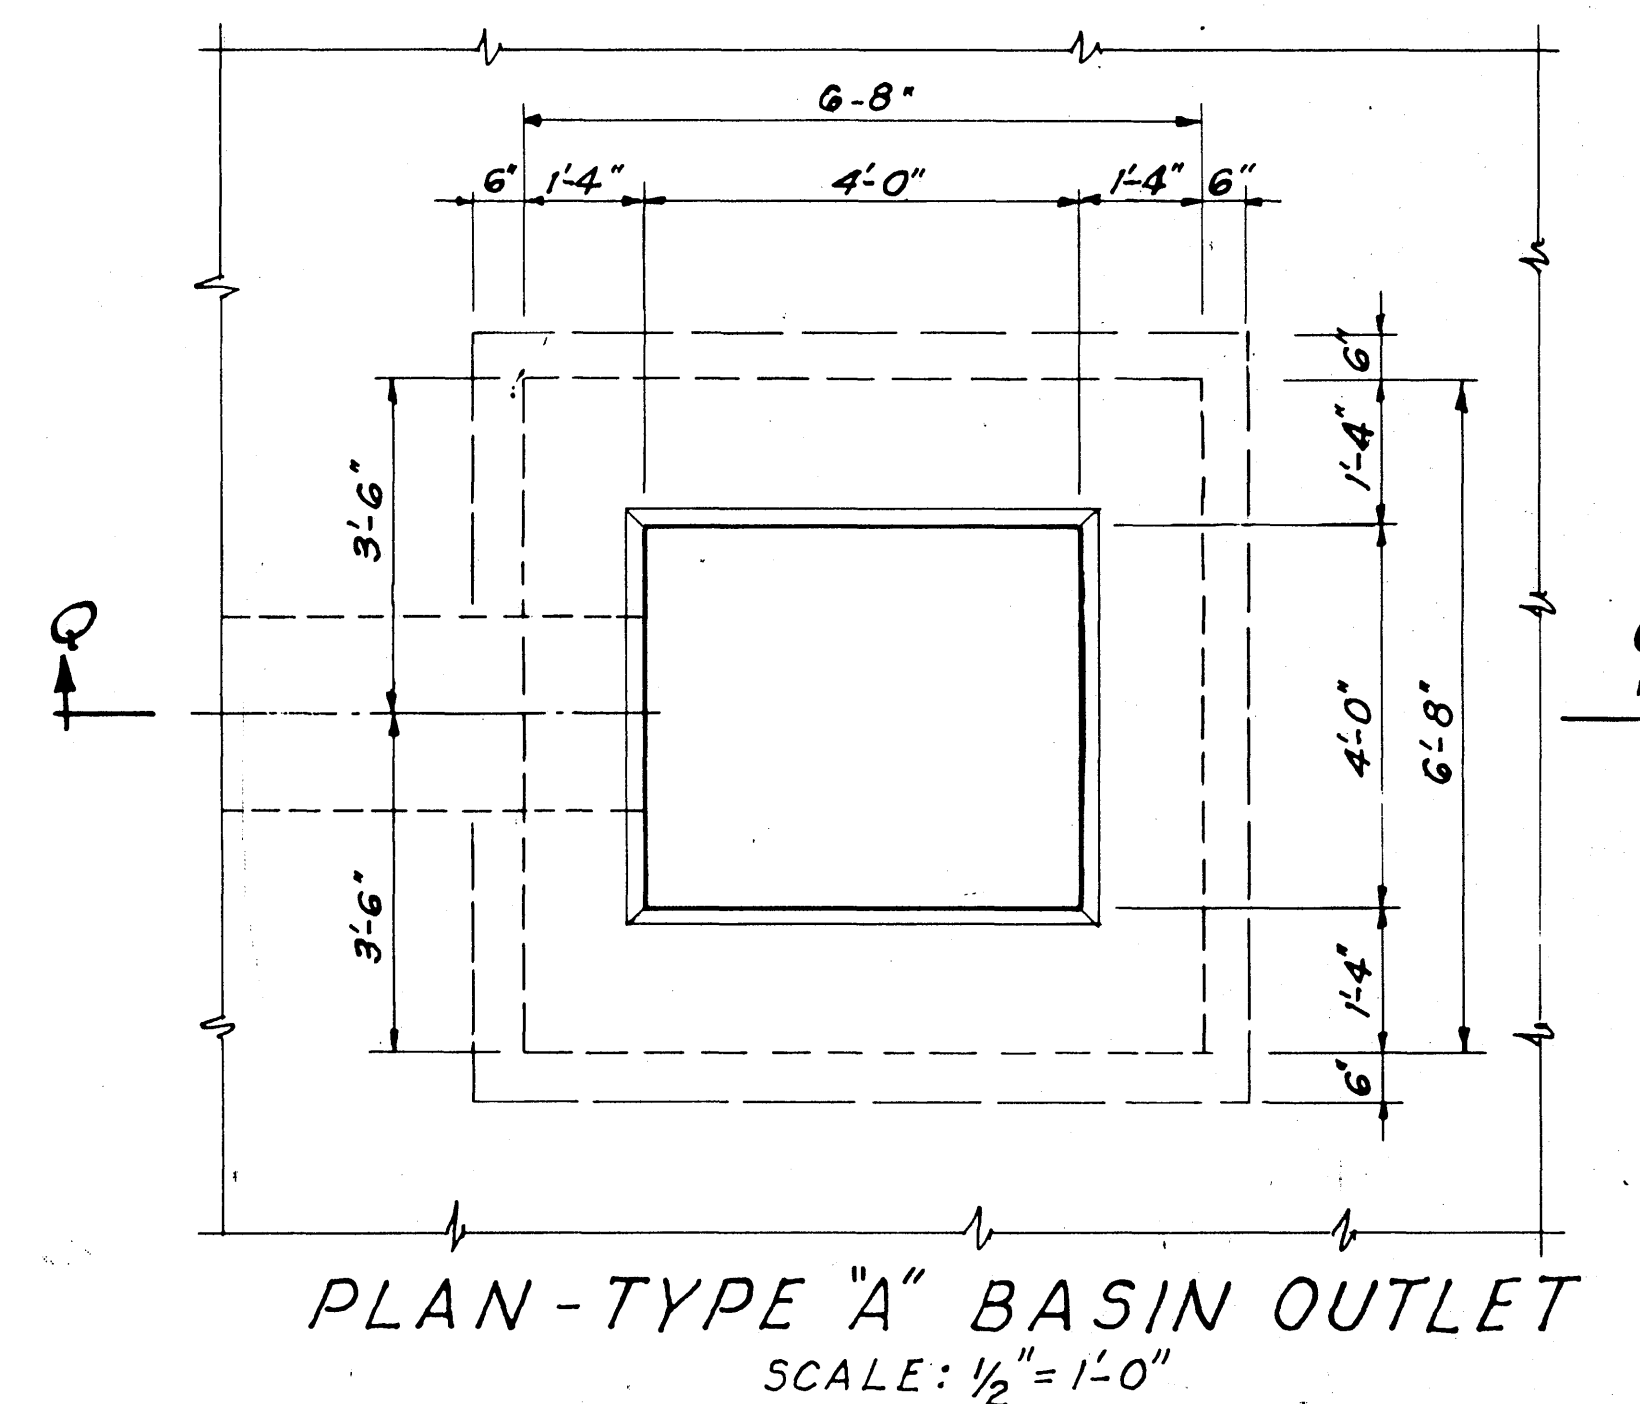
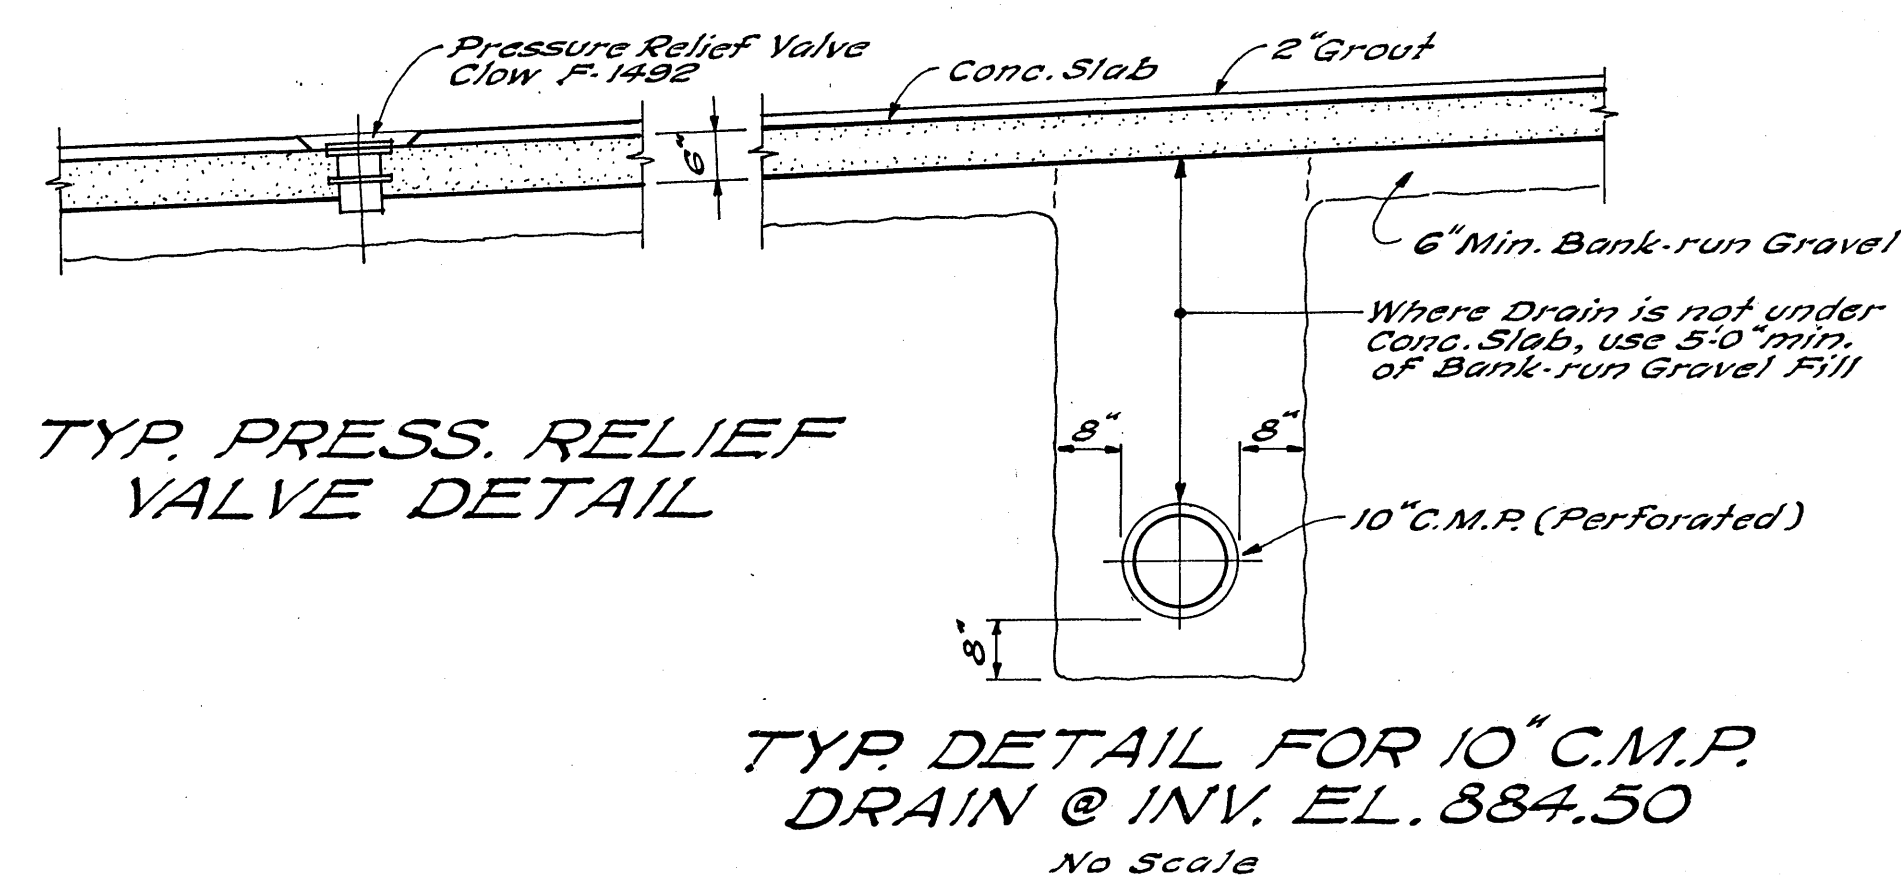
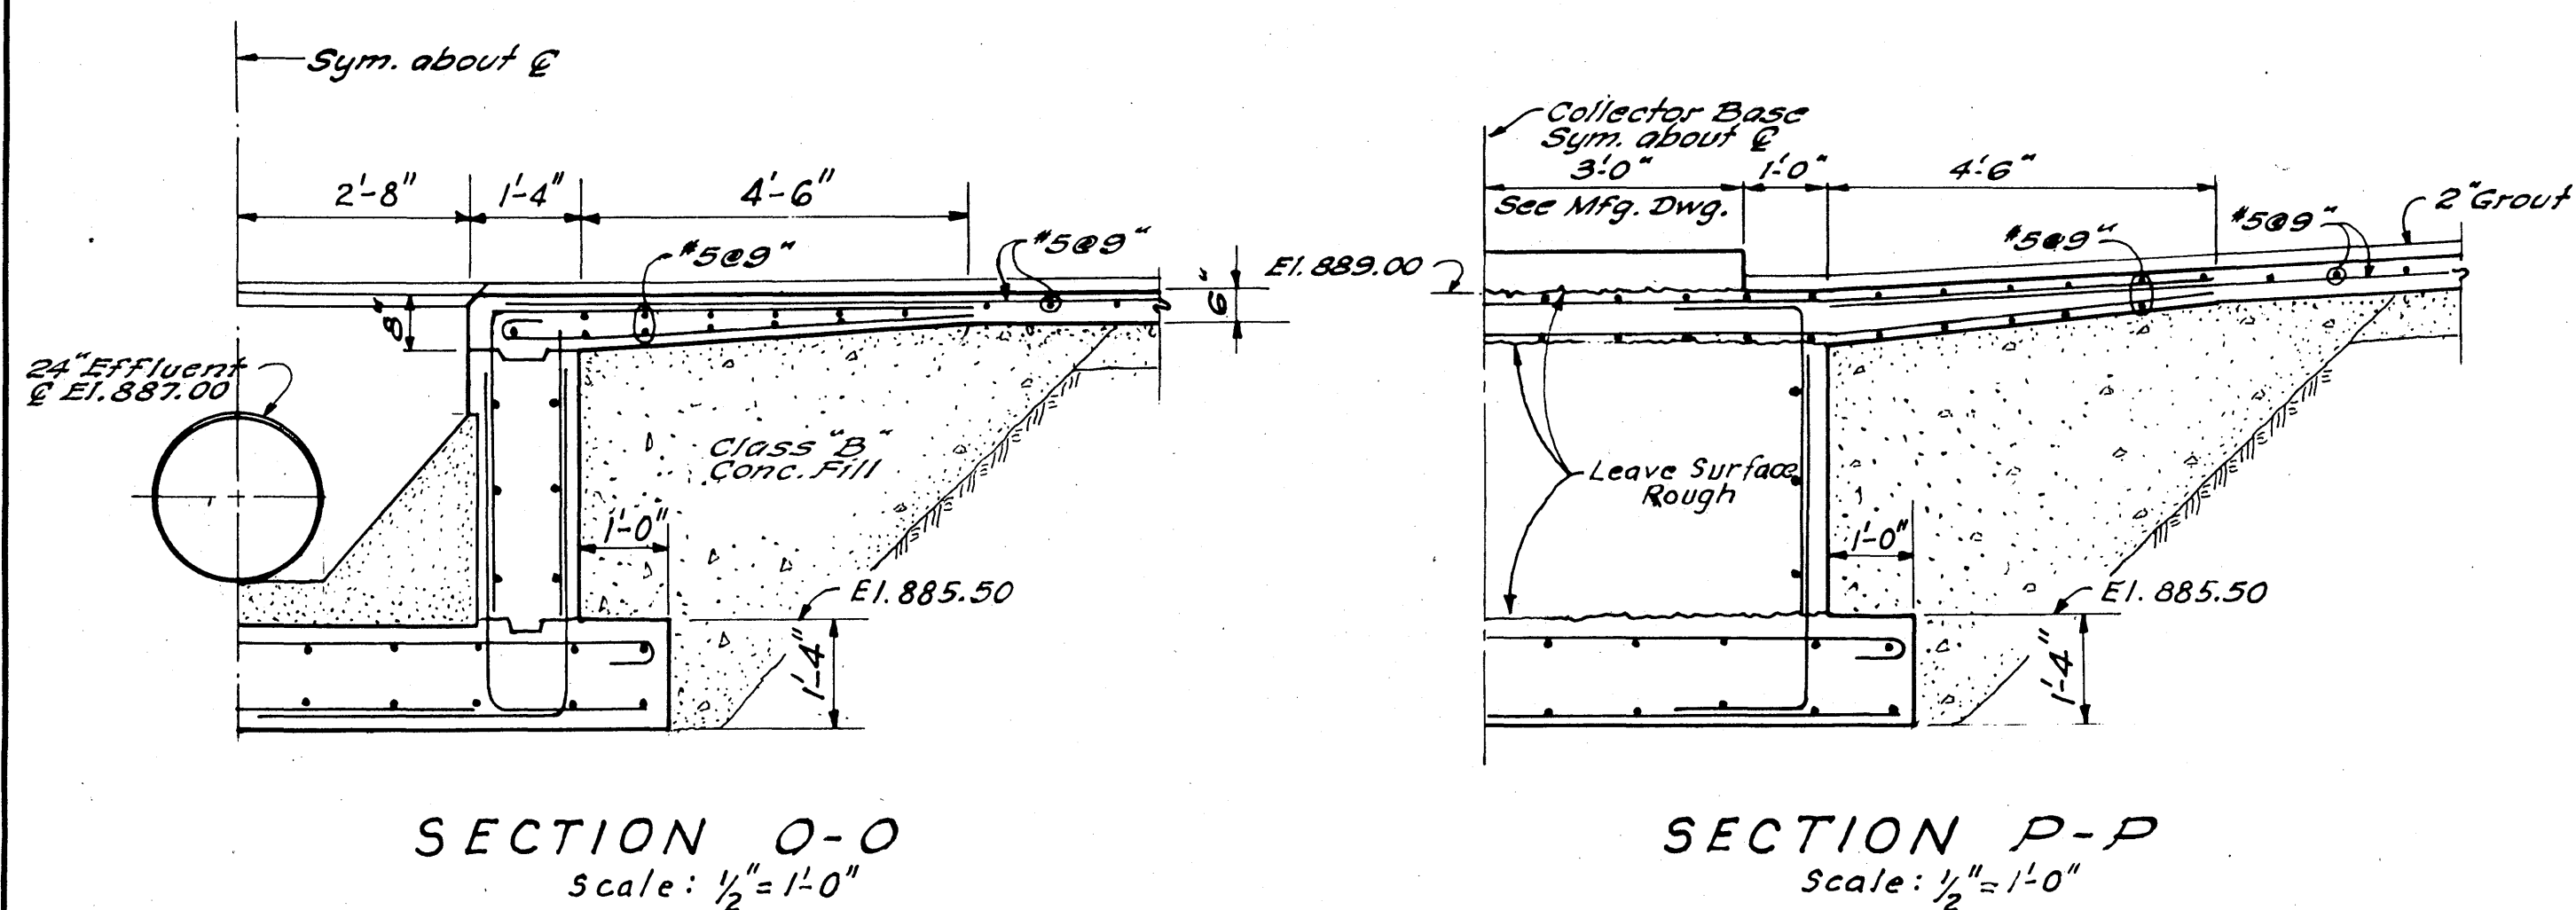
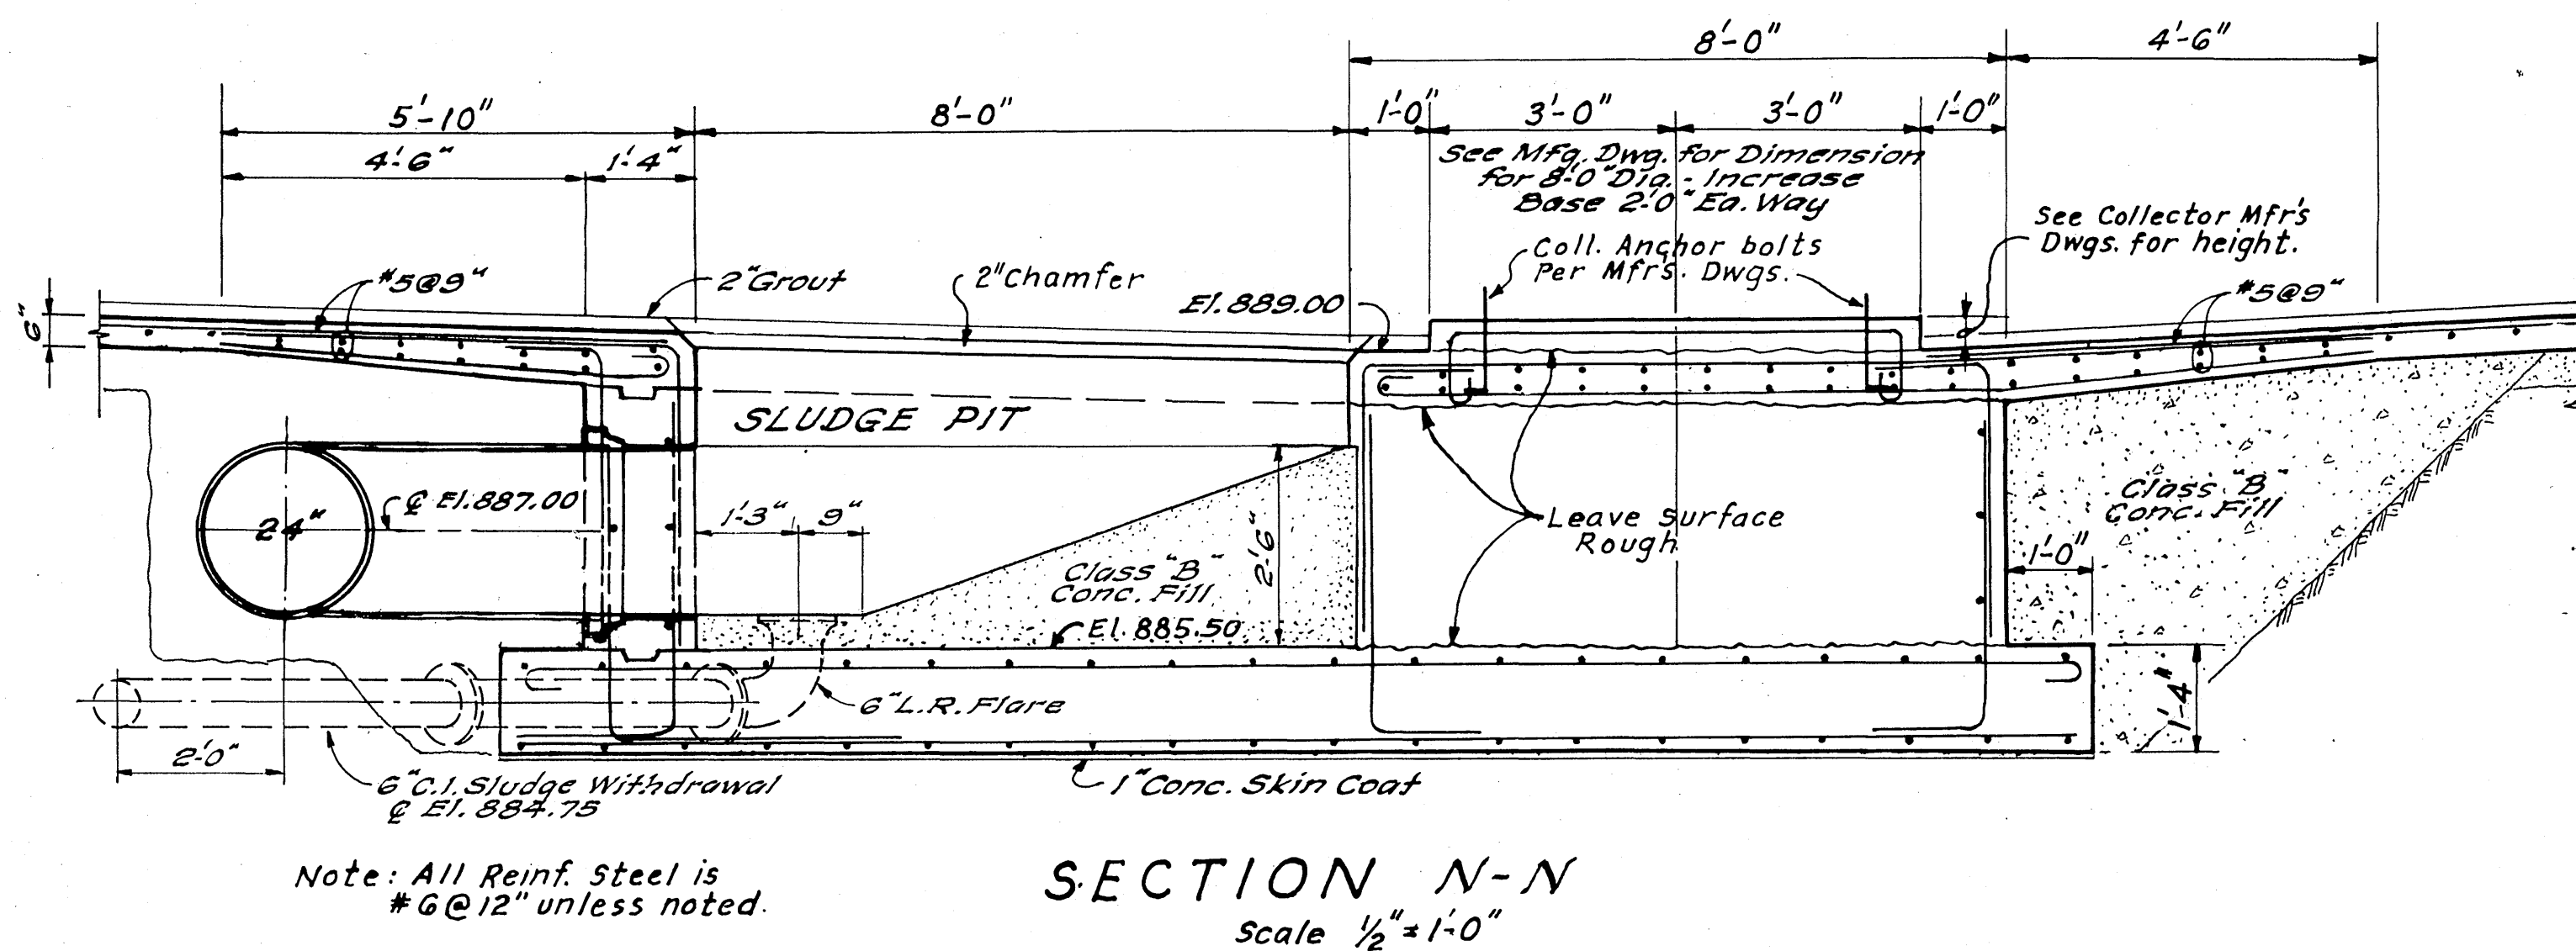


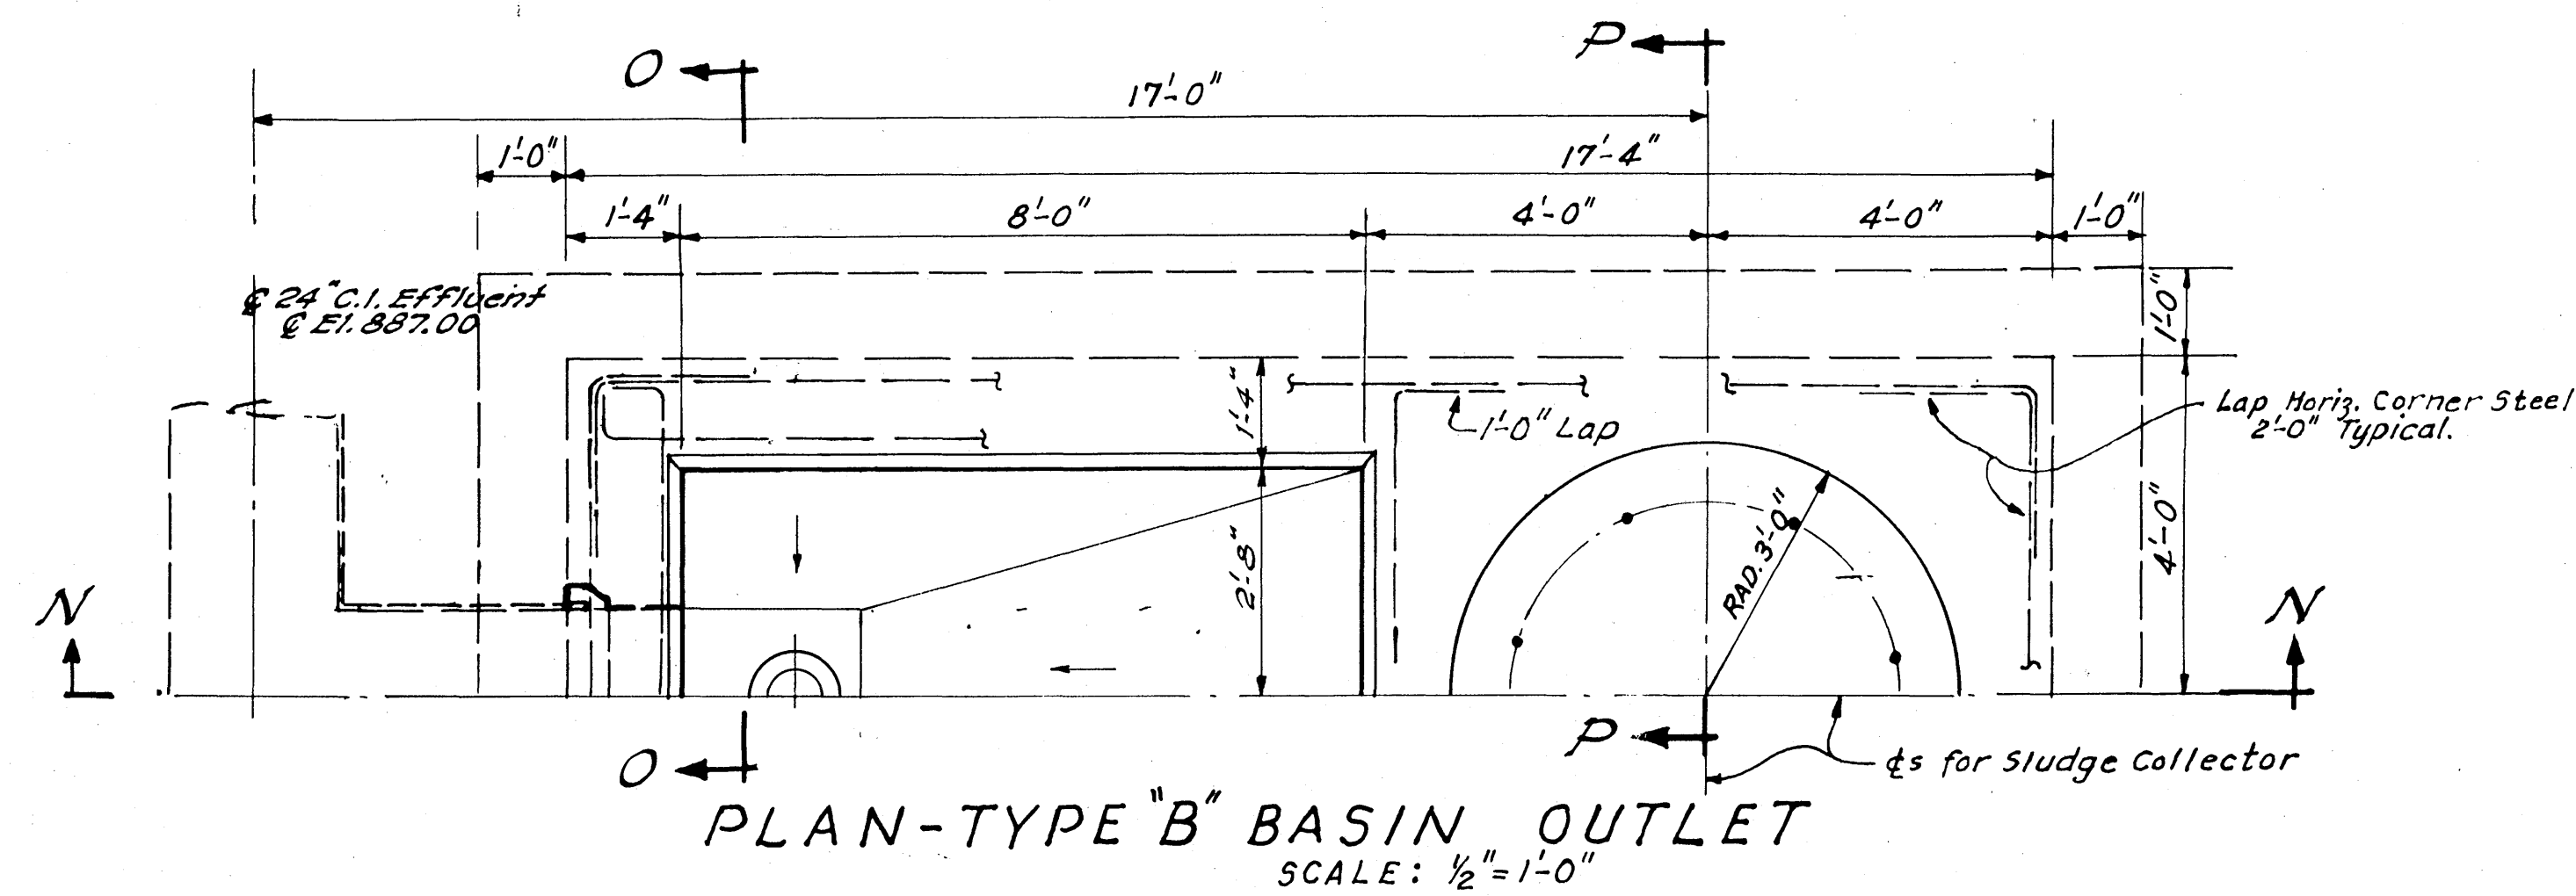

AS BUILT 5

CONTRACT D

ADDITIONS TO SEWAGE TREATMENT PLANT
ROANOKE, VIRGINIA

30 MG BASIN
SECTIONS

ALVORD BURDICK & HOWSON
ENGINEERS CHICAGO
1973

