




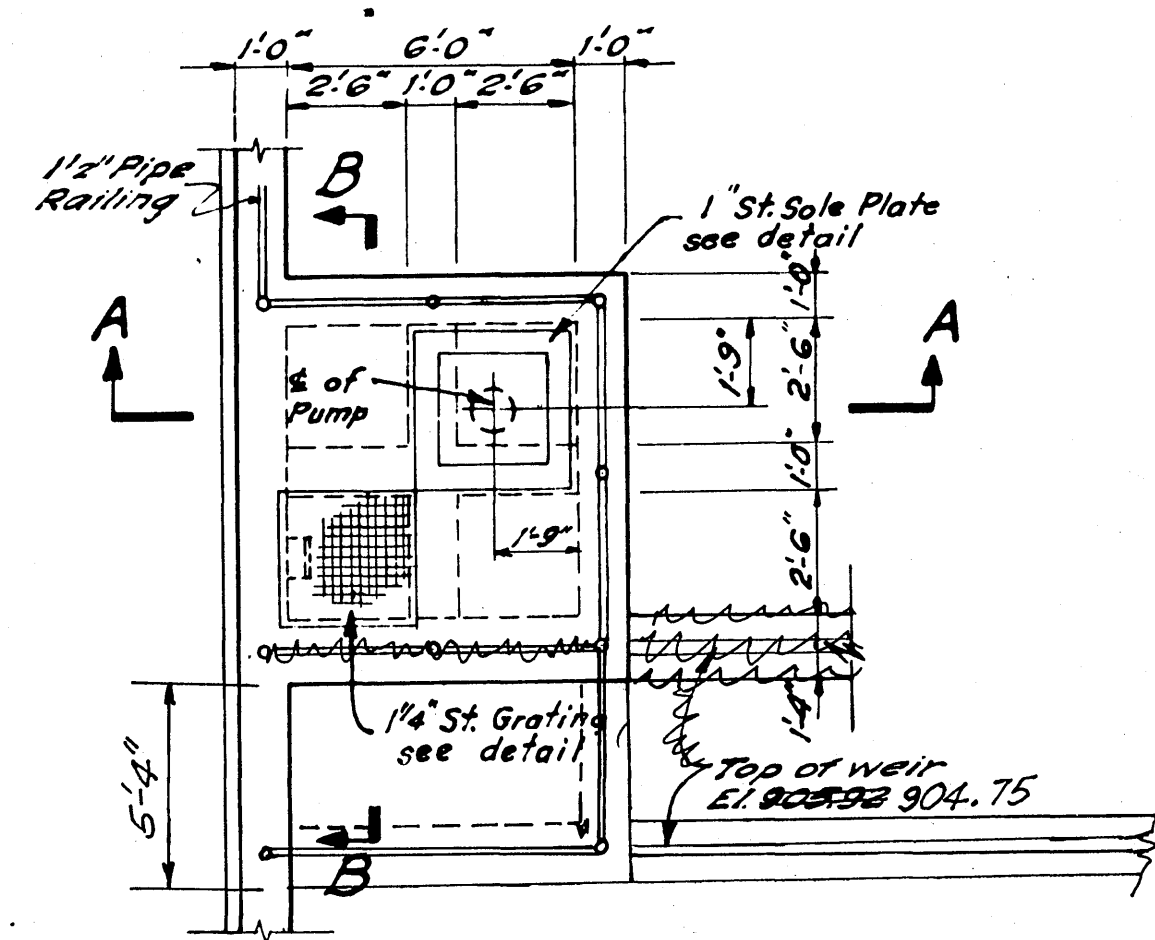


PLAN C ELEV. 908.0
Scale: 1/4" = 1'-0"

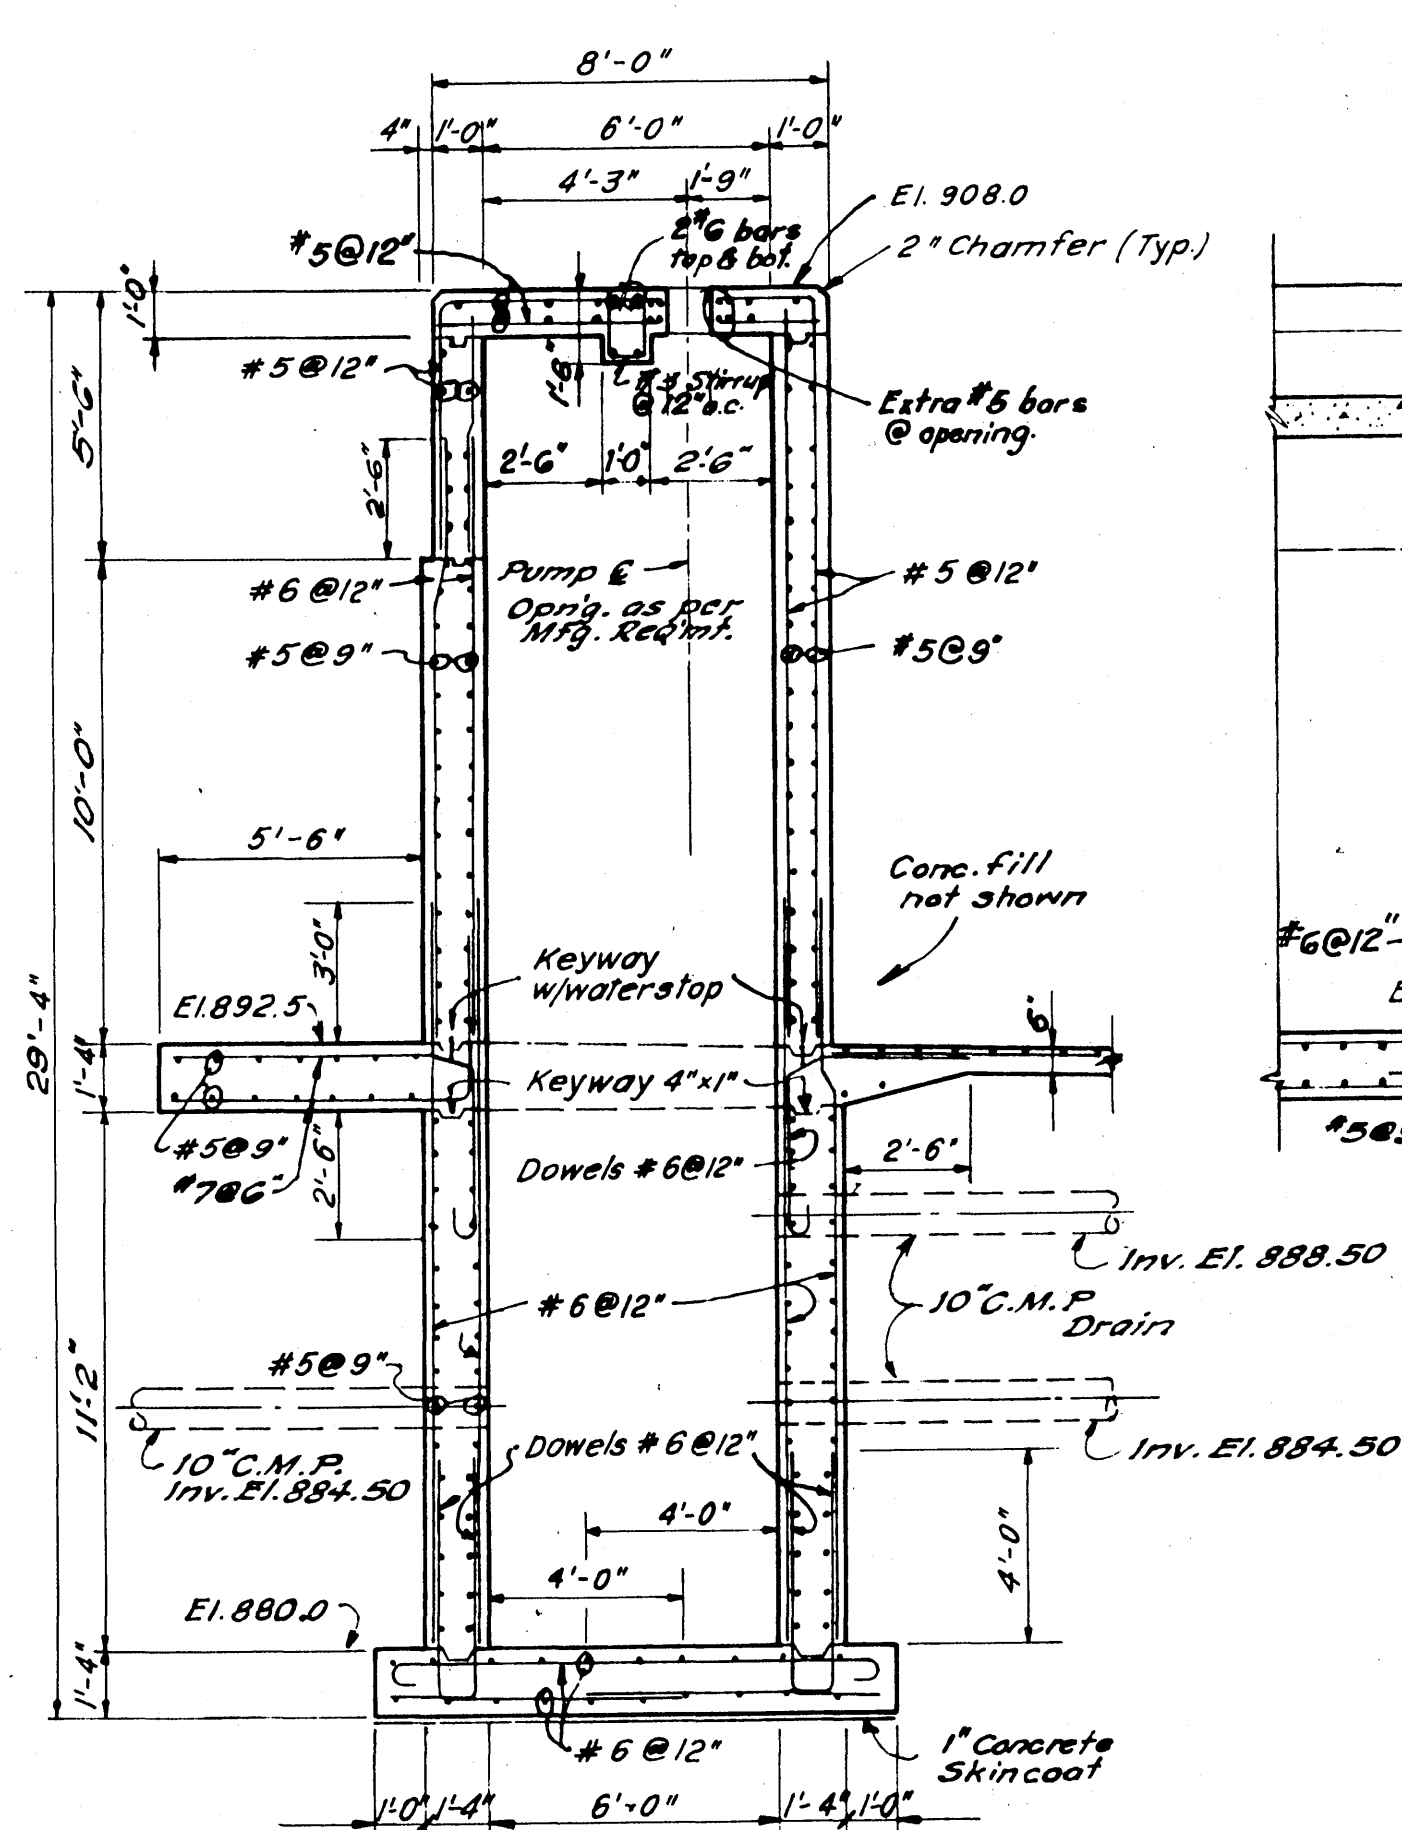

SECTION A-A
Scale: 1/4" = 1'-0"

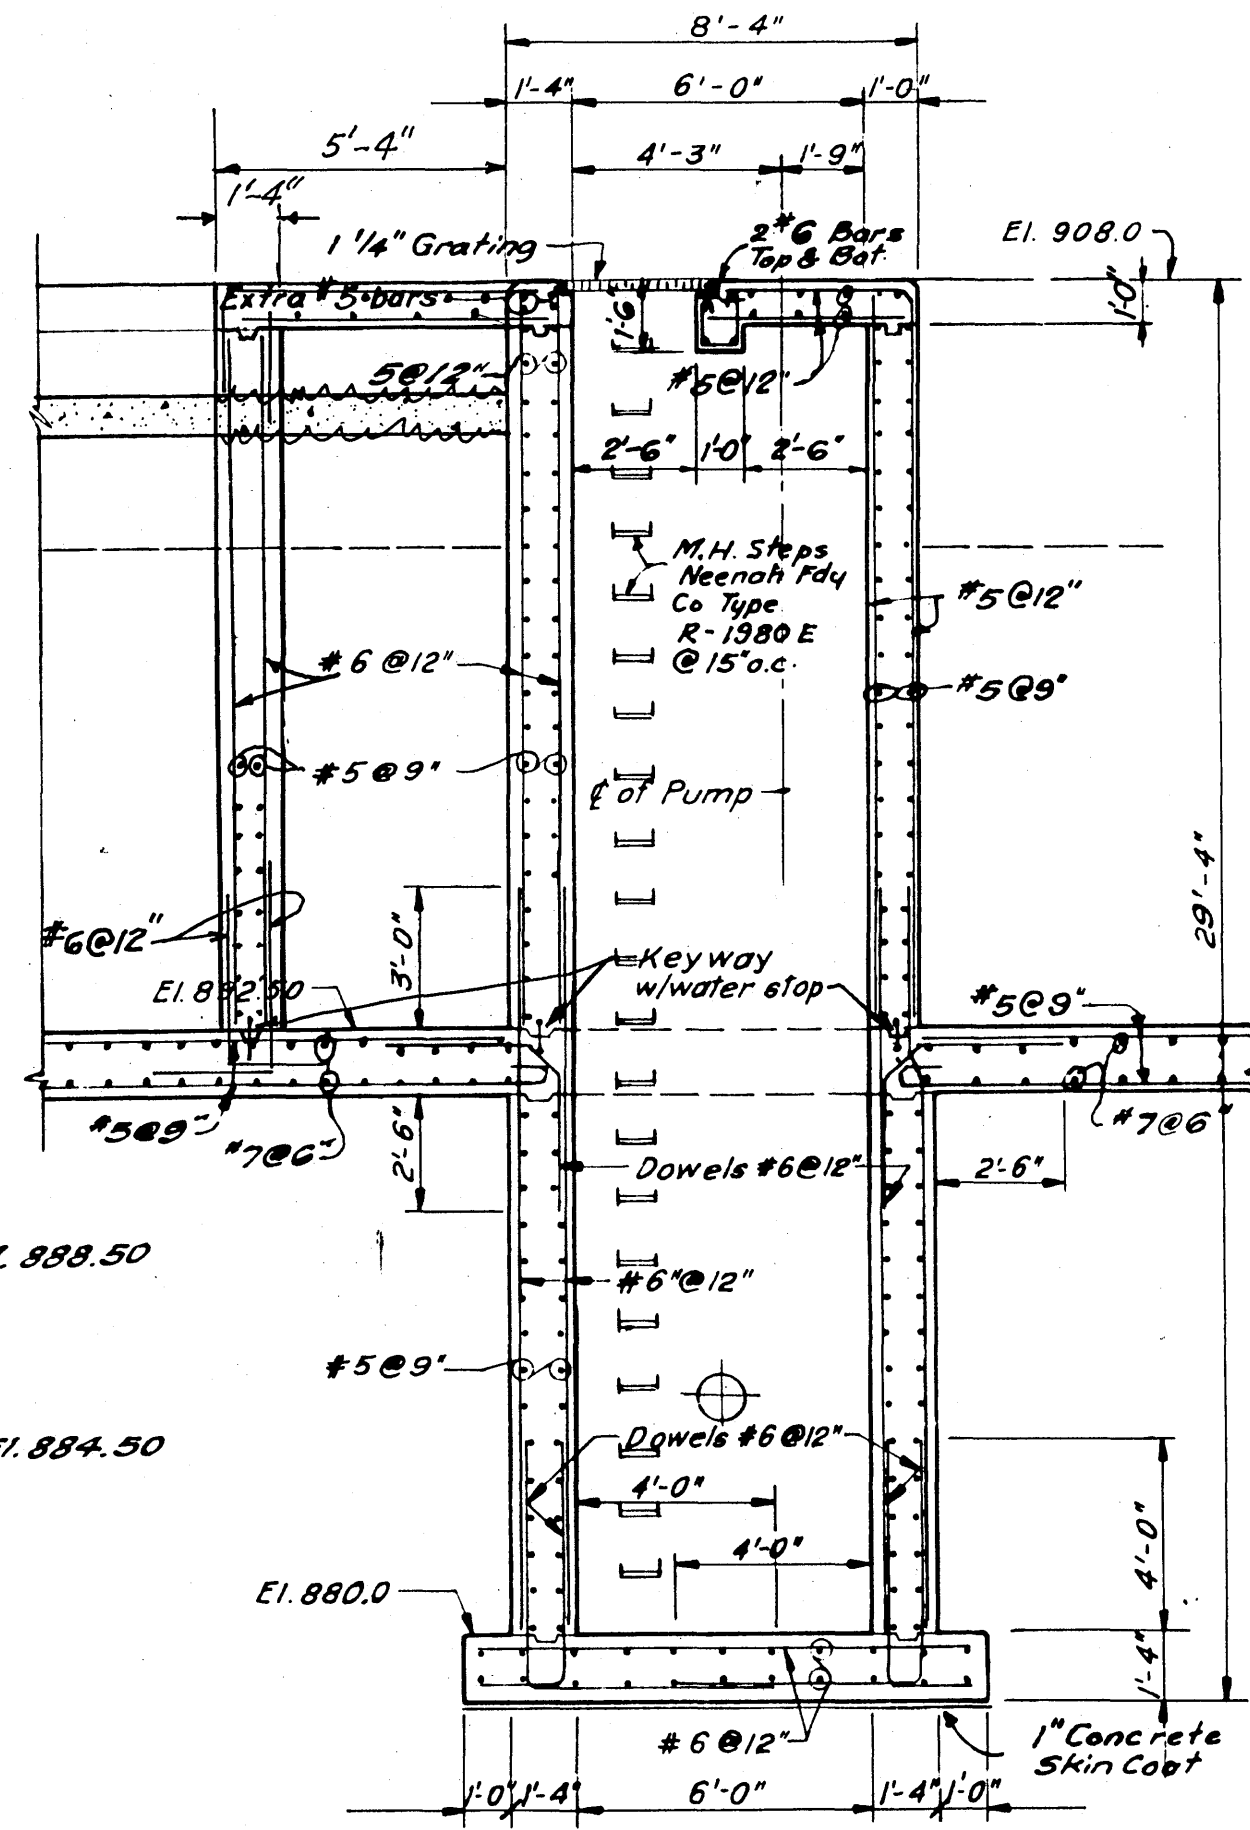


SECTION B-B

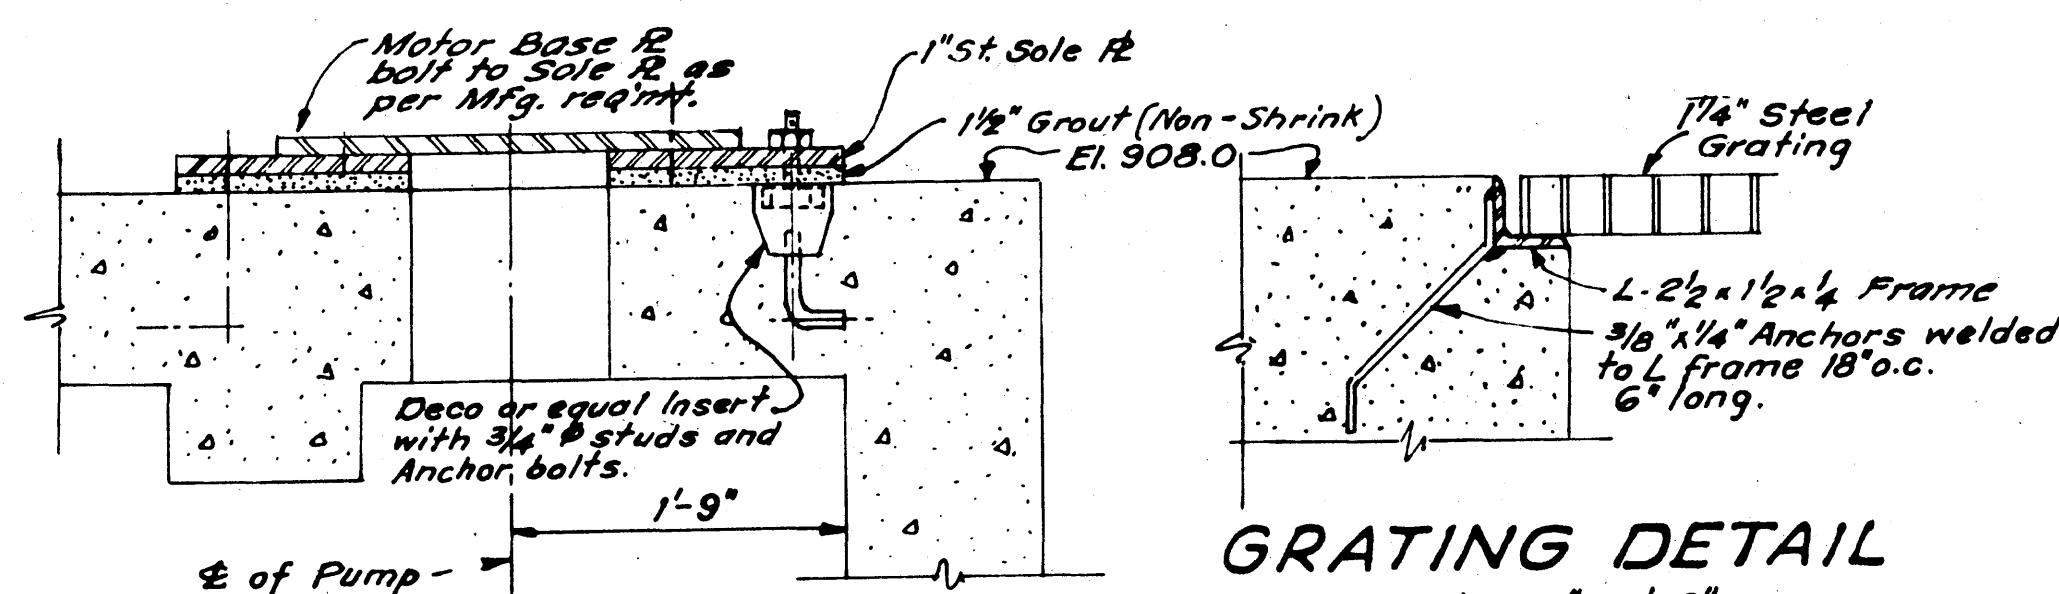


GRATING DETAIL
Scale: 3" = 1'-0"


1" STEEL SOLE PLATE DETAIL
Scale: 1" = 1'-0"

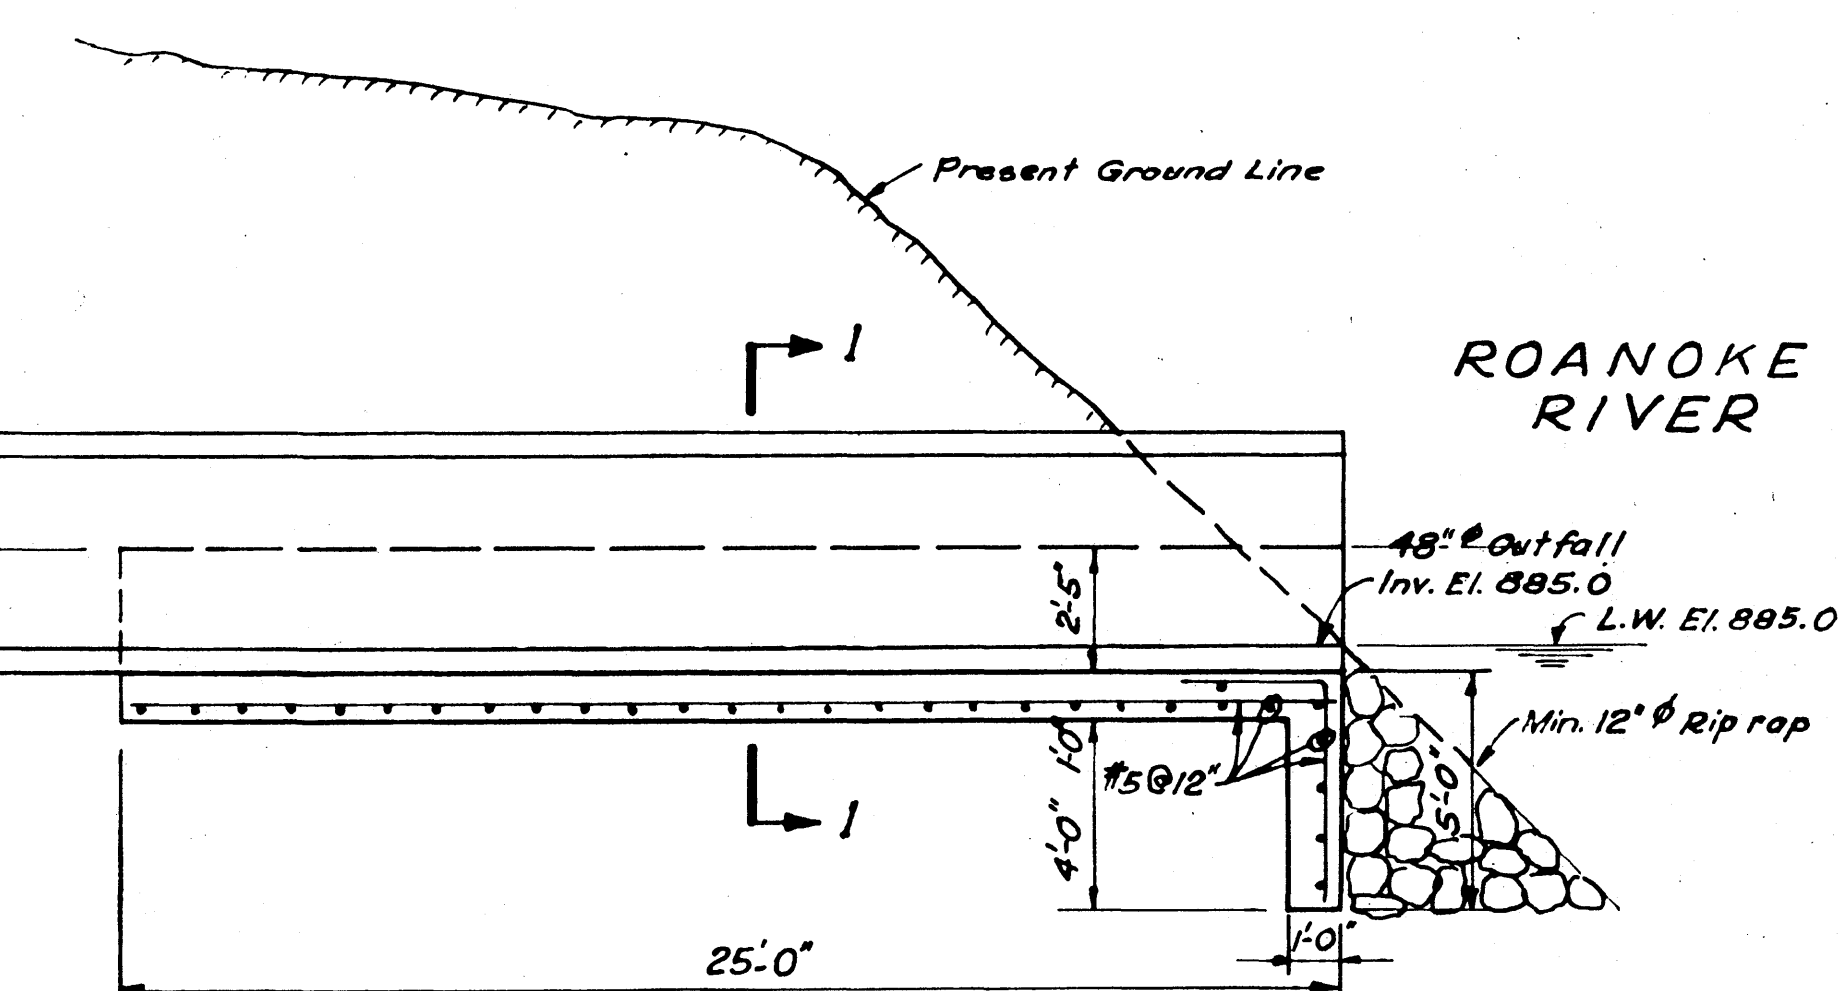


SECTION 2-2
DETAIL OF 48" Ø OUTFALL FROM 30 M.G. BASIN
Scale: 1/4" = 1'-0"

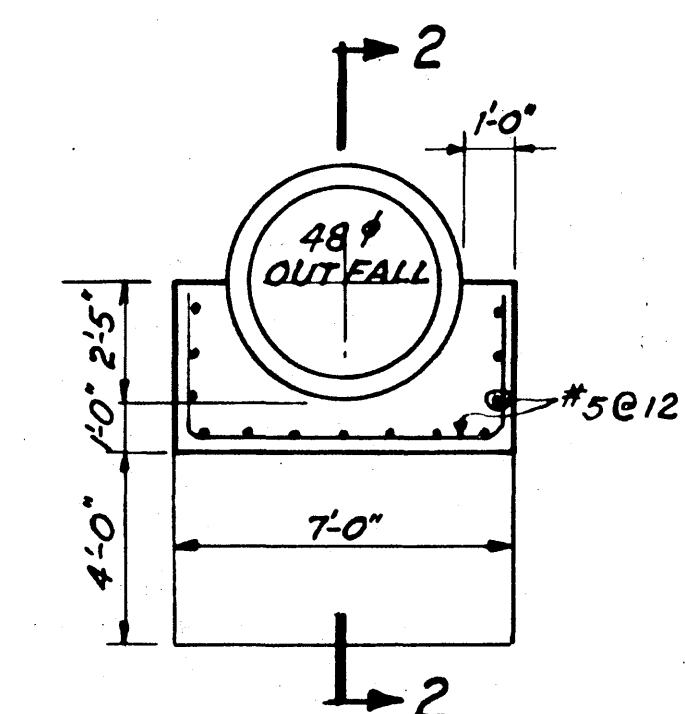


SECTION 1-1

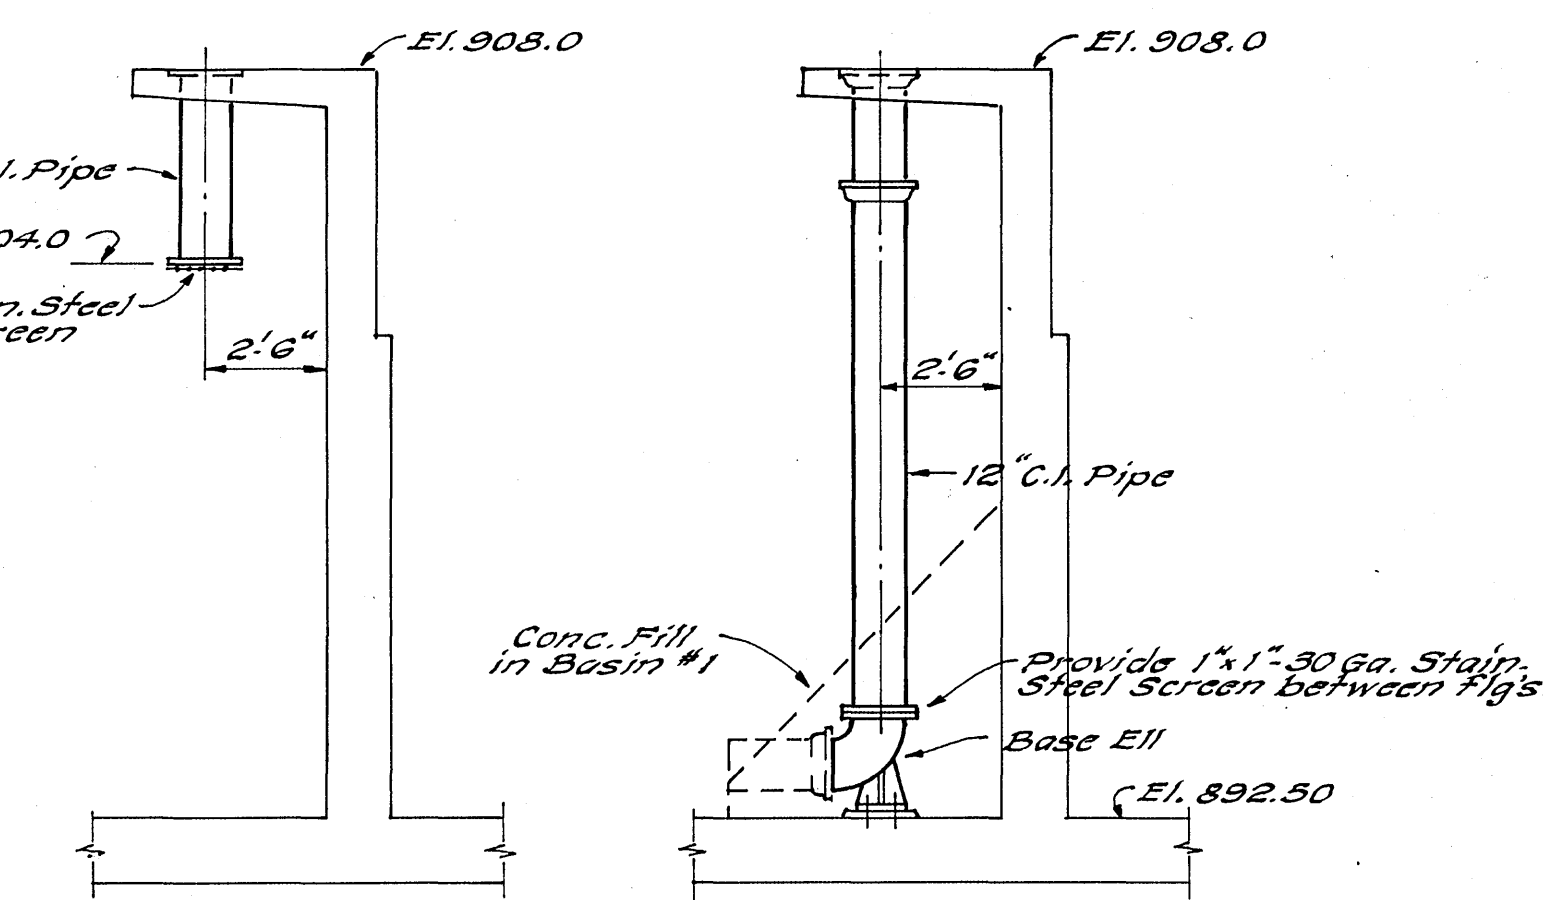


EFFLUENT FLOW INSTRUMENT STILLING WELL DETAILS

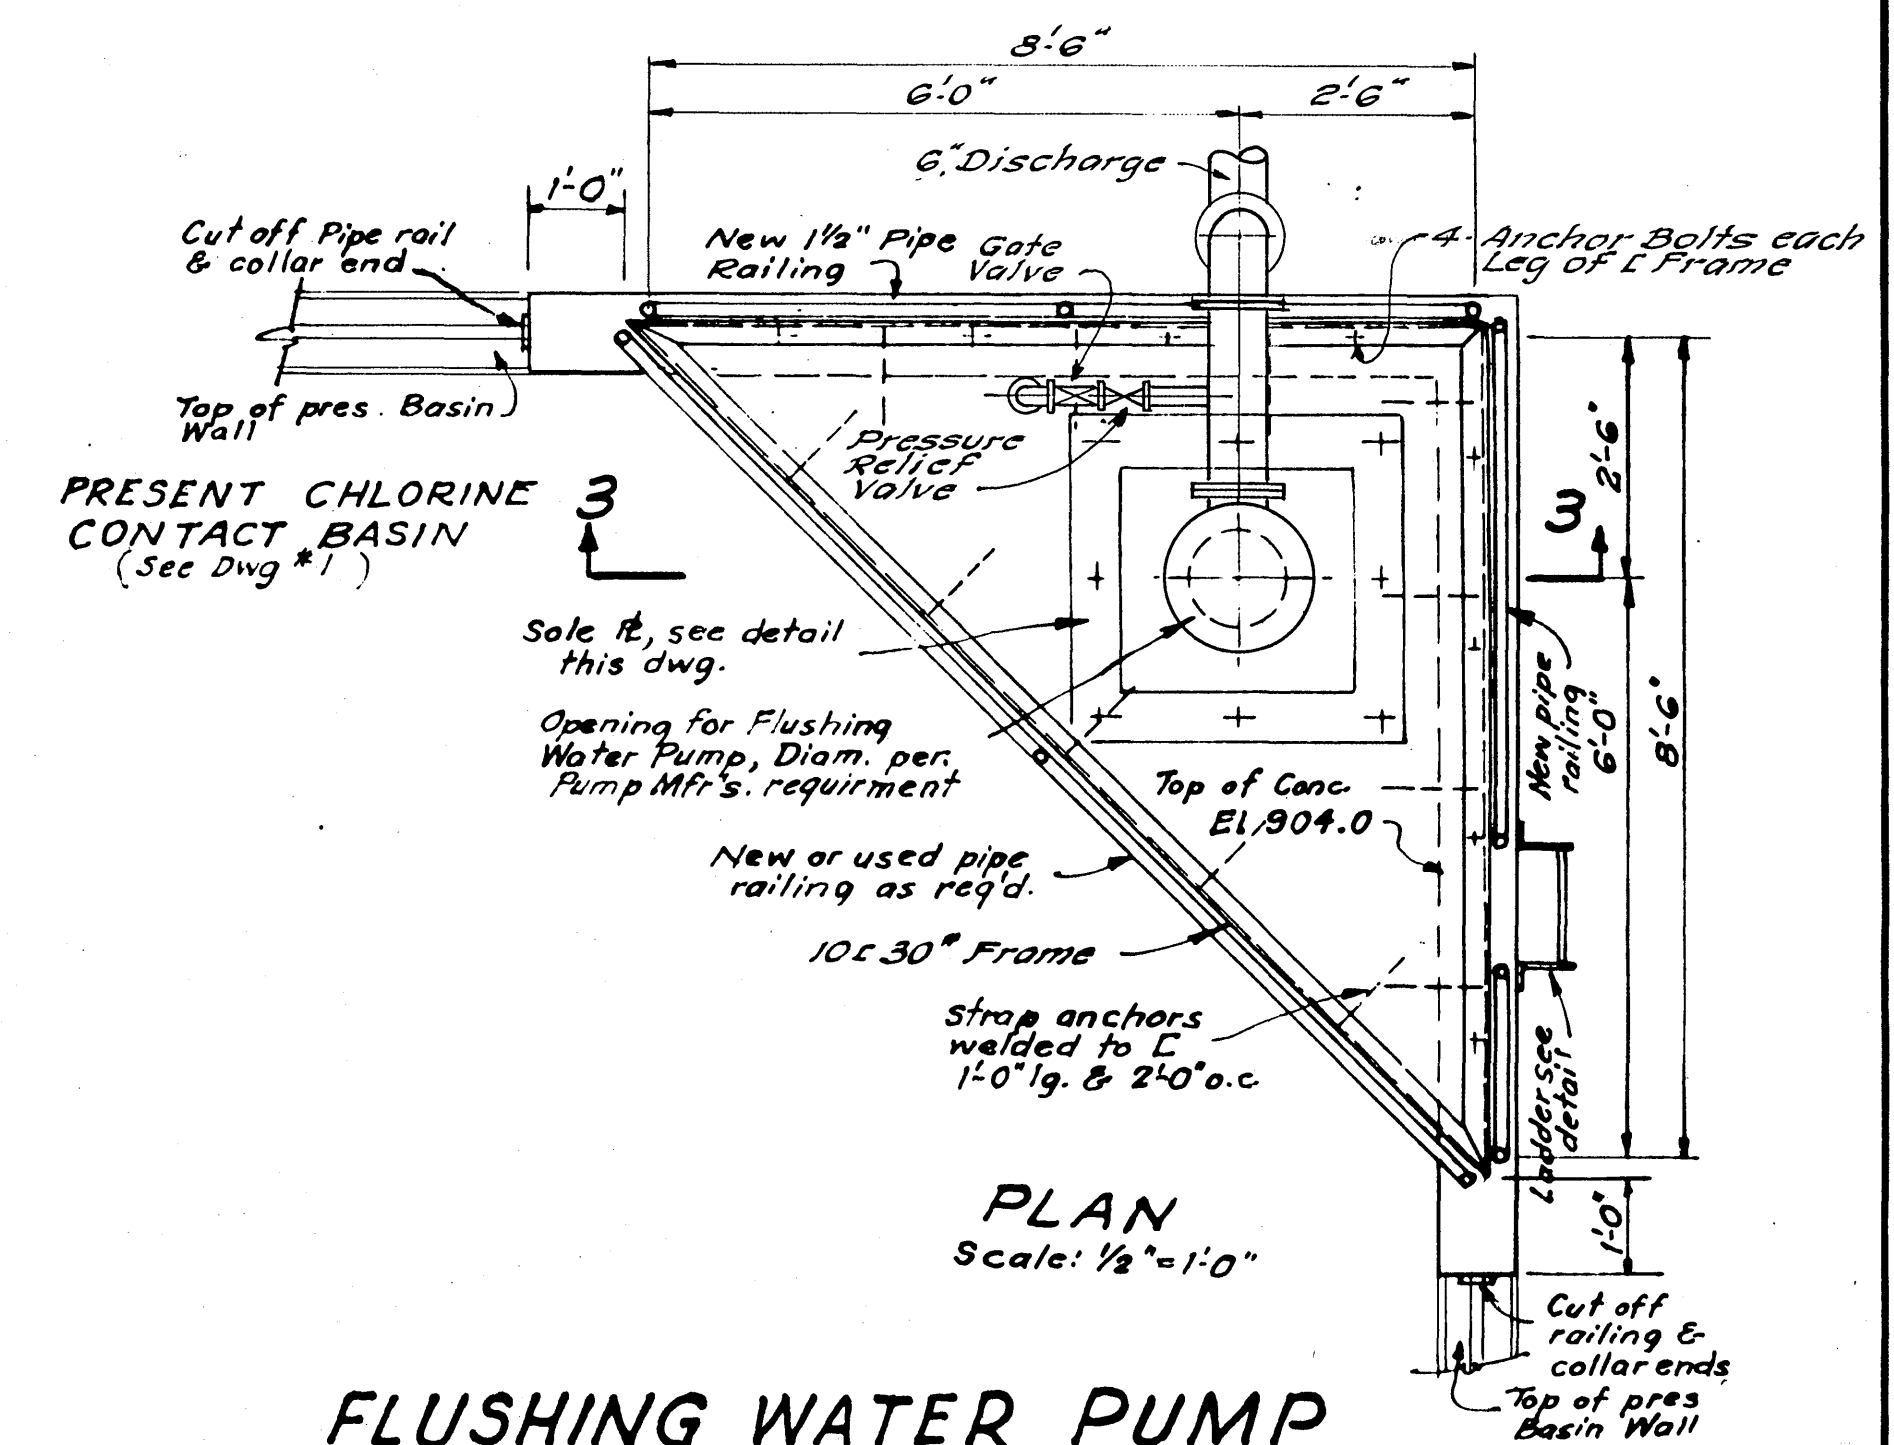

FLUSHING WATER PUMP BASE AT CHLORINE CONTACT BASIN

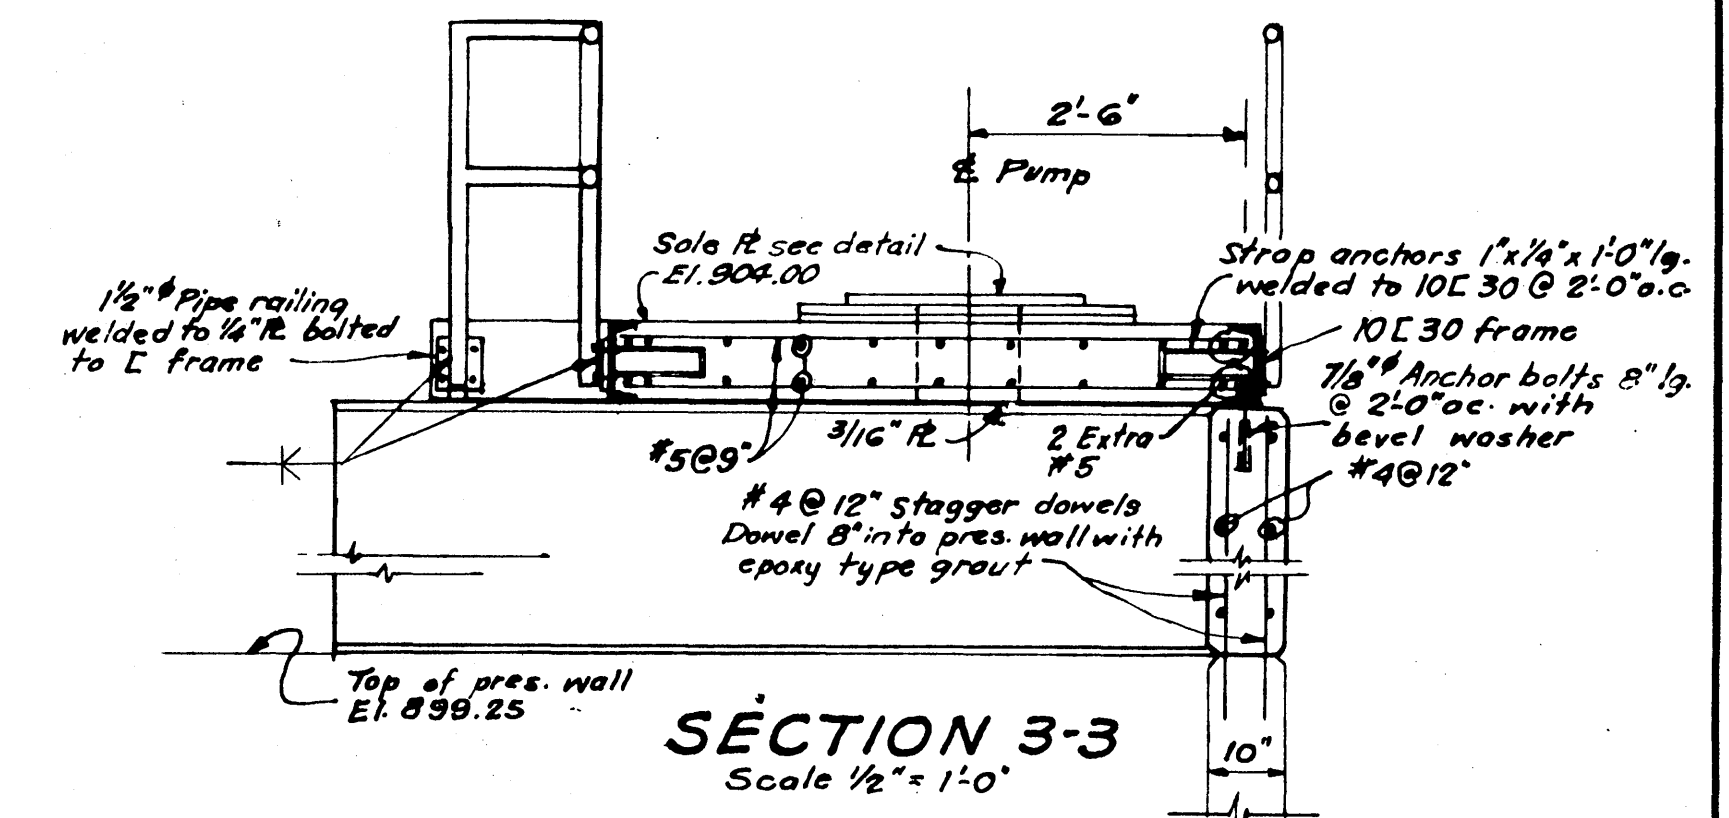

SECTION 3-3
Scale: 1/2" = 1'-0"

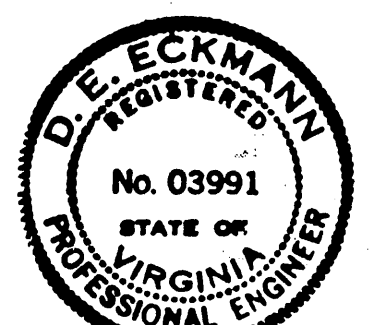

CONTRACT "D"

ADDITIONS TO SEWAGE TREATMENT PLANT ROANOKE, VIRGINIA

30 M.G. BASIN SECTIONS & DETAILS

AS BUILT

ALYORD, BURDICK & HOWSON ENGINEERS 1973

6