
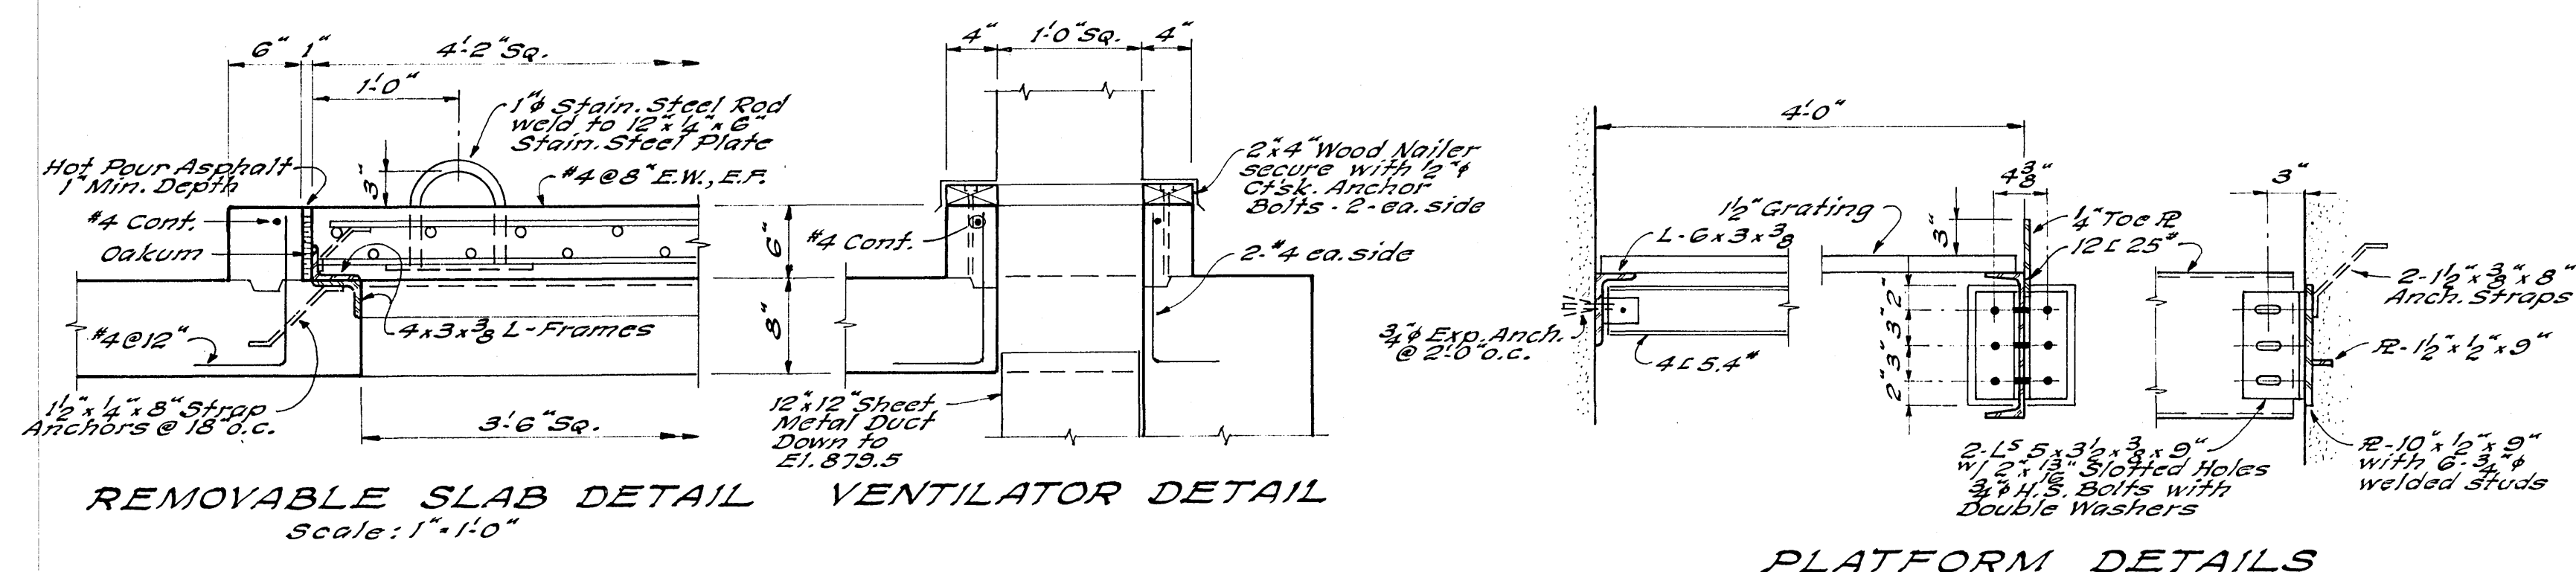
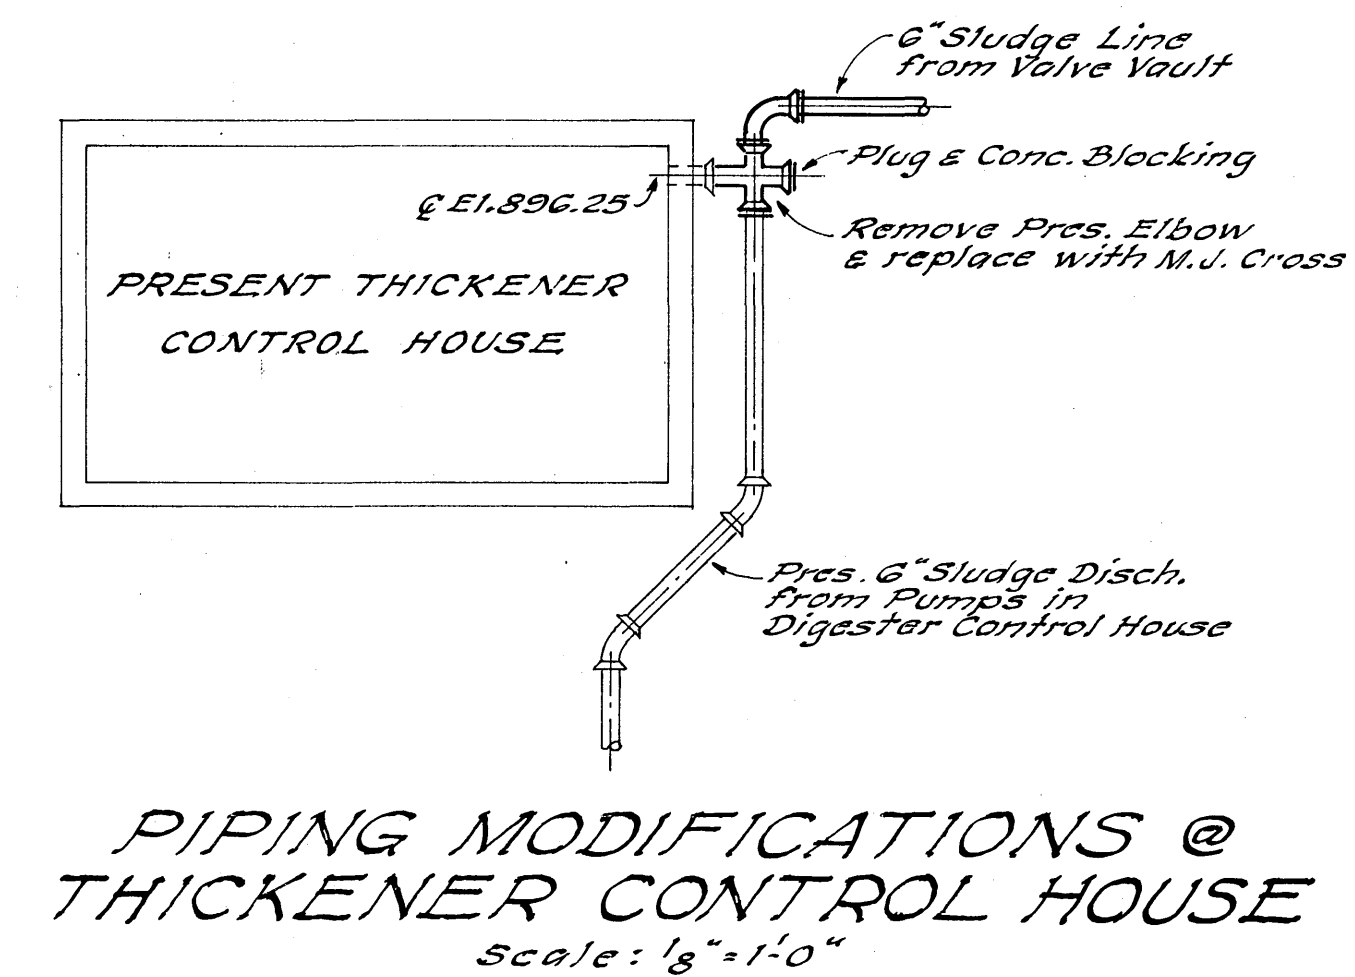
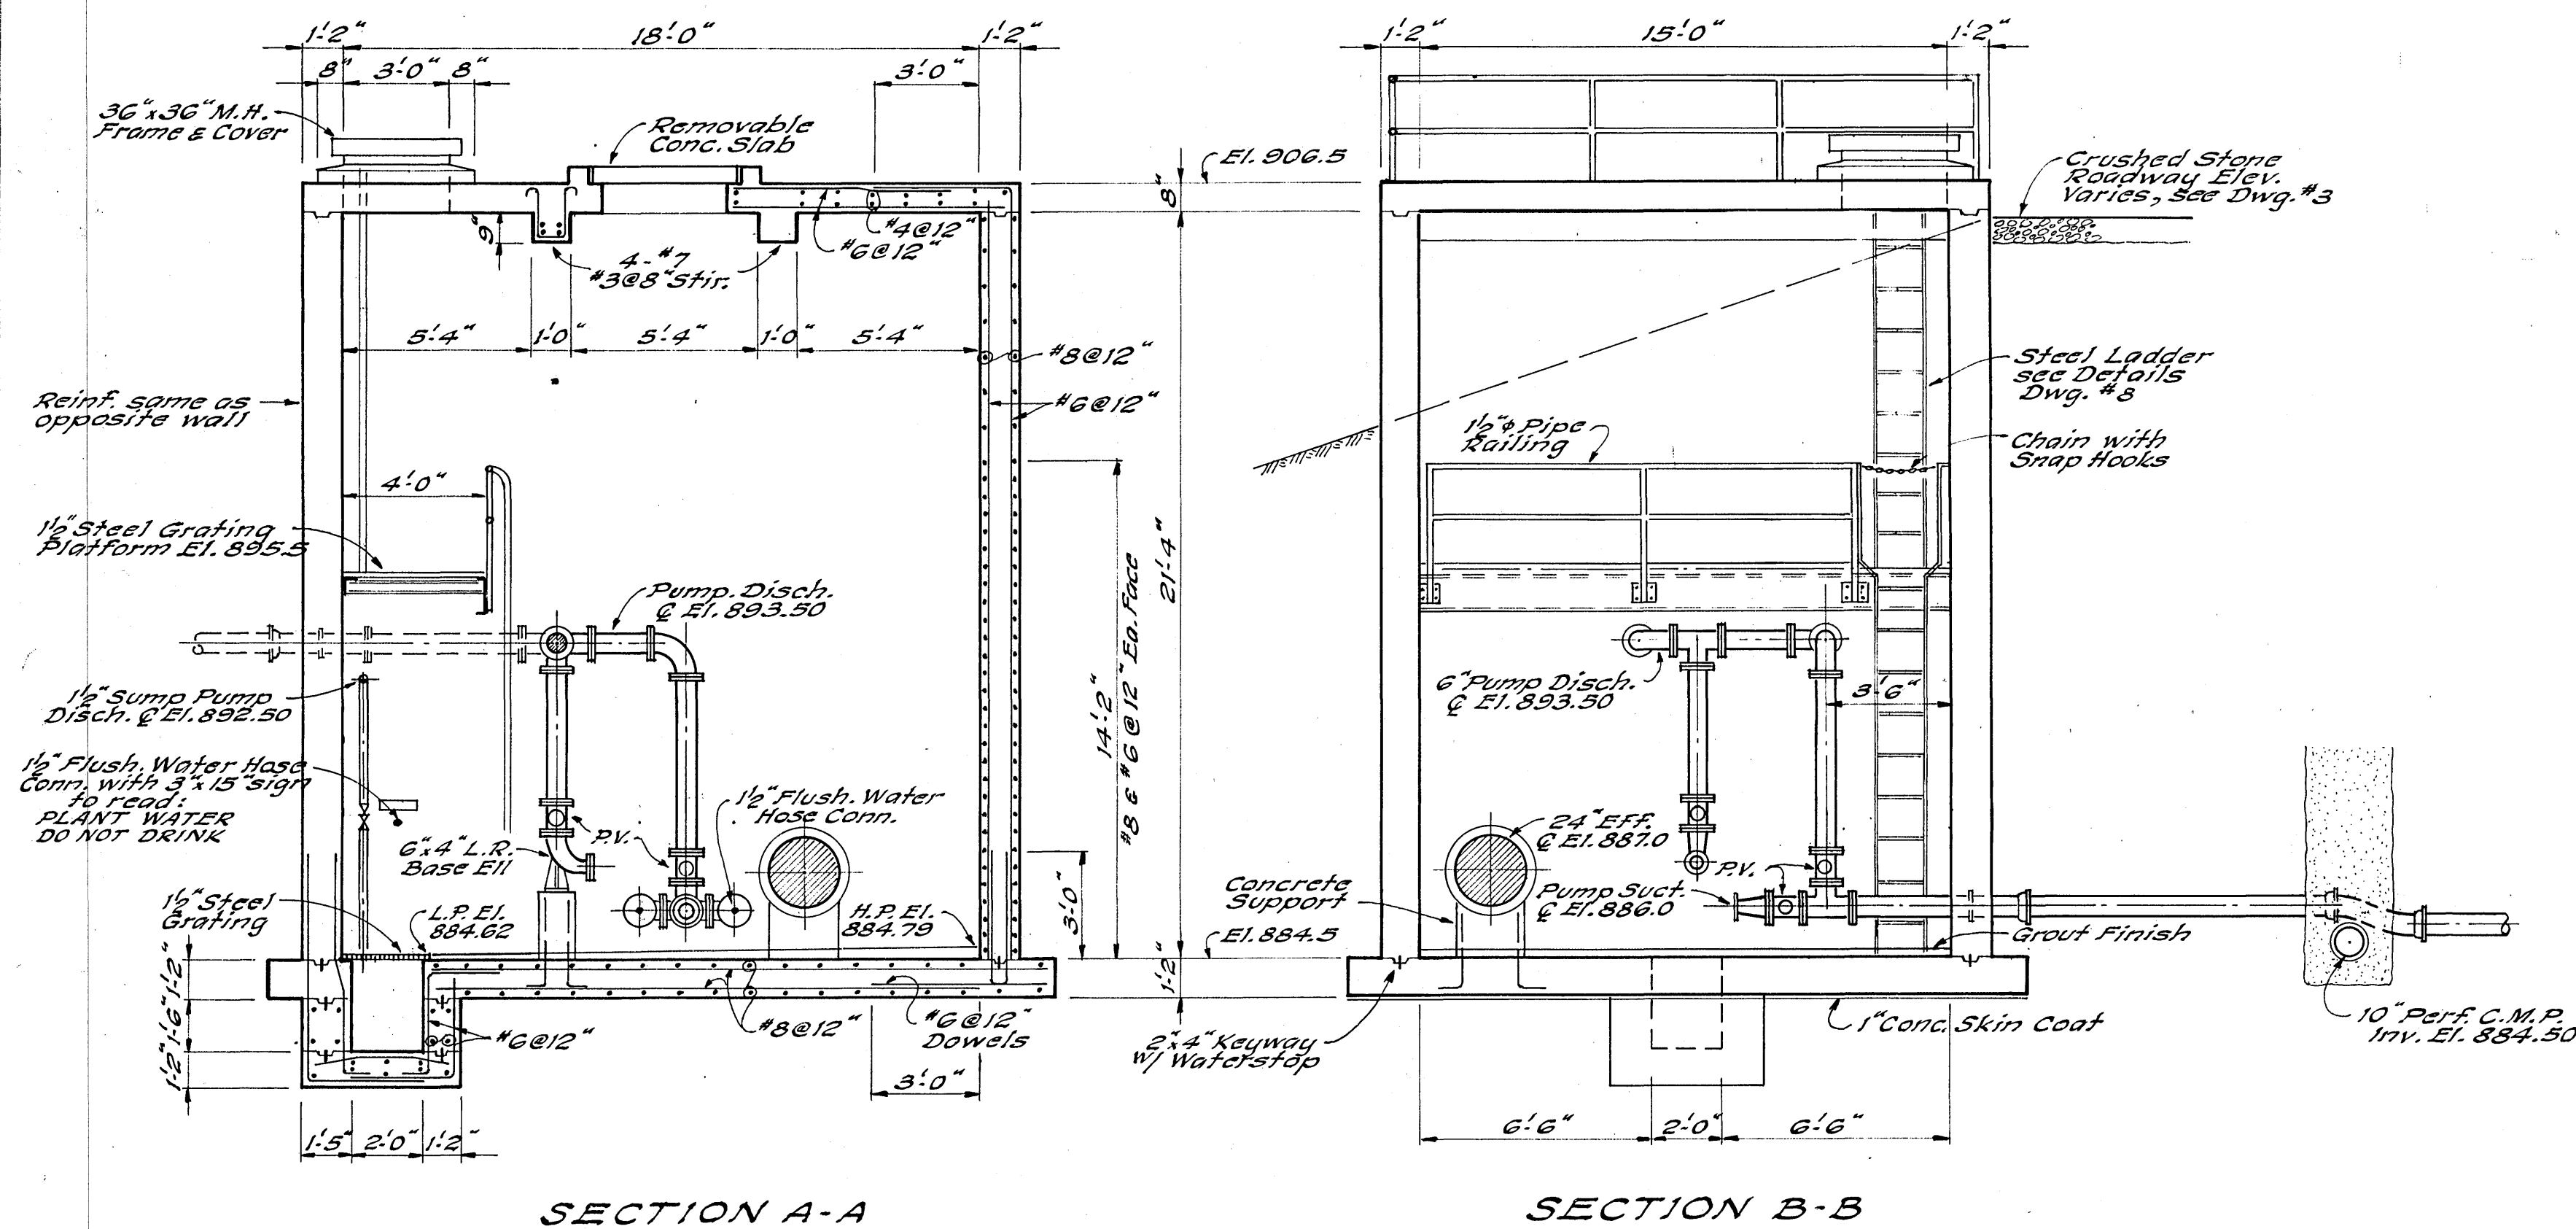
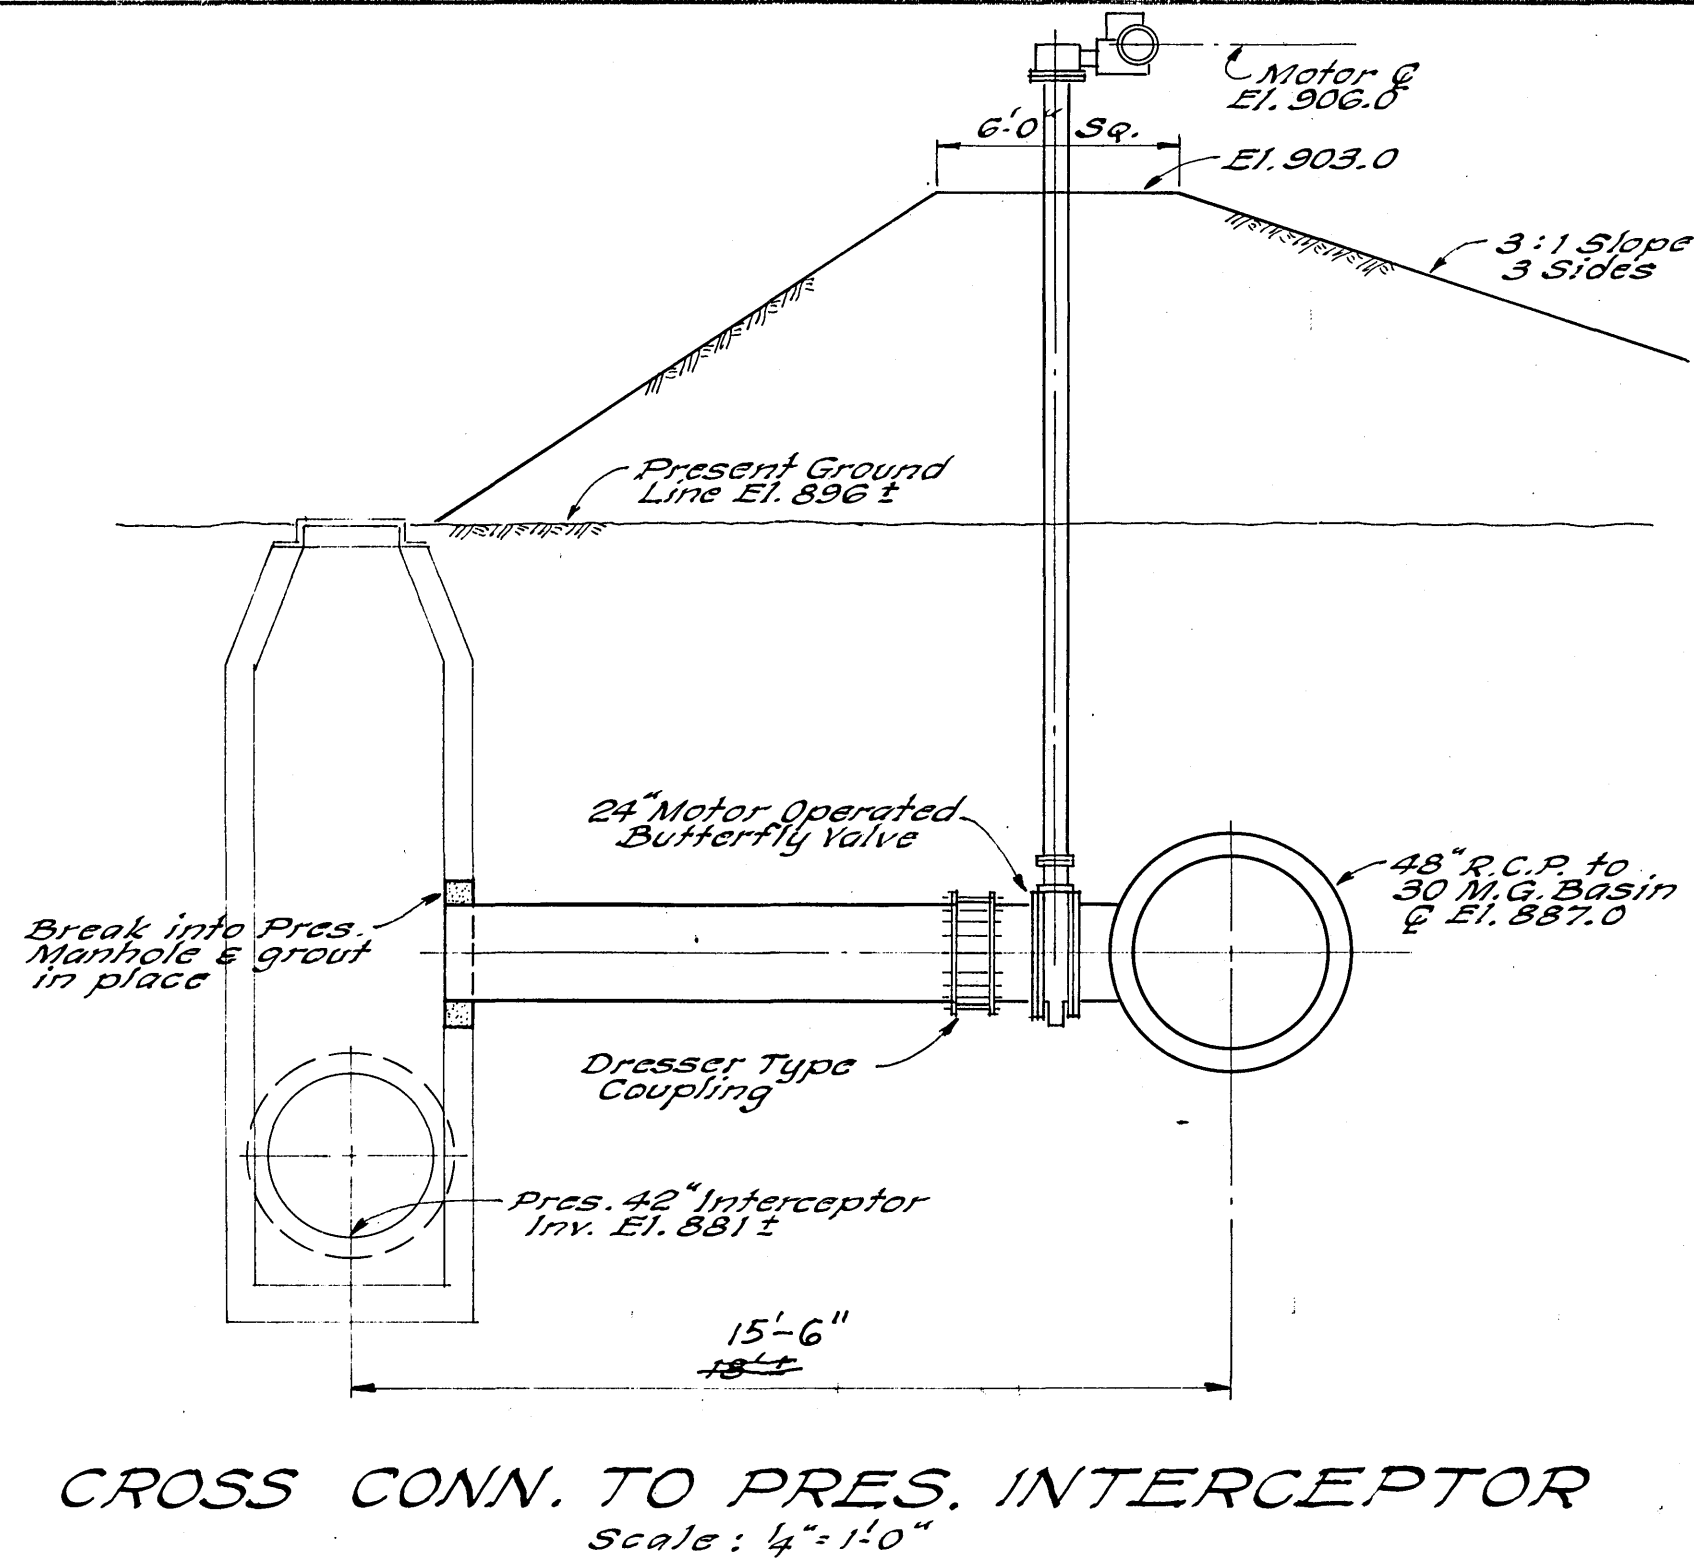


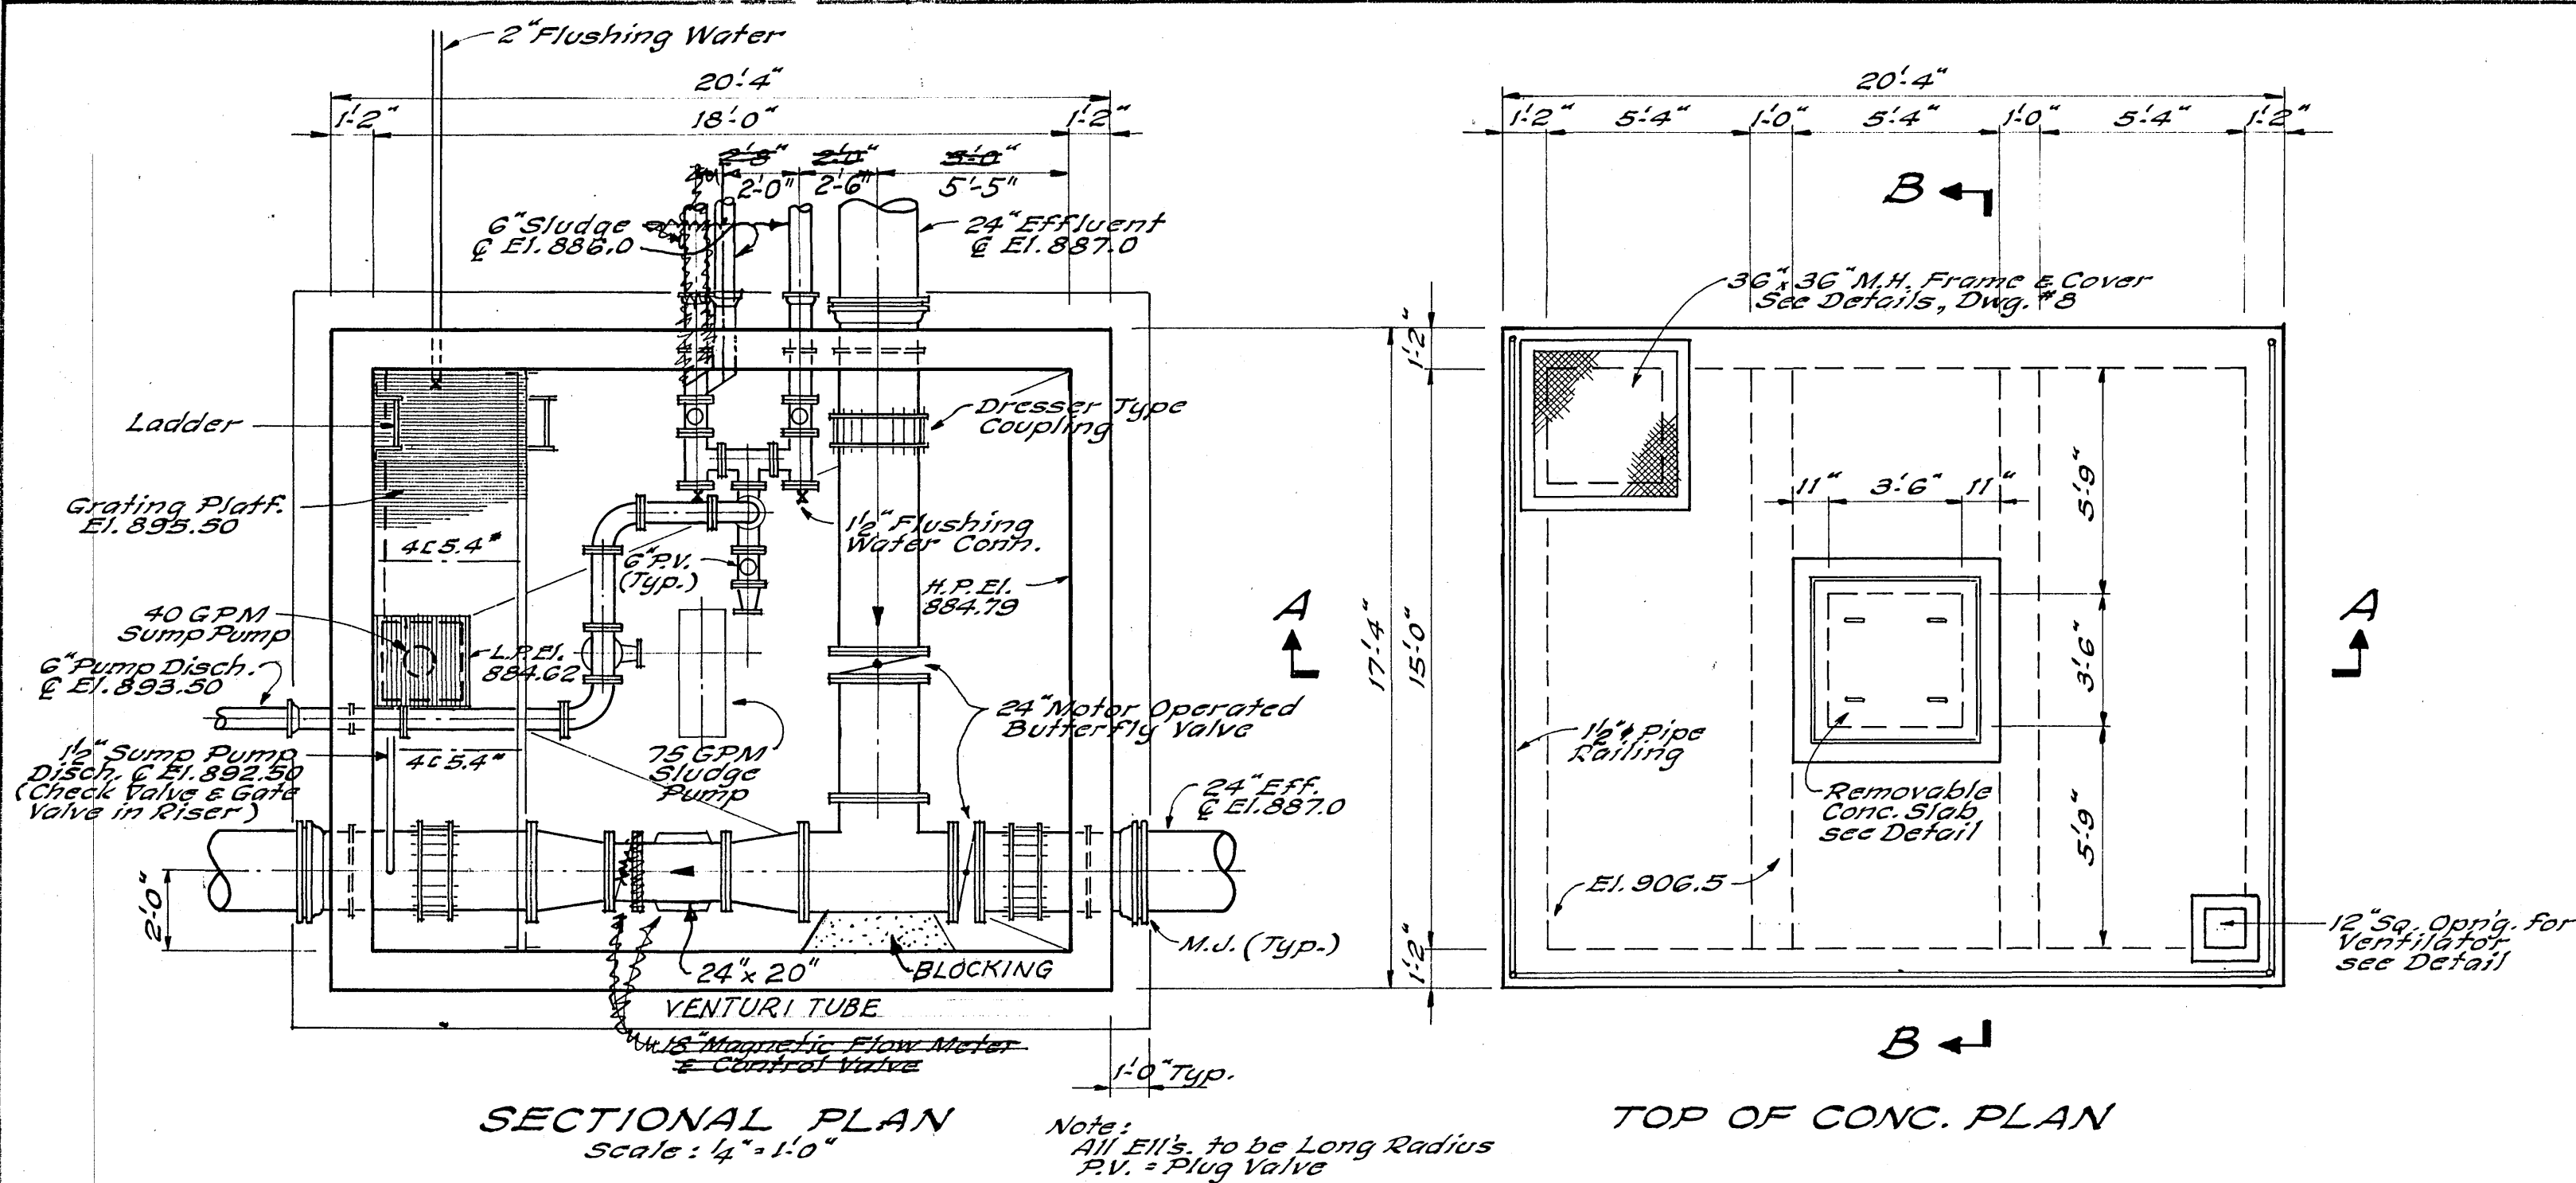

AS BUILT


CONTRACT D

ADDITIONS TO SEWAGE TREATMENT PLANT
ROANOKE, VIRGINIA

30 MG BASIN
DETAILS

ALVORD BURDICK & HOWSON
ENGINEERS CHICAGO

1973

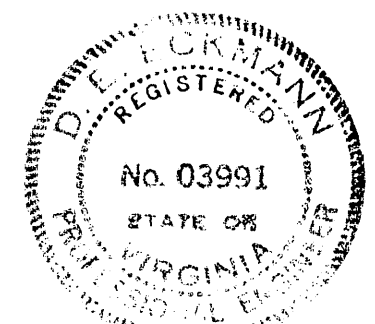

7