


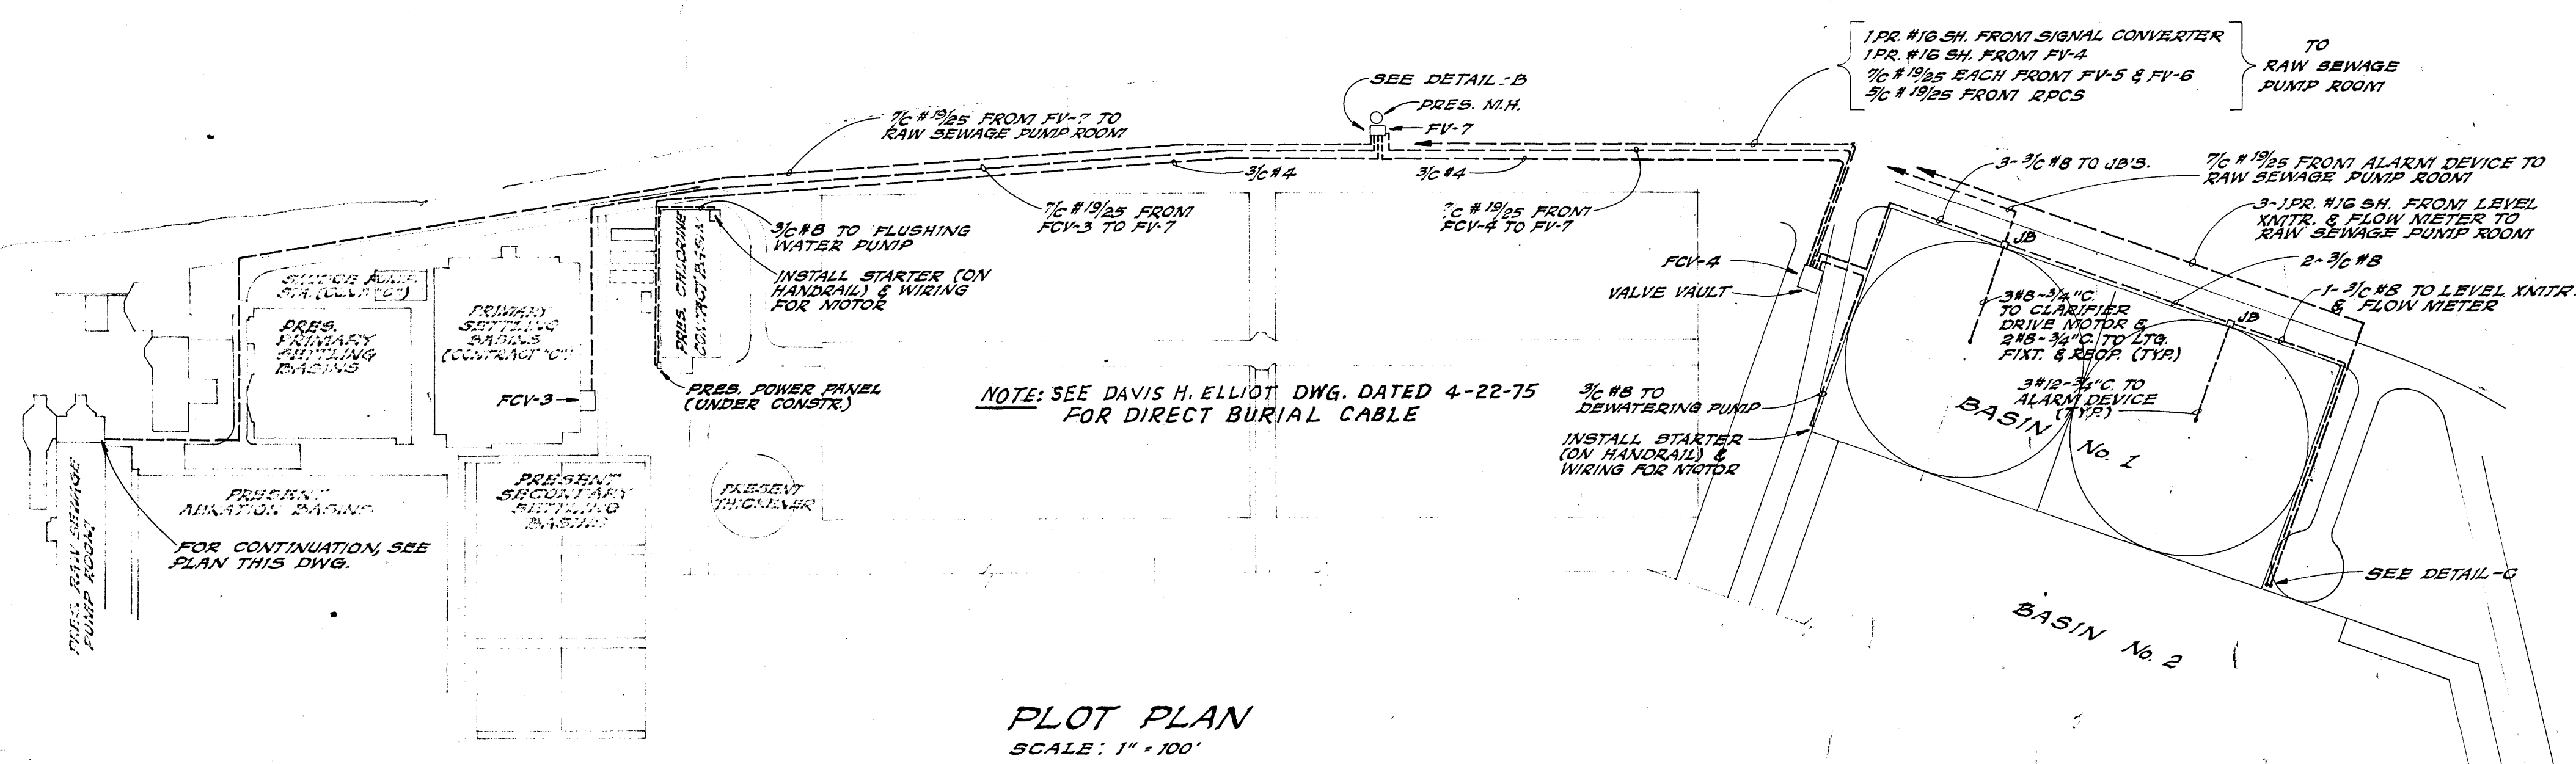


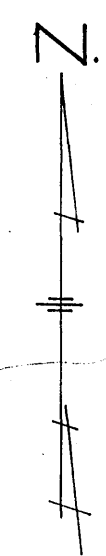


PLOT PLAN
SCALE: 1" = 100'

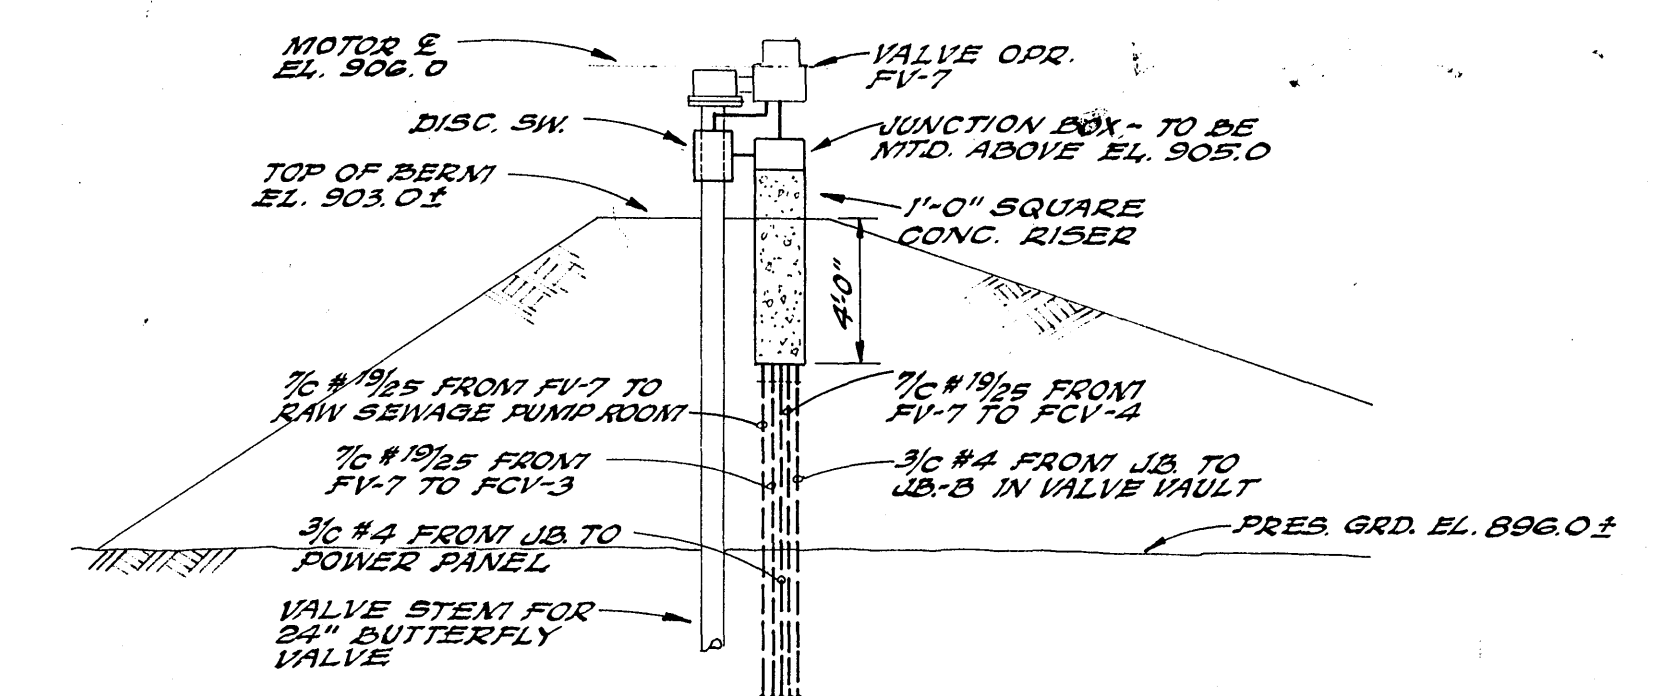


DETAIL - B
SCALE: 1/4" = 1'-0"

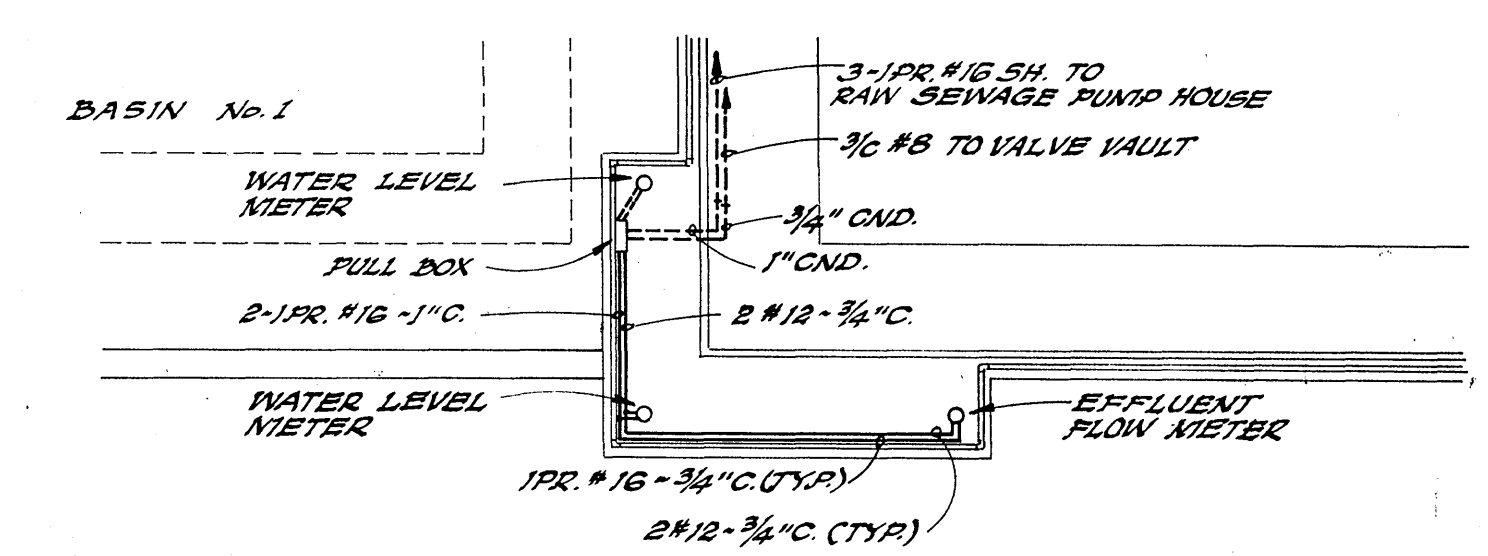


DETAIL - C
SCALE: 1" = 10'-0"

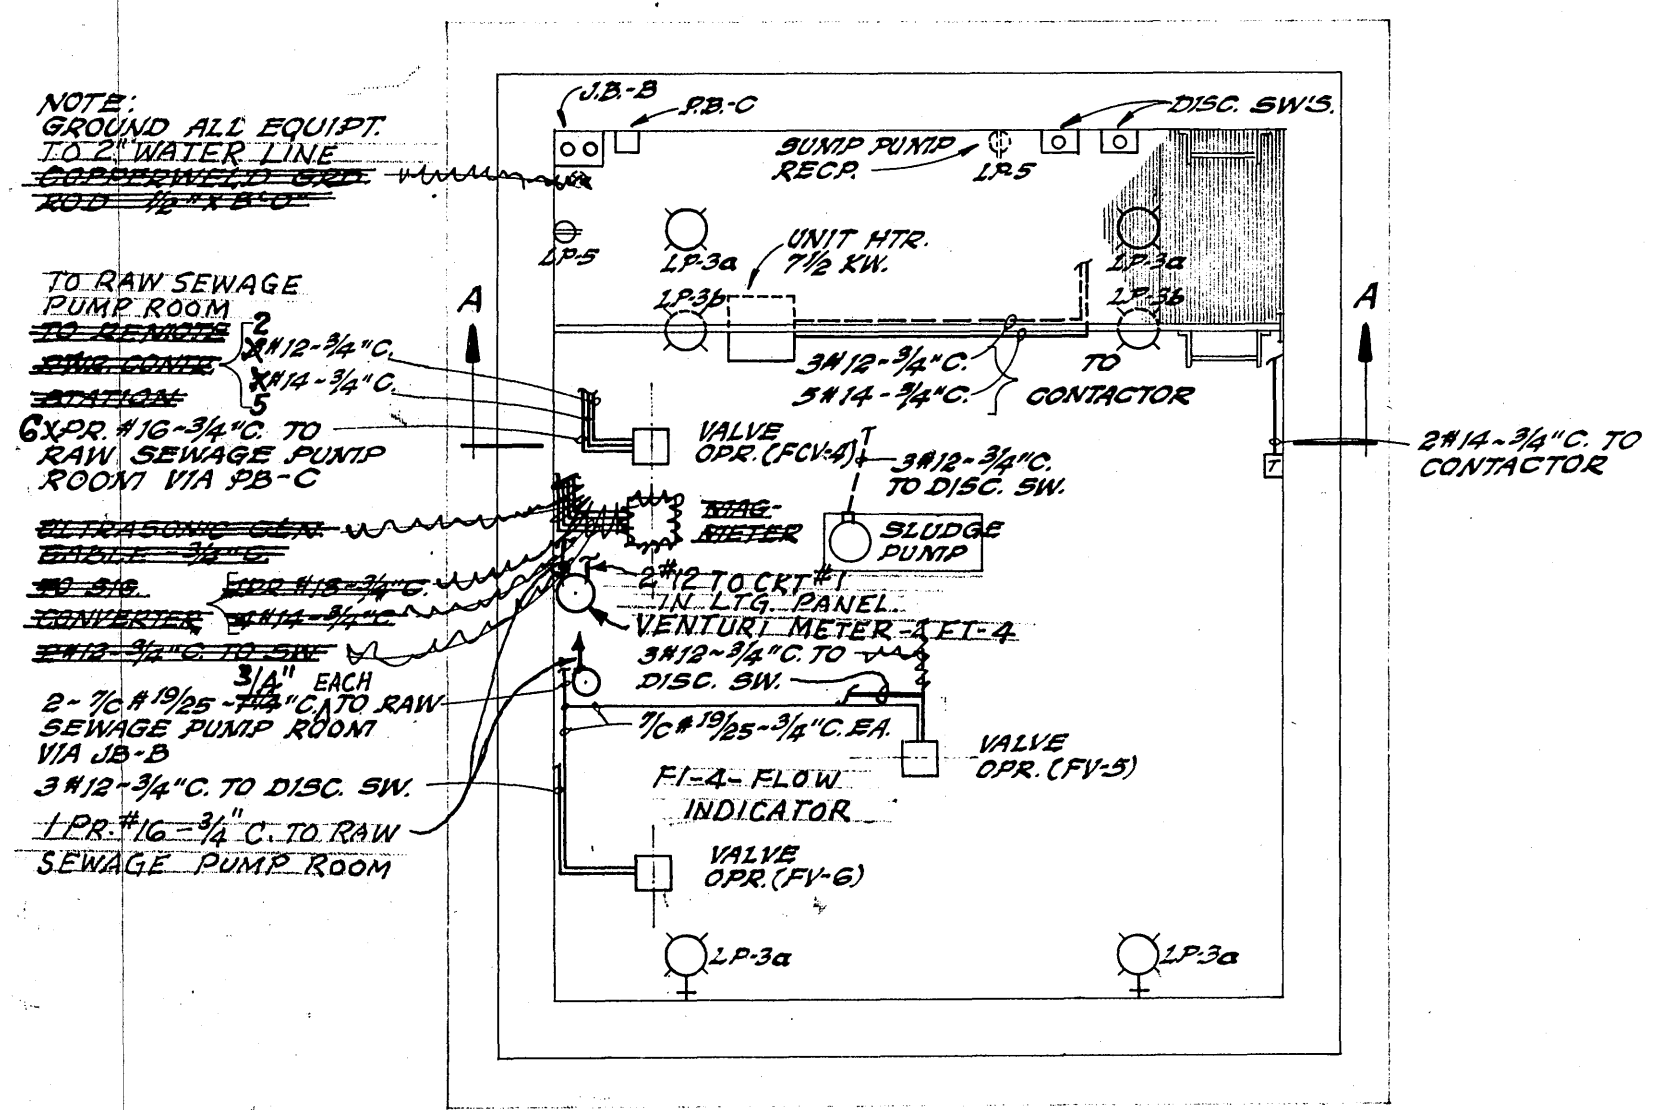


SECTIONAL PLAN

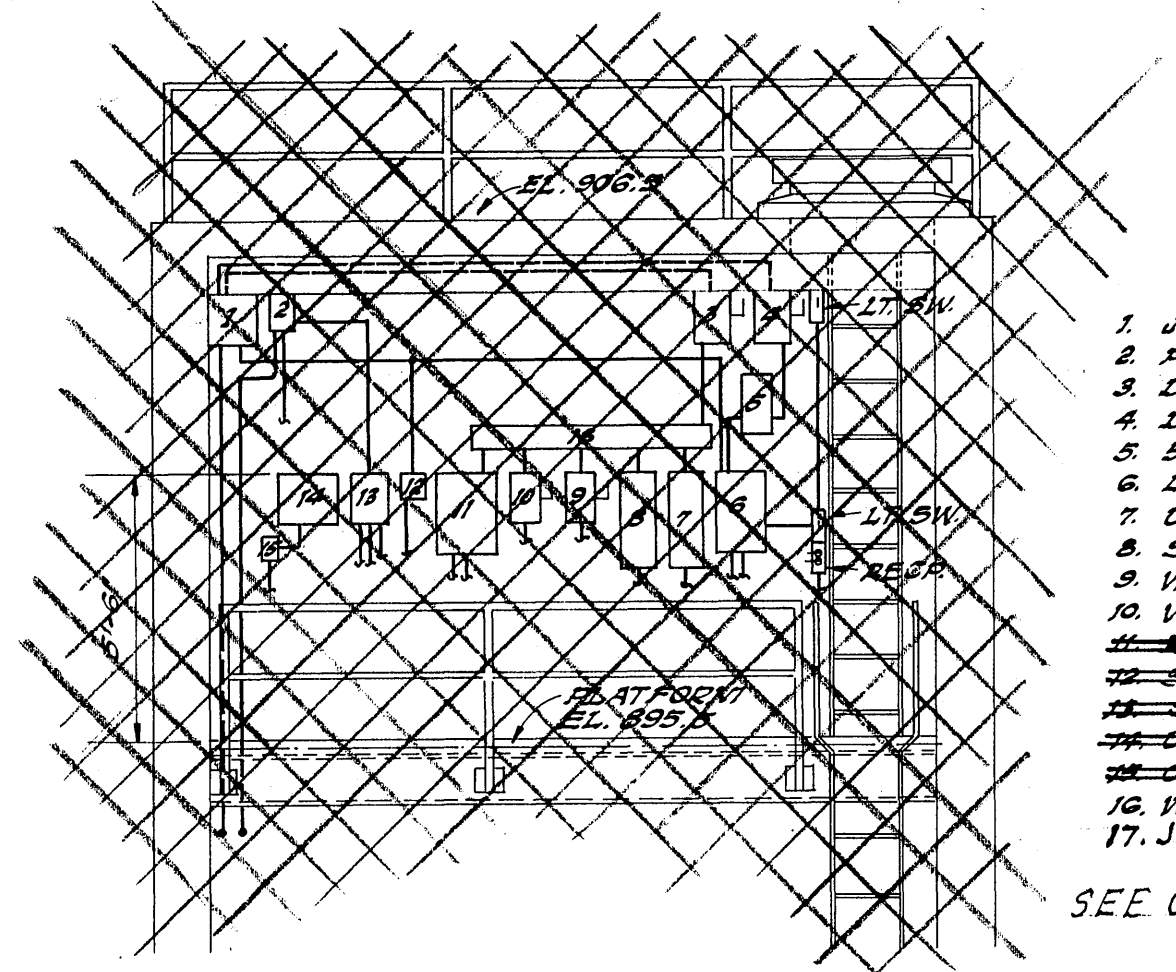

SECTION A-A
VALVE VAULT
POWER, LIGHTING & CONTROL
SCALE: 1/4" = 1'-0"

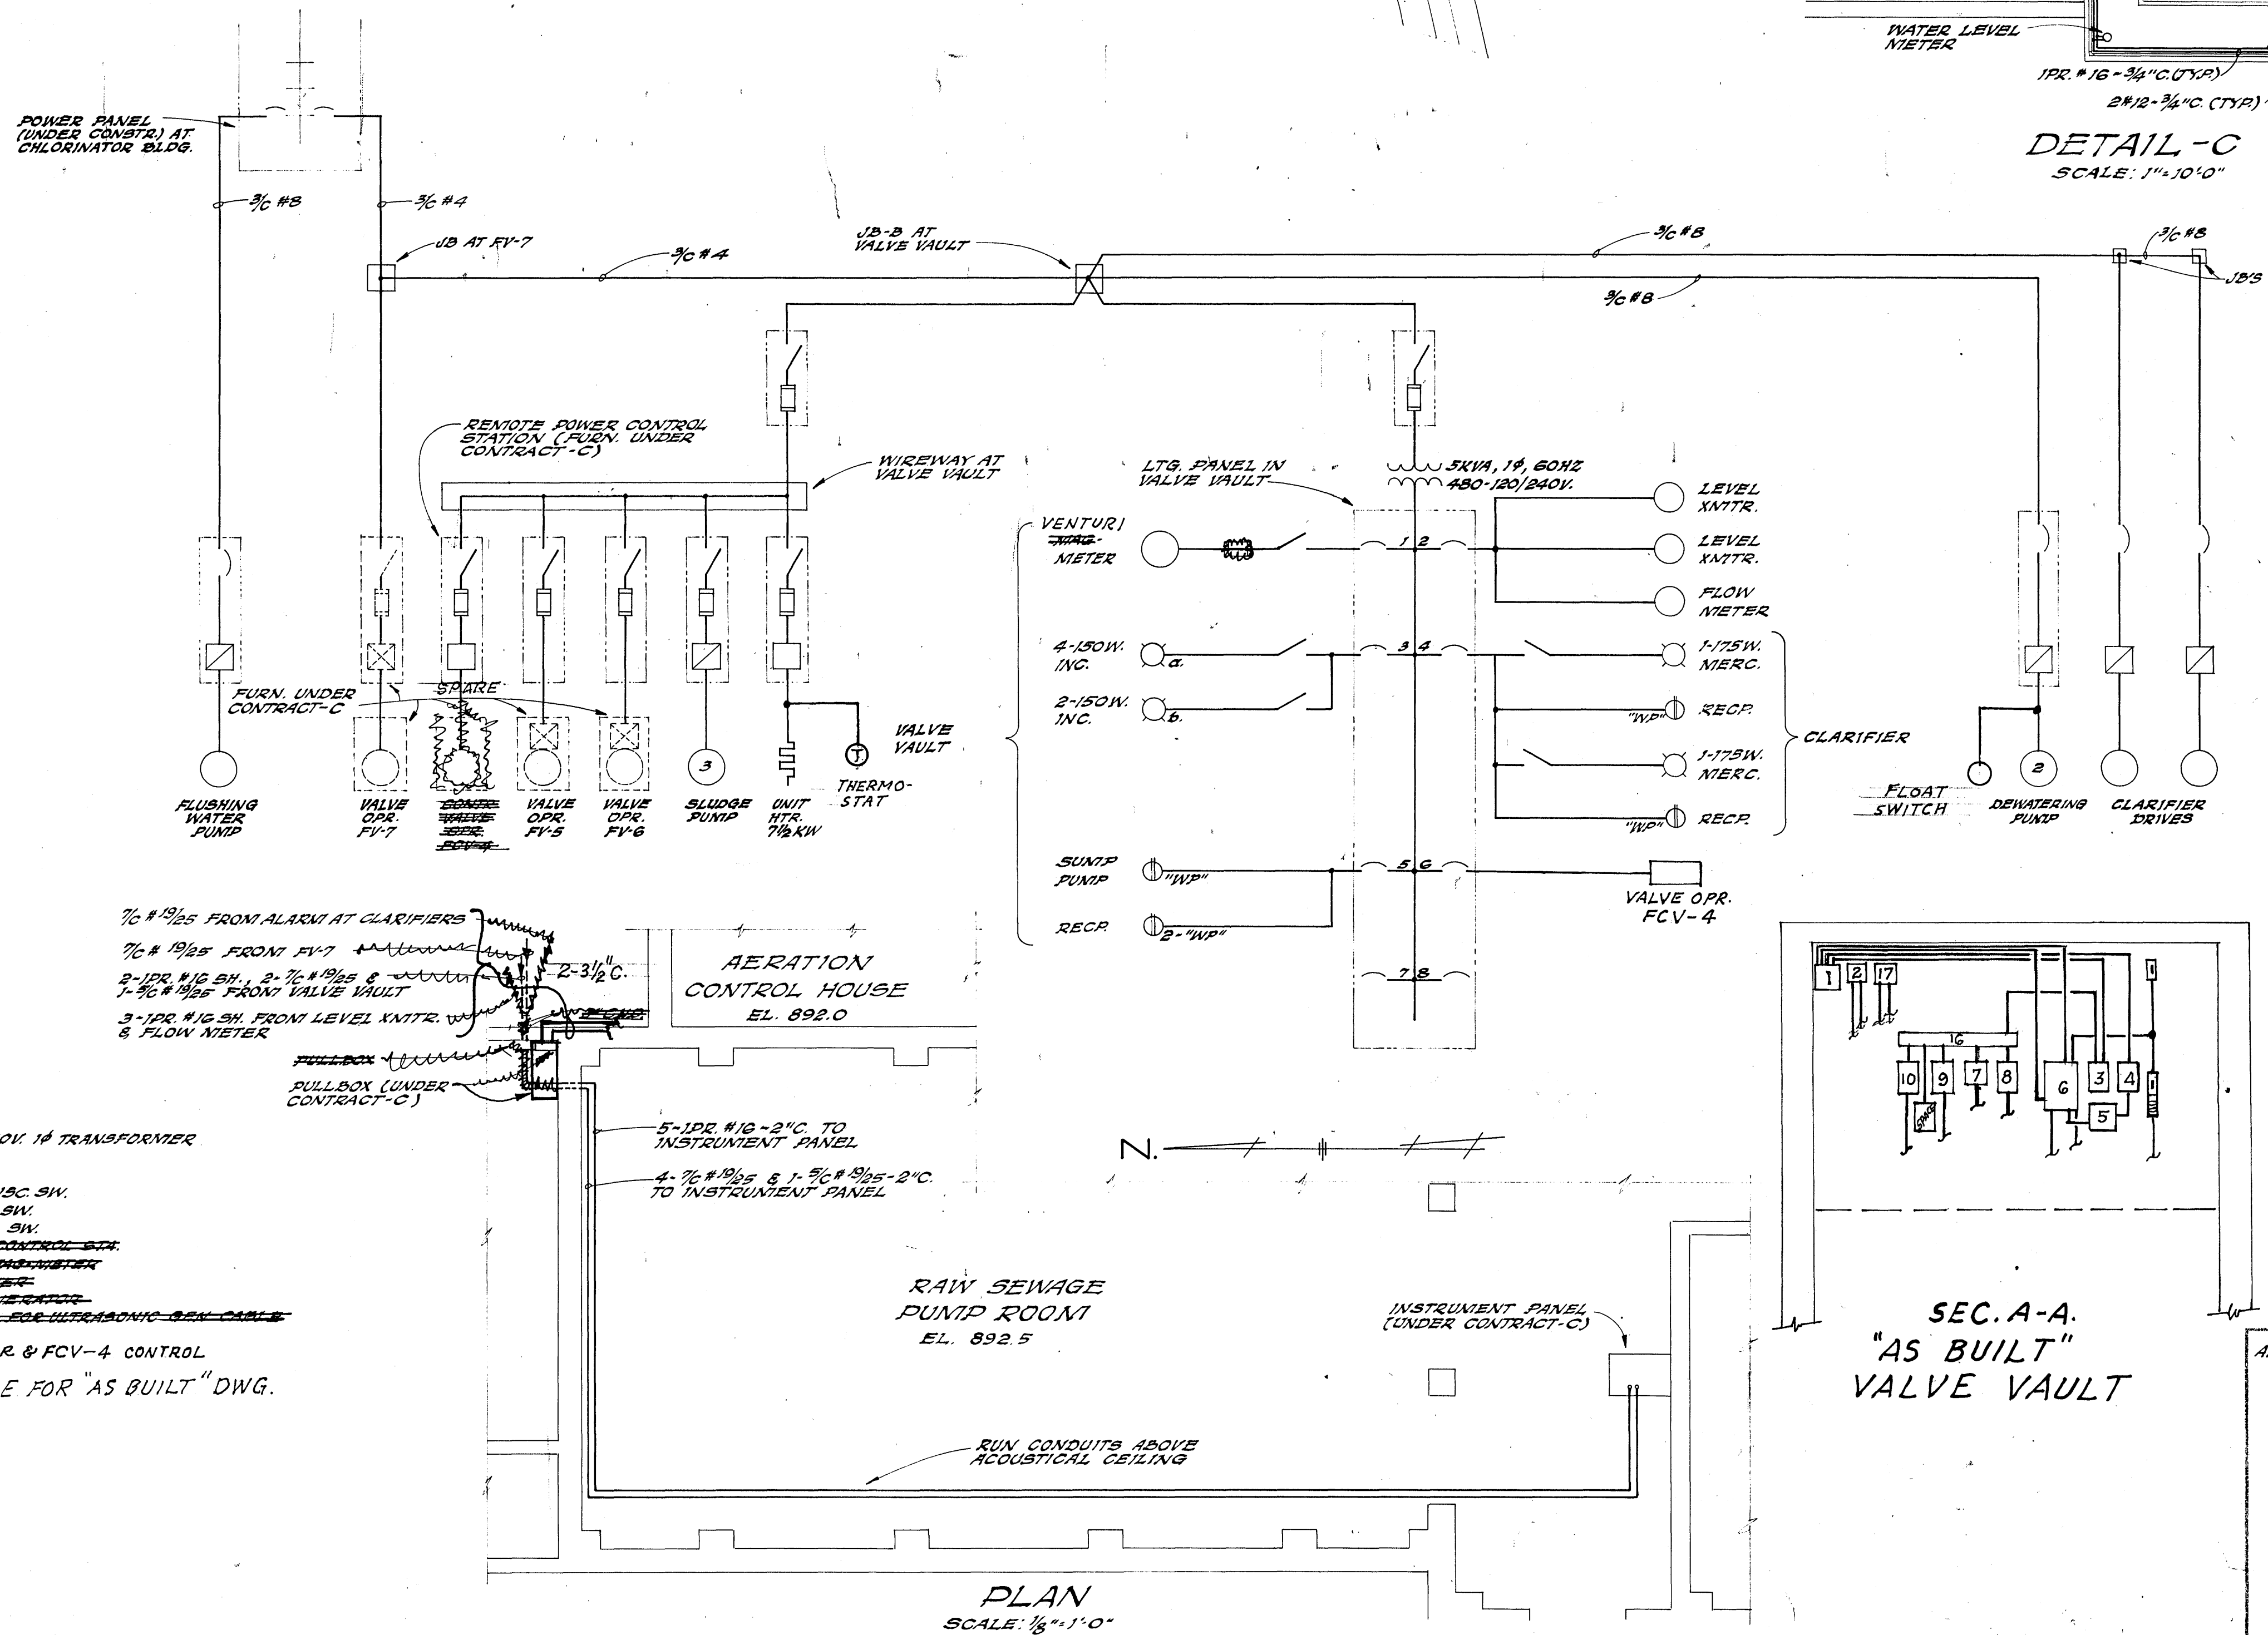

PLAN
SCALE: 1/8" = 1'-0"

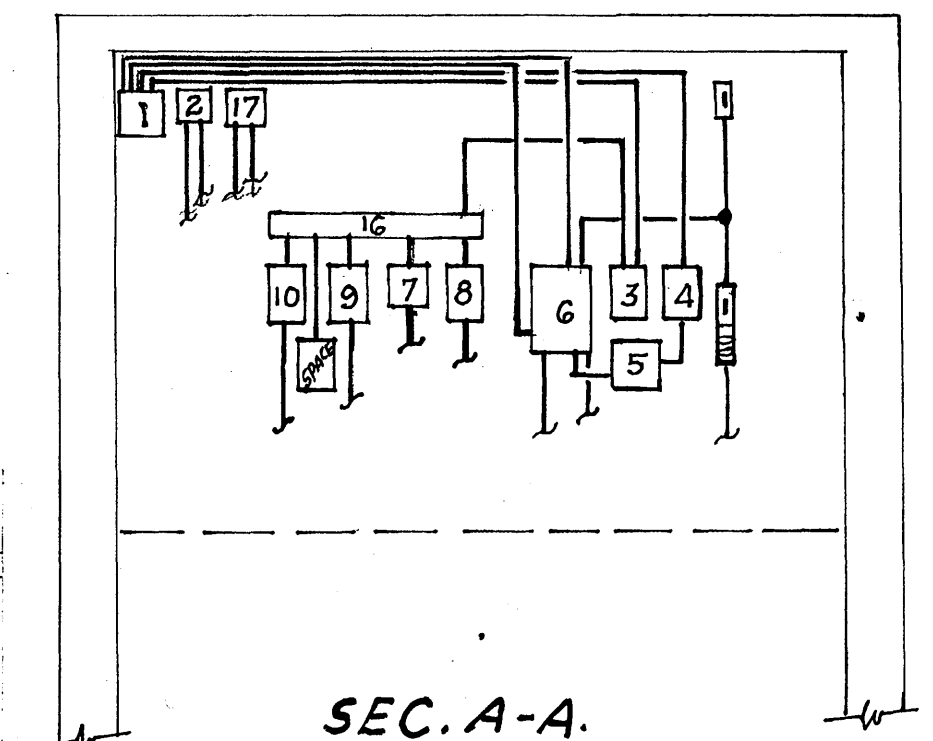

SEC. A-A
"AS BUILT"
VALVE VAULT

AS BUILT

CONTRACT D

ADDITIONS TO SEWAGE TREATMENT PLANT
ROANOKE, VIRGINIA

**30 MG BASIN
ELECTRICAL**

ALVORD BURDICK & HOWSON
ENGINEERS CHICAGO

1973