


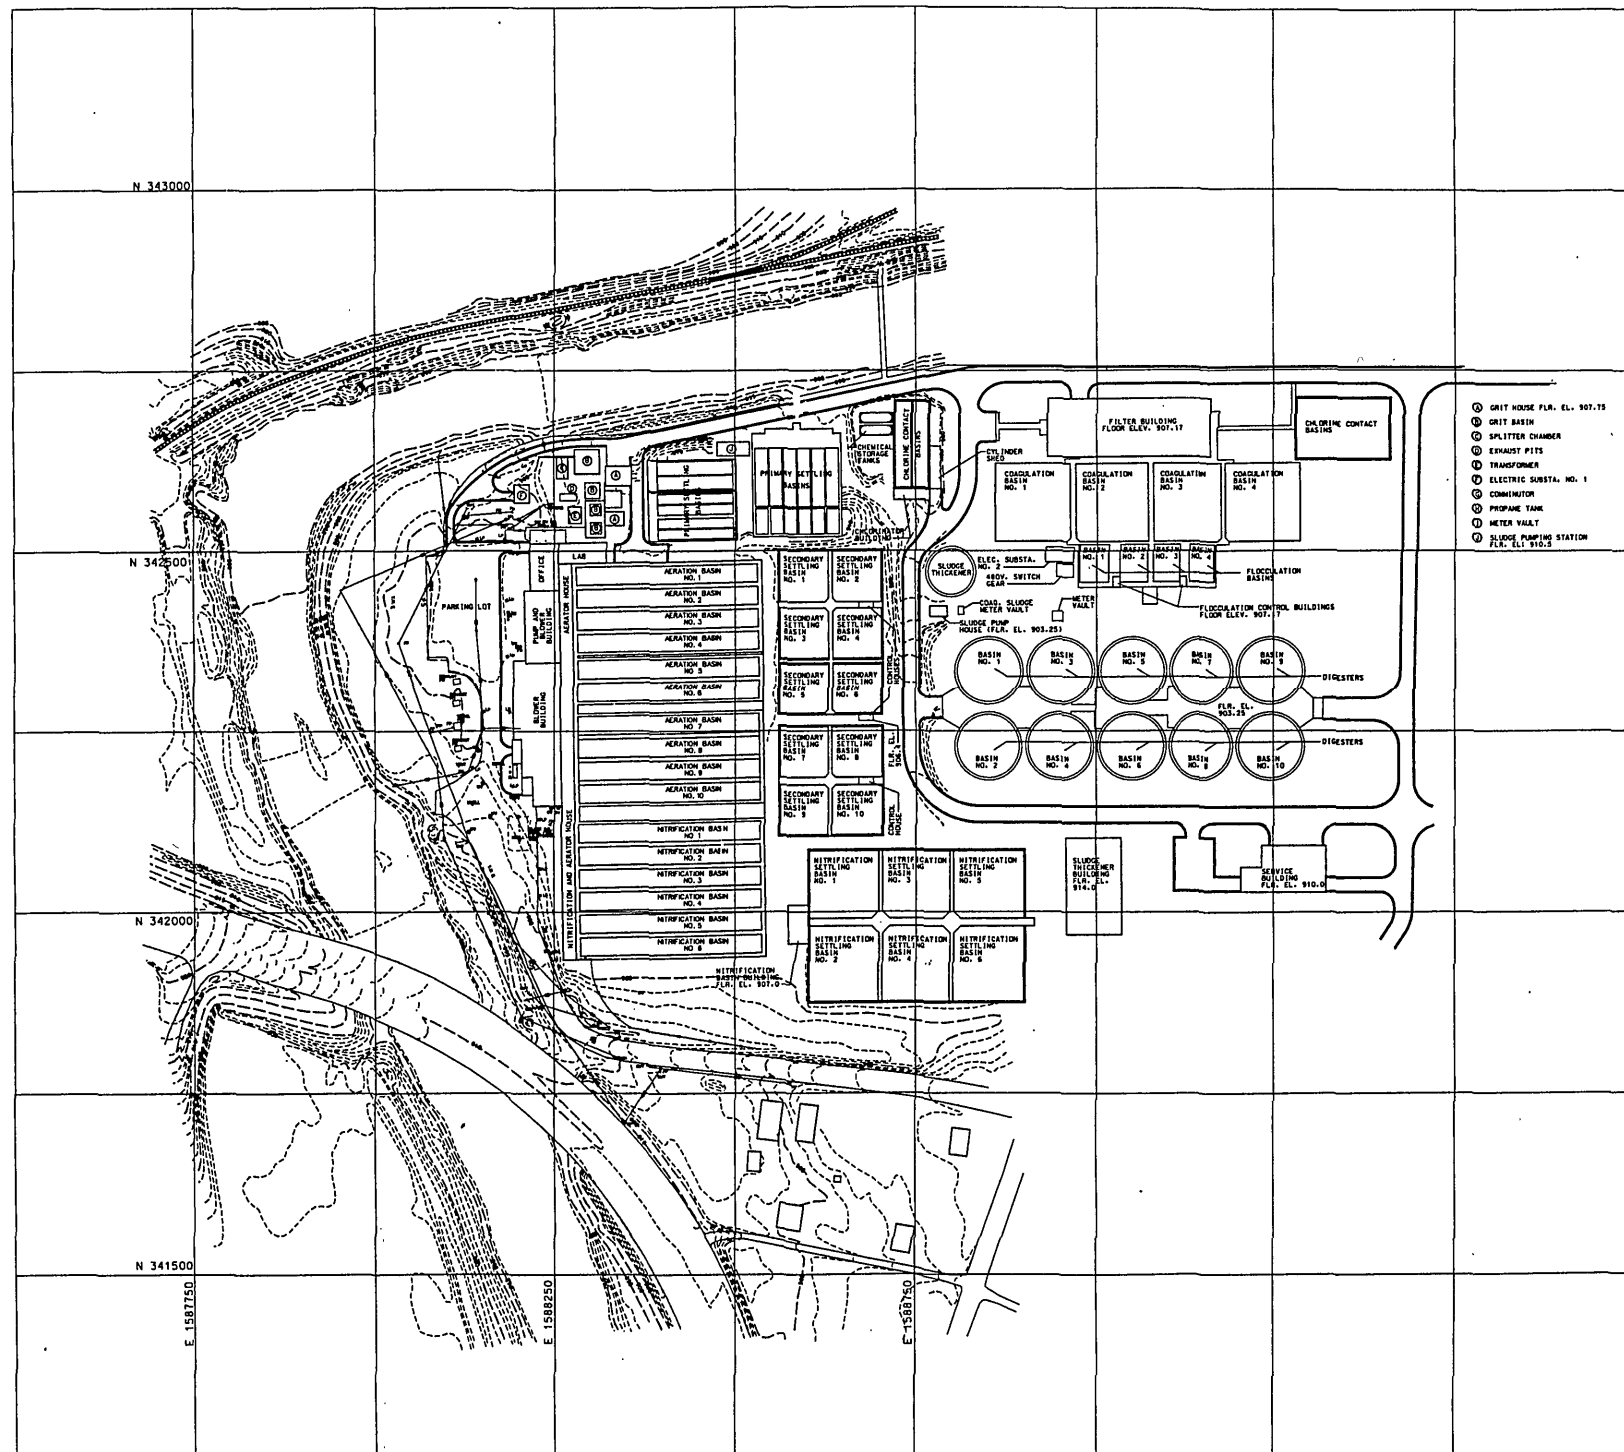

- ① GRIT HOUSE FLR. EL. 907.75
- ② GRIT BASIN
- ③ SPLITTER CHAMBER
- ④ EXHAUST PITS
- ⑤ TRANSFORMER
- ⑥ ELECTRIC SUBSTA. NO. 1
- ⑦ COMMUNICATOR
- ⑧ PROPANE TANK
- ⑨ METER VAULT
- ⑩ SLUDGE PUMPING STATION FLR. EL. 910.5

- LEGEND**
- 905— EXIST. MAJOR CONTOURS
 - 904— EXIST. MINOR CONTOURS
 - ⊕^{LP} LIGHT POLE
 - ⊕^{FP} FIRE HYDRANT
 - ⊕^{WV} WATER VALVE
 - ⊕^{GV} GAS VALVE
 - ⊕^{MW} MONITORING WELL
 - ^{UT} UNDERGROUND TANK COVERS
 - SD— EXIST. STORM DRAIN
 - SS— EXIST. SANITARY SEWER W/ MH
 - OWP— EXIST. OVERHEAD POWER LINE WITH POLE AND GUY WIRE
 - X— EXIST. FENCE

100 50 0 100 200FT
SCALE: 1" = 100'

As BUILT RECORD DWG.		8-31-93	SMH
Symbol	Descriptions	Date	Approved
Revisions			
U.S. ARMY ENGINEER DISTRICT CORPS OF ENGINEERS WILMINGTON, NORTH CAROLINA			
Designed by:	ROANOKE, VIRGINIA		
DWB	FLOOD REDUCTION PROJECT		
Drawn by:	SGM		
Checked by:	DWB		
Reviewed by:	Scale: 1" = 100'	Plate Number:	
CHIEF CIVIL ENGR. SECTION	Date: 23 APRIL 1991	P-1	
Approved by:	Drawing Code: RR102-02-32	Sheet 2 of 25	
CHIEF, DESIGN BRANCH			

37303002