


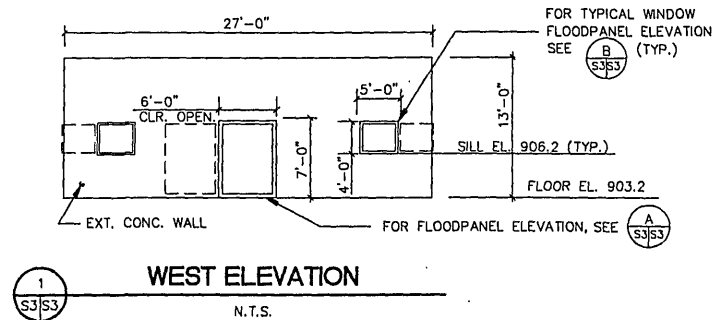
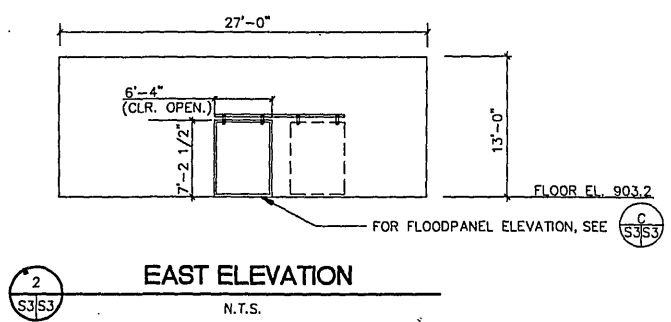


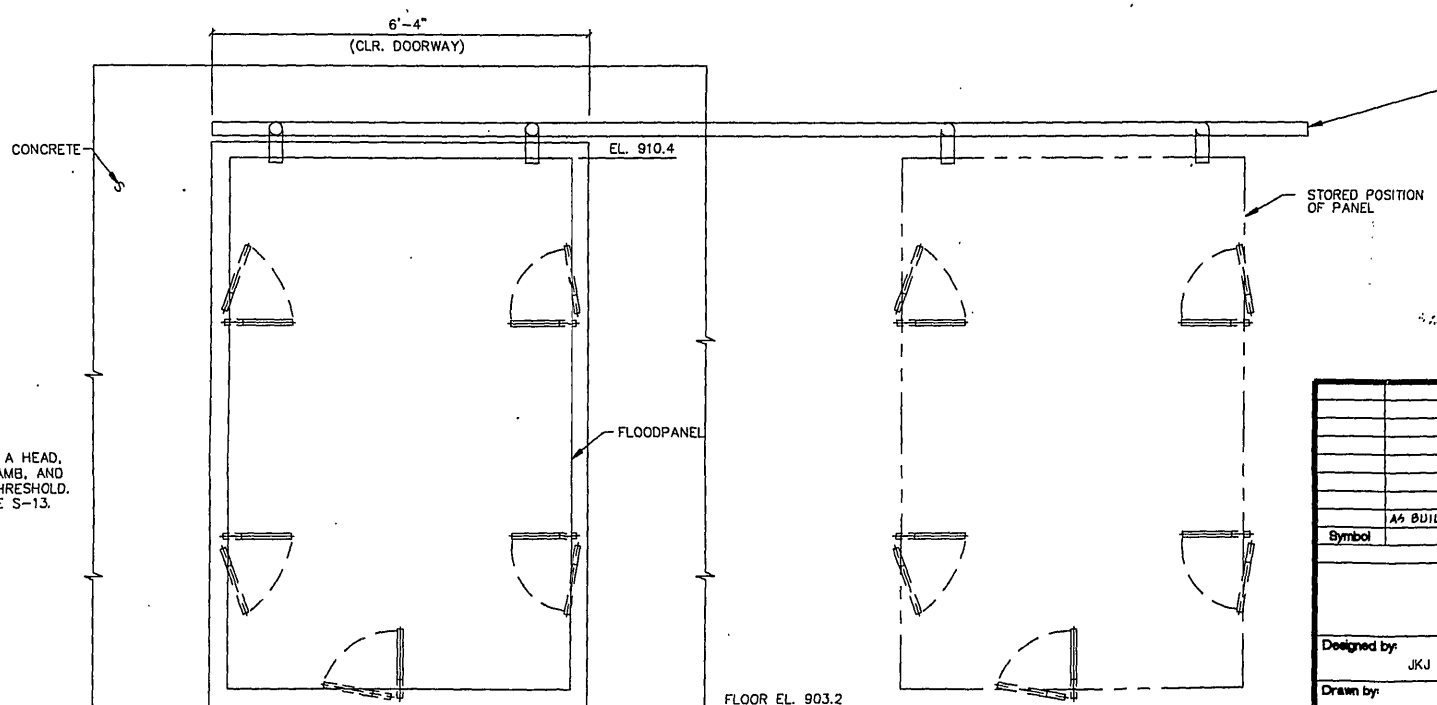

NOTE: NORTH AND SOUTH ELEVATIONS DO NOT HAVE WALL OPENINGS.

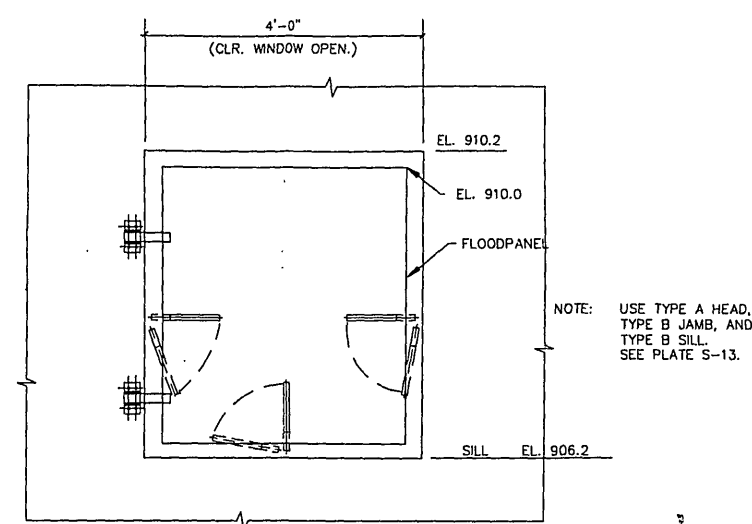

NOTE: USE TYPE A HEAD, TYPE B JAMB, AND TYPE B THRESHOLD. SEE PLATE S-13.

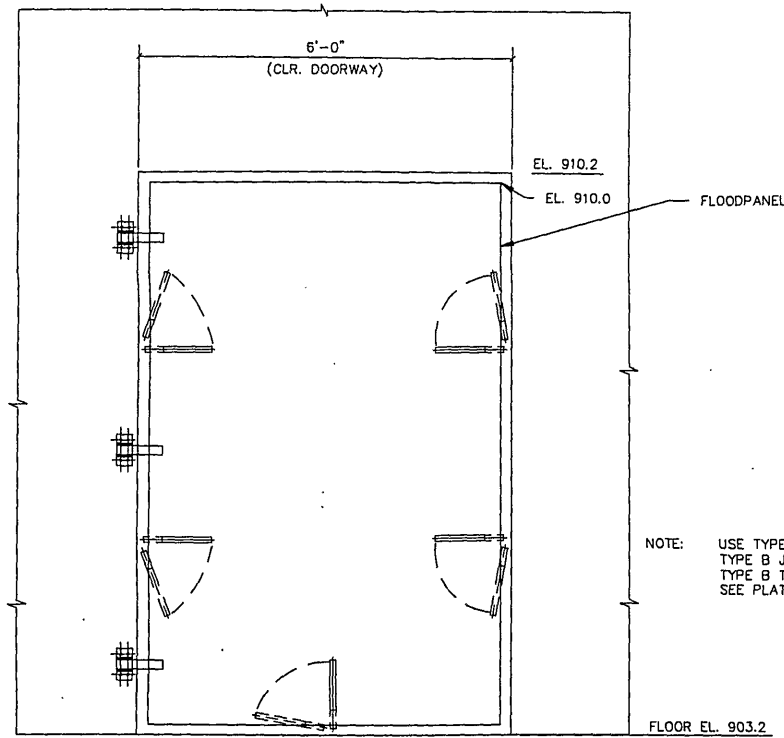

DOOR FLOODPANEL (1 REQ'D)
1"=1'-0"
