


EAST ELEVATION
NTS

NOTE: NORTH, SOUTH & WEST BLDG. ELEVATIONS DO NOT REQUIRE FLOODPROOFING.

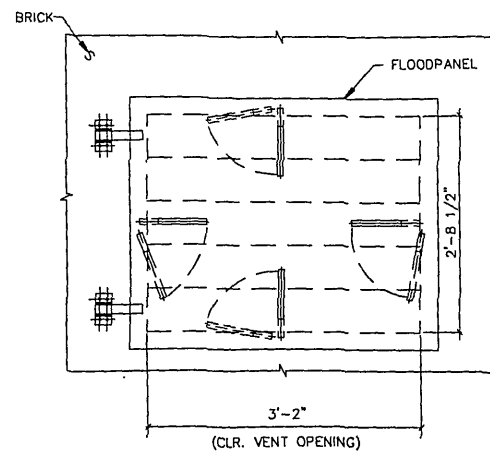

VENT FLOODPANEL (1 REQ'D)
1"=1'-0"

NOTE: USE TYPE C HEAD
TYPE C JAMB, AND
TYPE C SILL.
SEE PLATE S-13

RECORD DRAWING

AS BUILT RECORD DWG		B-31-99	SPH
Symbol	Description	Date	Approved
Revisions			
U.S. ARMY ENGINEER DISTRICT CORPS OF ENGINEERS WILMINGTON, NORTH CAROLINA			
ROANOKE, VIRGINIA FLOOD REDUCTION PROJECT SEWAGE TREATMENT PLANT FLOODPROOFING CHLORINATION BUILDING			
Designed by:	JKJ	Scale:	AS SHOWN
Drawn by:	JKJ	Date:	APRIL, 1991
Checked by:	JBW	Drawing Code:	RR102-02-32
Reviewed by:	W. B. Williams, P.E. CHIEF, STRUCTURES SECTION	Plate Number:	RRSTP9
Approved by:	Ed Lurie, P.E. CHIEF, DESIGN BRANCH	Sheet:	17 of 25

37303017