


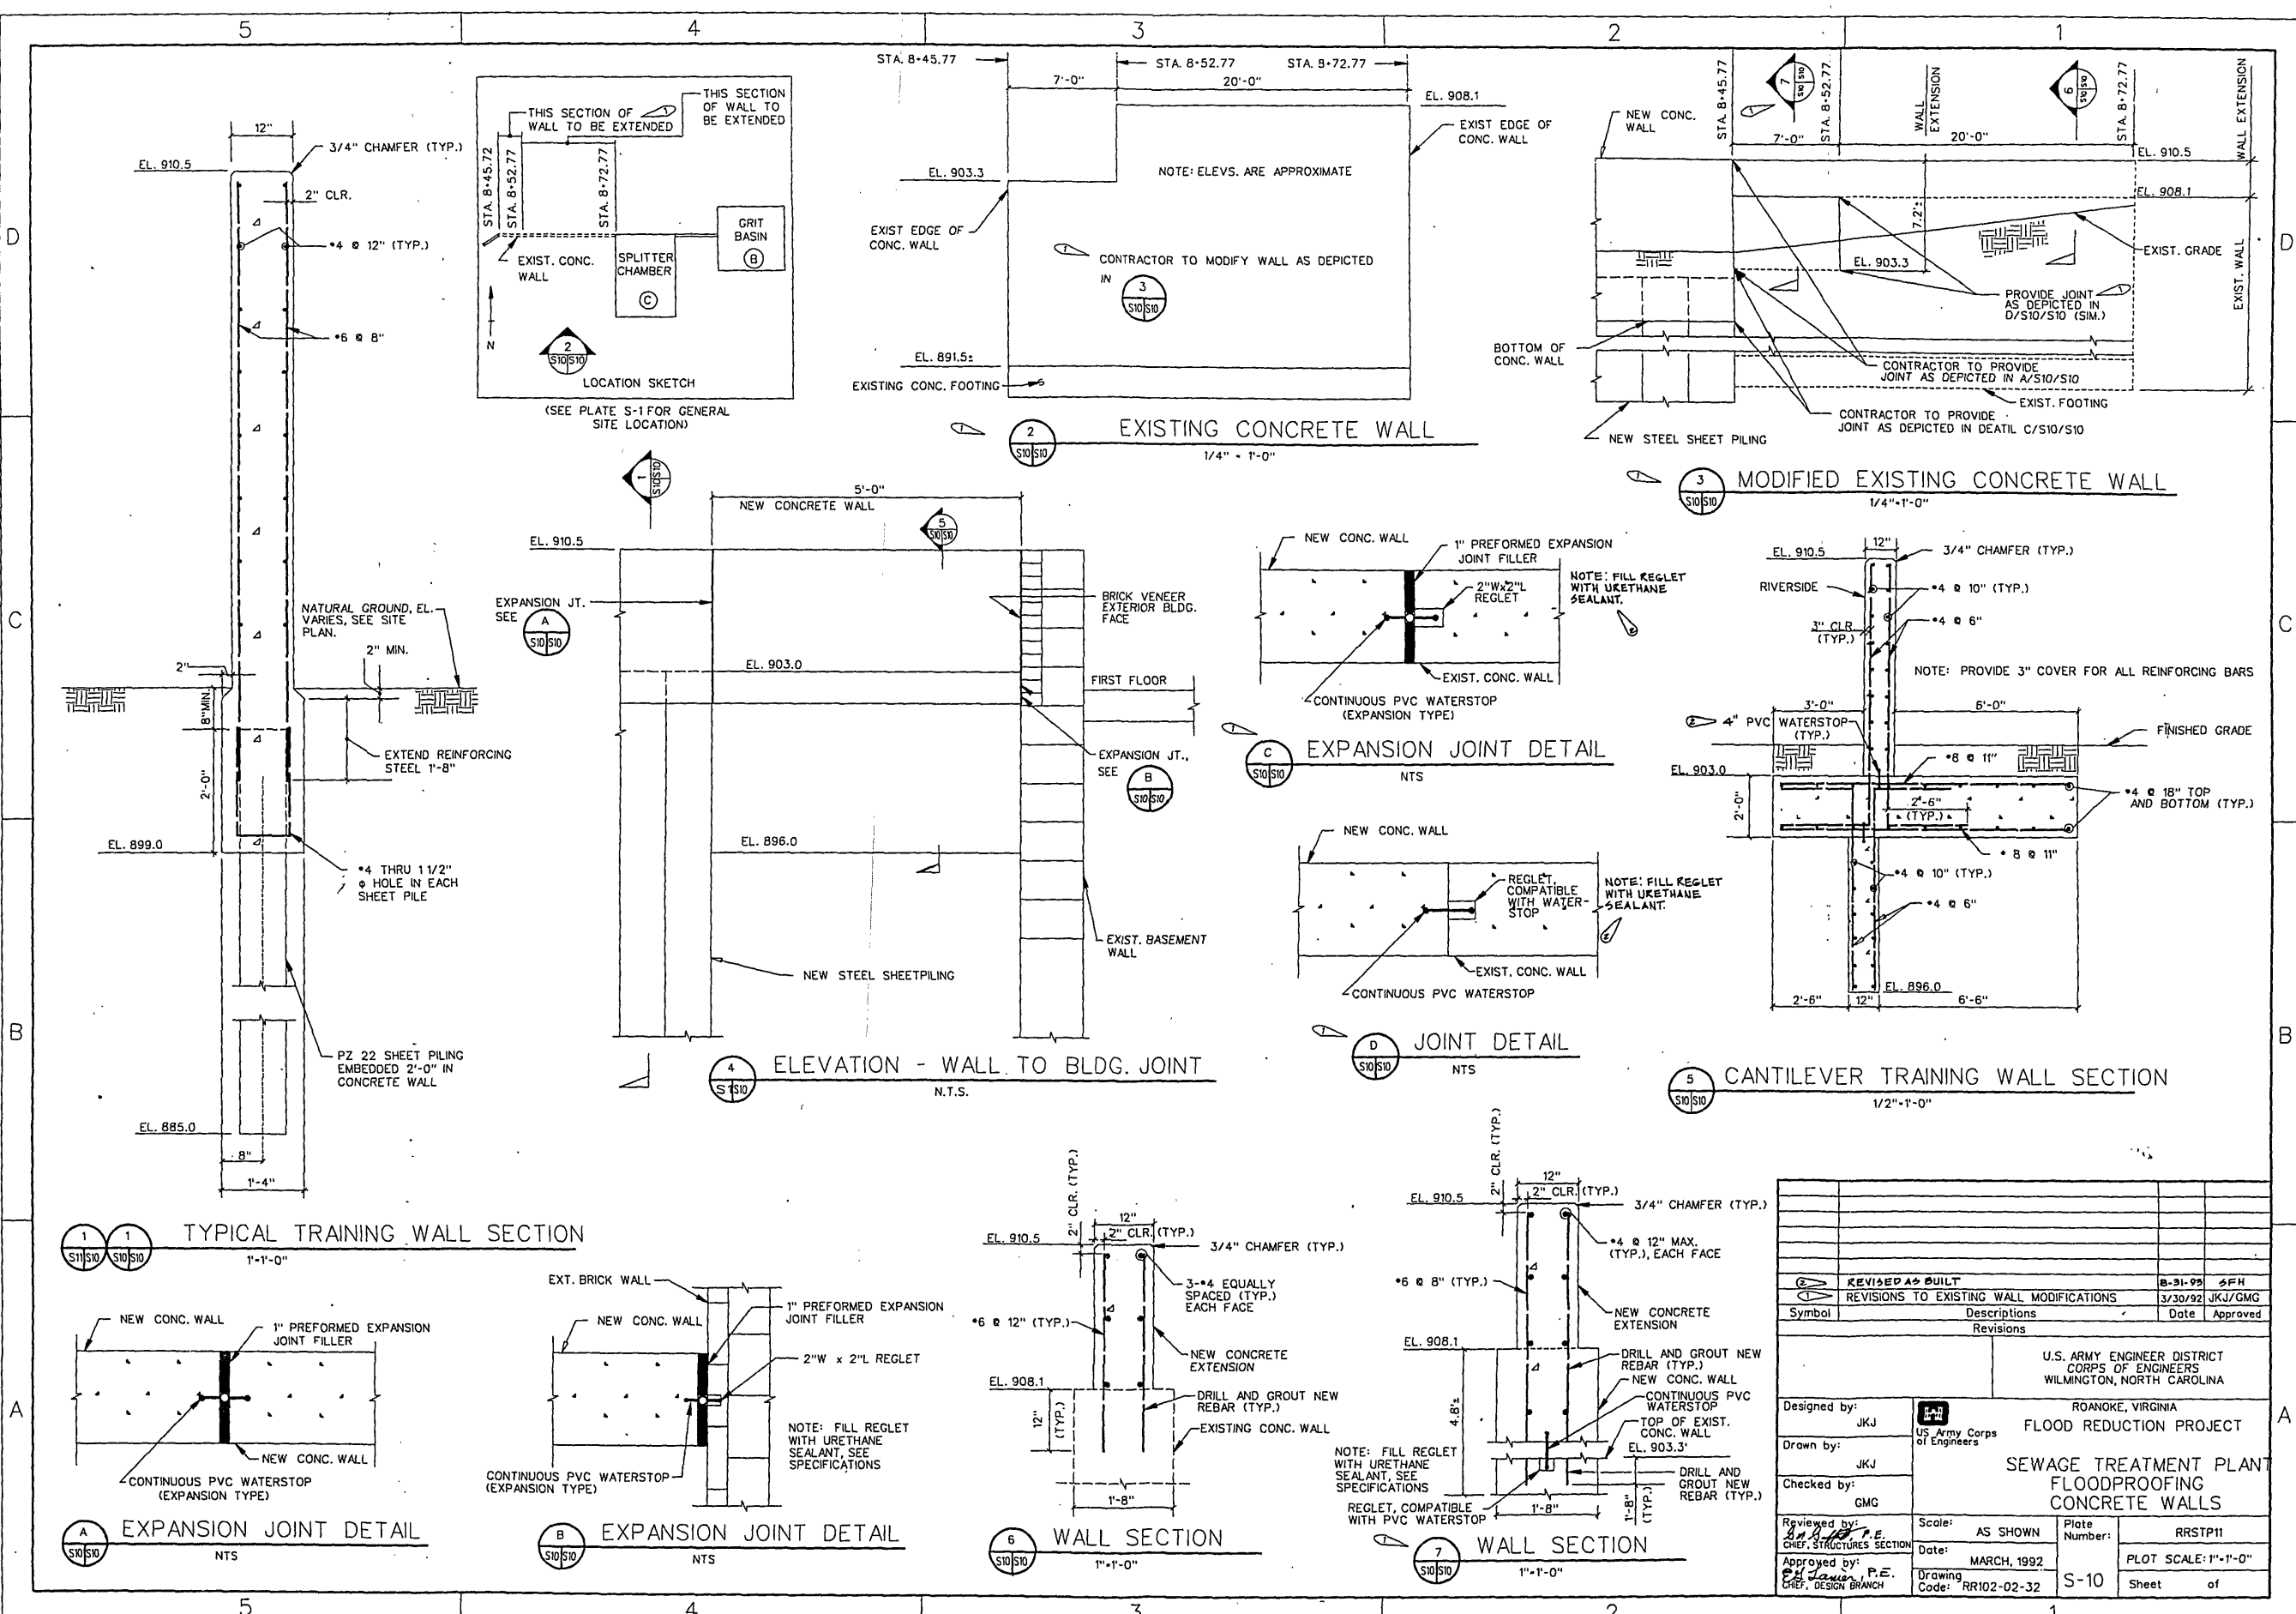

REVISIONS TO EXISTING WALL MODIFICATIONS			
Symbol	Revisions	Date	Approved
1	REVISED AS BUILT	8-31-92	JKJ/GMG
2	REVISIONS TO EXISTING WALL MODIFICATIONS	3/30/92	JKJ/GMG
U.S. ARMY ENGINEER DISTRICT CORPS OF ENGINEERS WILMINGTON, NORTH CAROLINA			
ROANOKE, VIRGINIA			
FLOOD REDUCTION PROJECT			
SEWAGE TREATMENT PLANT FLOODPROOFING CONCRETE WALLS			
Designed by:	JKJ	Scale:	AS SHOWN
Drawn by:	JKJ	Date:	MARCH, 1992
Checked by:	GMG	Drawing Code:	RR102-02-32
Reviewed by:	P.E. CHIEF, STRUCTURES SECTION	Plate Number:	RRSTP11
Approved by:	P.E. CHIEF, DESIGN BRANCH	Sheet	of