




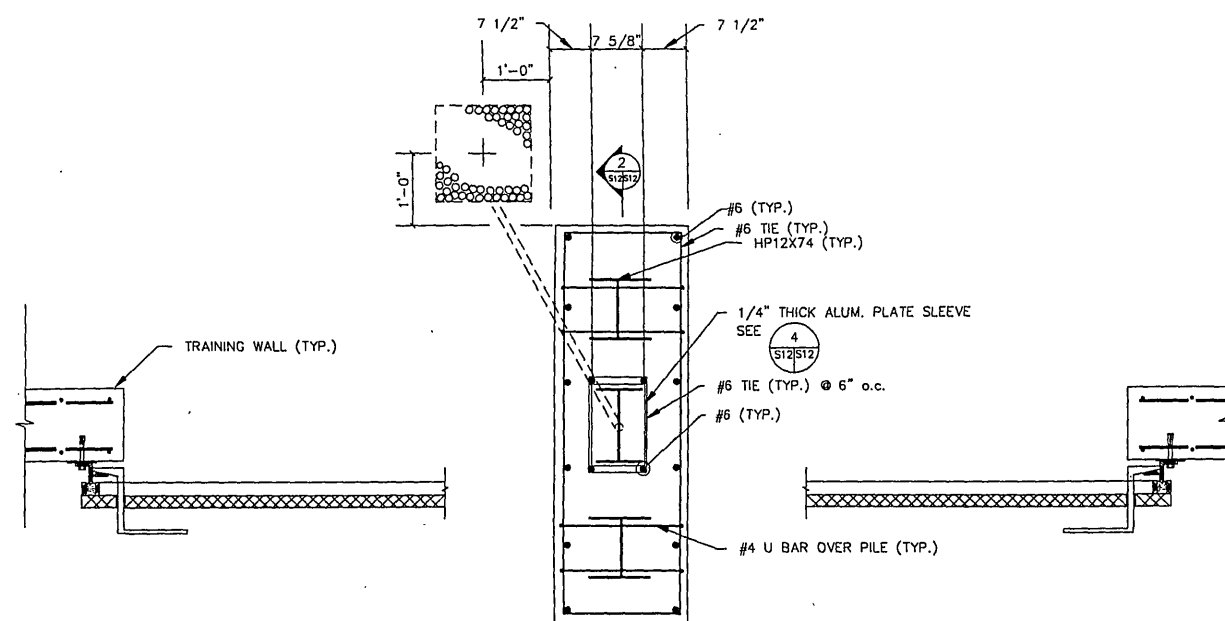


1
S12/S12
PLAN - POST SUPPORT
1"=1'

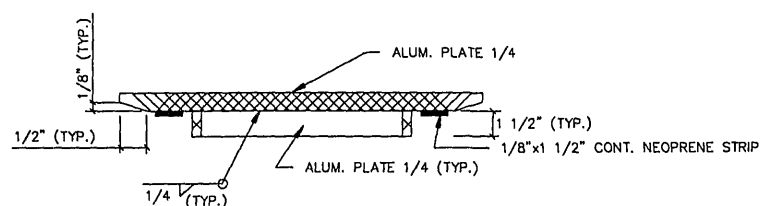


3
S12/S12
POST SUPPORT COVER
NTS

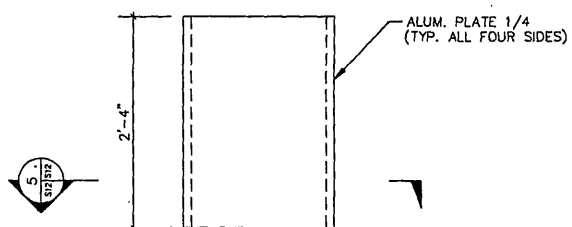

4
S12/S12
ELEV. ALUMINUM SLEEVE
NTS

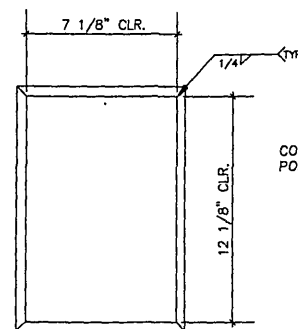

5
S12/S12
SECTION ALUMINUM SLEEVE
NTS

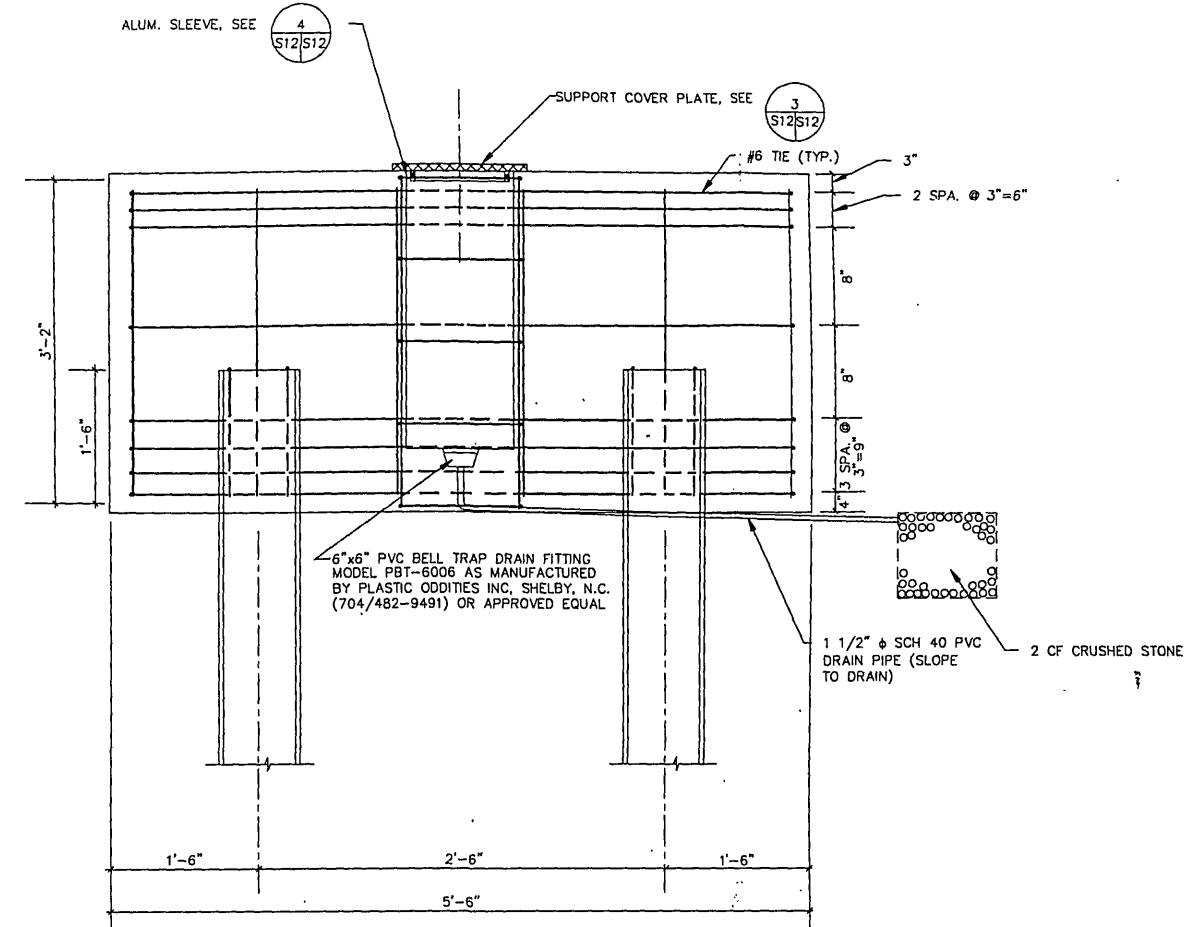

2
S12/S12
SECTION - POST SUPPORT
NTS

AS BUILT RECORD DWS.		B-31-93	SPH
Symbol	Descriptions	Date	Approved
Revisions			
U.S. ARMY ENGINEER DISTRICT CORPS OF ENGINEERS WILMINGTON, NORTH CAROLINA			
ROANOKE, VIRGINIA			
FLOOD REDUCTION PROJECT			
SEWAGE TREATMENT PLANT FLOOD-PROOFING SERVICE ACCESS ROAD			
Designed by:	JKJ	Scale:	AS SHOWN
Drawn by:	JKJ	Date:	NOVEMBER 1990
Checked by:	JBW	Plate Number:	RRSTP13
Reviewed by:	CHIEF, STRUCTURES SECTION	Drawing Code:	RR102-02-32
Approved by:	CHIEF, DESIGN BRANCH		
		PLOT SCALE: 1"=1'-0"	
		Sheet 21 of 25	