


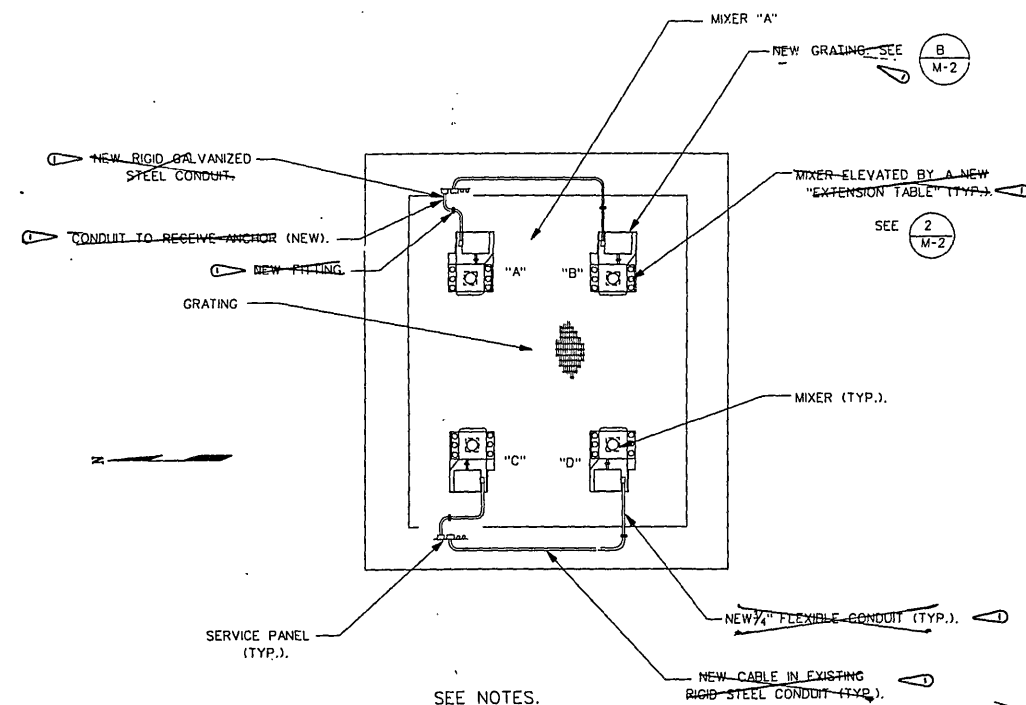


2
M-1

PLAN - FLOCCULATION MIXERS

SCALE: 1/4" = 1'

NOTES:

1. ALL EQUIPMENT IS EXISTING UNLESS OTHERWISE NOTED.
2. NEW FLEXIBLE CONDUIT AND NEW CABLE SHALL BE PROVIDED BETWEEN THE SERVICE PANEL AND MIXER AT EACH OF FOUR (4) LOCATIONS. ADDITIONALLY, MIXER "A" SHALL RECEIVE A LENGTH OF RIGID CONDUIT AS INDICATED. CABLE SHALL BE 3*10 THW * 10' GND.

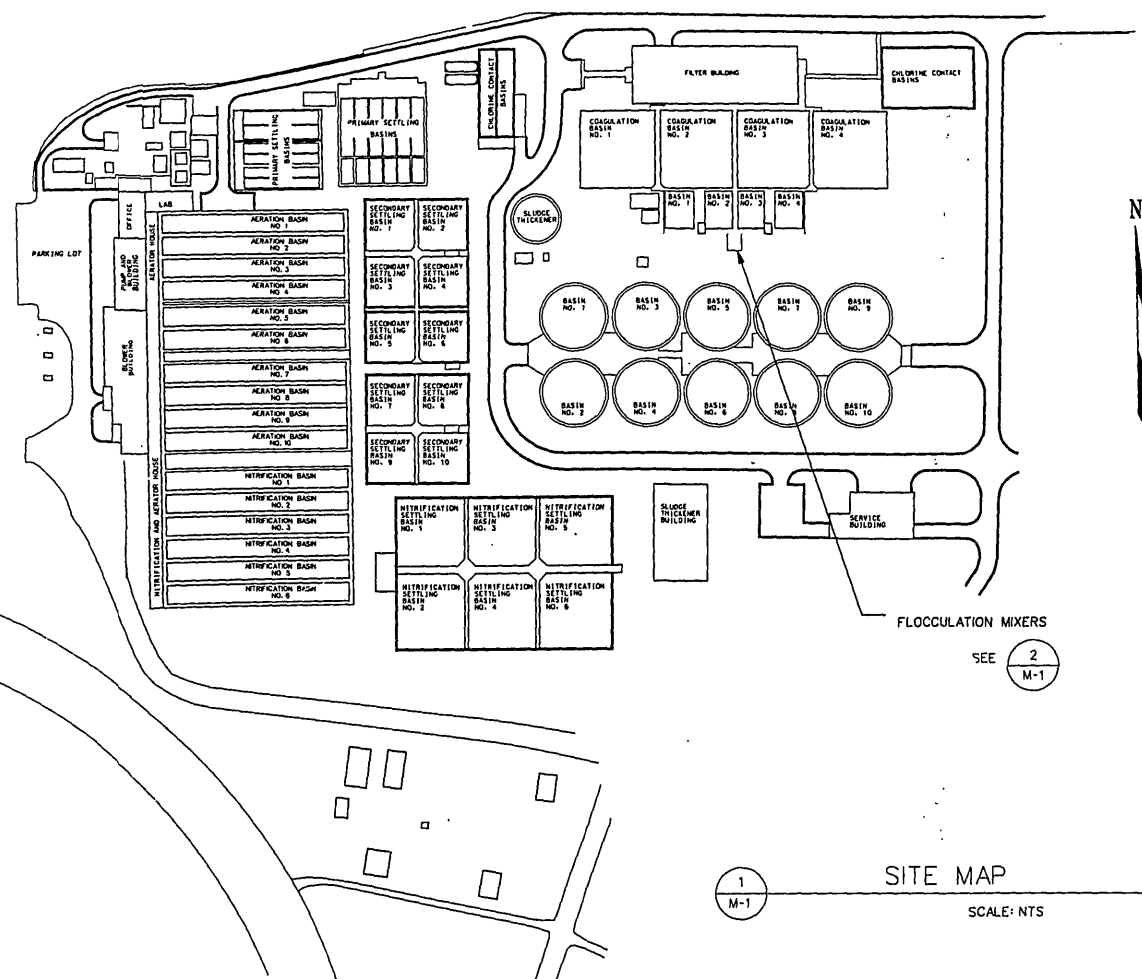

1
M-1

SITE MAP

SCALE: NTS

AS BUILT RECORD DWG		9-91-05	SPH
Symbol	Descriptions	Date	Approved
Revisions			
U.S. ARMY ENGINEER DISTRICT CORPS OF ENGINEERS WILMINGTON, NORTH CAROLINA			
Designed by:	ROANOKE, VIRGINIA		
WBD	US Army Corps of Engineers		
Drawn by:	FLOOD REDUCTION PROJECT		
WBD	PLAN - FLOCCULATION MIXERS		
Checked by:	SITE MAP		
JGP			
Reviewed by:	Scale: AS SHOWN	Plate Number:	
CHIEF ELEC MECH SECTION	Date: 23 APRIL 1991	M-1	
Approved by:	Drawing Code: RR102-02-32	Sheet: 23 of 25	
CHIEF DESIGN BRANCH			