


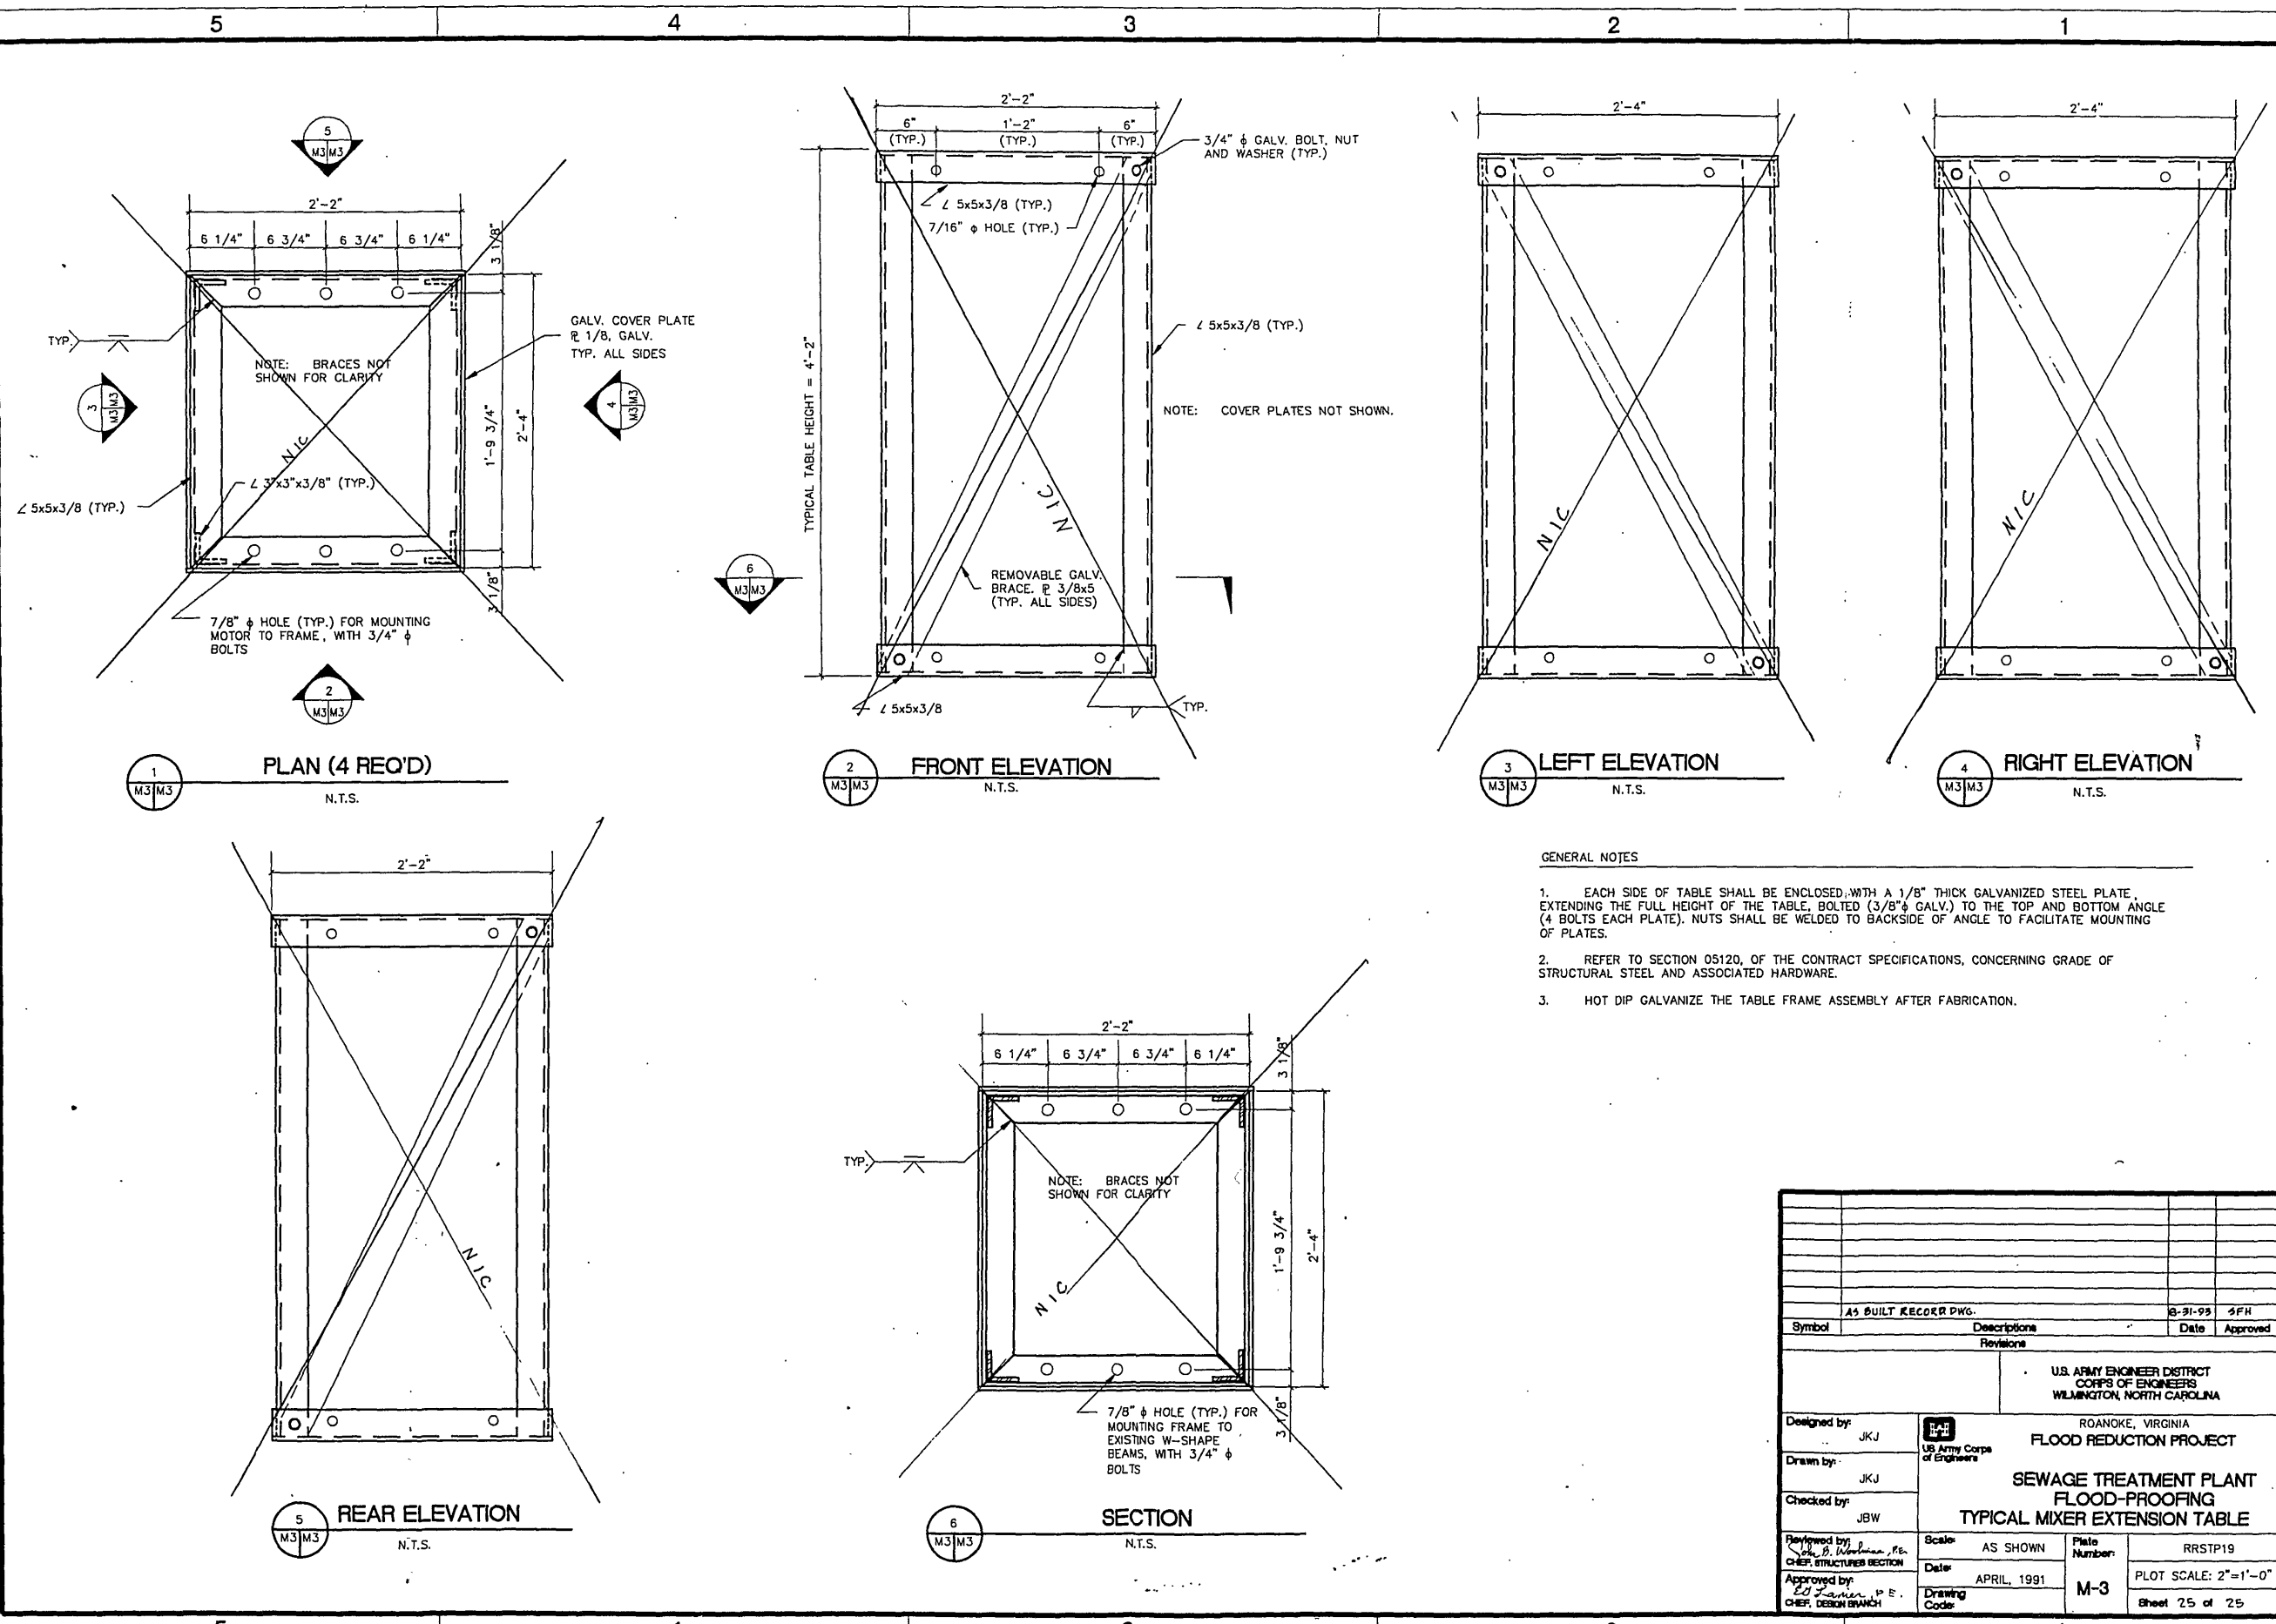

AS BUILT RECORD DWG.		8-91-95	5FH
Symbol	Descriptions	Date	Approved
Revisions			
U.S. ARMY ENGINEER DISTRICT CORPS OF ENGINEERS WILMINGTON, NORTH CAROLINA			
ROANOKE, VIRGINIA			
FLOOD REDUCTION PROJECT			
SEWAGE TREATMENT PLANT FLOOD-PROOFING TYPICAL MIXER EXTENSION TABLE			
Designed by:	JKJ	Scale:	AS SHOWN
Drawn by:	JKJ	Plate Number:	RRSTP19
Checked by:	JBW	Date:	APRIL, 1991
Reviewed by:	Ed Janner, P.E. CHIEF, DESIGN BRANCH	Drawing Code:	M-3
PLOT SCALE: 2"=1'-0"		Sheet 25 of 25	