


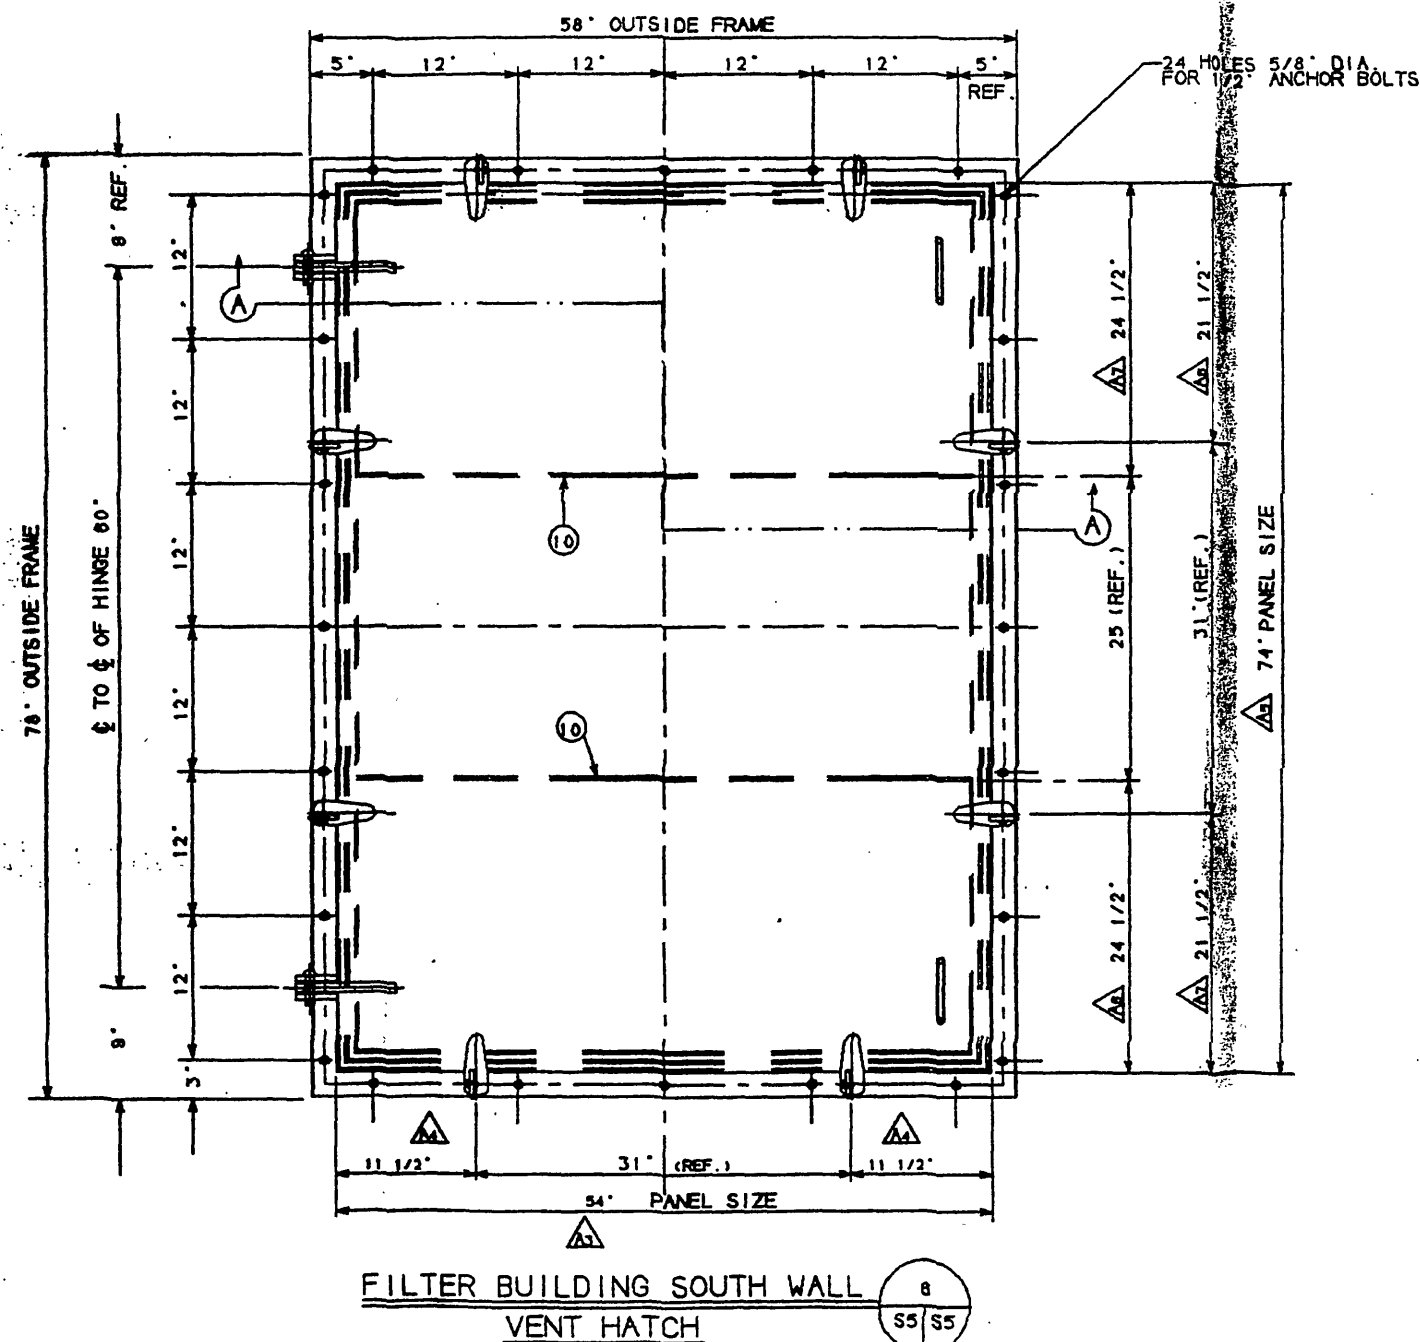

	30	----	-----	-----	-----	-----
	28	----	-----	-----	-----	-----
	28	----	-----	-----	-----	-----
A1	27	8	3/8 STAPLE	ALUM 5086	-----	3/8 DIA.
A2	25	18	WASHER	304 SS	-----	3/4" STD.
	28	----	-----	-----	-----	-----
A1	24	2	GRAB HANDLE	ALUM 5086	B-WK-788-1	1/2 DIA.
	23	----	-----	-----	-----	-----
	22	----	-----	-----	-----	-----
	21	----	-----	-----	-----	-----
	20	----	-----	-----	-----	-----
A1	18	4	HINGE PAD	ALUM 5086	B-WK-788-2	1/2X1 3/4
	18	2	HINGE PIN W/COTT	304 SS		3/4 DIA.
A1	17	2	HINGE BLADE	ALUM 5086	B-WK-788-1	3/4 PL.
A1	16	1	RETAINER	ALUM 5086		1/4X1 1/2
	15	----	-----	-----	-----	-----
	14	----	-----	-----	-----	-----
	13	----	-----	-----	-----	-----
	12	----	-----	-----	-----	-----
	11	----	-----	-----	-----	-----
A1	10	2	STIFFENER	ALUM 5086	-----	3X4X1 1/4
B2	9	8	COLLAR & PIN	CRES	D-WK-788-1	3/4" DIA.
A1	8	8	DOG PAD	ALUM 5086	B-WK-788-3	3/4 FB
B3	7	8	RING BOLT	MN. BRZ.	-----	3/4" DIA.
B3	6	8	DROP BOLT	304 SS	-----	3/4"X4-1/2L
	5	24	EXPANSION ANCHOR	GALV. ST.	-----	1/2 DIA.
	4	----	-----	-----	-----	-----
	3	1	GASKET 1/2X1 1/4	NEOPRENE	-----	25 DURO
A1	2	1	FRAME	ALUM 5086		3X3X1 1/4
A1	1	1	PANEL	ALUM 5086		1/4" PL.
	PN	QTY	DESCRIPTION	MATERIAL	DWG NO.	REMARKS

DATE	WALZ & KRENZER, INC.		
ISSUED	90 FOREST AVE. LOCUST VALLEY, NY 11560		
ORDERED	ROANOKE VA. - FLOOD REDUCTION PROJECT		
APPROVED	US ARMY CORPS OF ENGINEERS		
	FILTER BUILDING SOUTH WALL		
	VENT HATCH		
P.O.:	1058	SIZE	FEET NO.
JOB NO.:	8274	D	63705
		D-WK-768-12	B
		SCALE: 1" = 1'-0"	DATE: 1 1 1