




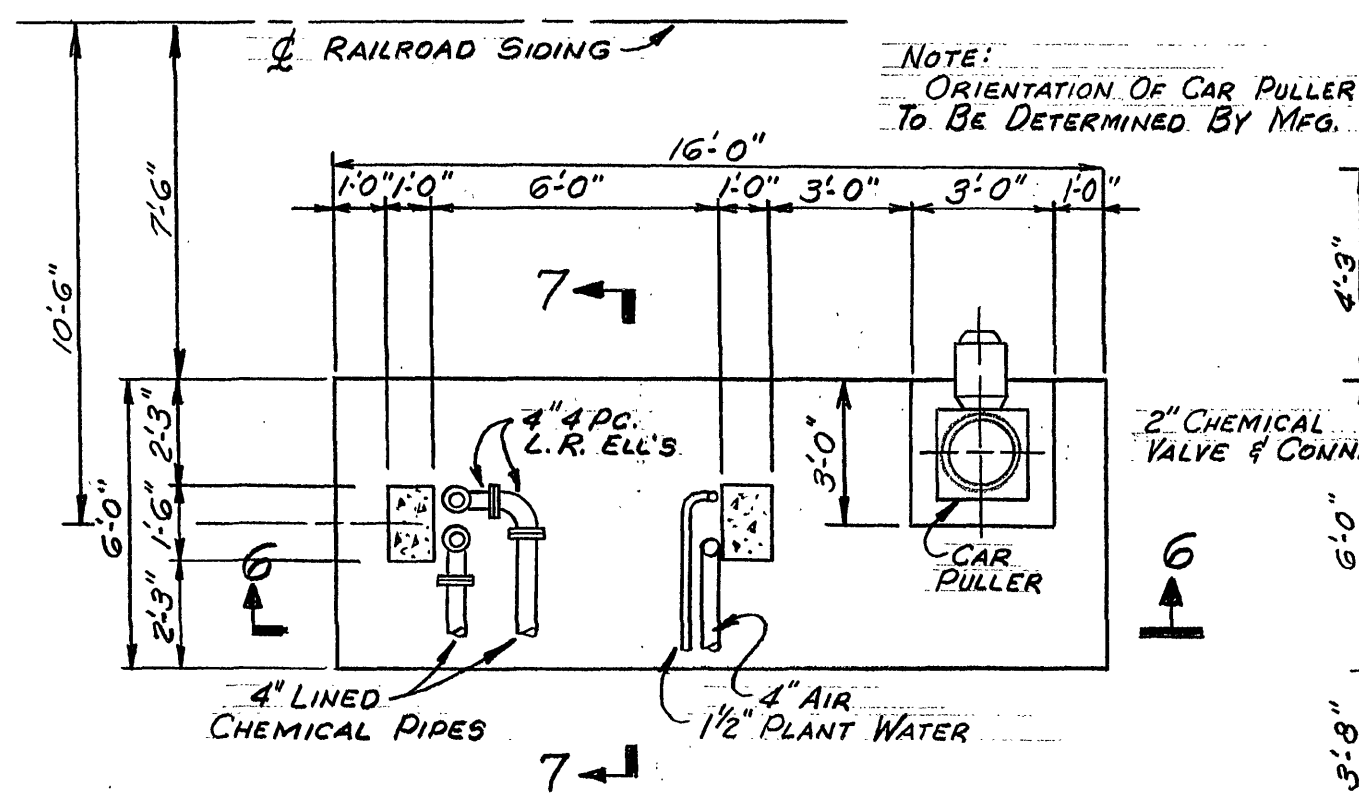


FOOTING PLAN  
SCALE 1/4"=1'-0"

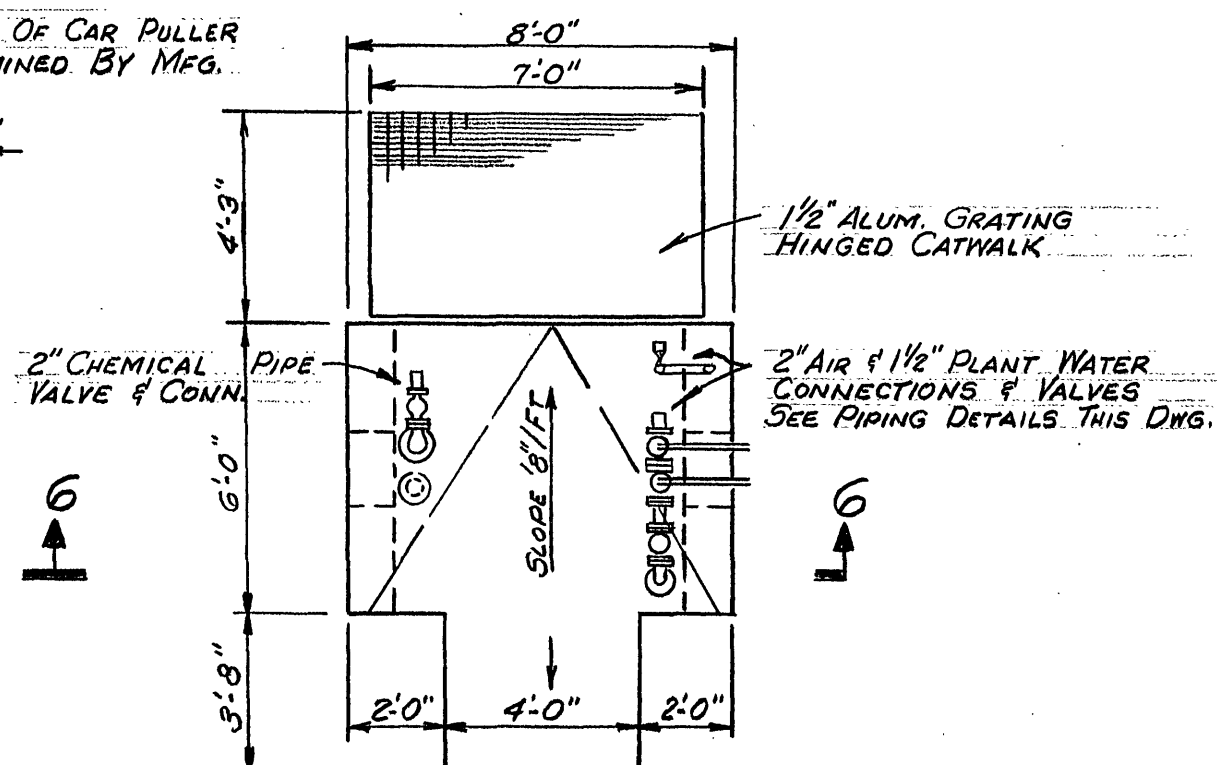


TOP OF CONC. PLAN

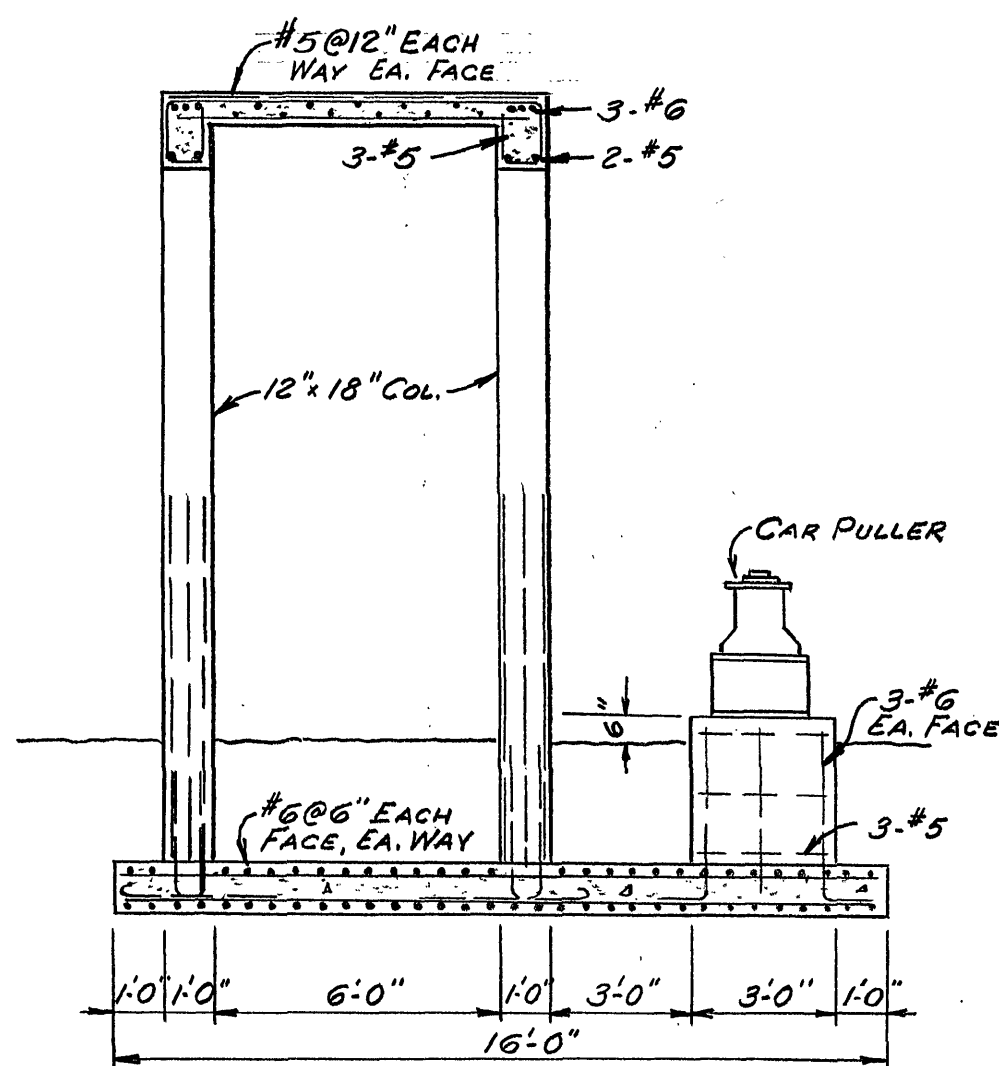


SECTION 6-6  
SCALE 1/4"=1'-0"

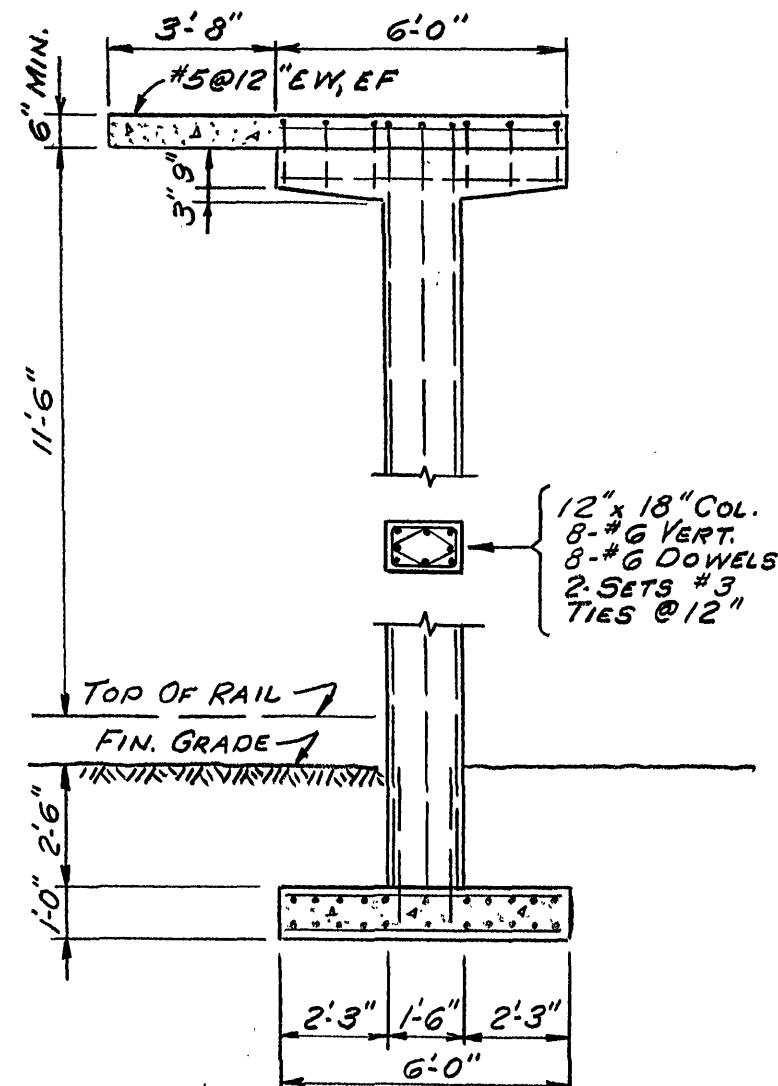

SECTION 7-7  
SCALE 1/4"=1'-0"

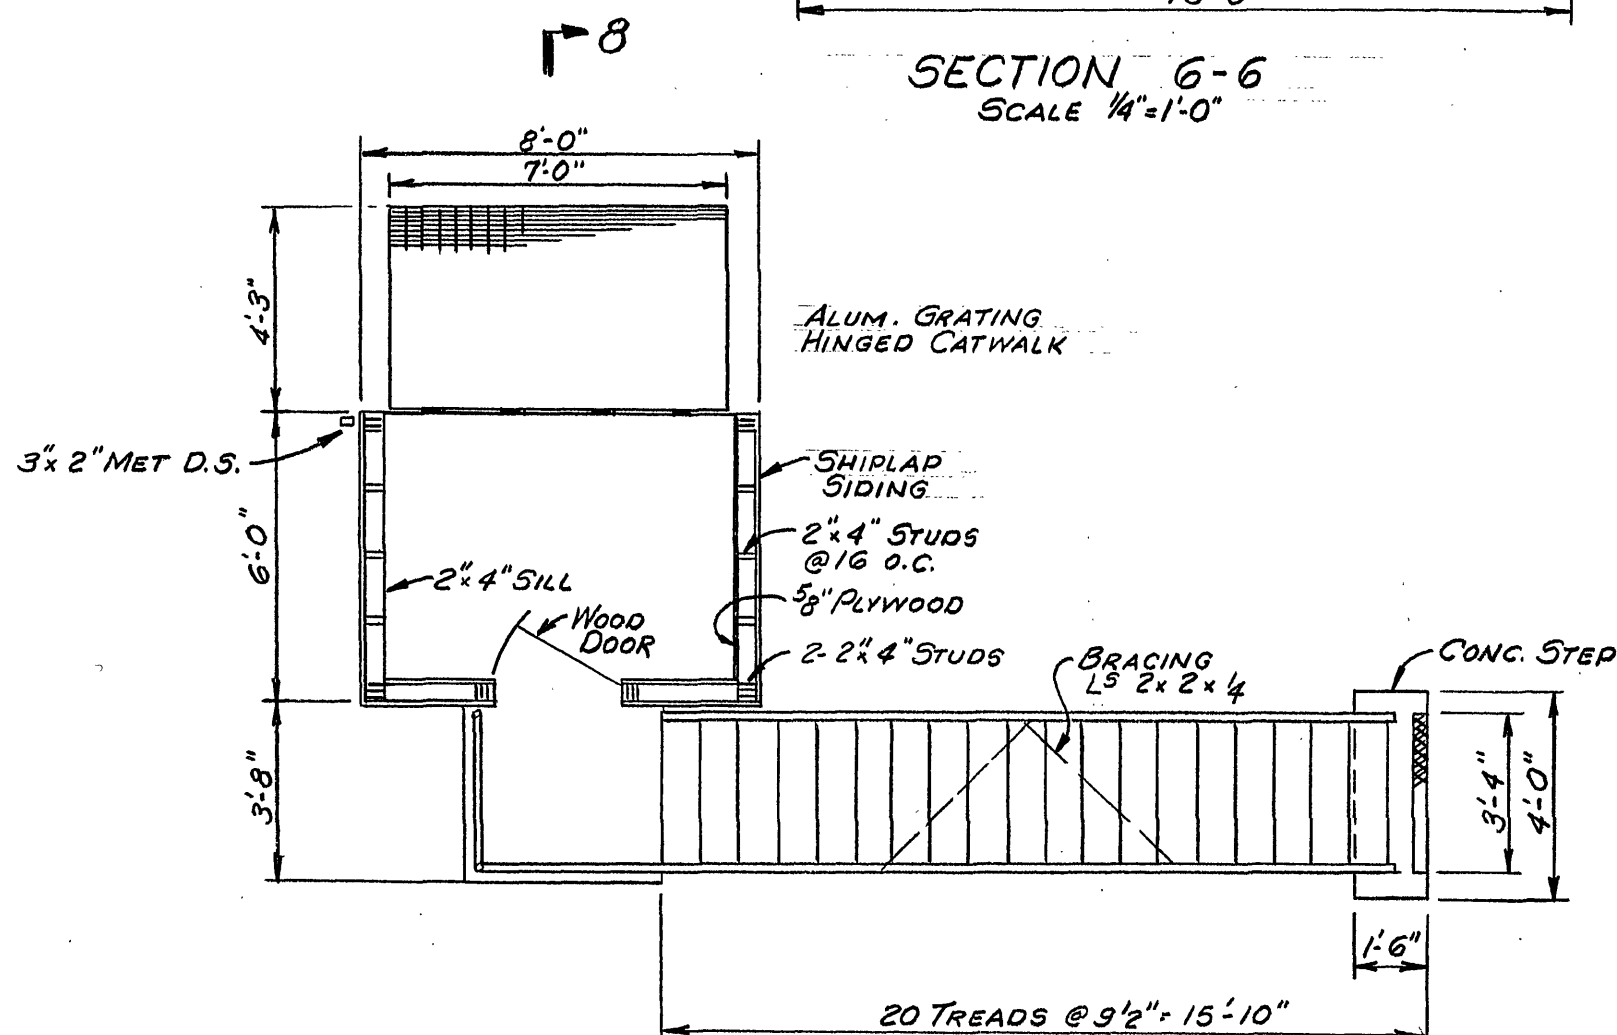

PLAN - UNLOADING SHED  
SCALE 1/4"=1'-0"

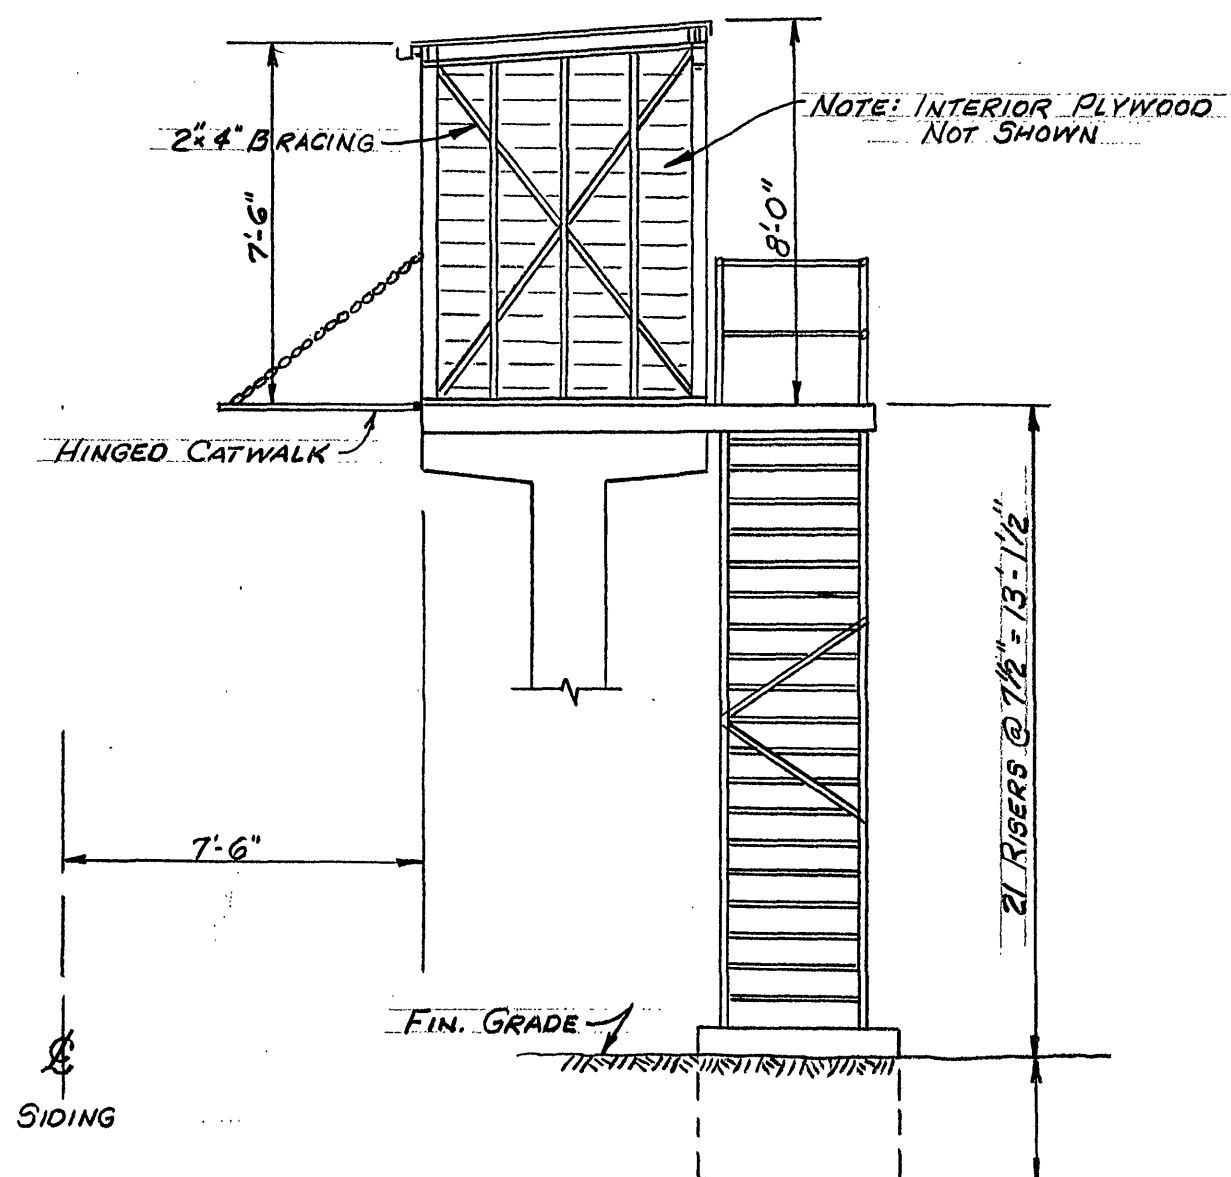

SECTION 8-8  
SCALE 1/4"=1'-0"

## CHEMICAL UNLOADING PLATFORM

TRACED FROM SH. 2 - PHOSPHORUS REMOVAL FACILITIES - SEWAGE TREATMENT PLANT ADDITIONS - REV. MAR. 3, 1972. THIS TRACING REVISED TO SHOW NORFOLK & WESTERN RAILROADS SETBACK REQUIREMENT AND REVISED HINGED CATWALK DIMENSION.

PLAN NO. 5318

MAY 26, 1972