


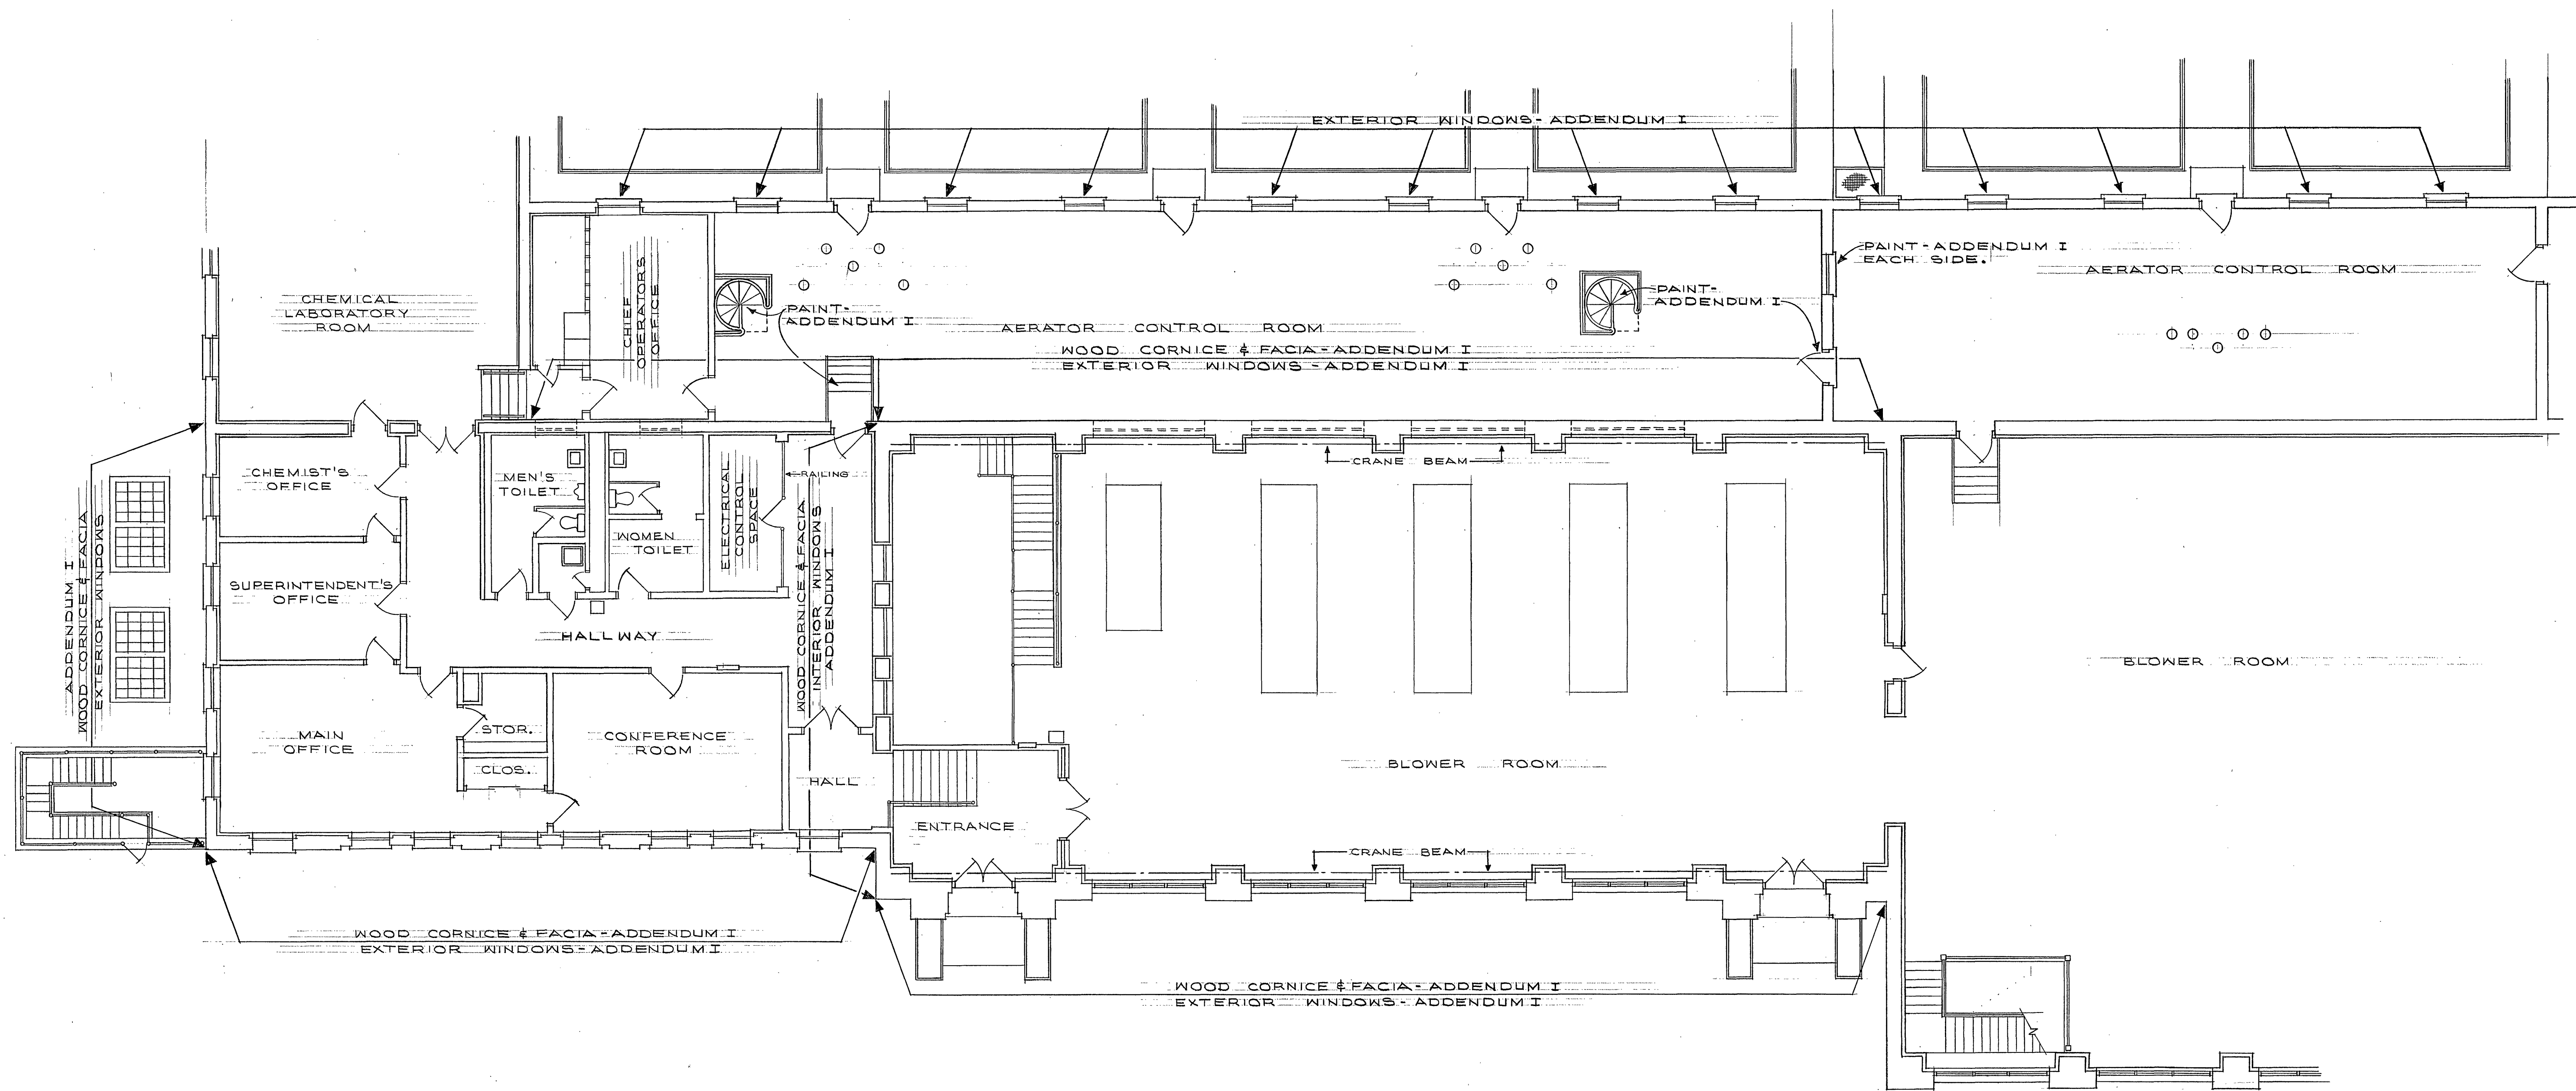

MAIN FLOOR PLAN
SCALE: 1/8" = 1'-0"

10-27-76	1	ADDENDUM I	LBV
DATE	REV.	DESCRIPTION	BY
MAIN FLOOR PLAN			
CITY ENGINEER			
DRAWN LBV			
CHECKED LBC			
APPROVED			
DATE 10-16-76			
JOB NO. 4401			
SHEET 3			
OF 3			
CONTRACTOR MUST VERIFY ALL DIMENSIONS AT PROJECT BEFORE PROCEEDING WITH WORK			