


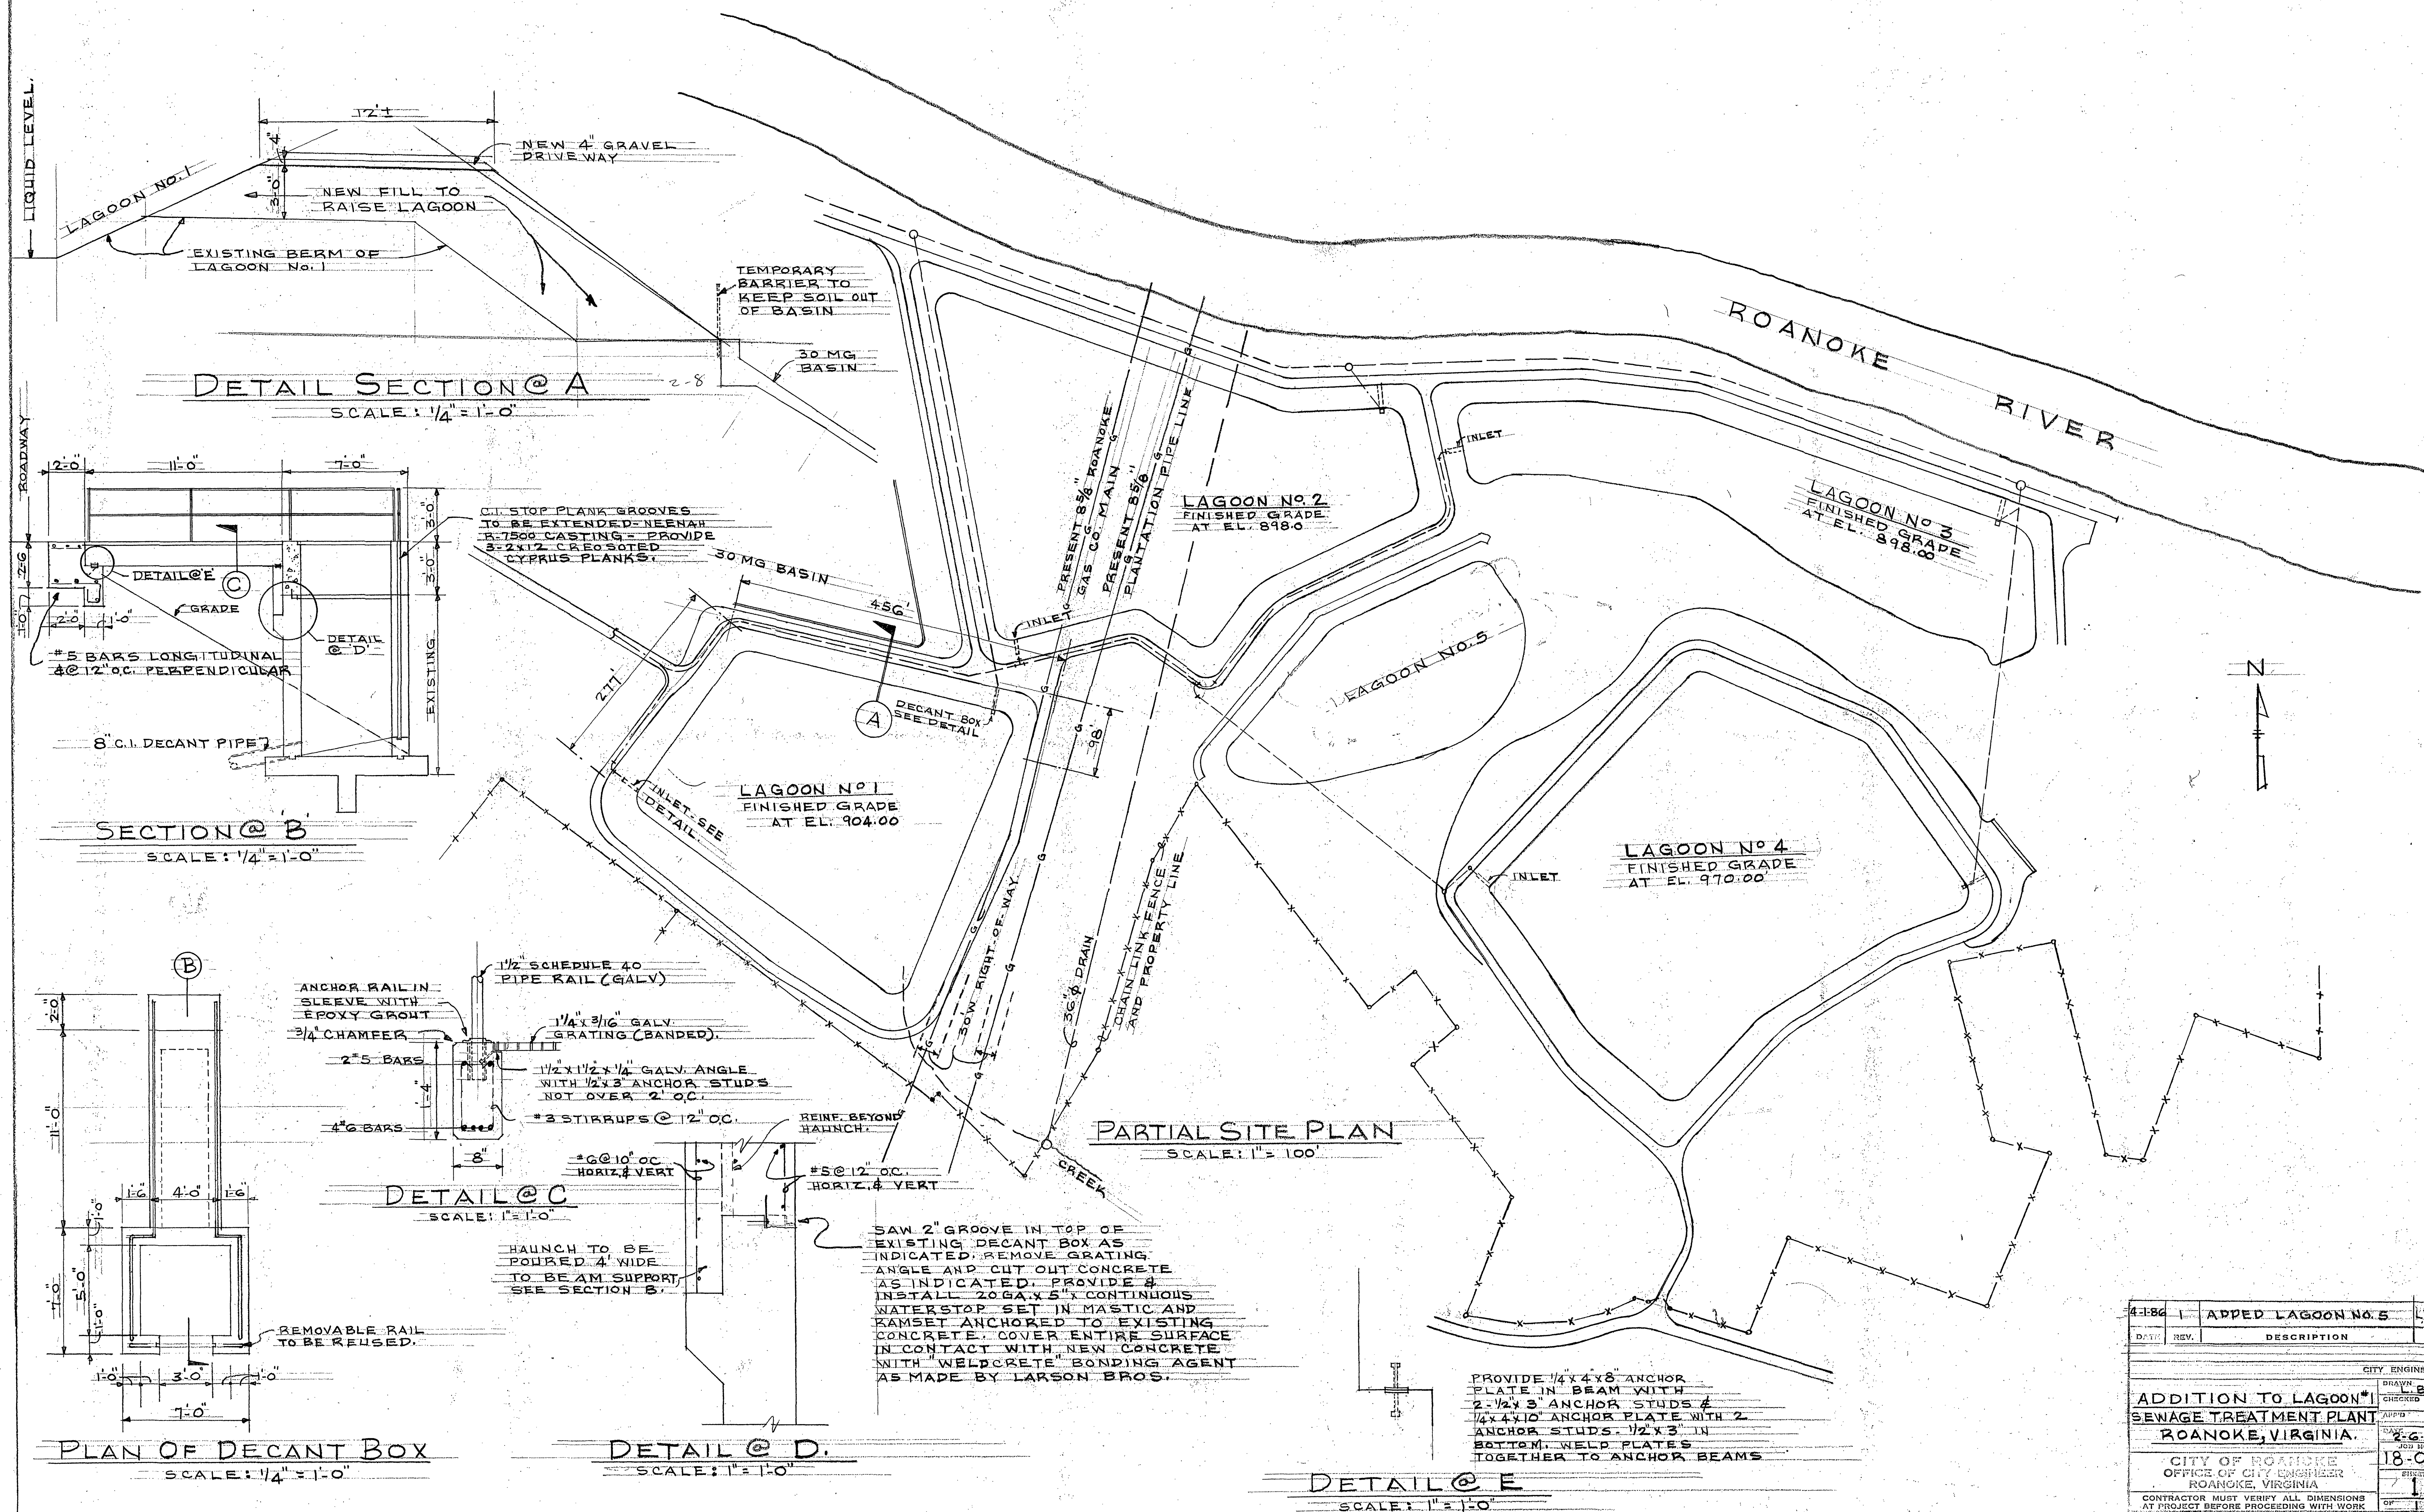

4-8-60	1	ADDED LAGOON NO.5	18-04
DATE	REV.	DESCRIPTION	BY
CITY ENGINEER			
ADDITION TO LAGOON #1			BROWN 8-6
SEWAGE TREATMENT PLANT			CHECKED
ROANOKE, VIRGINIA.			AUG 10
CITY OF ROANOKE			DATE 2-6-80
OFFICE OF CITY ENGINEER			703 NO.
ROANOKE, VIRGINIA			18-04
CONTRACTOR MUST VERIFY ALL DIMENSIONS			SHEET
1			1
OF			1