
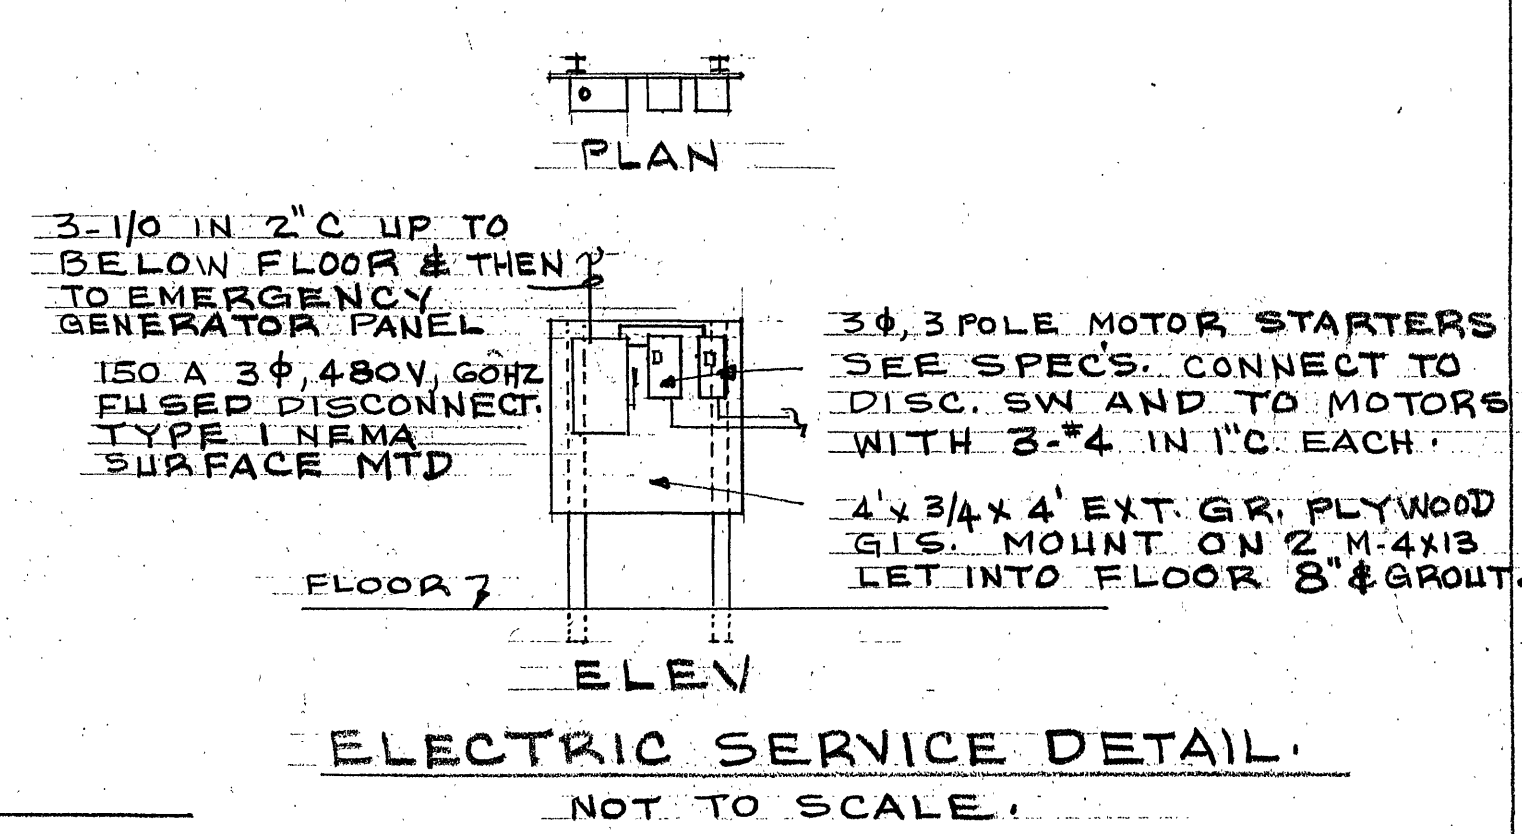


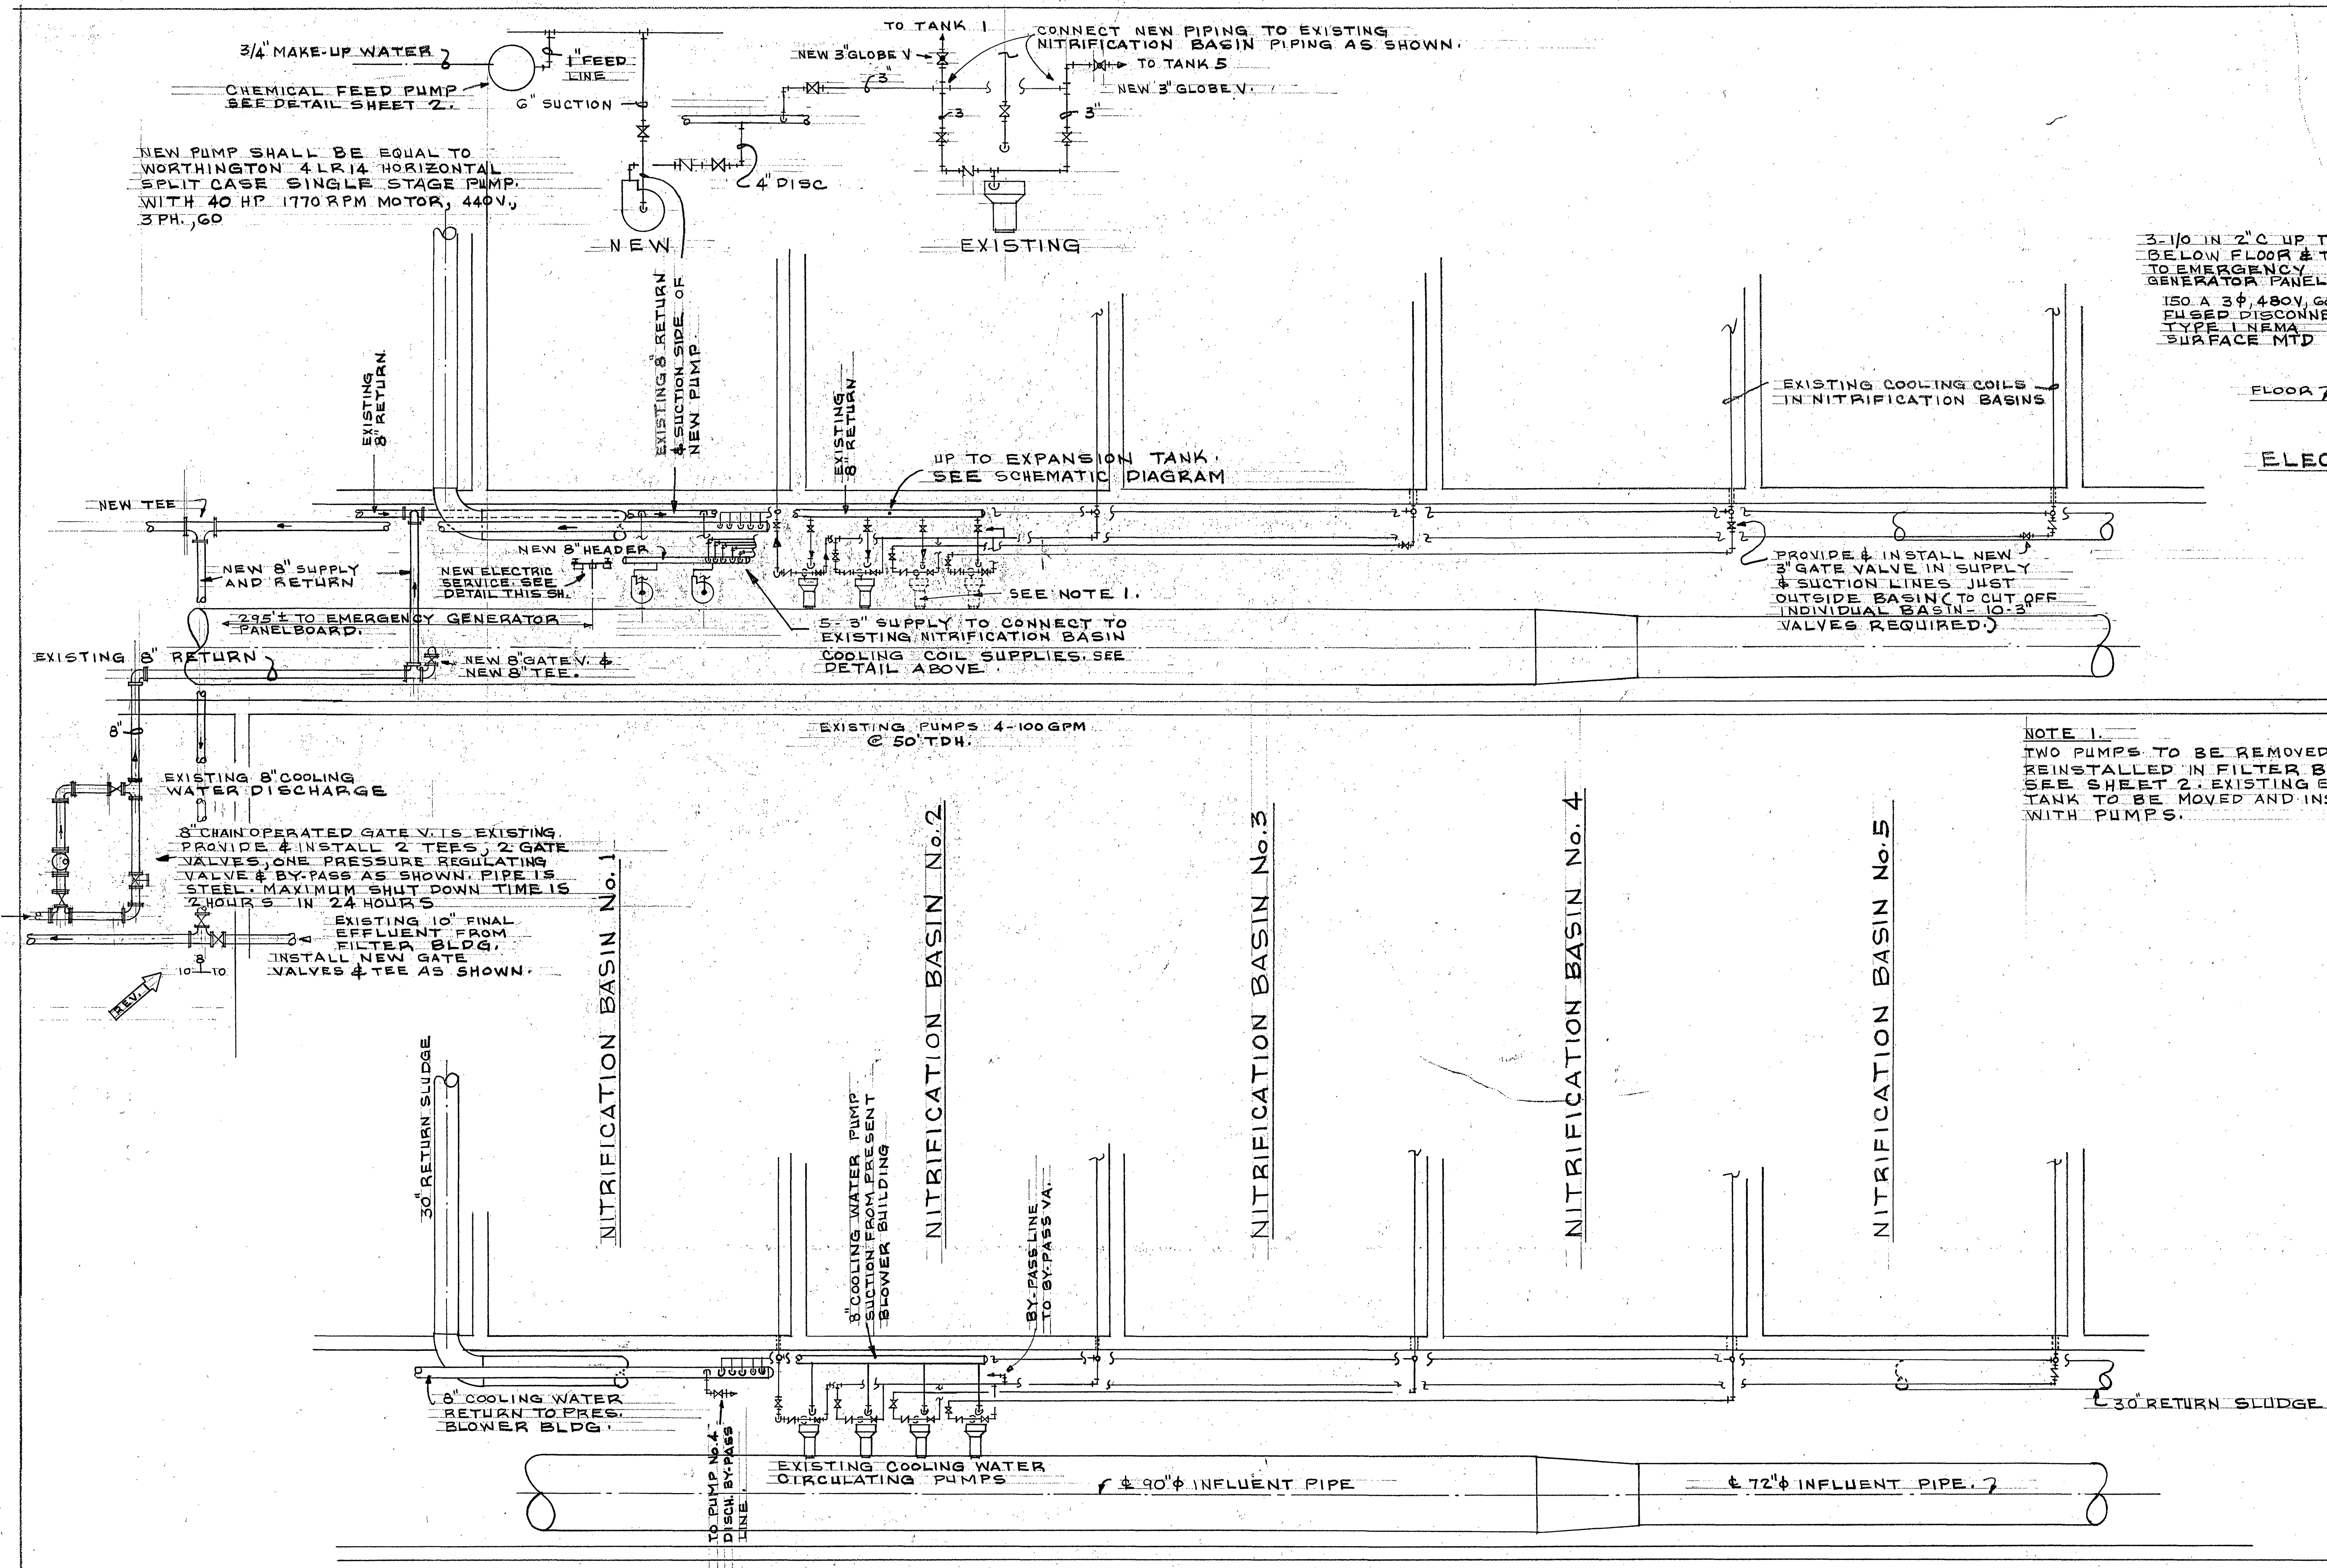

NOTE 1.
TWO PUMPS TO BE REMOVED AND
REINSTALLED IN FILTER BUILDING
SEE SHEET 2. EXISTING EXPANSION
TANK TO BE MOVED AND INSTALLED
WITH PUMPS.

EXISTING CONDITIONS @
COOLING WATER CIRCULATING PUMPS.

6-29-81	1	CHANGED VALVES @ 18-10	LBC
DATE	REV.	DESCRIPTION	BY
CITY ENGINEER			
DRAWN			
CHECKED			
APPROVED			
DATE			
JOB NO.			
18-09			
CITY OF ROANOKE			
OFFICE OF CITY ENGINEER			
ROANOKE, VIRGINIA			
CONTRACTOR MUST VERIFY ALL DIMENSIONS AT PROJECT BEFORE PROCEEDING WITH WORK			
OF 2			