




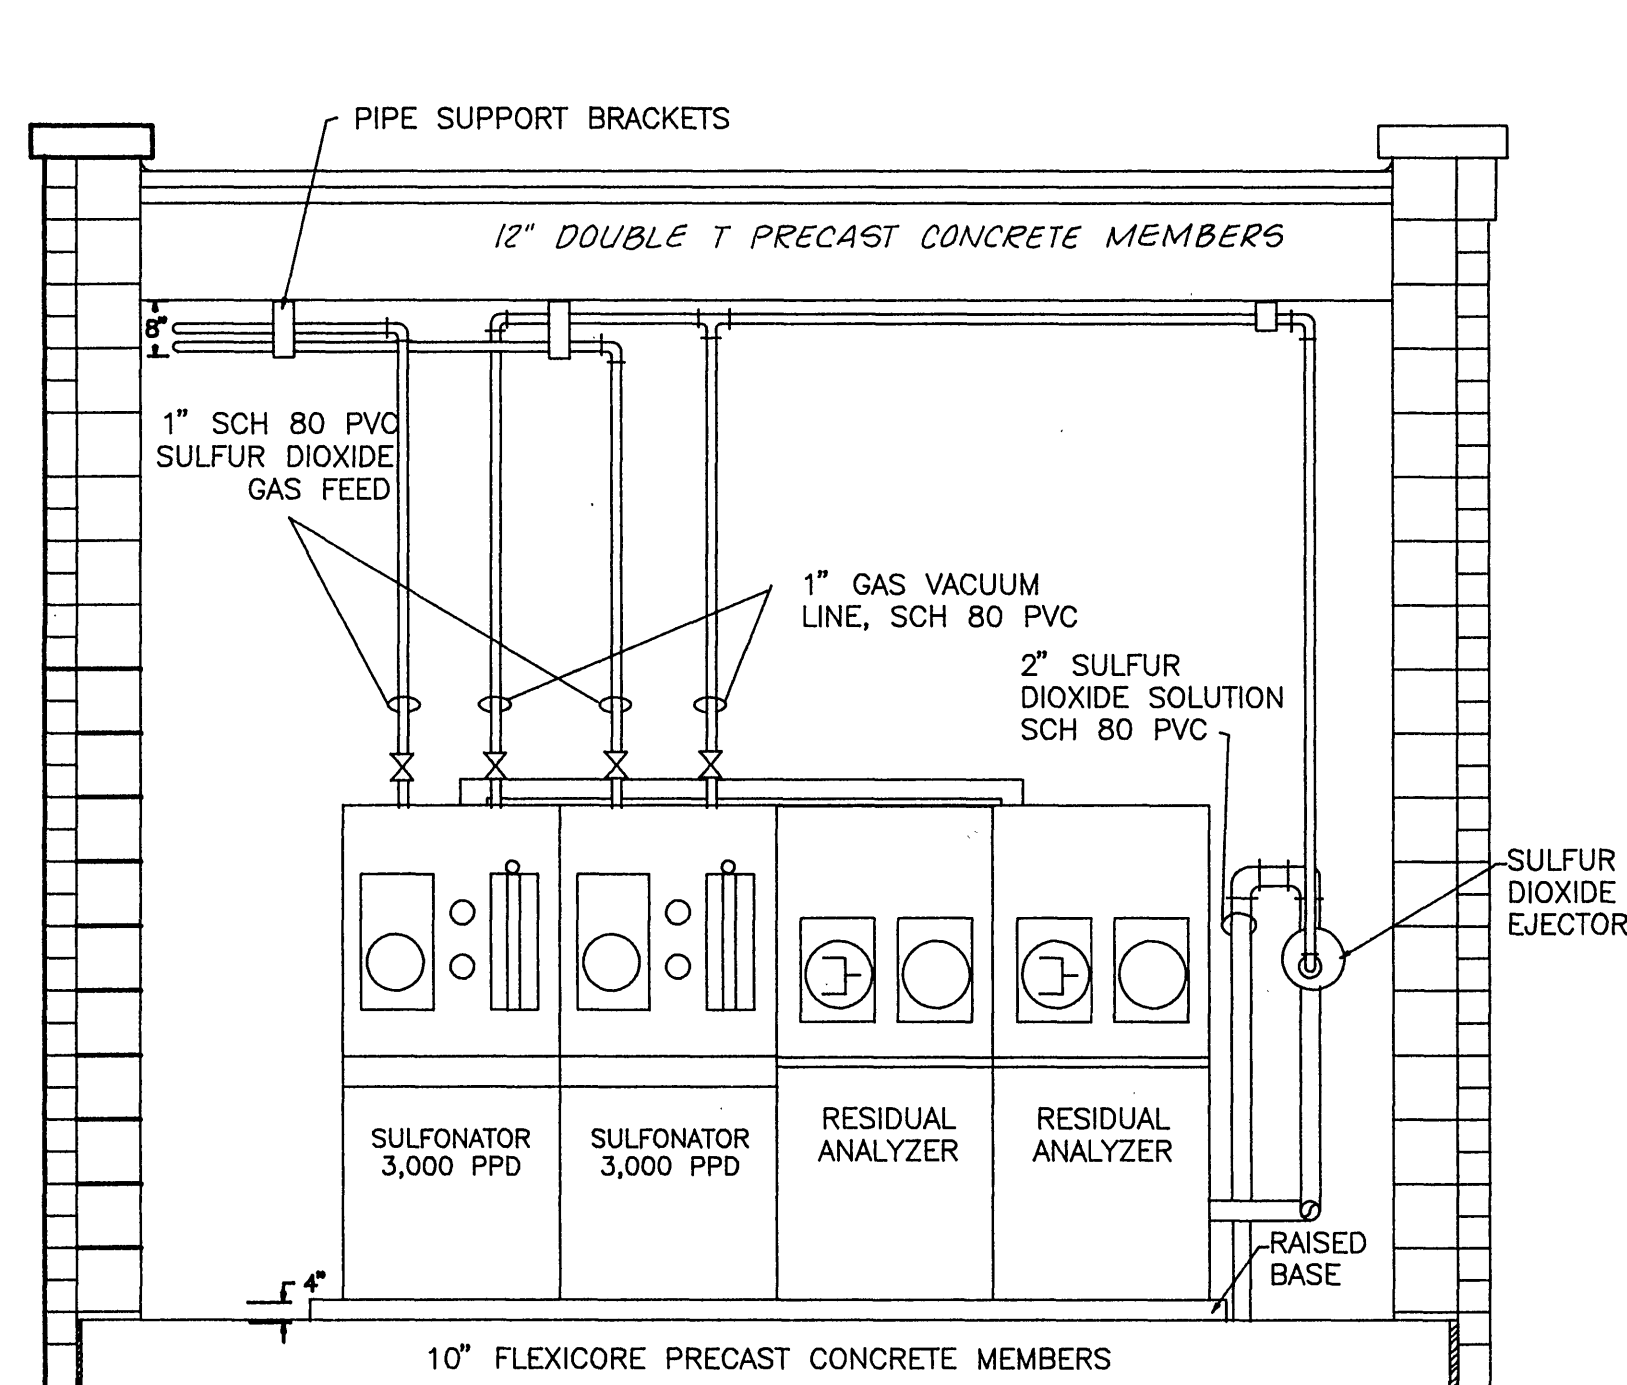


SULFONATION ROOM SECTION C-4
NOT TO SCALE

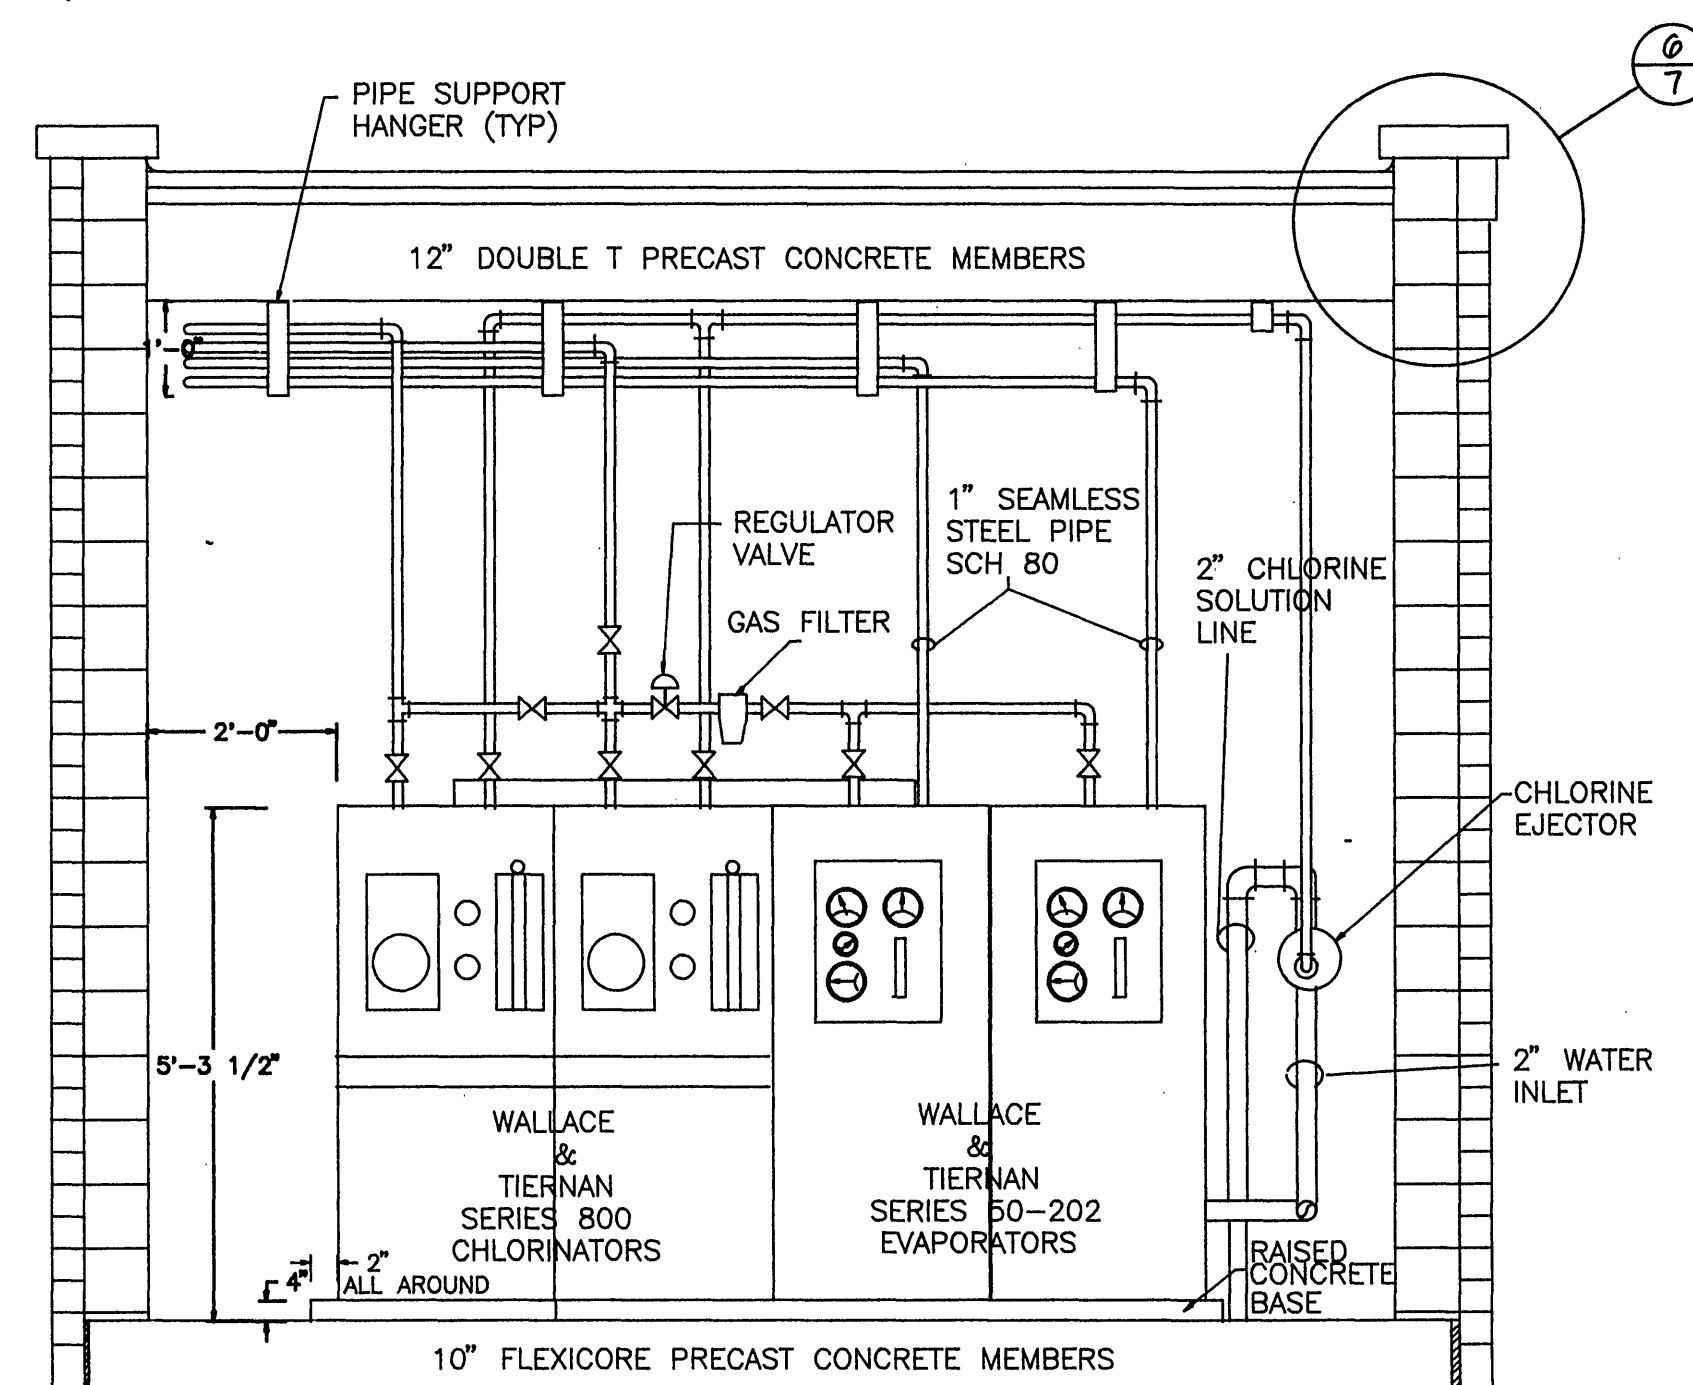


CHLORINATION EQUIPMENT D-4
NOT TO SCALE

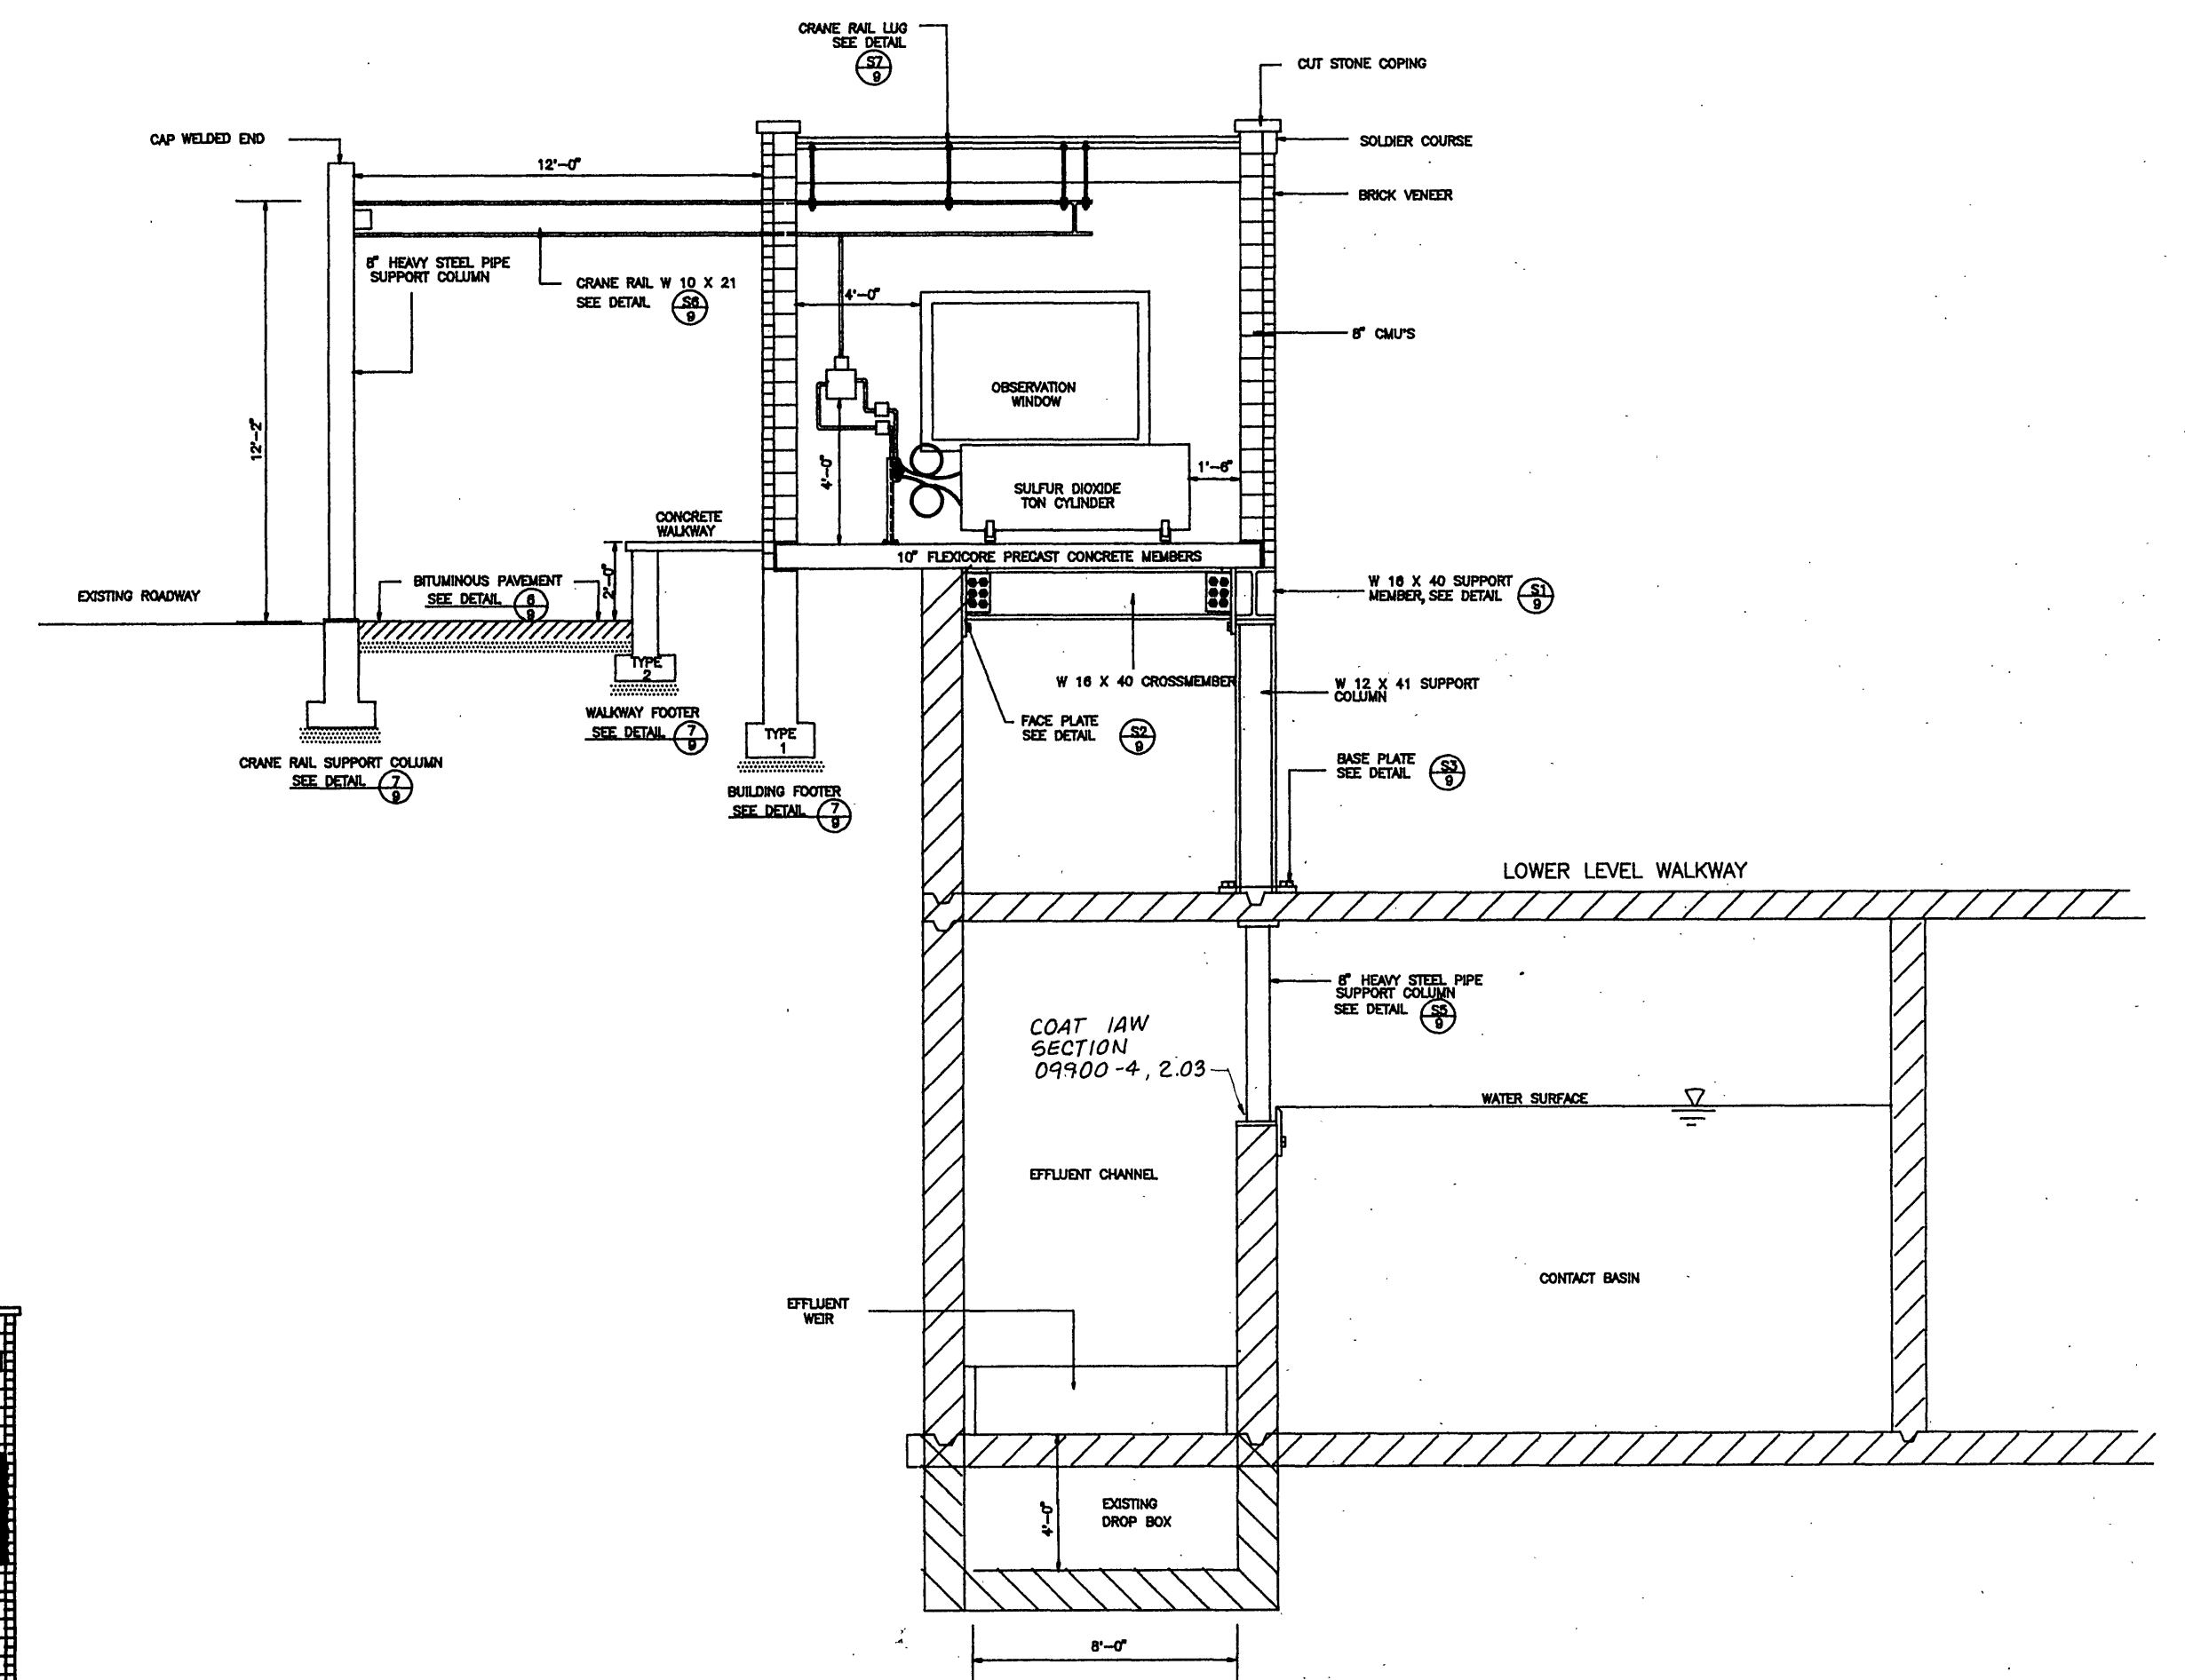


SECTION B-4
SCALE: 1" = 5'

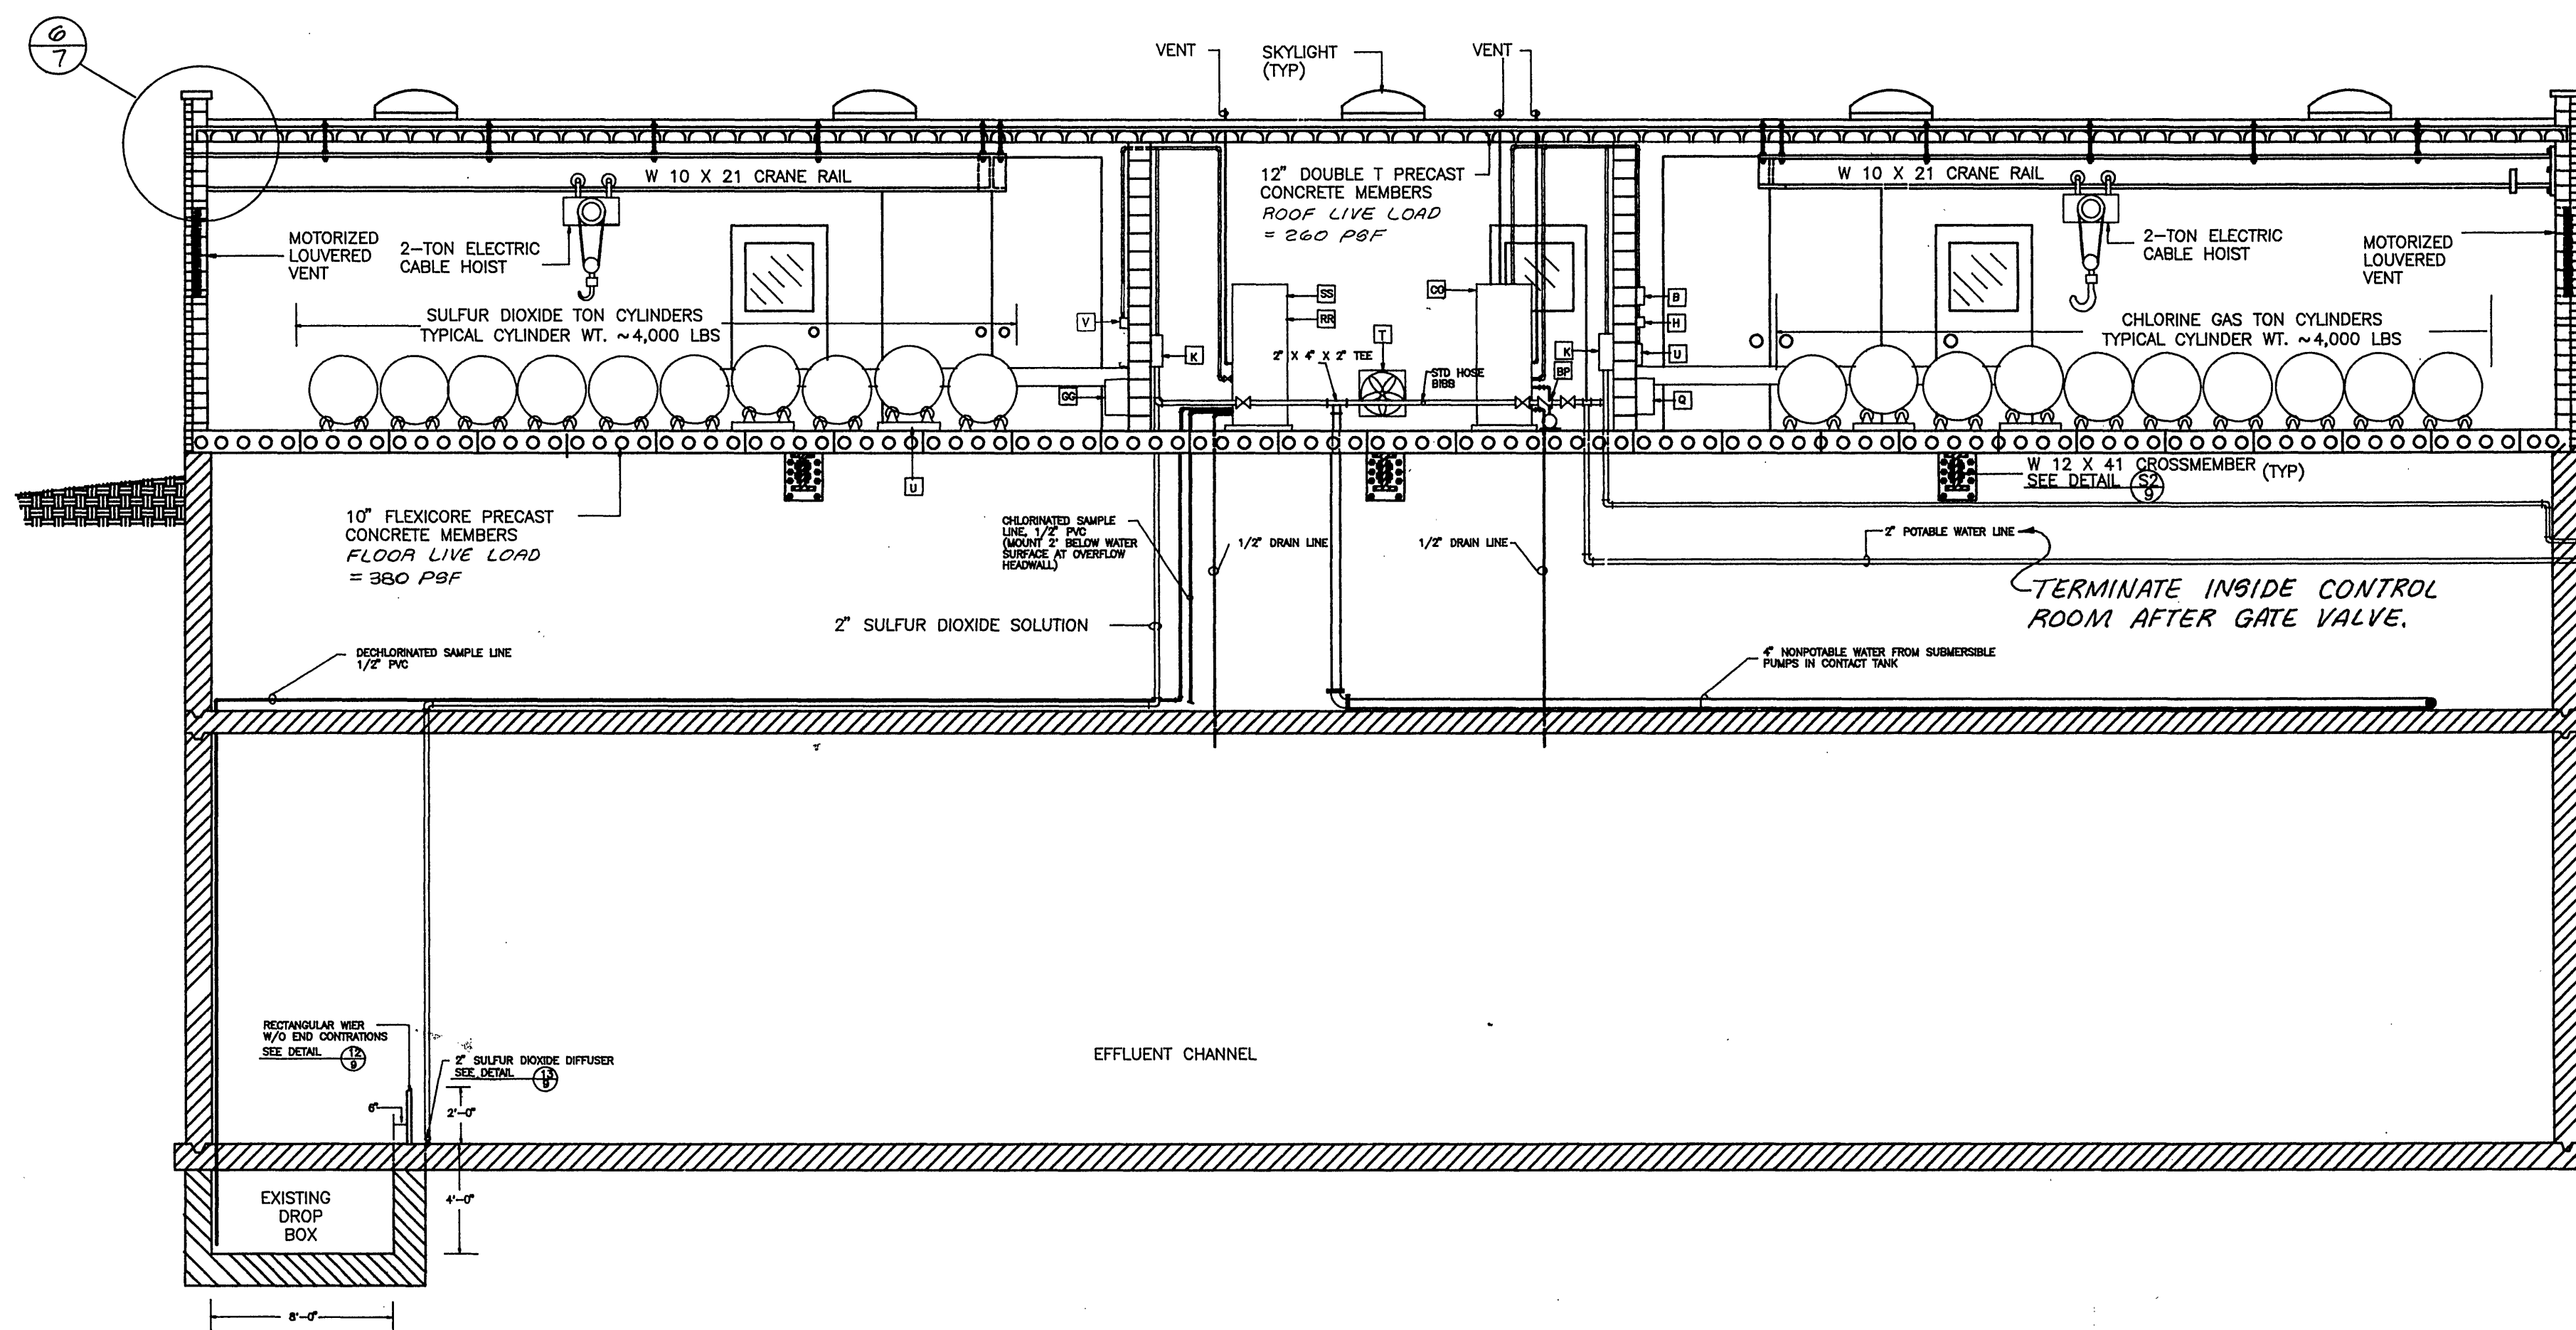



SECTION A-4
SCALE: 1" = 5'

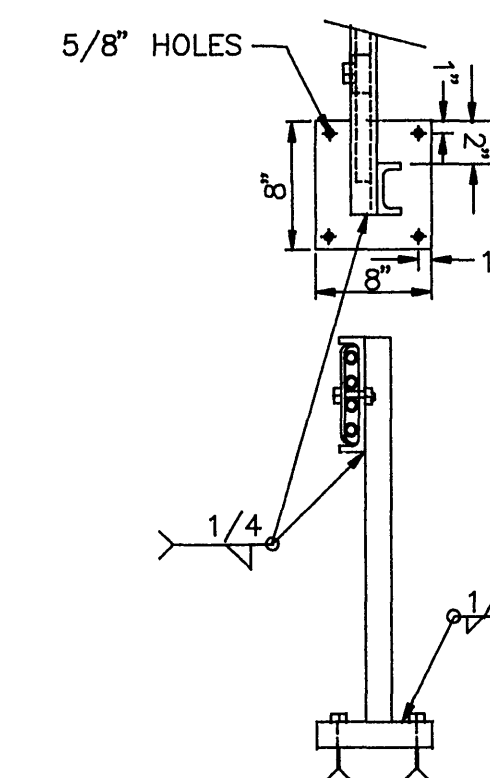

SUPPORT BRACKET 2/3

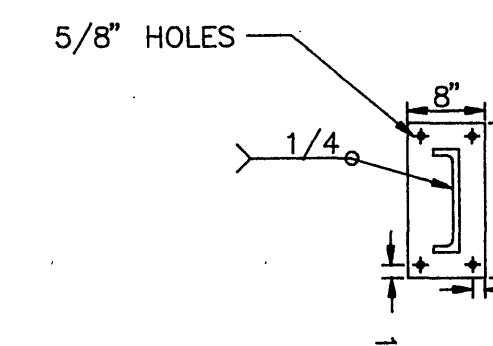


WALL PLATE CYLINDER SUPPORT TRUNION 4/3

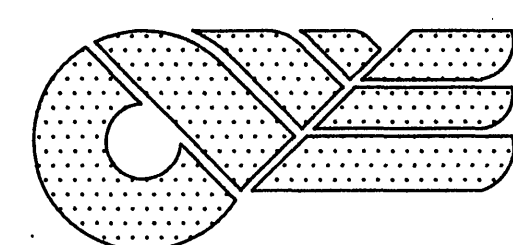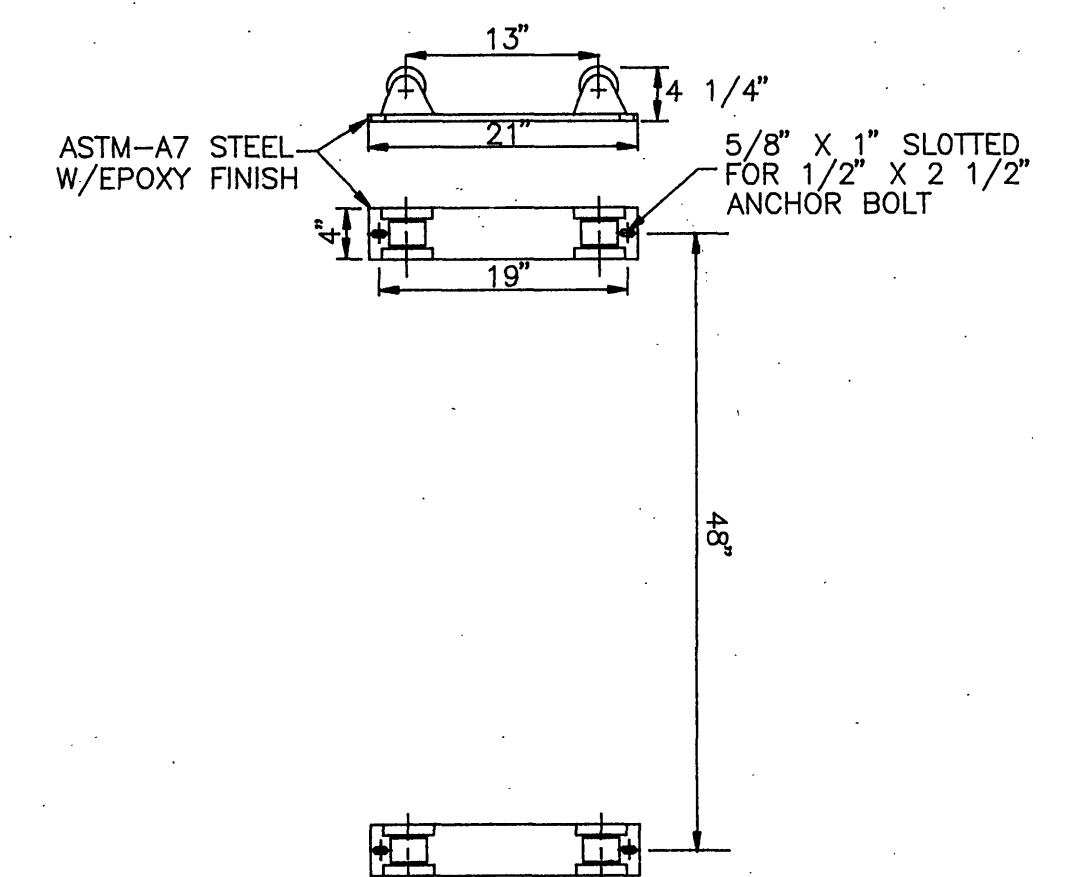

CLEAN WATER ENGINEERS, INC.

P.O. BOX 218
FINCASTLE, VIRGINIA 24090

ROANOKE WATER POLLUTION CONTROL PLANT
CHLORINATION/DECHLORINATION FACILITIES
BUILDING SECTIONS

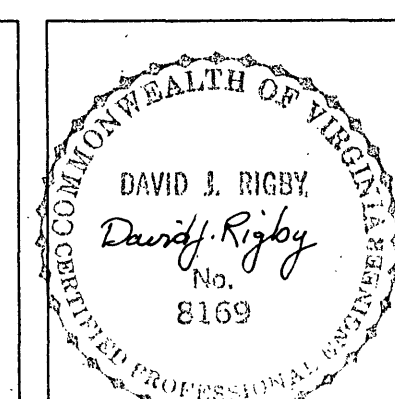

REVISIONS			DESIGNED:	SHEET:
NO.	DATE	BY	WGP	3 OF 10
1	4/21/89	WGP	DRAWN: NA	SCALE: AS SHOWN
2	5/9/89	DJR	CHECKED: DJR	DATE: JAN 1989
3	5/31/89	DJR	APPROVED: DJR	PROJECT: 87025
4	8/2/89	WGP		