


PROJECT LOCATION MAP

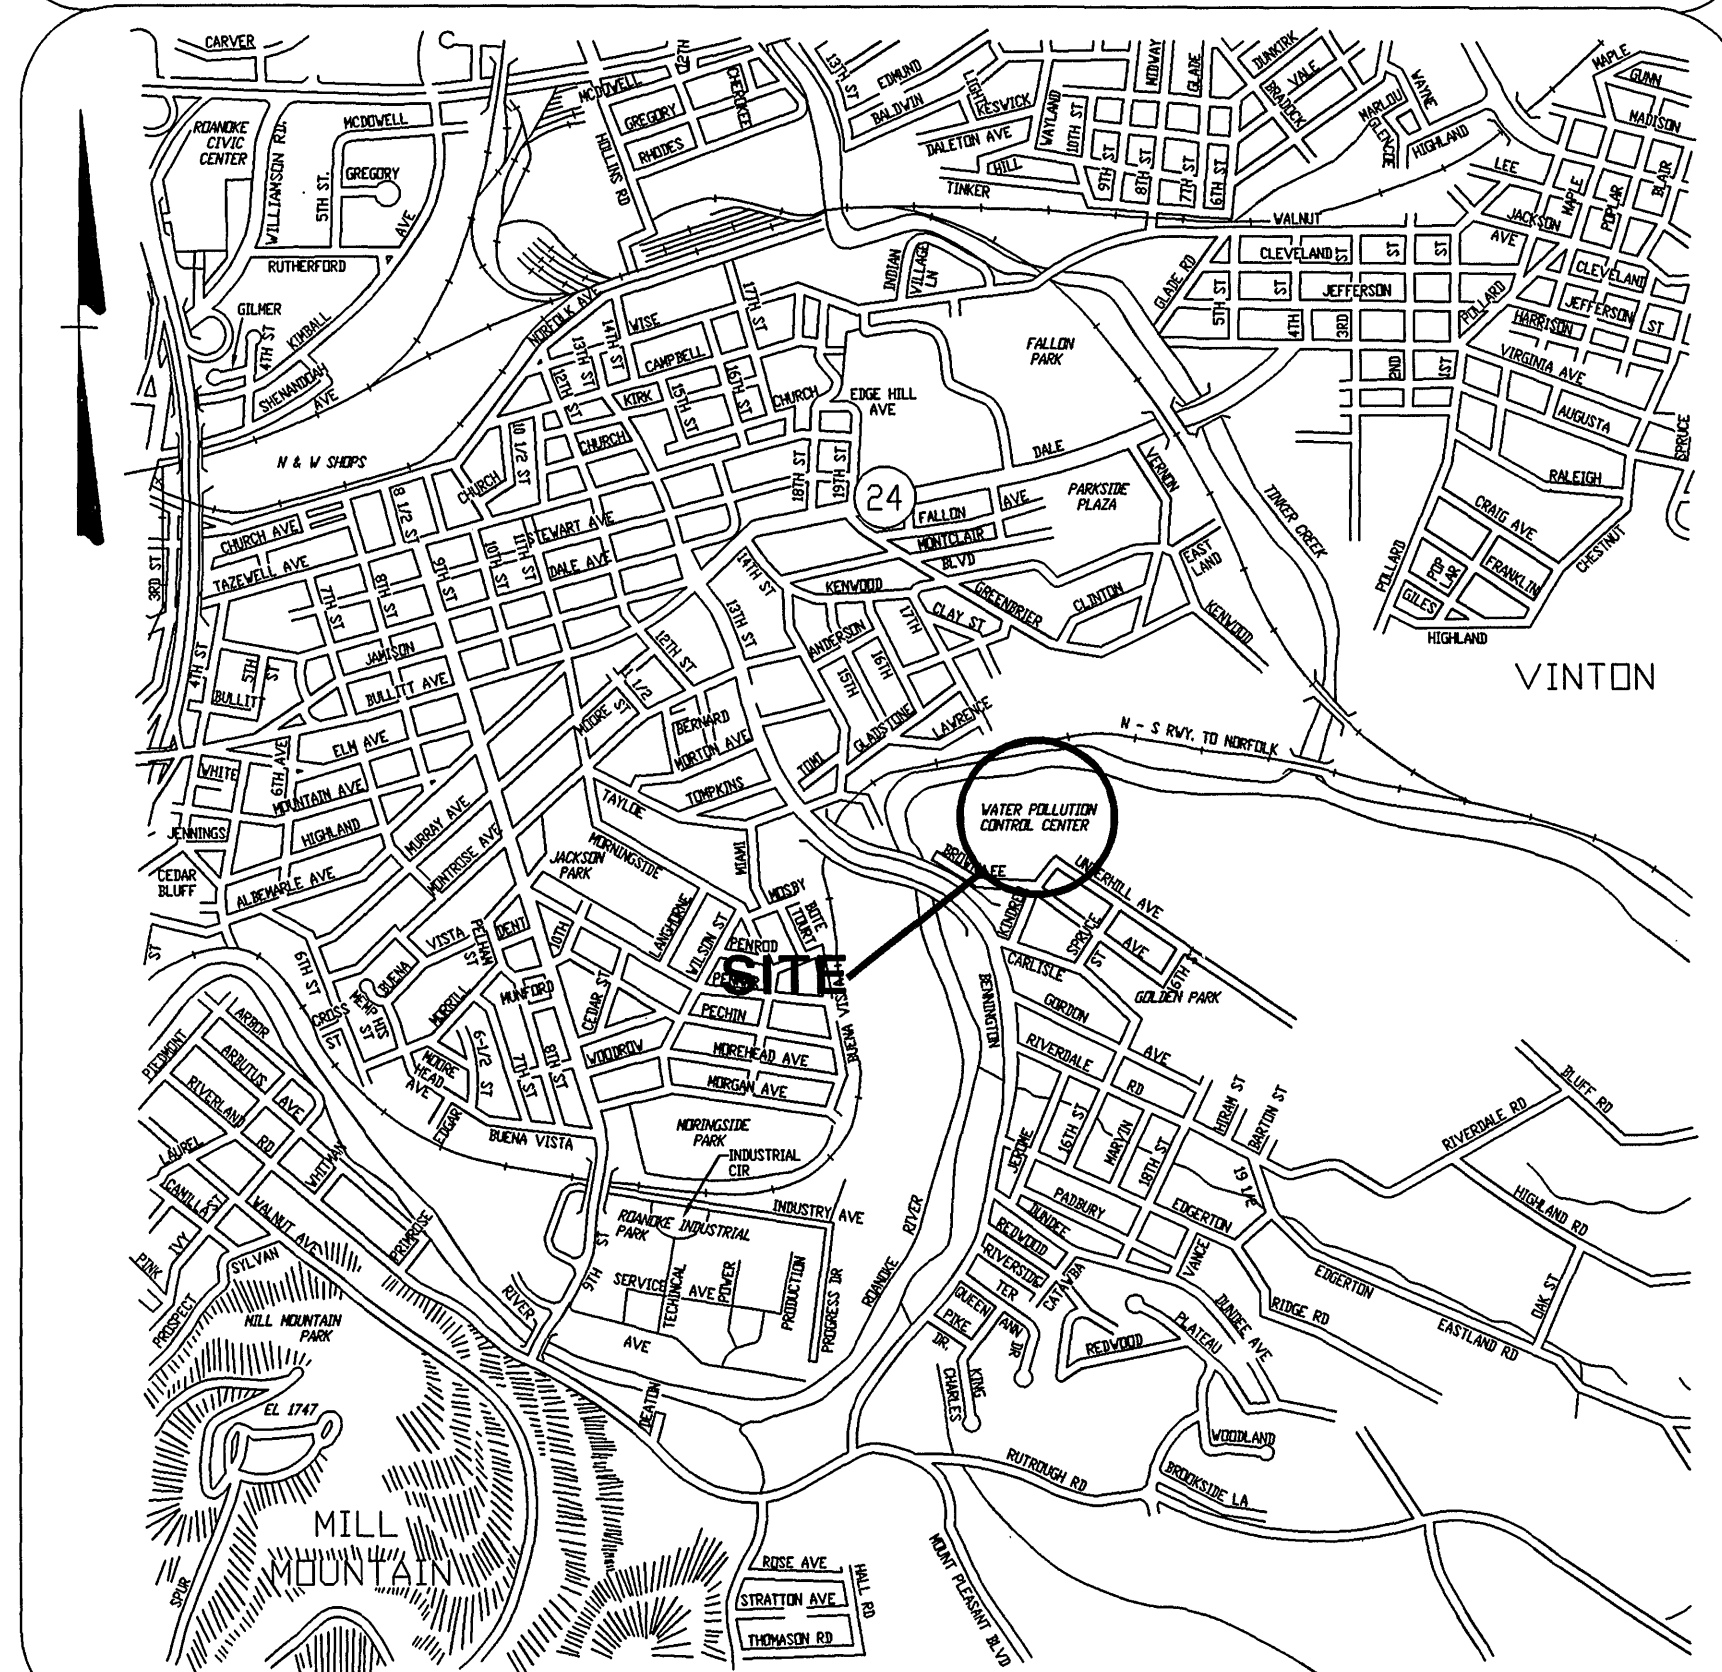


OFFICE OF CITY ENGINEER
ROOM 350
MUNICIPAL BUILDING
215 CHURCH AVENUE, S.W.
ROANOKE, VIRGINIA 24011

INDEX OF SHEETS

- 1 TITLE SHEET
- 2 ABBREVIATION AND LEGEND
- 3 PLAN
- 4 SECTION
- 5 SECTION


CONSULTING ENGINEERS

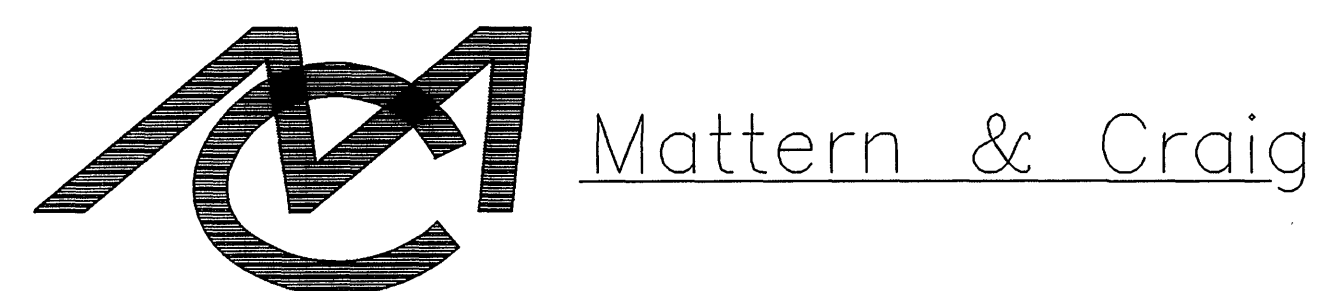

CONSULTING ENGINEERS
SURVEYORS

701 FIRST STREET
ROANOKE, VIRGINIA

COMMISSION NUMBER: 1367

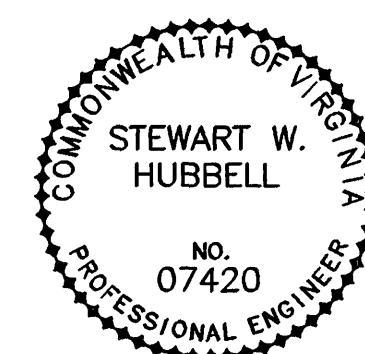

PROJECT NAME

EFFLUENT REAERATION PROJECT
ROANOKE WATER POLLUTION CONTROL
PLANT
CITY OF ROANOKE, VIRGINIA

PROJECT NUMBER:

REVISION BY	DESCRIPTION:	DATE
REVISION BY	DESCRIPTION:	DATE
REVISION BY	DESCRIPTION:	DATE
REVISION BY	DESCRIPTION:	DATE

RECORD DRAWINGS

APPROVED FOR CONSTRUCTION

ROANOKE CITY ENGINEER

DATE

DIRECTOR OF PUBLIC WORKS

DATE

DIRECTOR OF PUBLIC UTILITIES AND OPERATIONS

DATE

DATE

DATE

ADVERTISED DATE:

SET NUMBER:

SHEET NUMBER: 1 OF 5

6454