

SECTION


SCALE: 1/4" = 1'-0"

4.2

3


GENERAL NOTES:

1. CHLORINE CONTACT BASINS MUST REMAIN IN SERVICE AND CANNOT BE DEWATERED. REFER TO SPECIFICATIONS FOR INSTALLATION METHODS AIR DIFFUSER GRIDS.
2. CONTRACTOR MUST VERIFY THAT NO OTHER UTILITIES EXIST IN THE AREA OF THE NEW BLOWER PAD (WITH THE EXCEPTION OF THE EXISTING ELECTRIC) PRIOR TO BEGINNING CONSTRUCTION.
3. CONTRACTOR SHALL ADJUST DIFFUSER GRID SPACING AS NECESSARY TO AVOID THE LADDERS IN THE CHLORINE CONTACT BASINS.

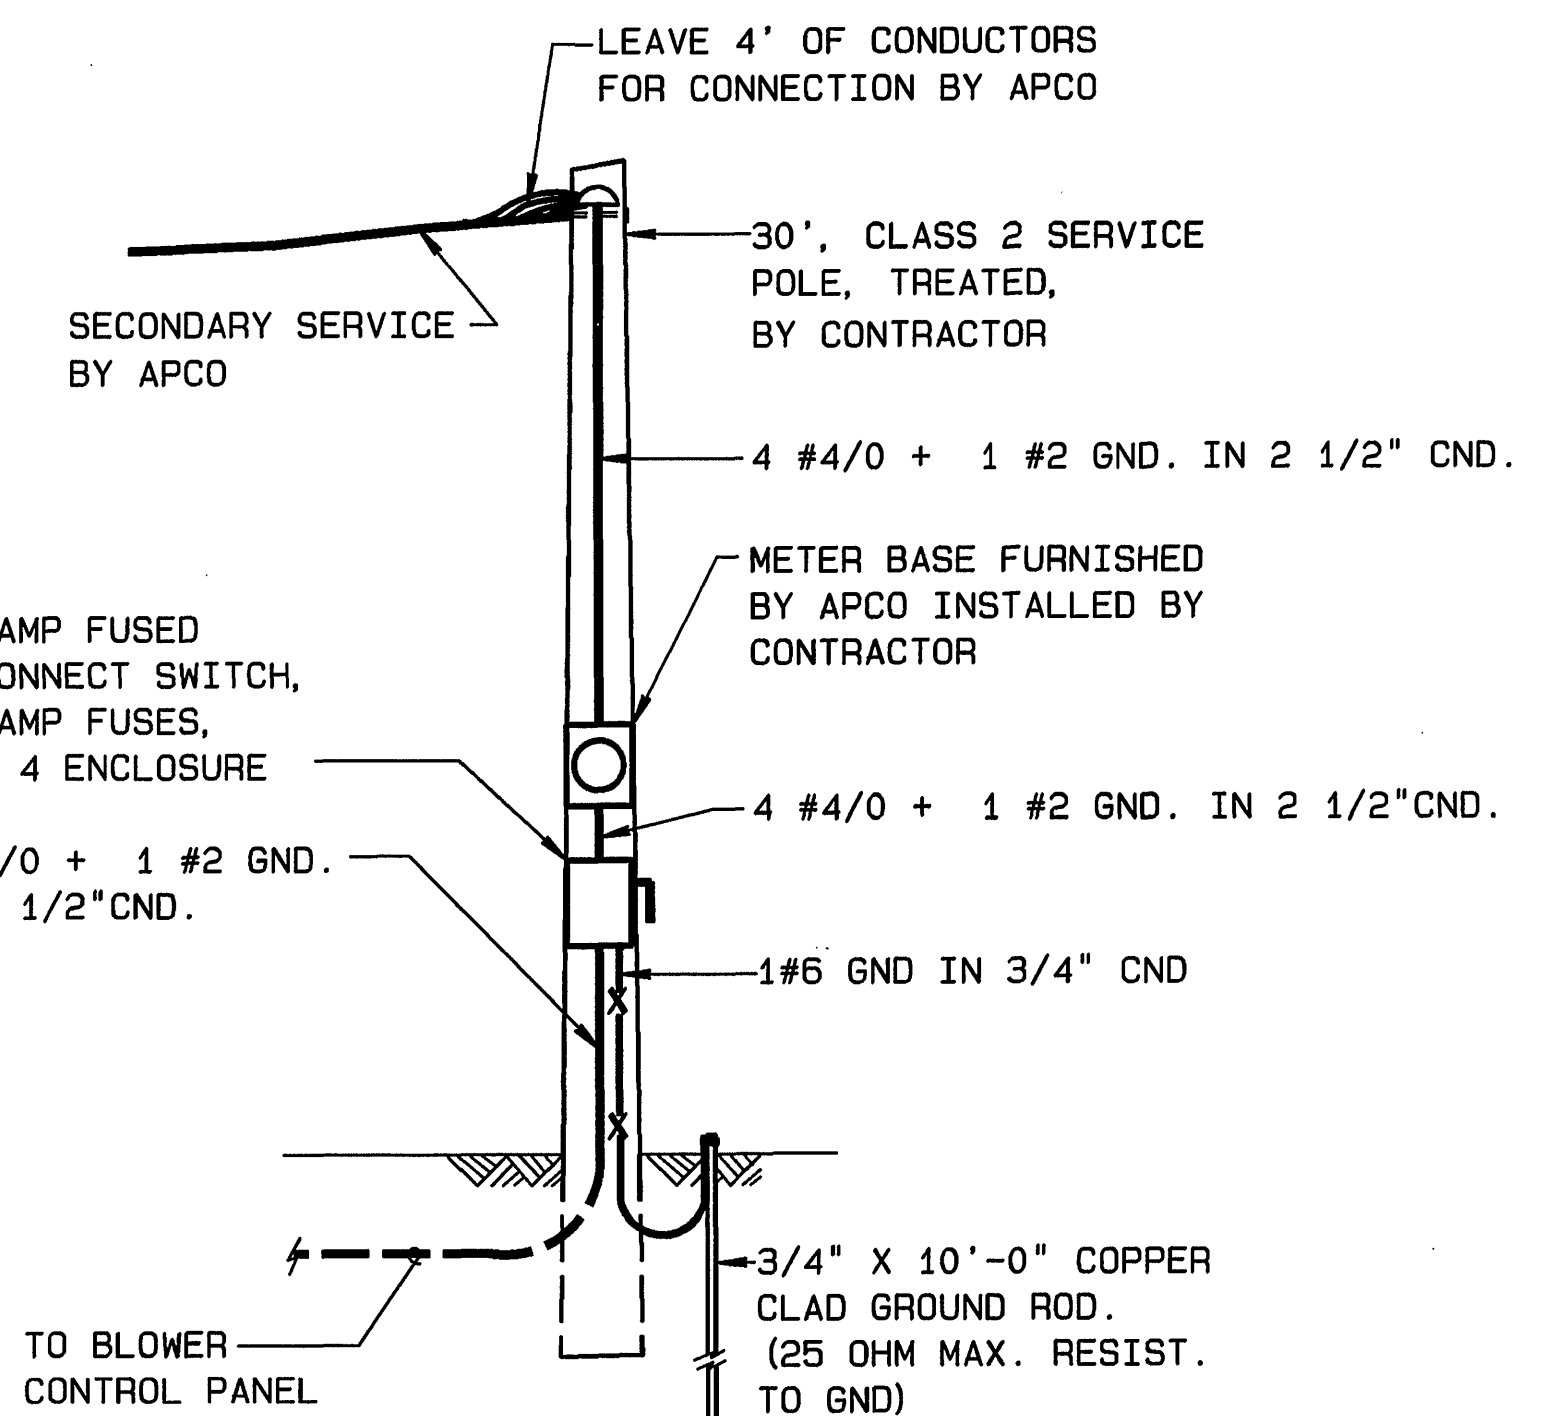


DETAIL - NEW SERVICE POLE
NOT TO SCALE

RECORD DRAWING

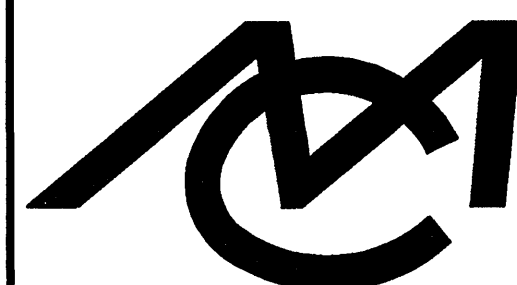

Mattern & Craig
CONSULTING ENGINEERS - SURVEYORS

DESIGNED: **BCC**
DRAWN: **TAM**
CHECKED: **SWH**

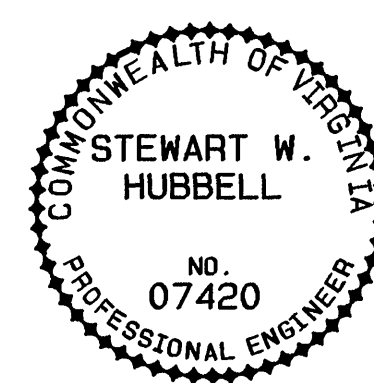

REVISION	DATE	DESCRIPTION	BY	APP.

DATE
NOVEMBER
1994
COMM.
1367

EFFLUENT REAERATION PROJECT
SECTION
ROANOKE WATER POLLUTION CONTROL PLANT
CITY OF ROANOKE, VIRGINIA

SCALE: AS SHOWN

6454

SHEET

4

PROJECT NO. 19-94C

DRAWING #4