


- NOTES:
- 1 SEE NOTES ON DRAWING G1.
 - 2 CONTRACTOR SHALL MAINTAIN INTEGRITY OF FLOOD BERM AND FLOOD WALL AT ALL TIMES.
 - 3 ADD SECTION TO MANHOLE TO RAISE TOP TO ELEVATION 909.00.
 - 4 SEE DRAWING G16 FOR CONCRETE PAD PLAN AND SECTION.
 - 5 HATCHED AREA SHALL BE LINED WITH PERMANENT TURF REINFORCEMENT MATING WITH A MINIMUM SHEAR STRESS OF 8 LB/SF. CONTRACTOR SHALL SUBMIT INFORMATION ON TYPE OF LINING TO BE PROVIDED TO ENGINEER FOR APPROVAL. TURF REINFORCEMENT LINING SHALL BE INSTALLED PER MANUFACTURER RECOMMENDATIONS.

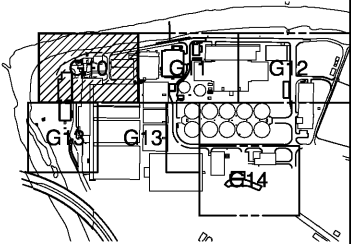

1"=20'-0"

20 10 0 20'

COMMENTS FROM ENG. DEPT. RECORD DRAWINGS CONSTRUCTION REGULATORY APPROVAL PRELIMINARY DESIGN ISSUED FOR				DESIGNED DAN DRAWN RWB CHECKED PROJ. ENGR. DAN APPROVED		THIS DOCUMENT ORIGINALLY ISSUED FOR CONSTRUCTION AND SEALED BY ROBERT S. DIFIORE, SEAL NO. 22769 THIS DOCUMENT ORIGINALLY ISSUED FOR CONSTRUCTION AND SEALED BY RONALD L. TAYLOR, SEAL NO. 024649		RECORD DRAWING THIS DRAWING HAS BEEN MODIFIED TO REFLECT FIELD CHANGES REPORTED BY THE CONTRACTOR OR ANOTHER PARTY, BUT NOT VERIFIED BY THE CERTIFYING ENGINEER. THIS DOCUMENT ORIGINALLY ISSUED AND SEALED BY DAVID A. NAILOR, 025465. THIS MEDIA SHALL NOT BE CONSIDERED A CERTIFIED DOCUMENT.		HAZEN AND SAWYER Environmental Engineers & Scientists 4011 WestChase Blvd, Raleigh, North Carolina 27607		CITY OF ROANOKE VIRGINIA REGIONAL WATER POLLUTION CONTROL PLANT WET WEATHER IMPROVEMENTS		PARTIAL SITE PLAN GENERAL GRADING, DRAINAGE AND EROSION CONTROL		THE SCALE BAR SHOWN BELOW MEASURES ONE INCH LONG ON THE ORIGINAL DRAWING.		DATE JULY 2003 H & S JOB NUMBER 30788A CONTRACT NUMBER A DRAWING NUMBER G10	
--	--	--	--	---	--	--	--	---	--	--	--	---	--	---	--	---	--	--	--