


- NOTES:
- 1 IN SOME LOCATIONS, PIPES SHOWN TO BE ABANDONED MAY NEED TO BE REMOVED IN WAY OF NEW PIPING, DUCT BANK, ETC. THIS WORK SHALL BE PERFORMED AT NO ADDITIONAL COST TO THE OWNER.
 - 2 REROUTE EXISTING 12" DRAIN PUMP STATION DISCHARGE UNDER NEW 66" PTE.
 - 3 CUT EXISTING 12" MUW AT SECONDARY CLARIFIER WALL. PLUG WALL PIPE AND ABANDON 12" MUW.
 - 4 THE EXISTING 48" FBWR PIPING BETWEEN THE FILTER BUILDING AND THE PARKING AREA MAY BE ABANDONED IN PLACE EXCEPT WHERE THE DEMOLITION IS REQUIRED TO INSTALL THE PLUG AS SHOWN ON DWG M11. THE SIDEWALK LOCATED ABOVE THE PIPE IS TO BE DEMOLISHED.

LEGEND

- [Cross-hatched box] TO BE DEMOLISHED
- [Diagonal hatched box] TO BE ABANDONED IN PLACE

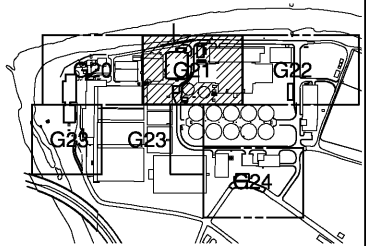

KEY PLAN

1"=20'-0"

20 10 0 20'

			DESIGNED DAN		<p>THIS DOCUMENT ORIGINALLY ISSUED FOR CONSTRUCTION AND SEALED BY ROBERT S. DIFIORE, SEAL NO. 22769</p> <p>RECORD DRAWING</p> <p>THIS DRAWING HAS BEEN MODIFIED TO REFLECT FIELD CHANGES REPORTED BY THE CONTRACTOR OR ANOTHER PARTY, BUT NOT VERIFIED BY THE CERTIFYING ENGINEER. THIS DOCUMENT ORIGINALLY ISSUED AND SEALED BY DAVID A. NAILOR, 025465. THIS MEDIA SHALL NOT BE CONSIDERED A CERTIFIED DOCUMENT.</p>	<p>HAZEN AND SAWYER</p> <p>Environmental Engineers & Scientists</p> <p>4011 WestChase Blvd, Raleigh, North Carolina 27607</p>	CITY OF ROANOKE		PARTIAL SITE PLAN		<p>THE SCALE BAR SHOWN BELOW MEASURES ONE INCH LONG ON THE ORIGINAL DRAWING.</p> <p>DATE JULY 2003</p> <table><tr><td colspan="2">H & S JOB NUMBER 30788A</td></tr><tr><td>CONTRACT NUMBER A</td><td>DRAWING NUMBER G21</td></tr></table>	H & S JOB NUMBER 30788A		CONTRACT NUMBER A	DRAWING NUMBER G21
H & S JOB NUMBER 30788A															
CONTRACT NUMBER A	DRAWING NUMBER G21														
			DRAWN RWB				VIRGINIA								
			CHECKED				REGIONAL WATER POLLUTION CONTROL PLANT								
			PROJ. ENGR. DAN		WET WEATHER IMPROVEMENTS										
			APPROVED				GENERAL		DEMOLITION						
RECORD DRAWINGS			MAR 2008		RLT										
CONSTRUCTION			MAR 2004		RLT										
REGULATORY APPROVAL			NOV 2003		RLT										
PRELIMINARY DESIGN			NOV 2002		RLT										
ISSUED FOR			DATE		BY										
NO.															
									</						