


NOTES:

1 IN SOME LOCATIONS, PIPES SHOWN TO BE ABANDONED MAY NEED TO BE REMOVED IN WAY OF NEW PIPING, DUCT BANK, ETC. THIS WORK SHALL BE PERFORMED AT NO ADDITIONAL COST TO THE OWNER.

LEGEND

- TO BE DEMOLISHED
- TO BE ABANDONED IN PLACE

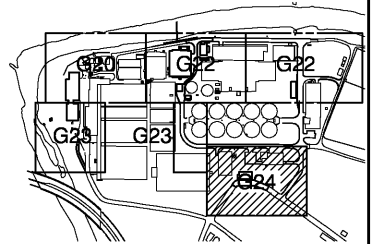

KEY PLAN

1"=20'-0"

20 10 0 20'

				DESIGNED	DAN	RECORD DRAWING	THIS DOCUMENT ORIGINALLY ISSUED FOR CONSTRUCTION AND SEALED BY ROBERT S. DIFIORE, SEAL NO. 22769	CITY OF ROANOKE VIRGINIA	PARTIAL SITE PLAN	THE SCALE BAR SHOWN BELOW MEASURES ONE INCH LONG ON THE ORIGINAL DRAWING.	DATE JULY 2003	
				DRAWN	RWB						H & S JOB NUMBER 30788A	
				CHECKED							CONTRACT NUMBER A	
				PROJ. ENGR.	DAN						DRAWING NUMBER G24	
				APPROVED								
						THIS DRAWING HAS BEEN MODIFIED TO REFLECT FIELD CHANGES REPORTED BY THE CONTRACTOR OR ANOTHER PARTY, BUT NOT VERIFIED BY THE CERTIFYING ENGINEER. THIS DOCUMENT ORIGINALLY ISSUED AND SEALED BY DAVID A. NAILOR, 025465. THIS MEDIA SHALL NOT BE CONSIDERED A CERTIFIED DOCUMENT.	THIS DOCUMENT ORIGINALLY ISSUED FOR CONSTRUCTION AND SEALED BY RONALD L. TAYLOR, SEAL NO. 024649	HAZEN AND SAWYER Environmental Engineers & Scientists 4011 WestChase Blvd, Raleigh, North Carolina 27607	REGIONAL WATER POLLUTION CONTROL PLANT WET WEATHER IMPROVEMENTS			
										</		