


NOTES:
1 SEE CONTRACT B FOR CONTINUATION OF PROCESS SCHEMATIC.

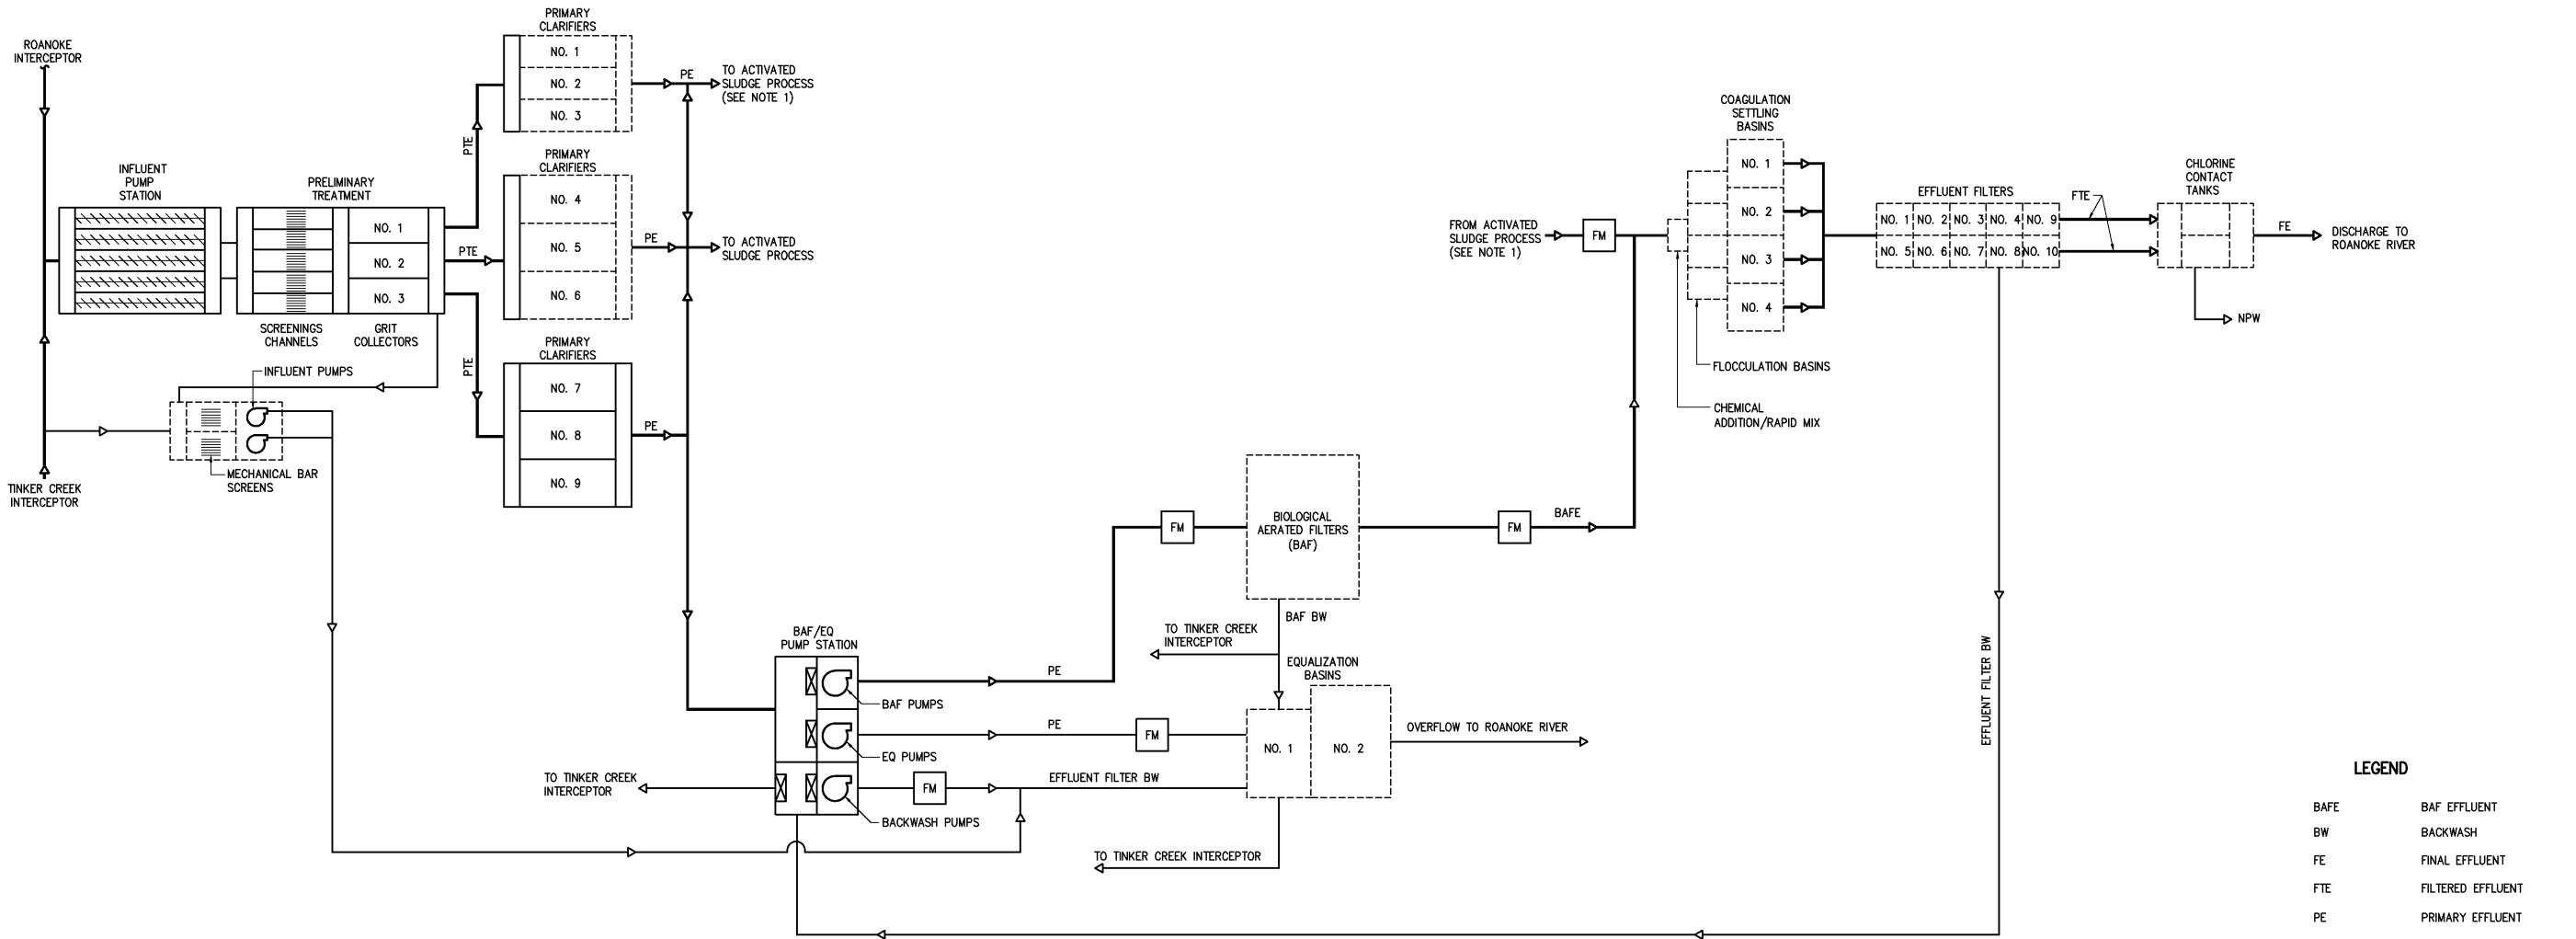

LEGEND

- | | |
|------|--------------------------|
| BAFE | BAF EFFLUENT |
| BW | BACKWASH |
| FE | FINAL EFFLUENT |
| FTE | FILTERED EFFLUENT |
| PE | PRIMARY EFFLUENT |
| PTE | PRIMARY TREATED EFFLUENT |
| | PRIMARY FLOW PATH |
| | SECONDARY FLOW PATH |
| | FLOW METER |
| | NEW STRUCTURE |
| | EXISTING STRUCTURE |

DESIGNED	DAN
DRAWN	H & S
CHECKED	
PROJ. ENGR.	DAN
APPROVED	
NO.	

THIS DOCUMENT ORIGINALLY ISSUED FOR CONSTRUCTION AND SEALED BY ROBERT S. DIFIORE, SEAL NO. 22769

RECORD DRAWING

THIS DRAWING HAS BEEN MODIFIED TO REFLECT FIELD CHANGES REPORTED BY THE CONTRACTOR OR ANOTHER PARTY, BUT NOT VERIFIED BY THE CERTIFYING ENGINEER. THIS DOCUMENT ORIGINALLY ISSUED AND SEALED BY DAVID A. NAILOR, 025465. THIS MEDIA SHALL NOT BE CONSIDERED A CERTIFIED DOCUMENT.

THIS DOCUMENT ORIGINALLY ISSUED FOR CONSTRUCTION AND SEALED BY RONALD L. TAYLOR, SEAL NO. 024649

HAZEN AND SAWYER
Environmental Engineers & Scientists
4011 WestChase Blvd, Raleigh, North Carolina 27607

CITY OF ROANOKE
VIRGINIA

REGIONAL WATER POLLUTION CONTROL PLANT
WET WEATHER IMPROVEMENTS

PROCESS FLOW SCHEMATIC
MECHANICAL
LIQUID TRAIN

THE SCALE BAR SHOWN BELOW MEASURES ONE INCH LONG ON THE ORIGINAL DRAWING.

DATE JULY 2003

H & S JOB NUMBER 30788A

CONTRACT NUMBER A

DRAWING NUMBER M1