
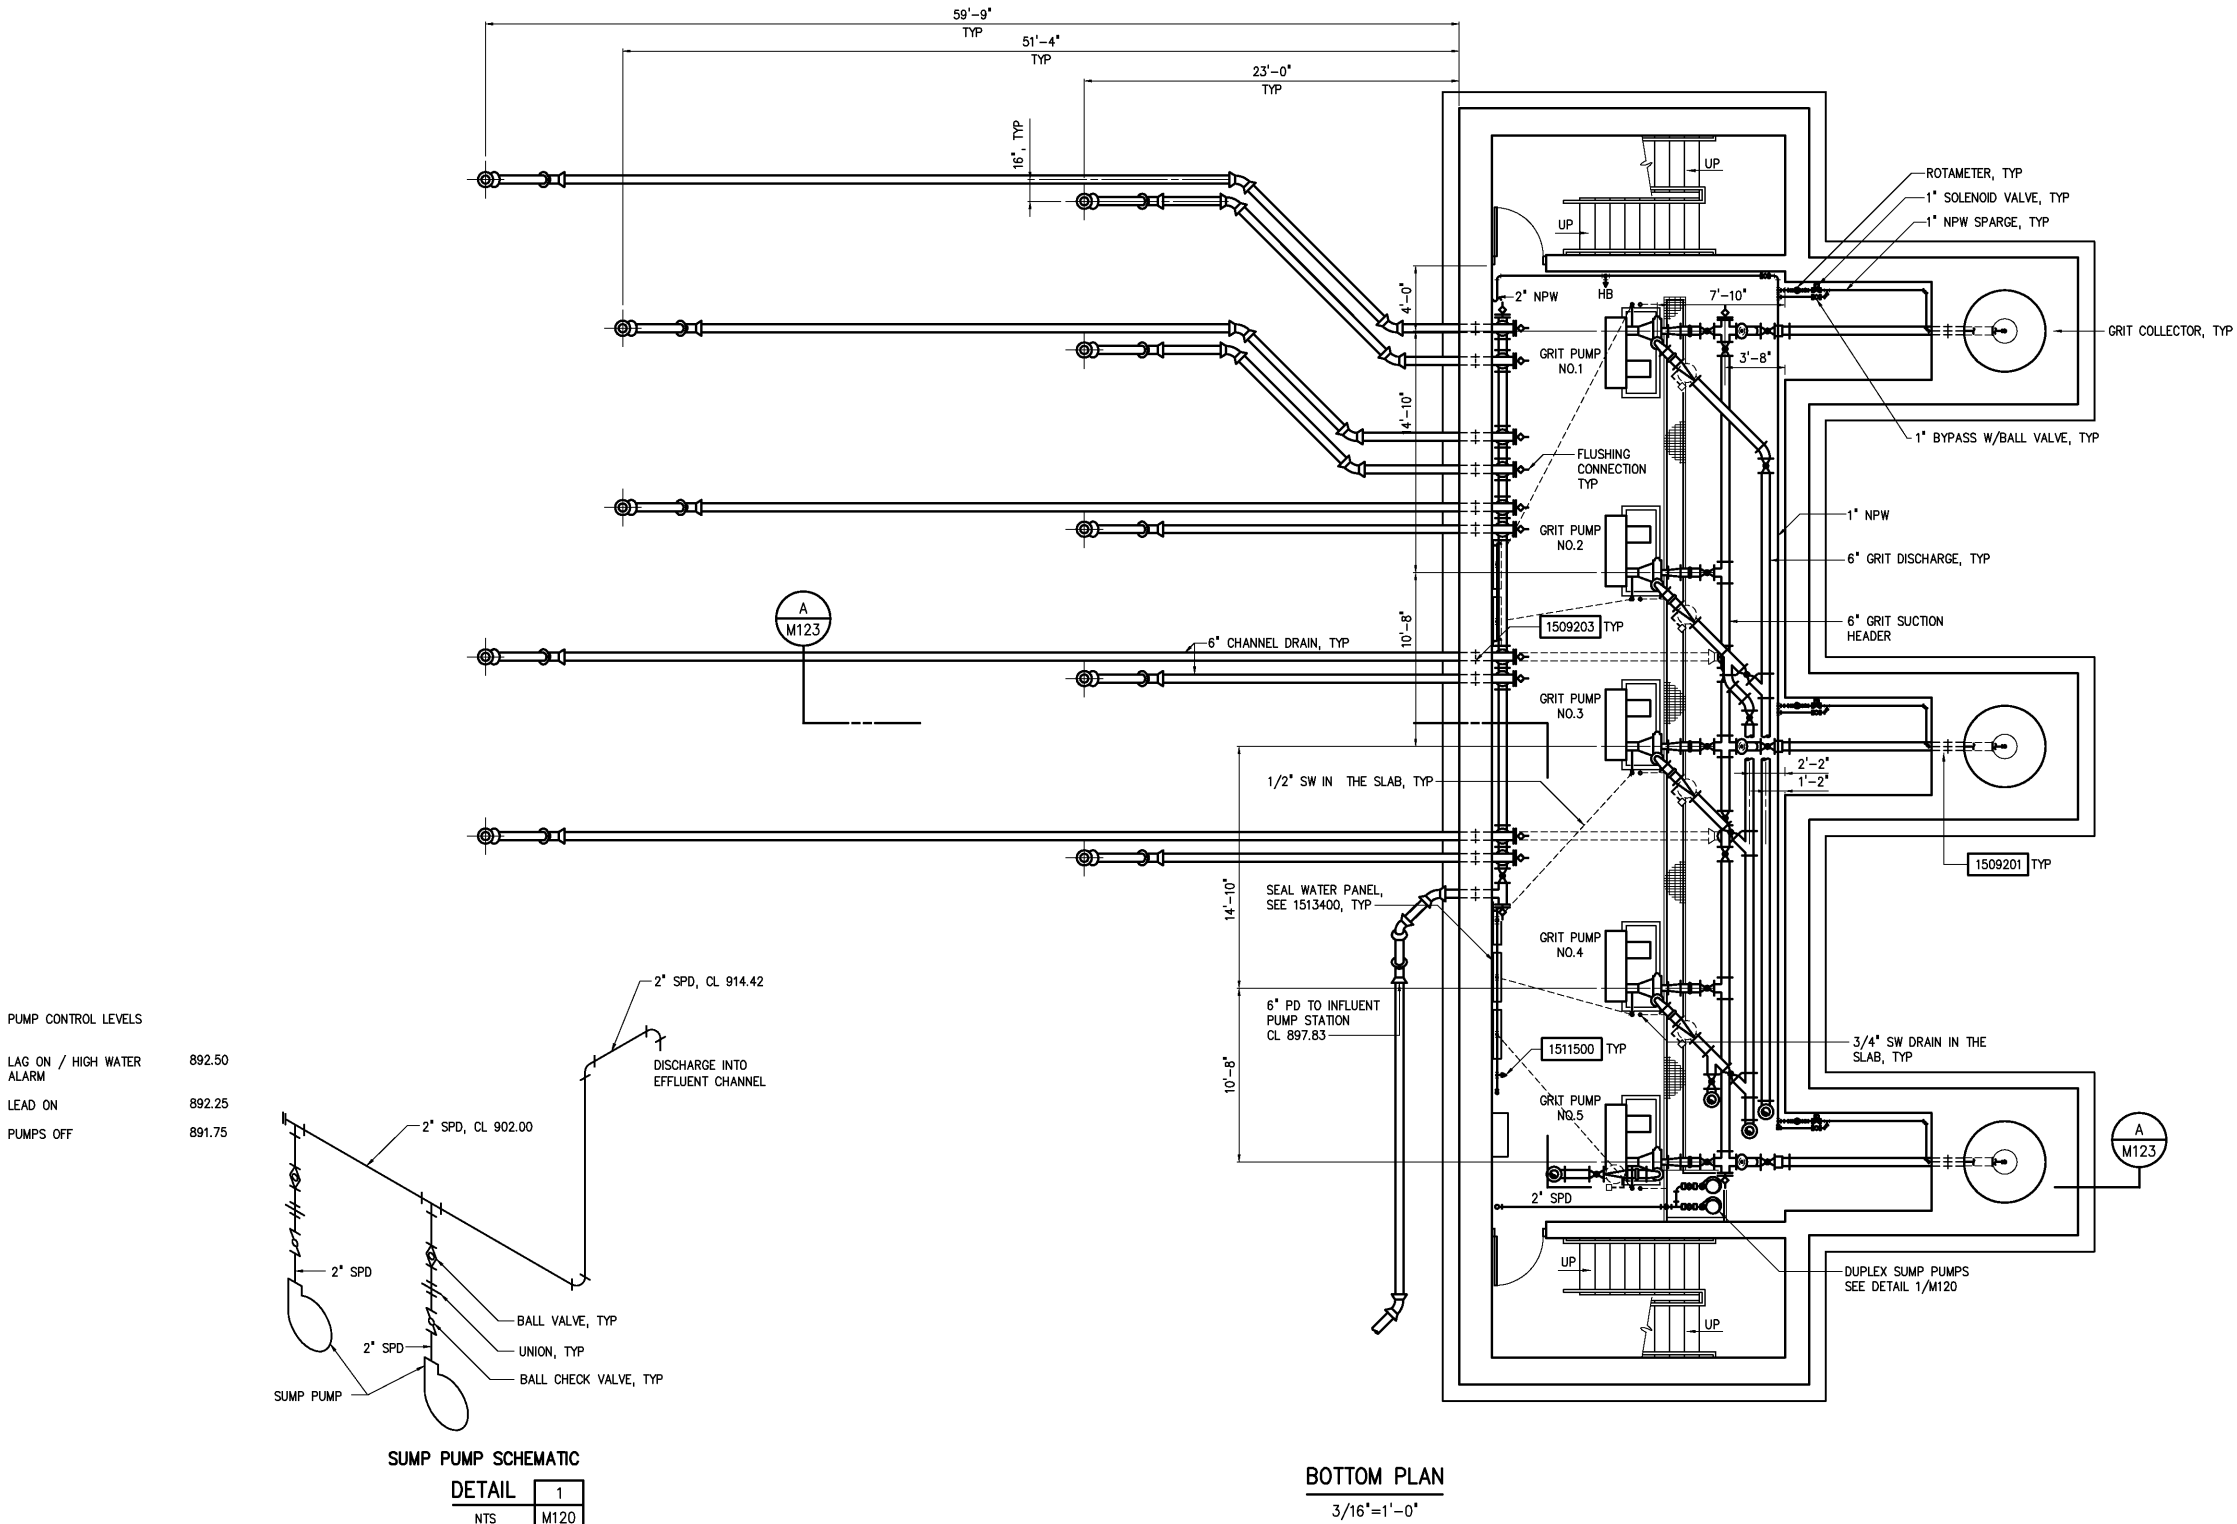 


NOTES:  
1 LAYOUT DIMENSIONS AND ELEVATIONS SHOWN ARE REPRESENTATIVE OF EQUIPMENT SUPPLIED BY ONE MANUFACTURER OF EACH TYPE OF PROCESS EQUIPMENT. ANY COST FOR REDESIGN, MATERIALS OR CONSTRUCTION DUE TO THE REQUIREMENTS OF THE EQUIPMENT ULTIMATELY FURNISHED SHALL BE THE RESPONSIBILITY OF THE CONTRACTOR.



DESIGNED: DAN				RECORD DRAWING		CITY OF ROANOKE VIRGINIA		PRELIMINARY TREATMENT FACILITIES		THE SCALE BAR SHOWN BELOW MEASURES ONE INCH LONG ON THE ORIGINAL DRAWING.		DATE: JULY 2003	
DRAWN: BRC				THIS DOCUMENT ORIGINALLY ISSUED FOR CONSTRUCTION AND SEALED BY ROBERT S. DIFIORE, SEAL NO. 22769		HAZEN AND SAWYER Environmental Engineers & Scientists 4011 WestChase Blvd, Raleigh, North Carolina 27607		MECHANICAL		H & S JOB NUMBER 30788A		CONTRACT NUMBER A	
CHECKED:				THIS DRAWING HAS BEEN MODIFIED TO REFLECT FIELD CHANGES REPORTED BY THE CONTRACTOR OR ANOTHER PARTY, BUT NOT VERIFIED BY THE CERTIFYING ENGINEER. THIS DOCUMENT ORIGINALLY ISSUED AND SEALED BY DAVID A. NAILOR, 025465. THIS MEDIA SHALL NOT BE CONSIDERED A CERTIFIED DOCUMENT.		REGIONAL WATER POLLUTION CONTROL PLANT WET WEATHER IMPROVEMENTS		BOTTOM PLAN AND DETAIL		DRAWING NUMBER M120			
PROJ. ENGR. DAN				THIS DOCUMENT ORIGINALLY ISSUED FOR CONSTRUCTION AND SEALED BY RONALD L. TAYLOR, SEAL NO. 024649									
APPROVED													
NO.													
ISSUED FOR													
DATE													
BY													
MAR 2008													
MAR 2004													
NOV 2003													
NOV 2002													
REGULATORY DESIGN													
CONSTRUCTION													
RECORD DRAWINGS													
POST DATE													