


NOTES:

- WEIR PLATES AT MOG-12150, 12151 AND 12152 SHALL BE AS SHOWN IN DETAIL 4/M121.
- LAYOUT DIMENSIONS AND ELEVATIONS SHOWN ARE REPRESENTATIVE OF EQUIPMENT SUPPLIED BY ONE MANUFACTURER OF EACH TYPE OF PROCESS EQUIPMENT. ANY COST FOR REDESIGN, MATERIALS OR CONSTRUCTION DUE TO THE REQUIREMENTS OF THE EQUIPMENT ULTIMATELY FURNISHED SHALL BE THE RESPONSIBILITY OF THE CONTRACTOR.
- SEE SPECIFICATION SECTION 09900 FOR CONCRETE COATING REQUIREMENTS.

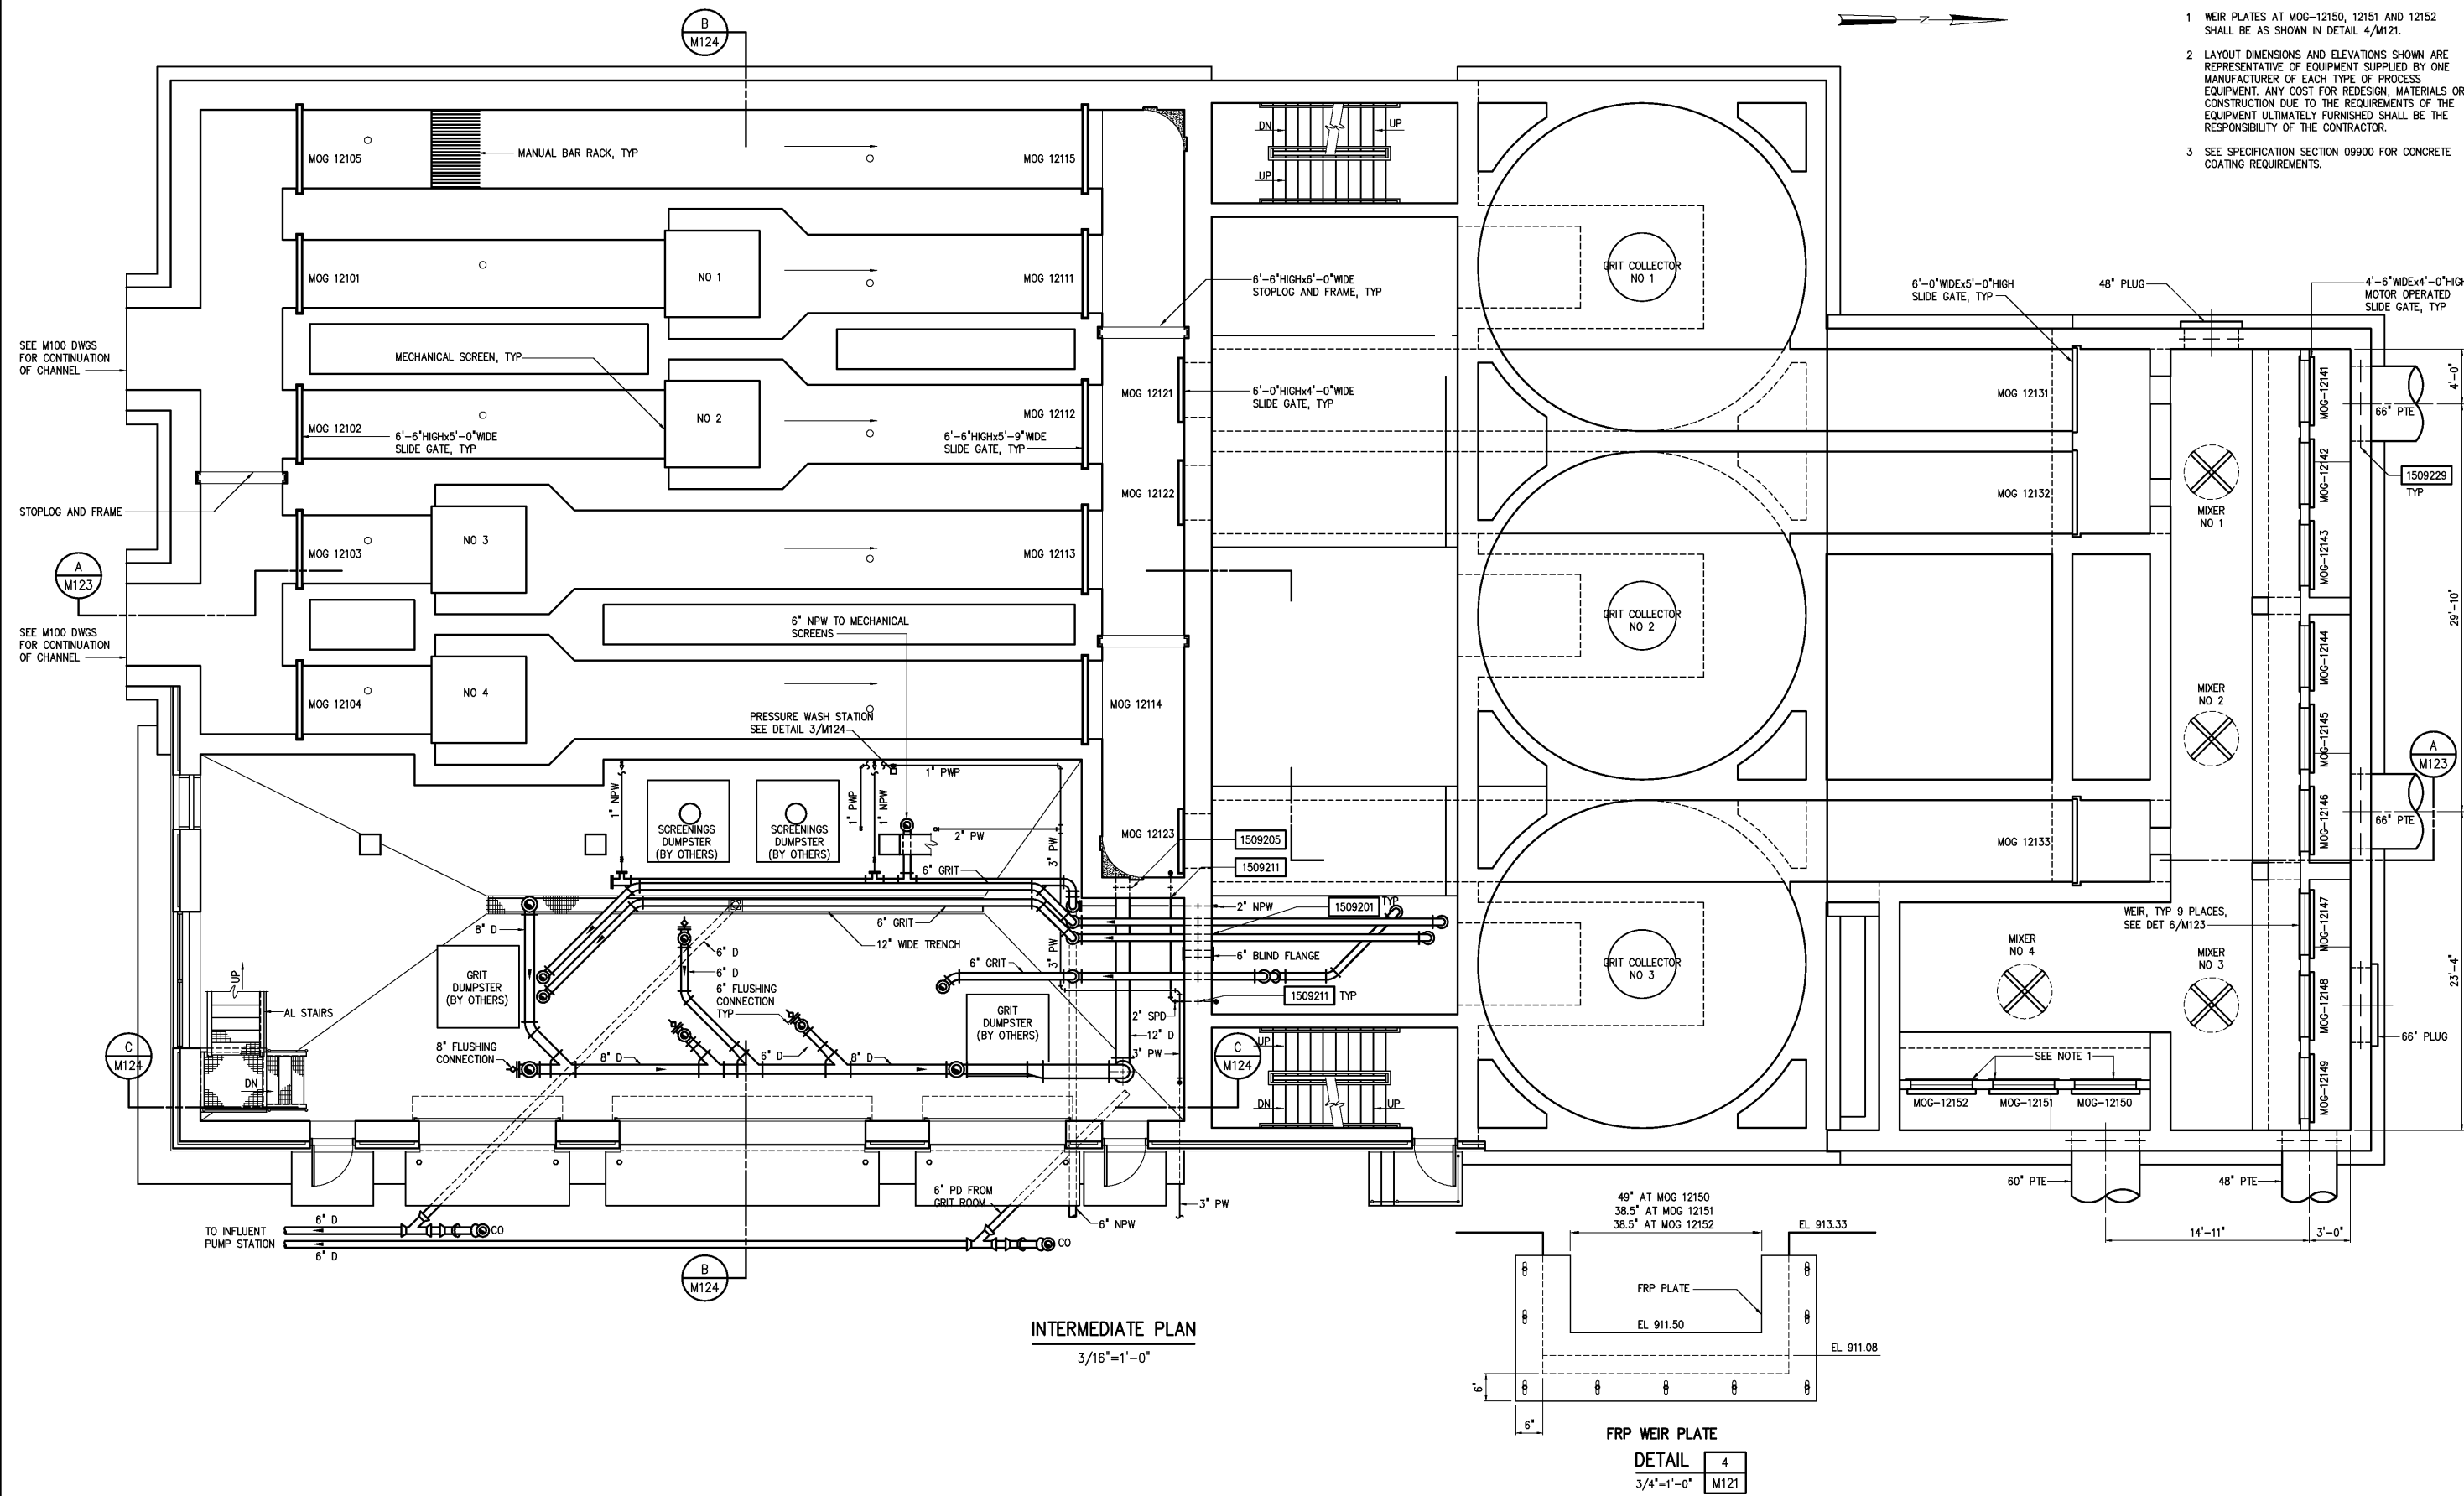

				DESIGNED	DAN
				DRAWN	BRC
				CHECKED	
	RECORD DRAWINGS	MAR 2008	RLT		
	CONSTRUCTION	MAR 2004	RLT	PROJ. ENGR.	DAN
	REGULATORY APPROVAL	NOV 2003	RLT		
	PRELIMINARY DESIGN	NOV 2002	RLT		
NO.	ISSUED FOR	DATE	BY	APPROVED	

THIS DOCUMENT ORIGINALLY ISSUED FOR CONSTRUCTION AND SEALED BY ROBERT S. DIFIORE, SEAL NO. 22769

THIS DOCUMENT ORIGINALLY ISSUED FOR CONSTRUCTION AND SEALED BY RONALD L. TAYLOR, SEAL NO. 024649

RECORD DRAWING

THIS DRAWING HAS BEEN MODIFIED TO REFLECT FIELD CHANGES REPORTED BY THE CONTRACTOR OR ANOTHER PARTY, BUT NOT VERIFIED BY THE CERTIFYING ENGINEER. THIS DOCUMENT ORIGINALLY ISSUED AND SEALED BY DAVID A. NAILOR, 025465. THIS MEDIA SHALL NOT BE CONSIDERED A CERTIFIED DOCUMENT.

**HAZEN AND SAWYER**  
Environmental Engineers & Scientists  
4011 WestChase Blvd, Raleigh, North Carolina 27607

CITY OF ROANOKE  
VIRGINIA

REGIONAL WATER POLLUTION CONTROL PLANT  
WET WEATHER IMPROVEMENTS

PRELIMINARY TREATMENT FACILITIES

MECHANICAL

INTERMEDIATE PLAN AND DETAIL

THE SCALE BAR SHOWN BELOW MEASURES ONE INCH LONG ON THE ORIGINAL DRAWING.	DATE	JULY 2003
	H & S JOB NUMBER	30788A
	CONTRACT NUMBER	A
	DRAWING NUMBER	M121