


**BOTTOM PLAN**  
1/4" = 1'-0"

**NOTES:**

- 1 CONTRACTOR TO FIELD VERIFY LOCATION AND ELEVATION OF EXISTING PIPE.
- 2 PROVIDE 16" LONG FLANGE x FLANGE SPOOL PIECE FOR 36" BUTTERFLY VALVE.

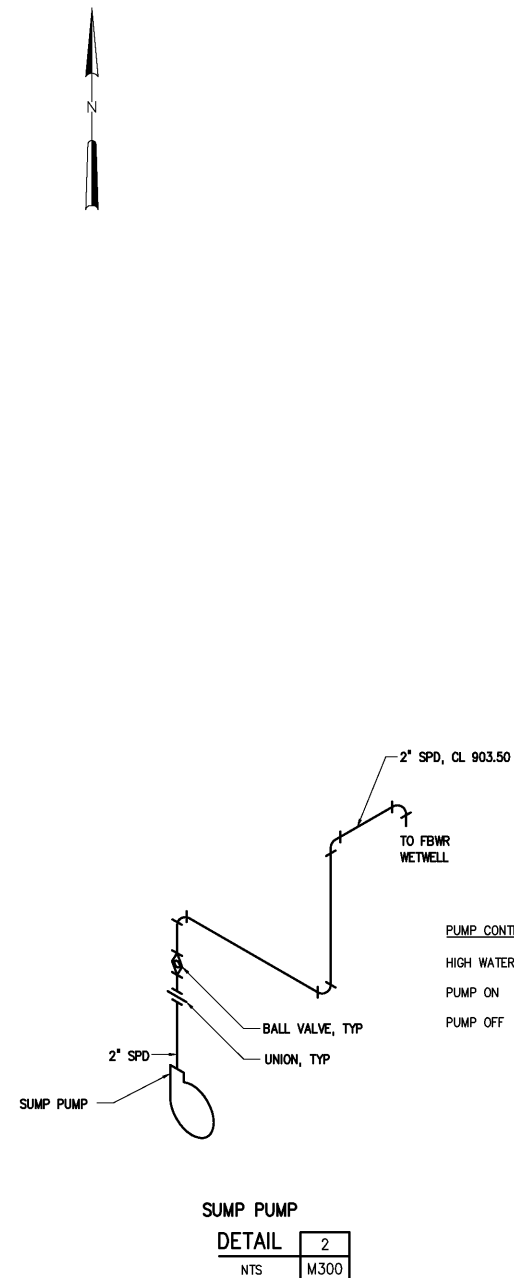

PUMP CONTROL LEVELS	
HIGH WATER ALARM	EL 894.25
PUMP ON	EL 894.00
PUMP OFF	EL 892.50

**SUMP PUMP  
DETAIL**  
2  
NTS M300

DESIGNED	DAP
DRAWN	BRC
CHECKED	
PROJ. ENGR.	DAN
APPROVED	
NO.	
ISSUED FOR	
DATE	
BY	

THIS DOCUMENT ORIGINALLY ISSUED FOR CONSTRUCTION AND SEALED BY ROBERT S. DIFIORE, SEAL NO. 22769

**RECORD DRAWING**

THIS DRAWING HAS BEEN MODIFIED TO REFLECT FIELD CHANGES REPORTED BY THE CONTRACTOR OR ANOTHER PARTY, BUT NOT VERIFIED BY THE CERTIFYING ENGINEER. THIS DOCUMENT ORIGINALLY ISSUED AND SEALED BY DAVID A. NAILOR, 025465. THIS MEDIA SHALL NOT BE CONSIDERED A CERTIFIED DOCUMENT.

THIS DOCUMENT ORIGINALLY ISSUED FOR CONSTRUCTION AND SEALED BY RONALD L. TAYLOR, SEAL NO. 024649

**HAZEN AND SAWYER**  
Environmental Engineers & Scientists  
4011 WestChase Blvd, Raleigh, North Carolina 27607

**CITY OF ROANOKE  
VIRGINIA**

**REGIONAL WATER POLLUTION CONTROL PLANT  
WET WEATHER IMPROVEMENTS**

**BAF/EQ PUMP STATION  
MECHANICAL  
BOTTOM PLAN AND DETAIL**

THE SCALE BAR SHOWN BELOW MEASURES ONE INCH LONG ON THE ORIGINAL DRAWING.	DATE	JULY 2003
	H & S JOB NUMBER	30788A
	CONTRACT NUMBER	A
	DRAWING NUMBER	M300